
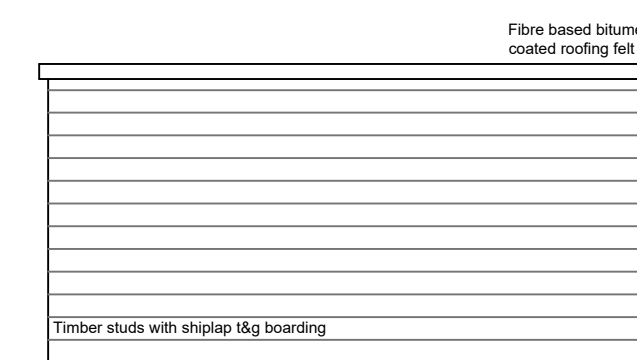
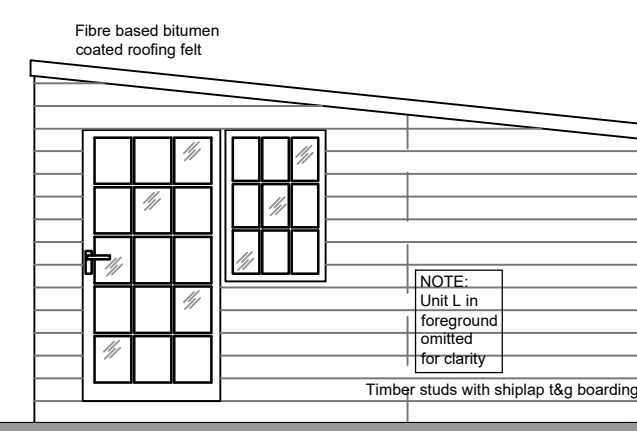
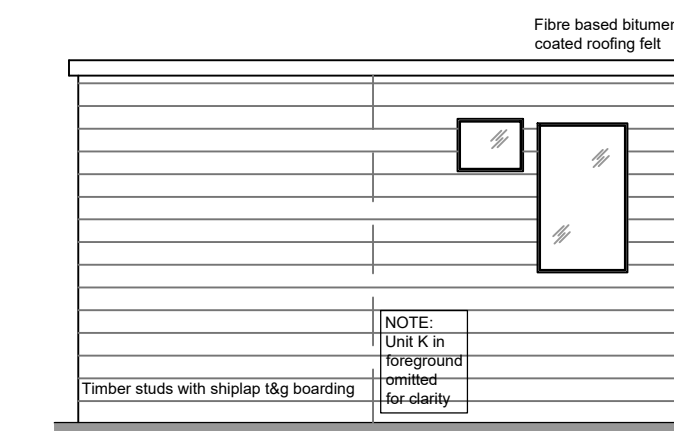
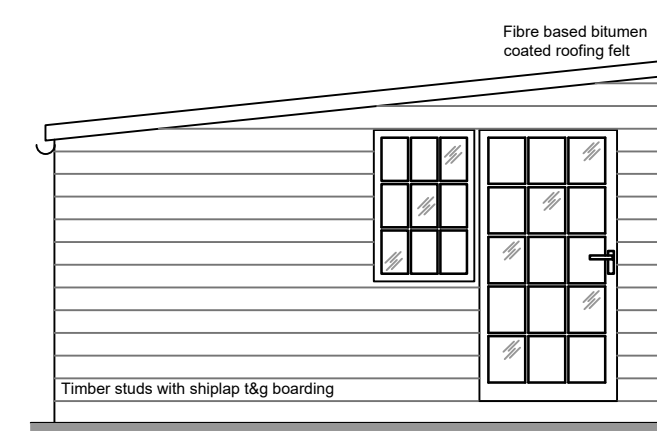
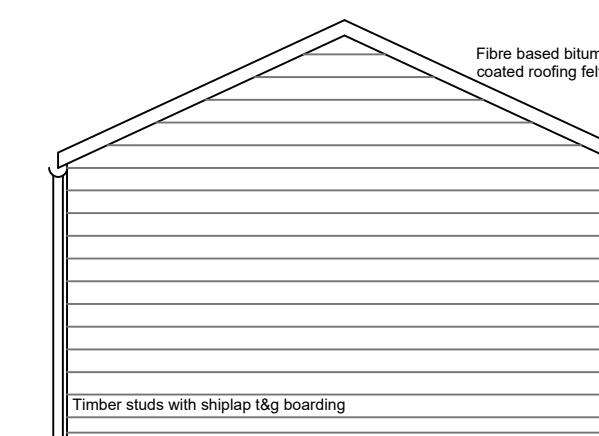
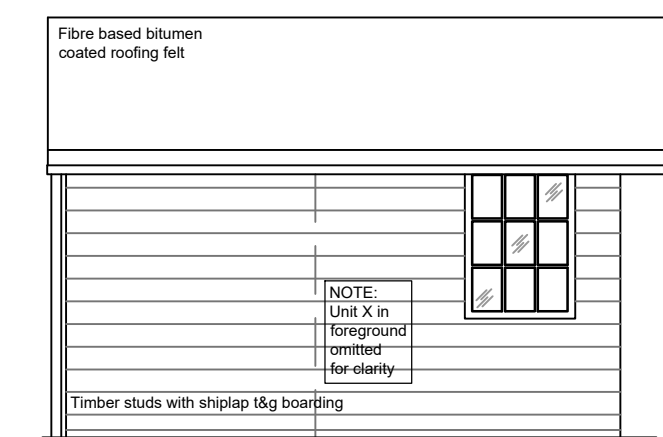
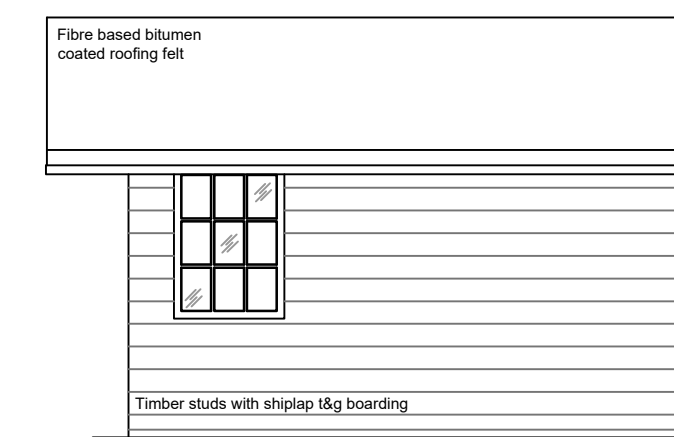
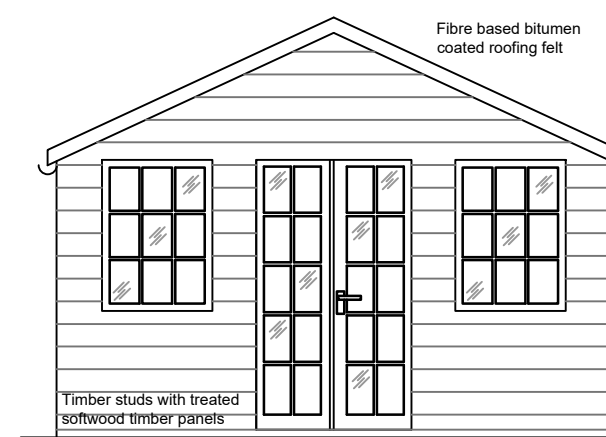
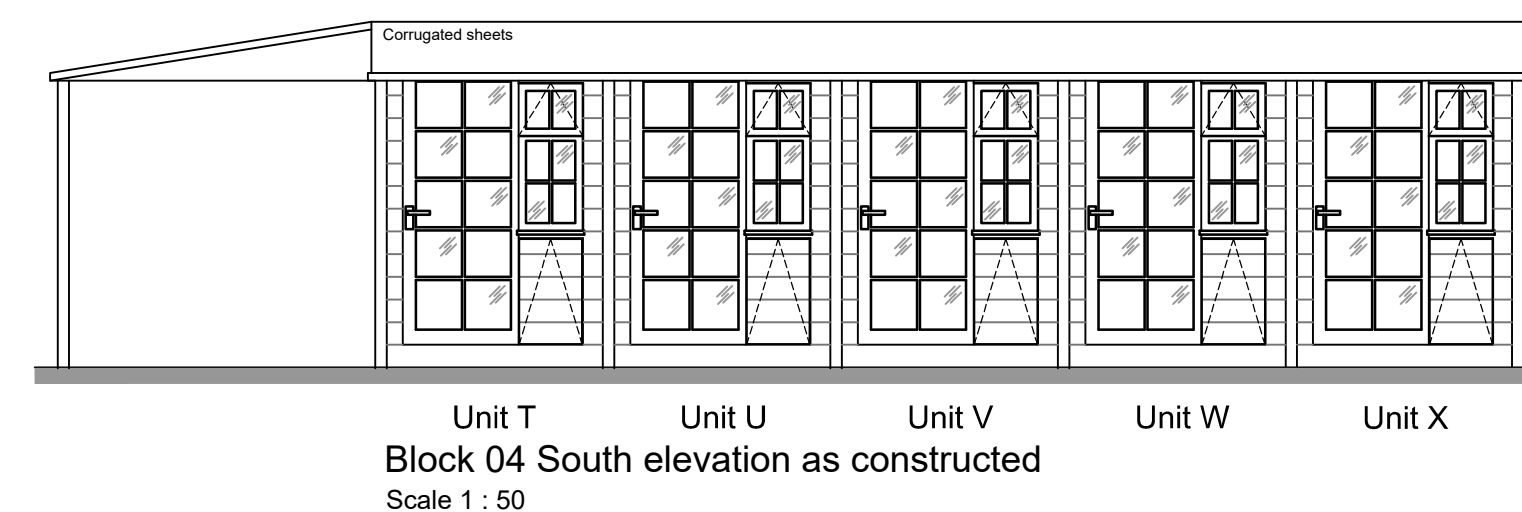
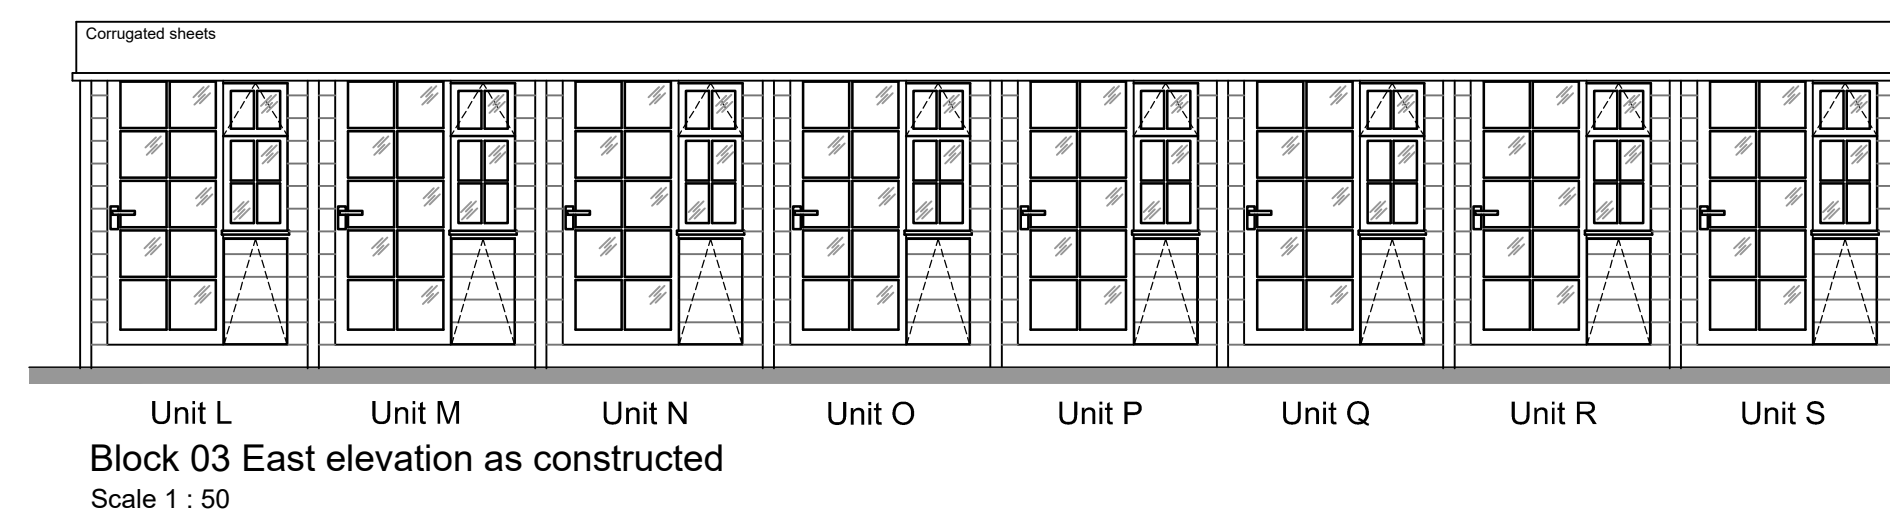
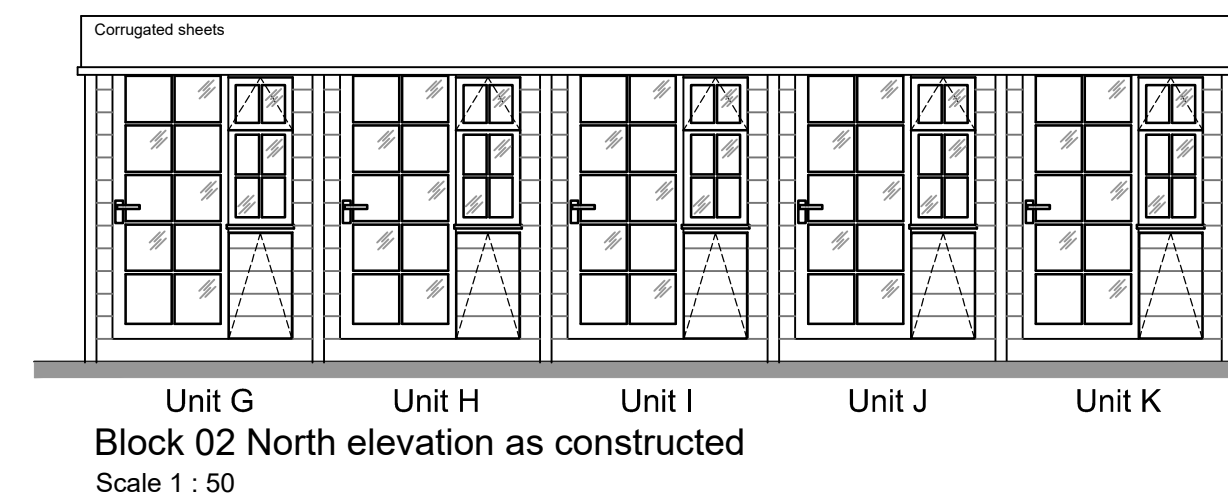
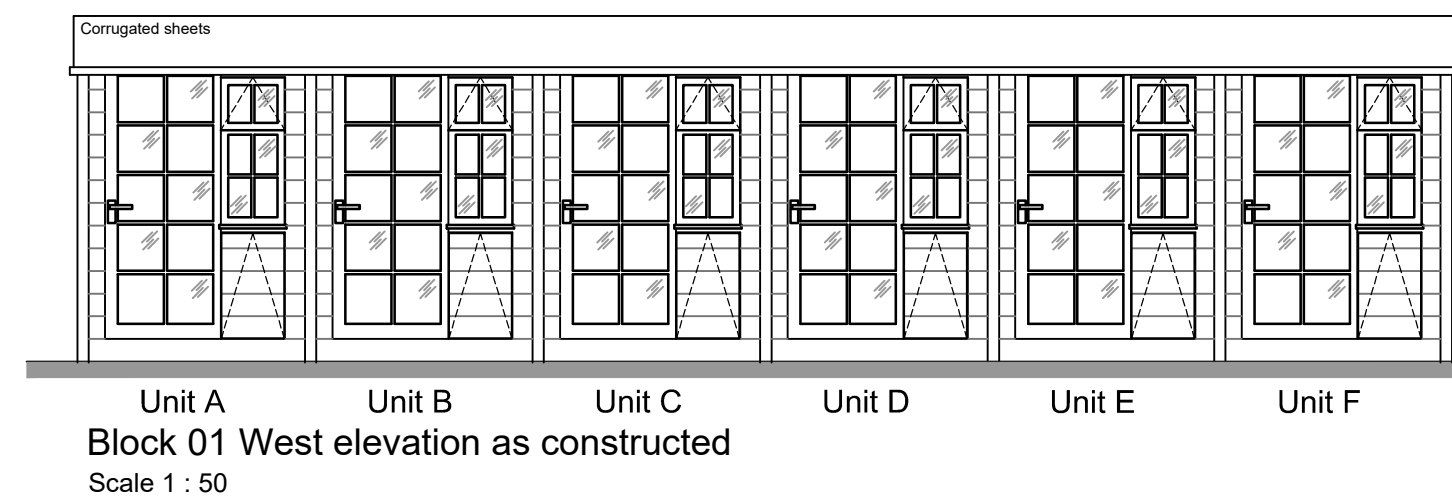


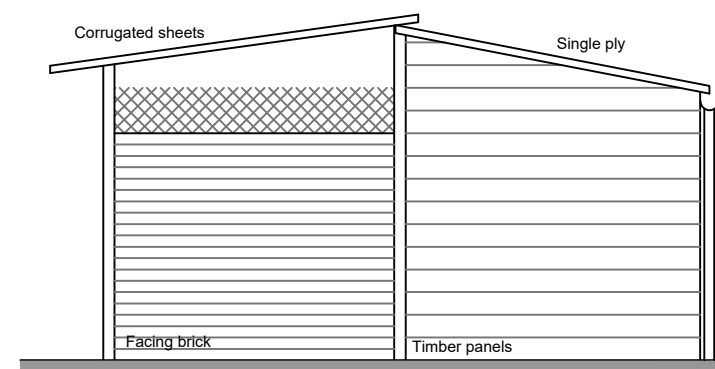

Notes:
Timber sub-structure with single ply/corrugated bituminous roof finishes throughout as indicated thus.
Single glazing timber windows throughout.

DO NOT SCALE THIS DRAWING. THE CONTRACTOR IS DEEMED TO HAVE CHECKED ALL DIMENSIONS ON SITE AND REPORT ANY DISCREPANCIES TO OGLESBY & LUMB LTD.
THE CONTENTS OF THIS DRAWING ARE COVERED BY COPYRIGHT AND REMAIN THE PROPERTY OF OGLESBY & LUMB LTD. WRITTEN APPROVAL MUST BE OBTAINED FROM OGLESBY & LUMB LTD PRIOR TO DUPLICATION OR REPRODUCTION OF THIS DRAWING OR ITS CONTENTS.
ANY DIMENSIONS NOT SHOWN ARE TO BE CHECKED AND AGREED WITH OGLESBY & LUMB LTD.

X	XX.XX.XX	XXX	XX
Ref.	Date	Description	Initial

Oglesby & Limb Ltd

Chartered Architect

Suite 1, Market Chambers
12 Market Place, Spalding, Lincs
PE11 1SL

Tel: 01775 761196

e-mail: design@o-l-ltd.co.uk



Client: **Mr M. Adamonis**

Project:

**Dog kennels at
Fulney Cottage
Low Road
Spalding
PE12 6EF**

Drawing Title:

**Roof plans and elevations
as constructed**

**RETROSPECTIVE PLANNING
APPLICATION ISSUE
PREVIOUSLY APPROVED H16-0986-19**

Date:	November 2022	Scale:	as shown
Drawn by:	RCW	Checked by:	AJO

Drawing Number:	Rev:
A1635 - 12	-