



Refer to E Bowman & Sons
Full Size drawings for
mouldings

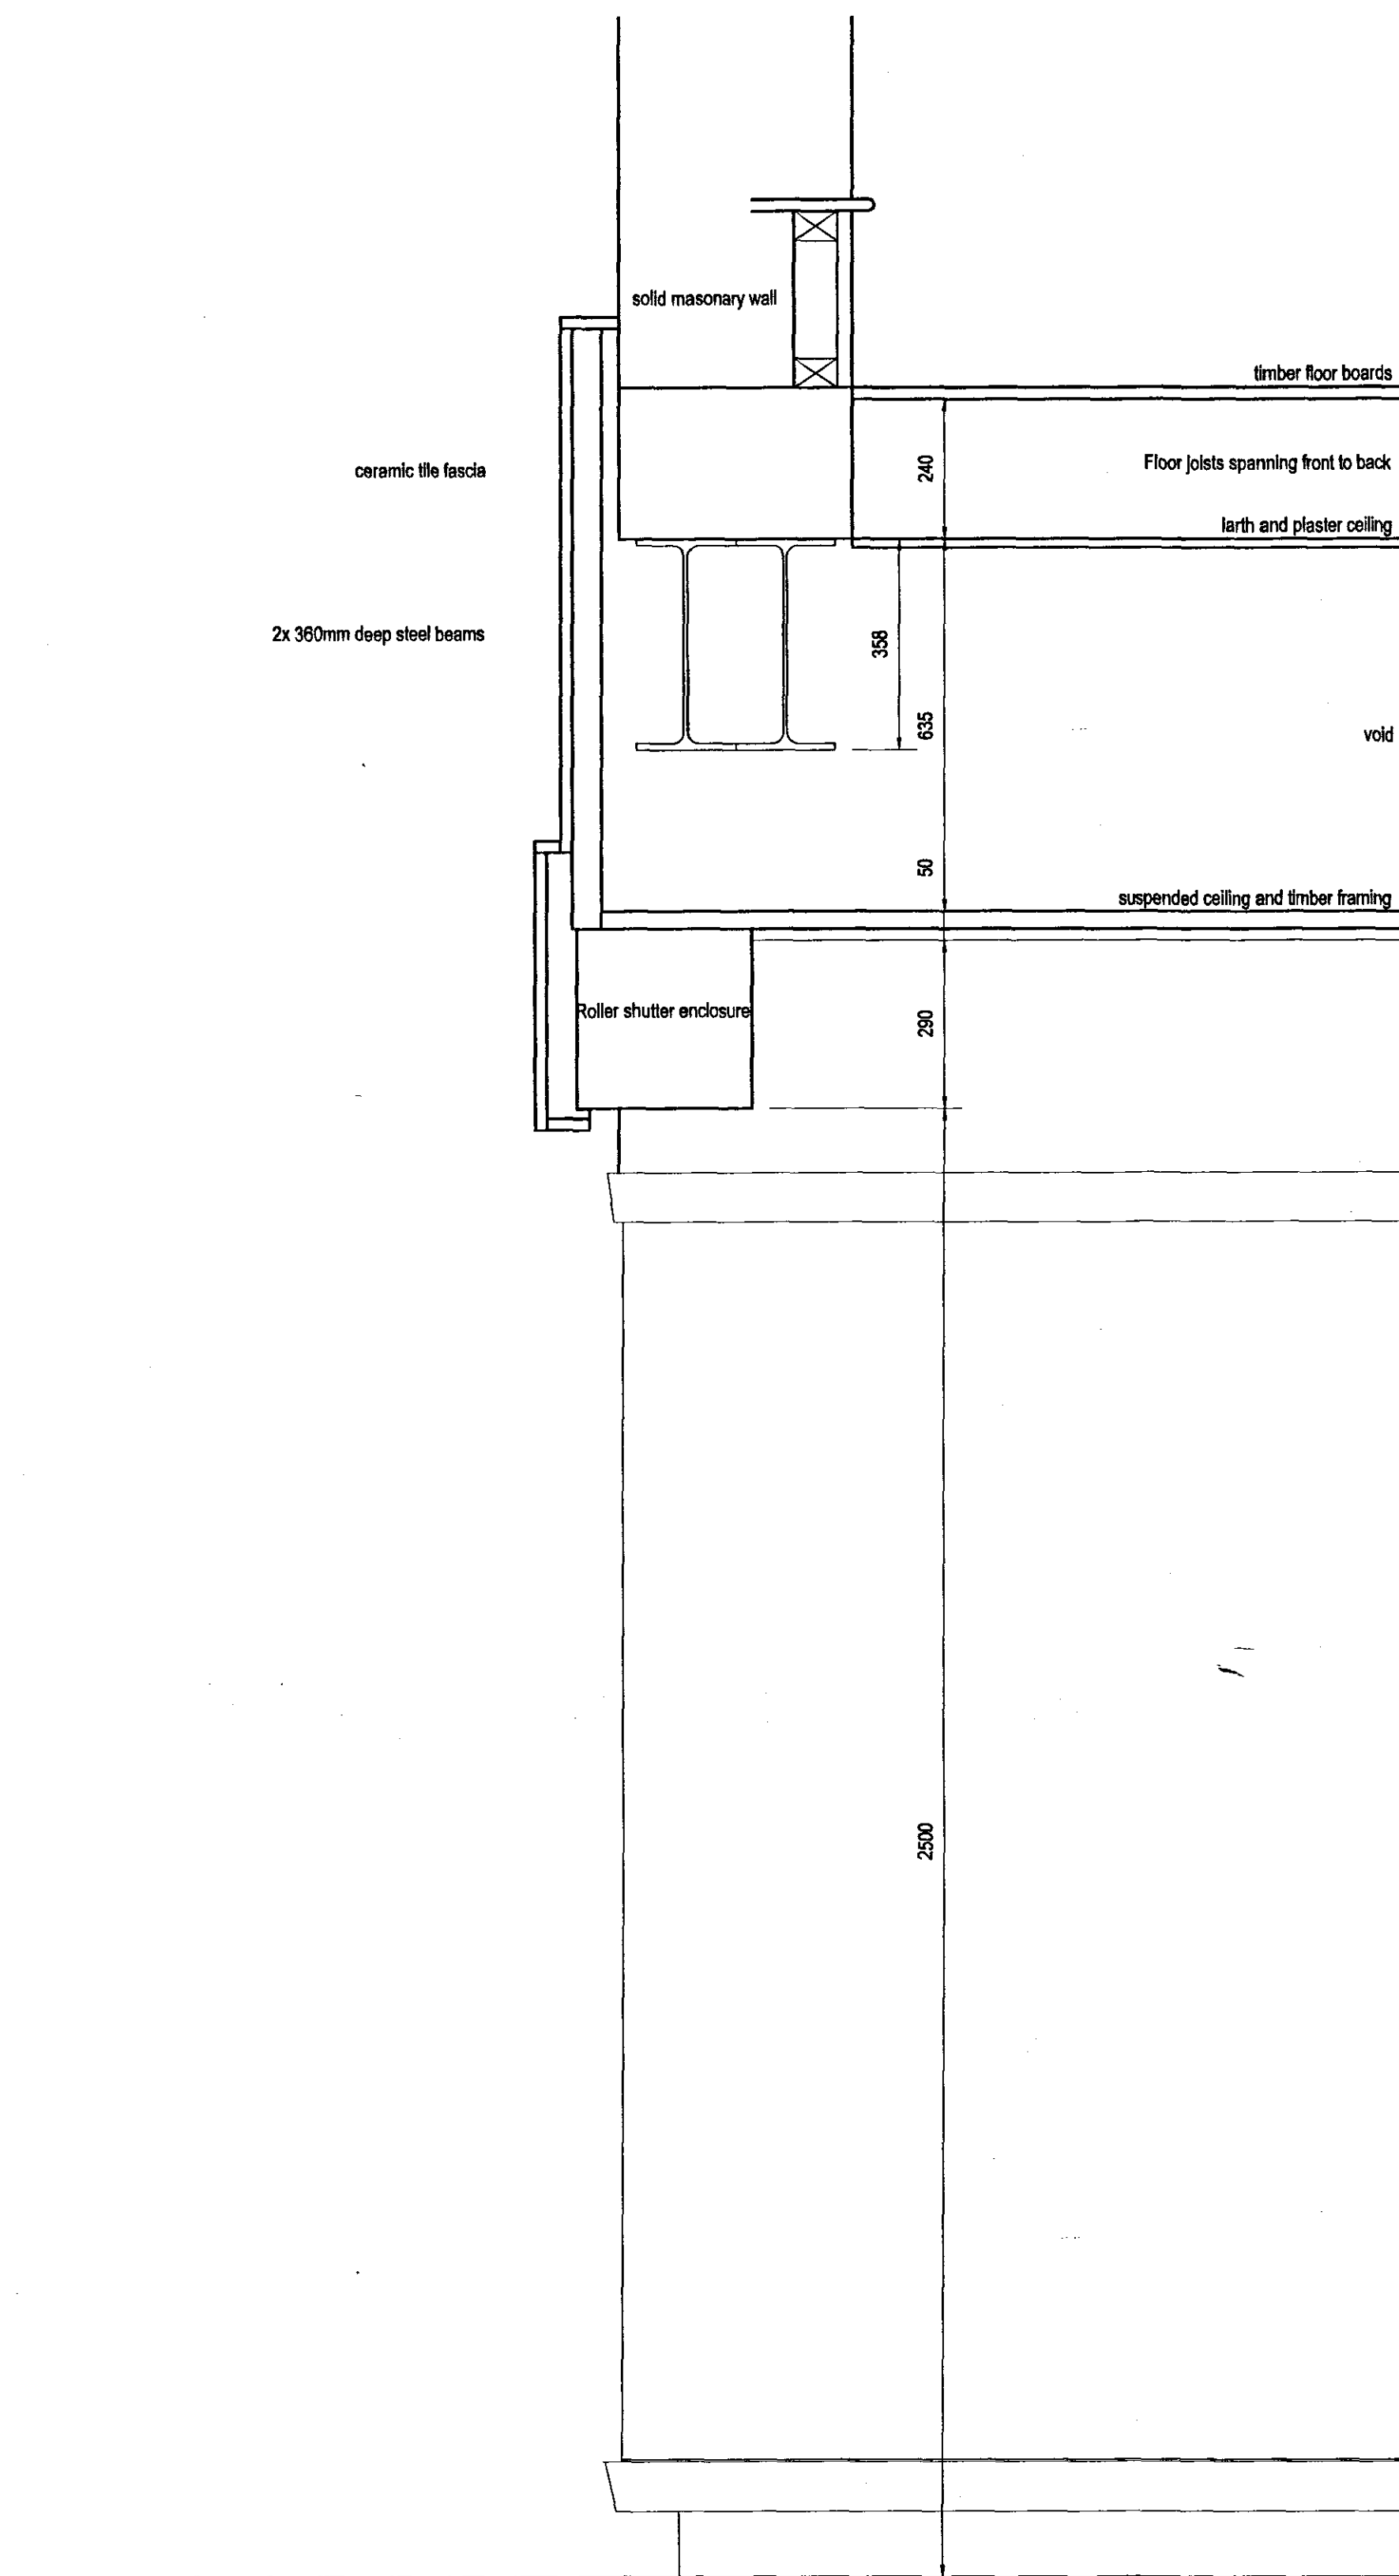


Existing Section through Shop Front

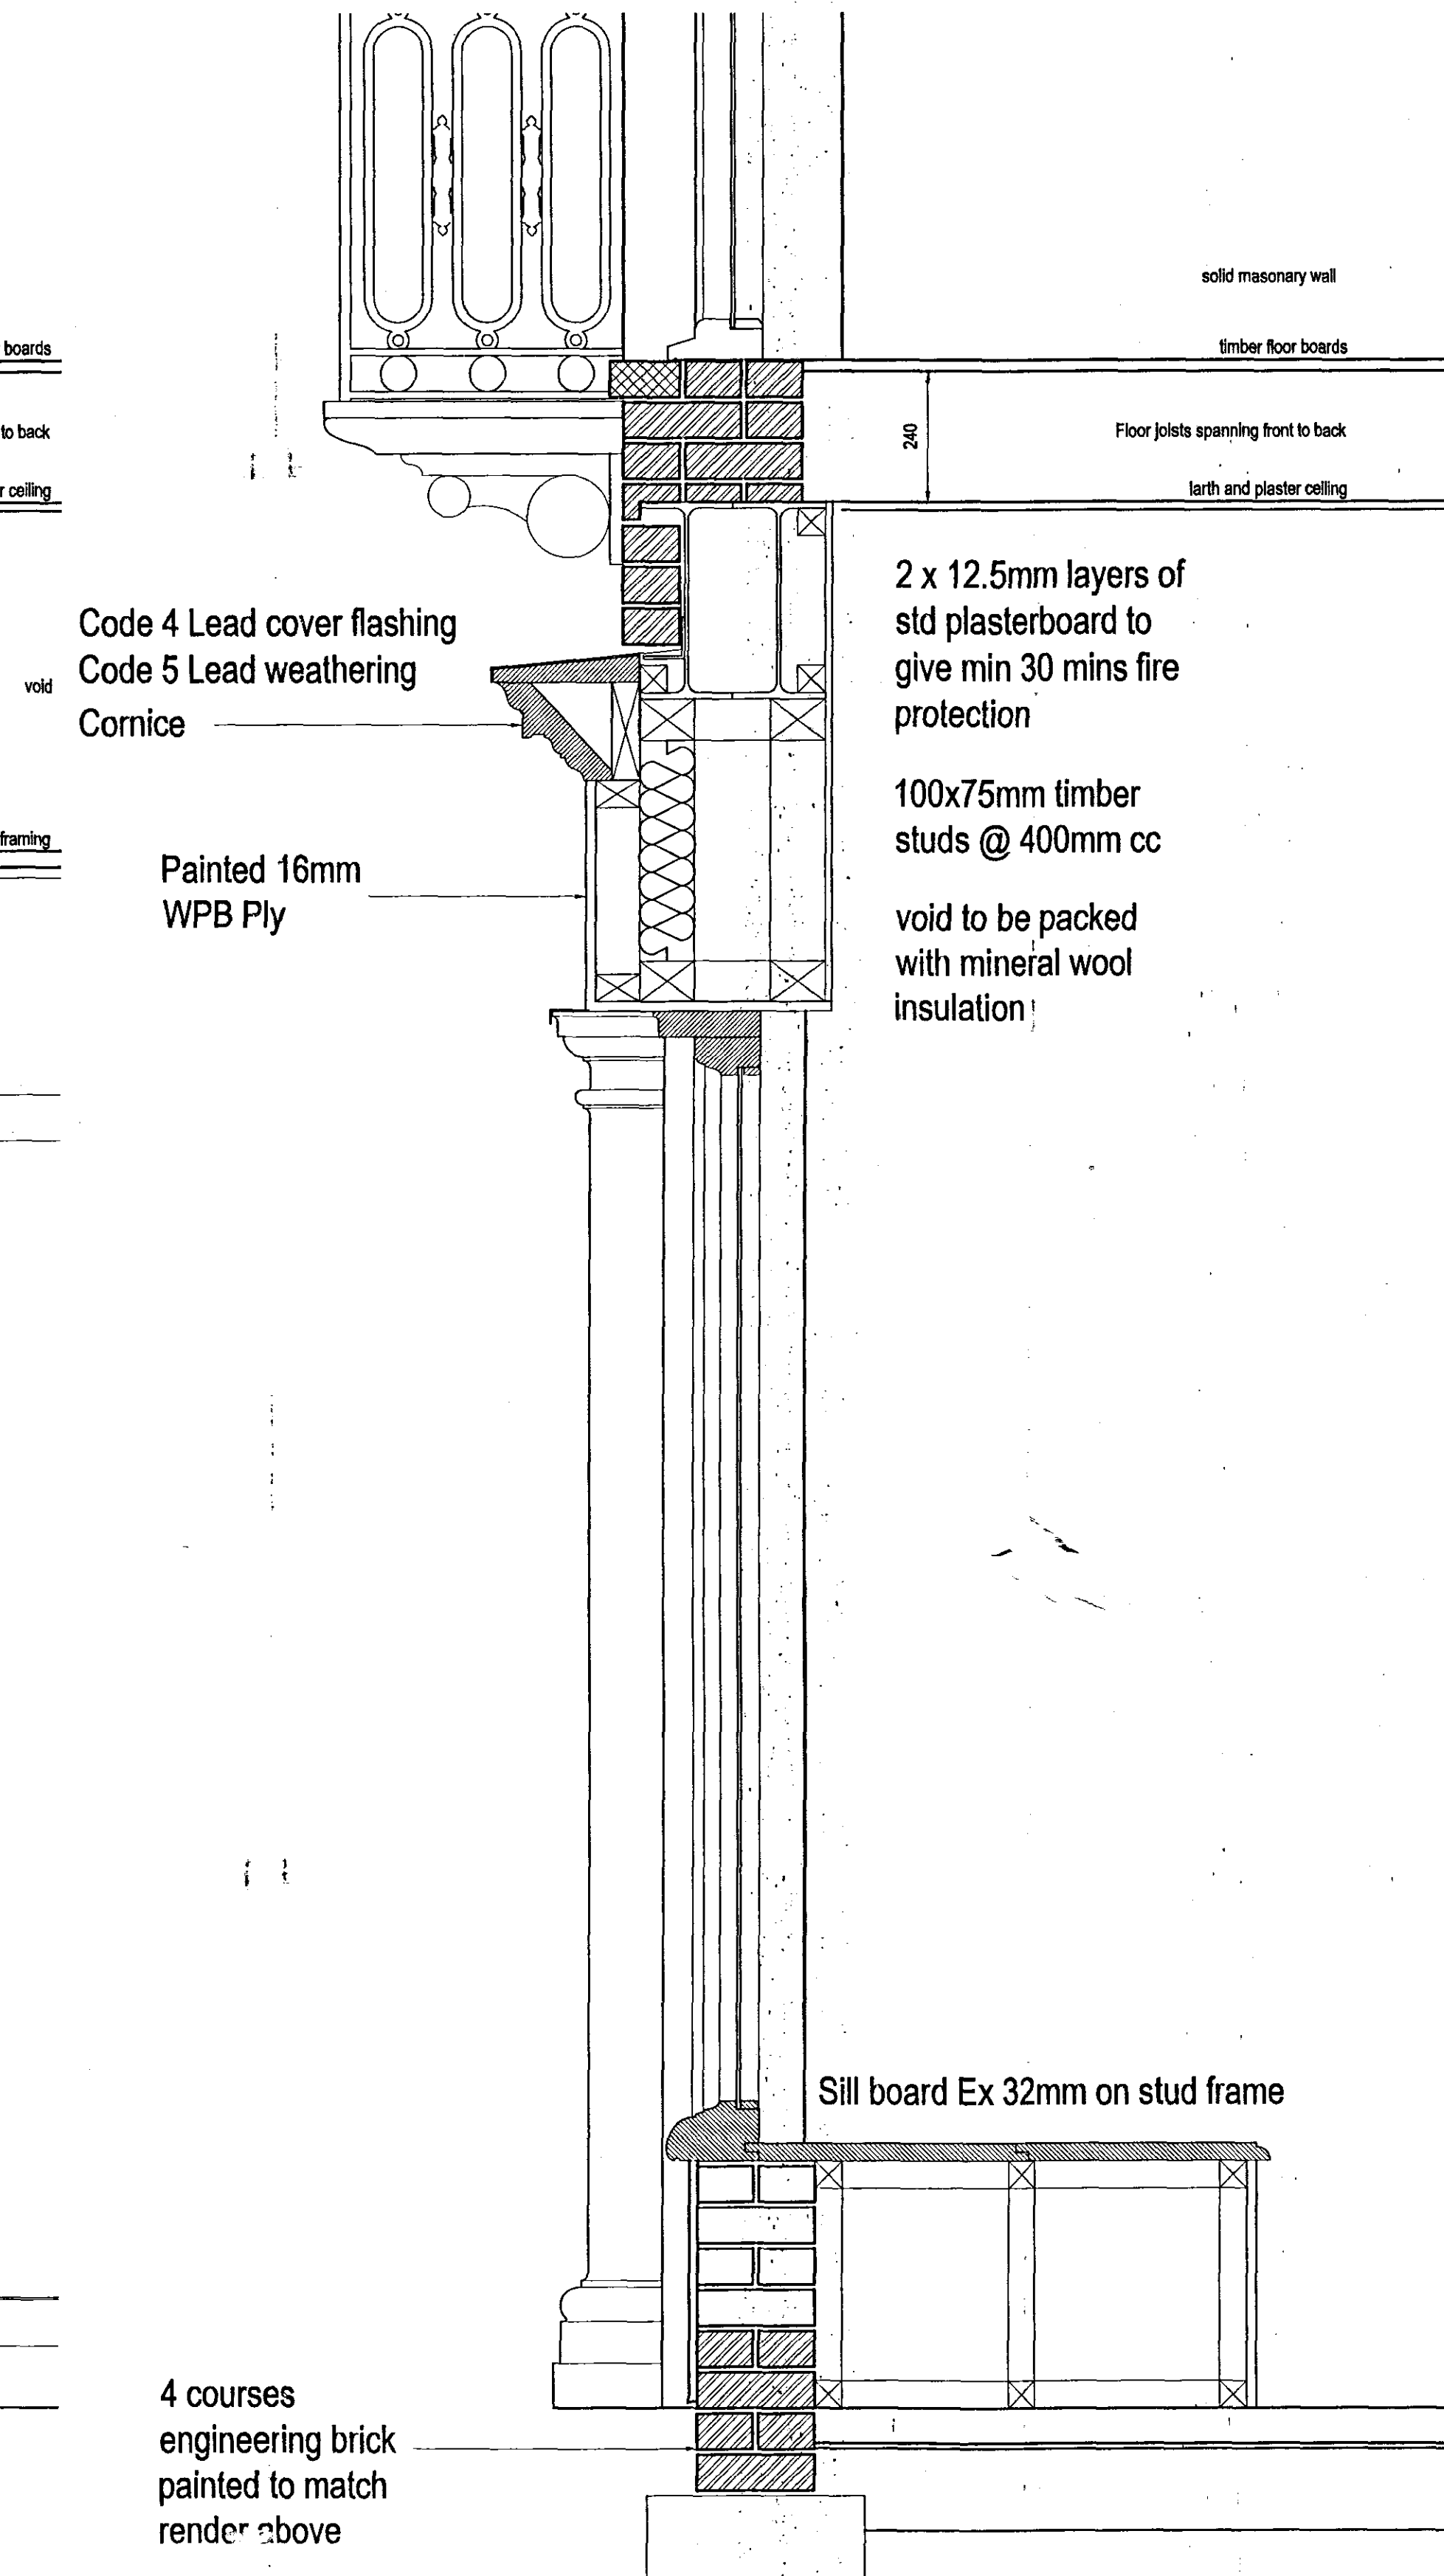

Proposed Section through Shop Front

Steel angle bolted to existing
beam as per SE details to
support new stone band and
cut facing brick

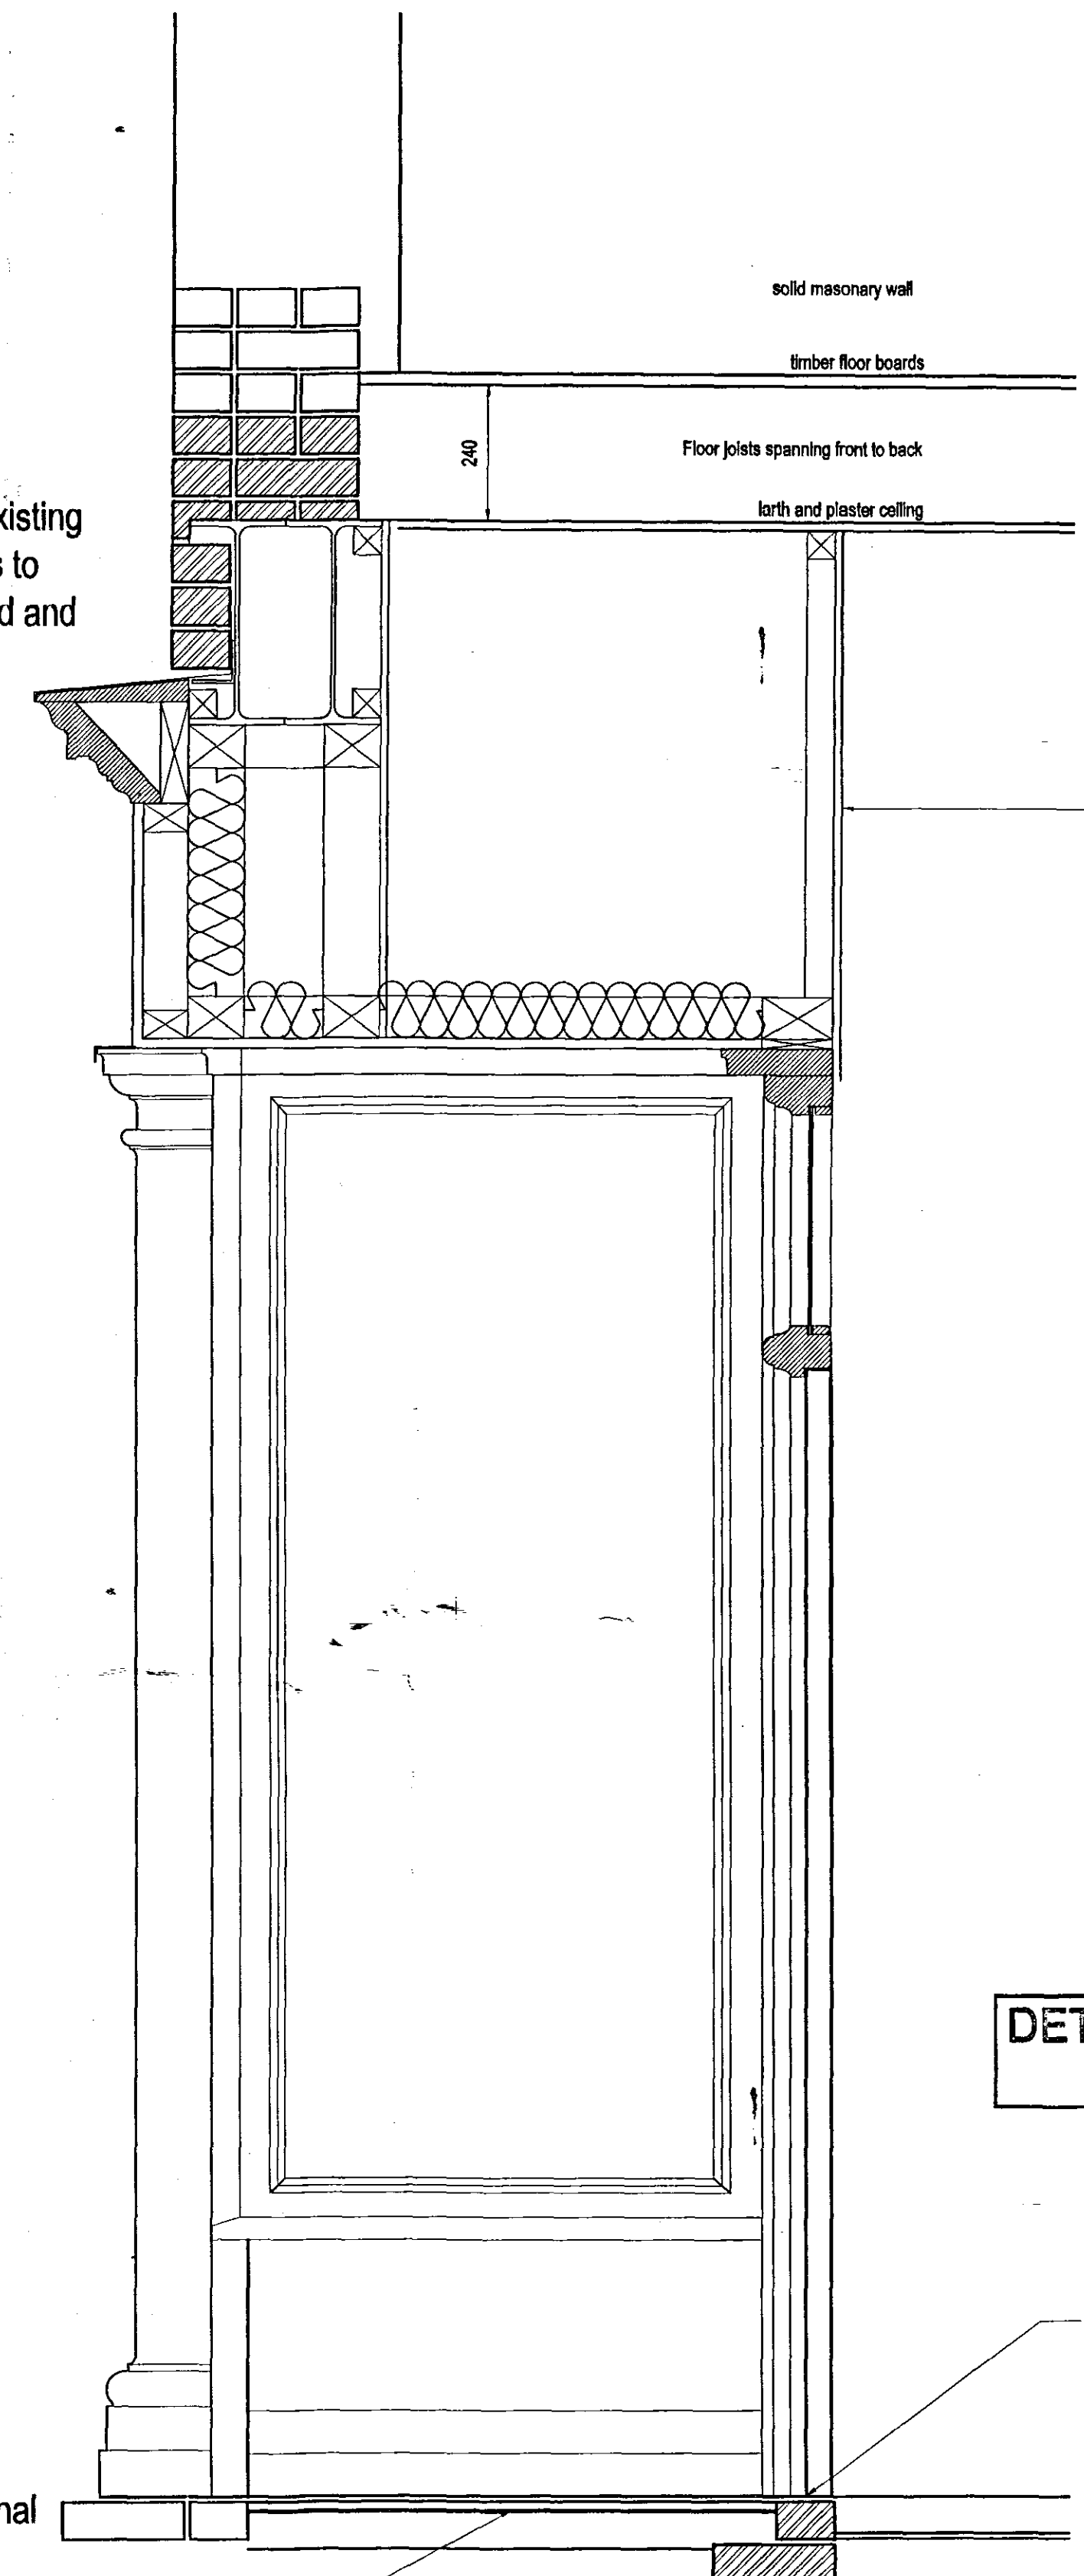

DETERMINED
PLAN

ISSUED

8 27 Apr 2009 RB RB Remove string course
A 20 Apr 2009 RB RB As Built - mouldings amended

3400
Planning & Development
27 APR 2009
Ref: 1197/08

REVISION	DATE	DRAWN	CHECKED	DESCRIPTION	SCALE	DATE
CLIENT	Joy Centre Properties Ltd & Mr M Berwald	1:10	26 Aug 2008			
PROJECT	14 Market Place, Spalding	DRAWN	CHECKED			
DRAWING TITLE	Shop Front Section	JM	JM			
JOB NUMBER	231432	DRAWING NO.	102	REVISION		
				B		

3 COLLEGE, NORWICH, NORFOLK NR1 1SN. TEL: 01603 874444, FAX: 01603 874445
PURCELL MILLER PARTITION LLP IS A LIMITED LIABILITY PARTNERSHIP REGISTERED IN ENGLAND AND WALES.
REGISTERED NUMBER: 06155848. REGISTERED OFFICE: 3 COLLEGE, NORWICH, NORFOLK NR1 1SN. www.pml.co.uk
© ALL RIGHTS RESERVED. DO NOT SCALE FROM DRAWING. CHECK DIMENSIONS ON SITE.

PURCELL MILLER PARTITION