


NOTES:-

NO DIRECT SHADE CASTING ON
OR ELECTRONICS.
Window - floor area ratio 1:
Floor area 181.0 sq.m.
Window area 30.40 sq.m. = 16.8%

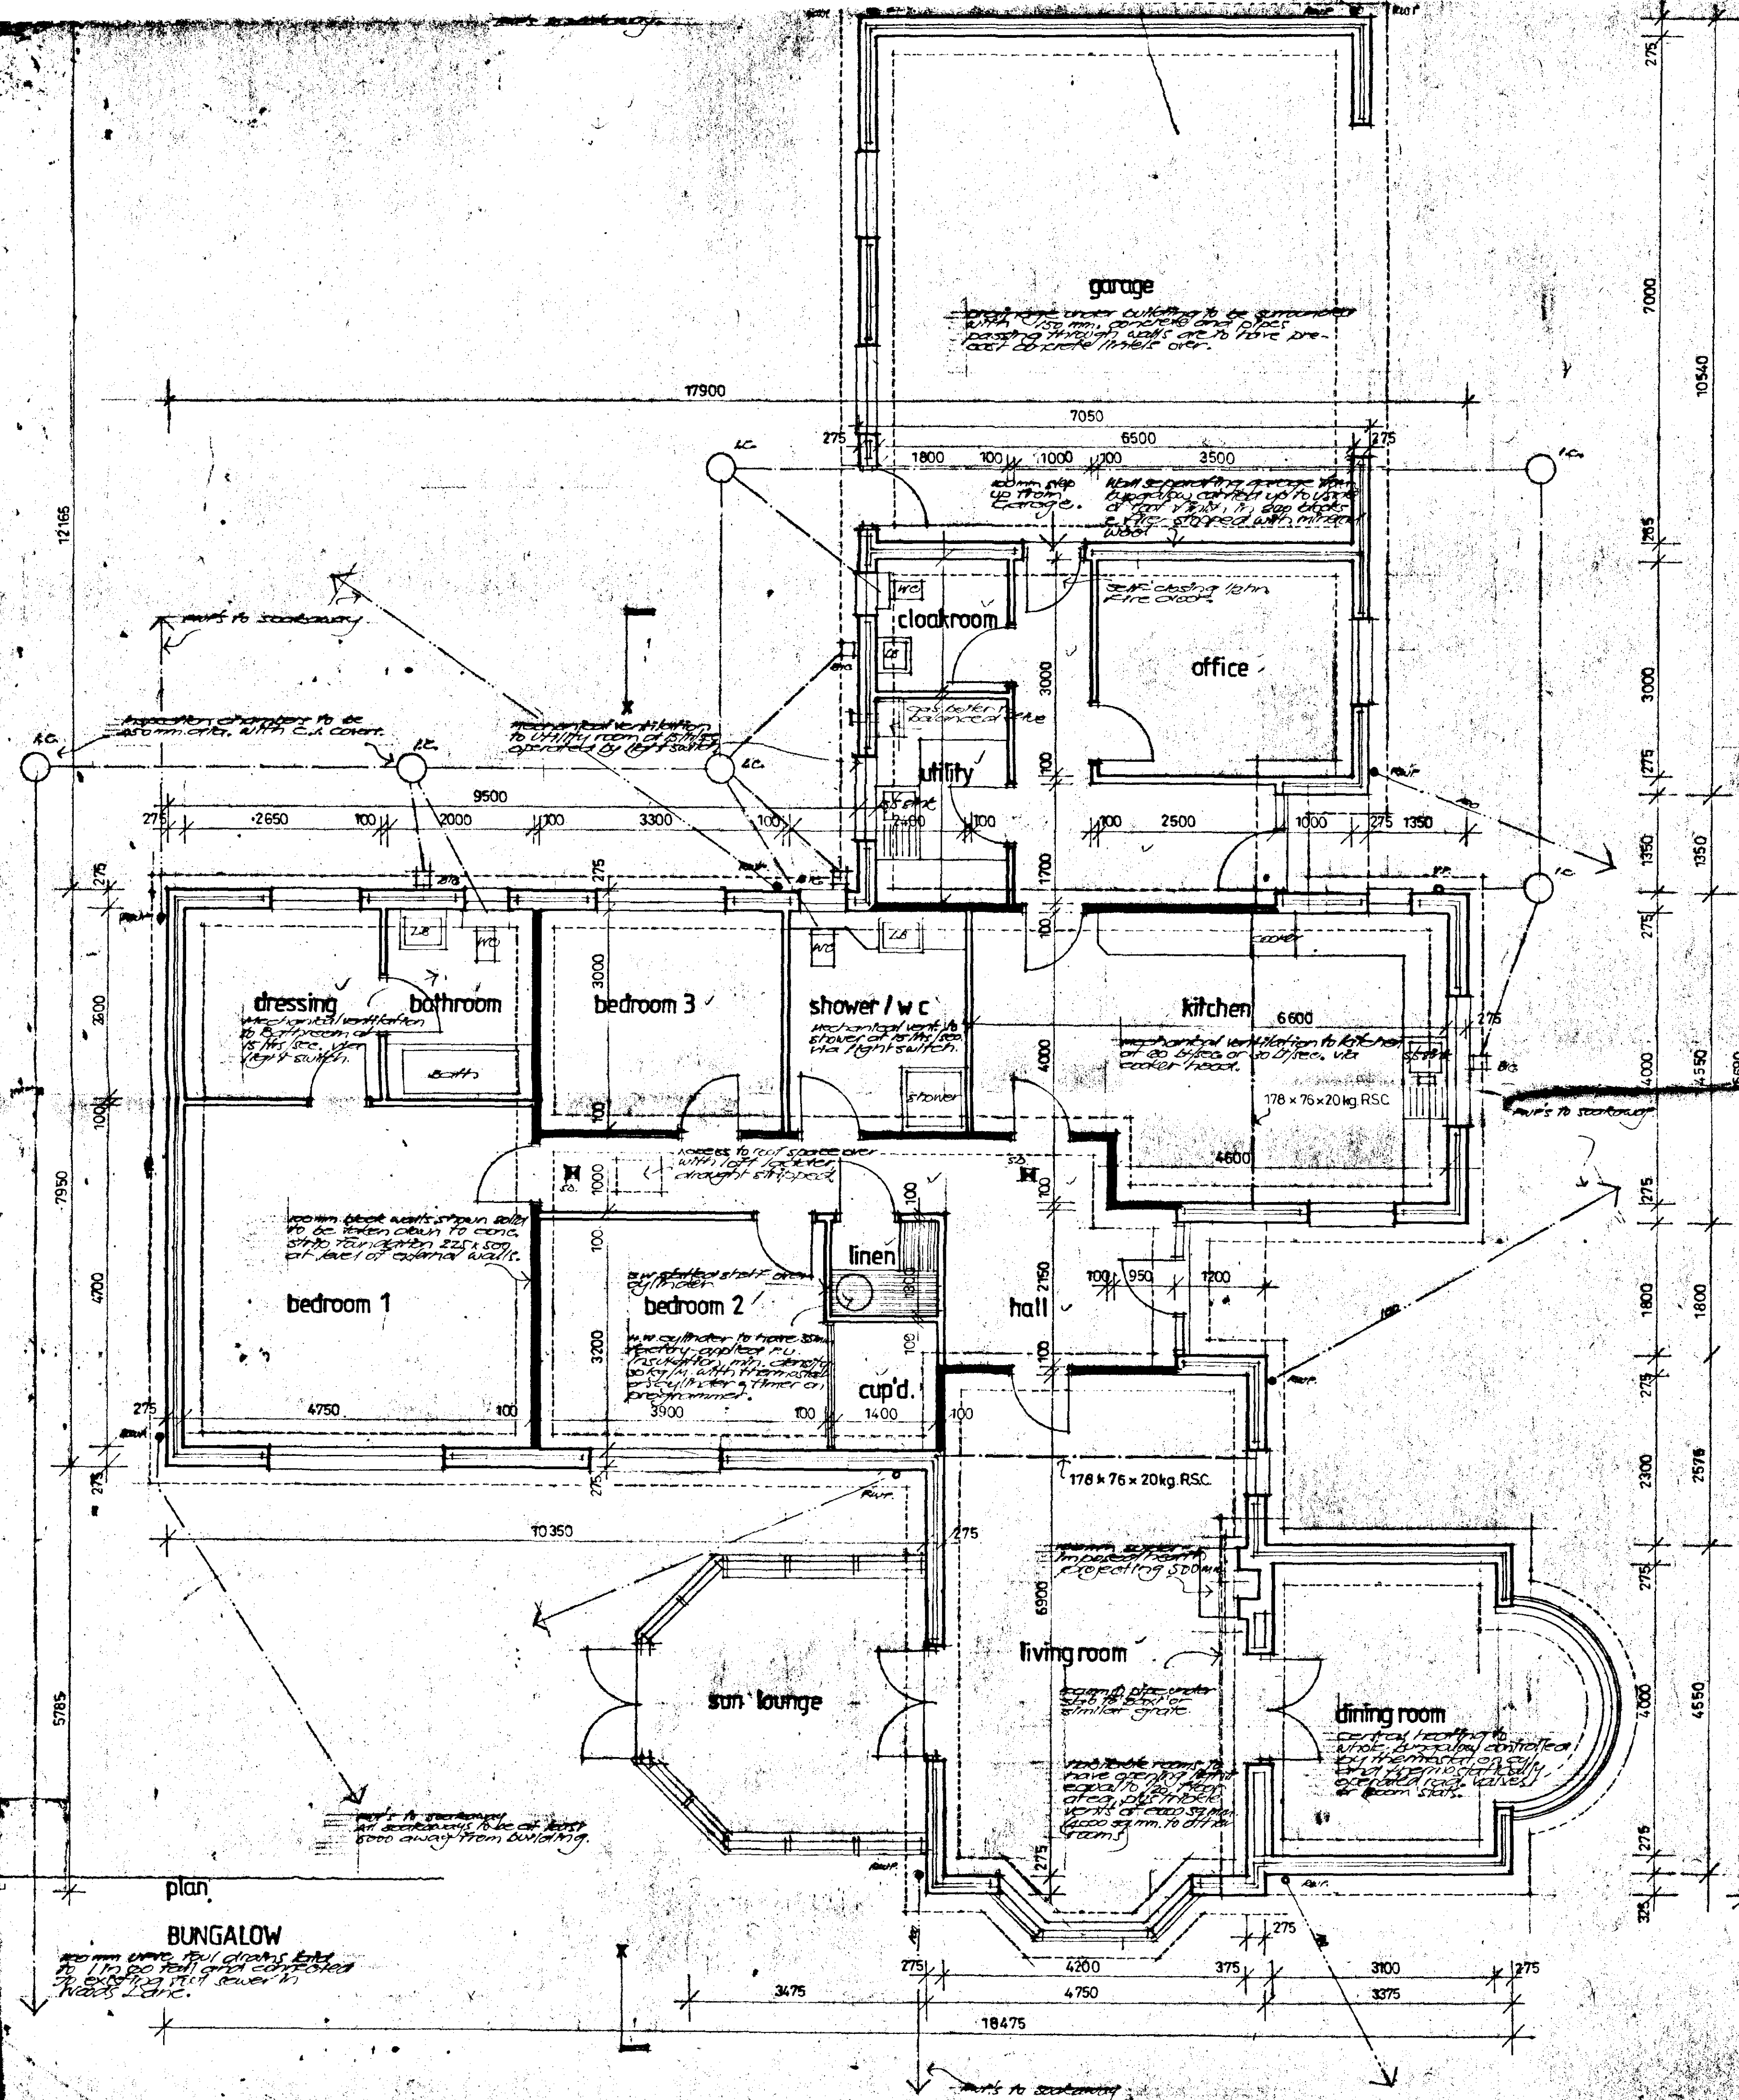

REVISIONS:-

1. OCT. 96: REVISIONS TO BE COMPLETED TO ALL WORK SHOWN. ADD TO REAR OF GARAGE. SUN LOUNGE OMITTED.
2. APRIL 97: SUN LOUNGE ADDED.

DETERMINED PLAN

SOUTH COAST
HOMES
10, NEWTON
Ref: 033/91

M. PARKER & SONS LIMITED
BUILDERS & CONTRACTORS




ST. JOHNS RD. SPALDING - Lincs PE11 1JX
FAX. 01775 762171 TEL 01775 724777

E. SAUNDERS. R.I.B.A. COMPANY ARCHITECT

PROPOSED BUNGALOW, OFFICE,
SEED STORE & GLASSHOUSE
WOODS LANE, SURFLEET, SPALDING
FOR
J.A. DOBNEY & SONS
BUNGALOW PLAN

SCALES: 1/50
DRG. NO. DATE: JULY 96

NOTES:-

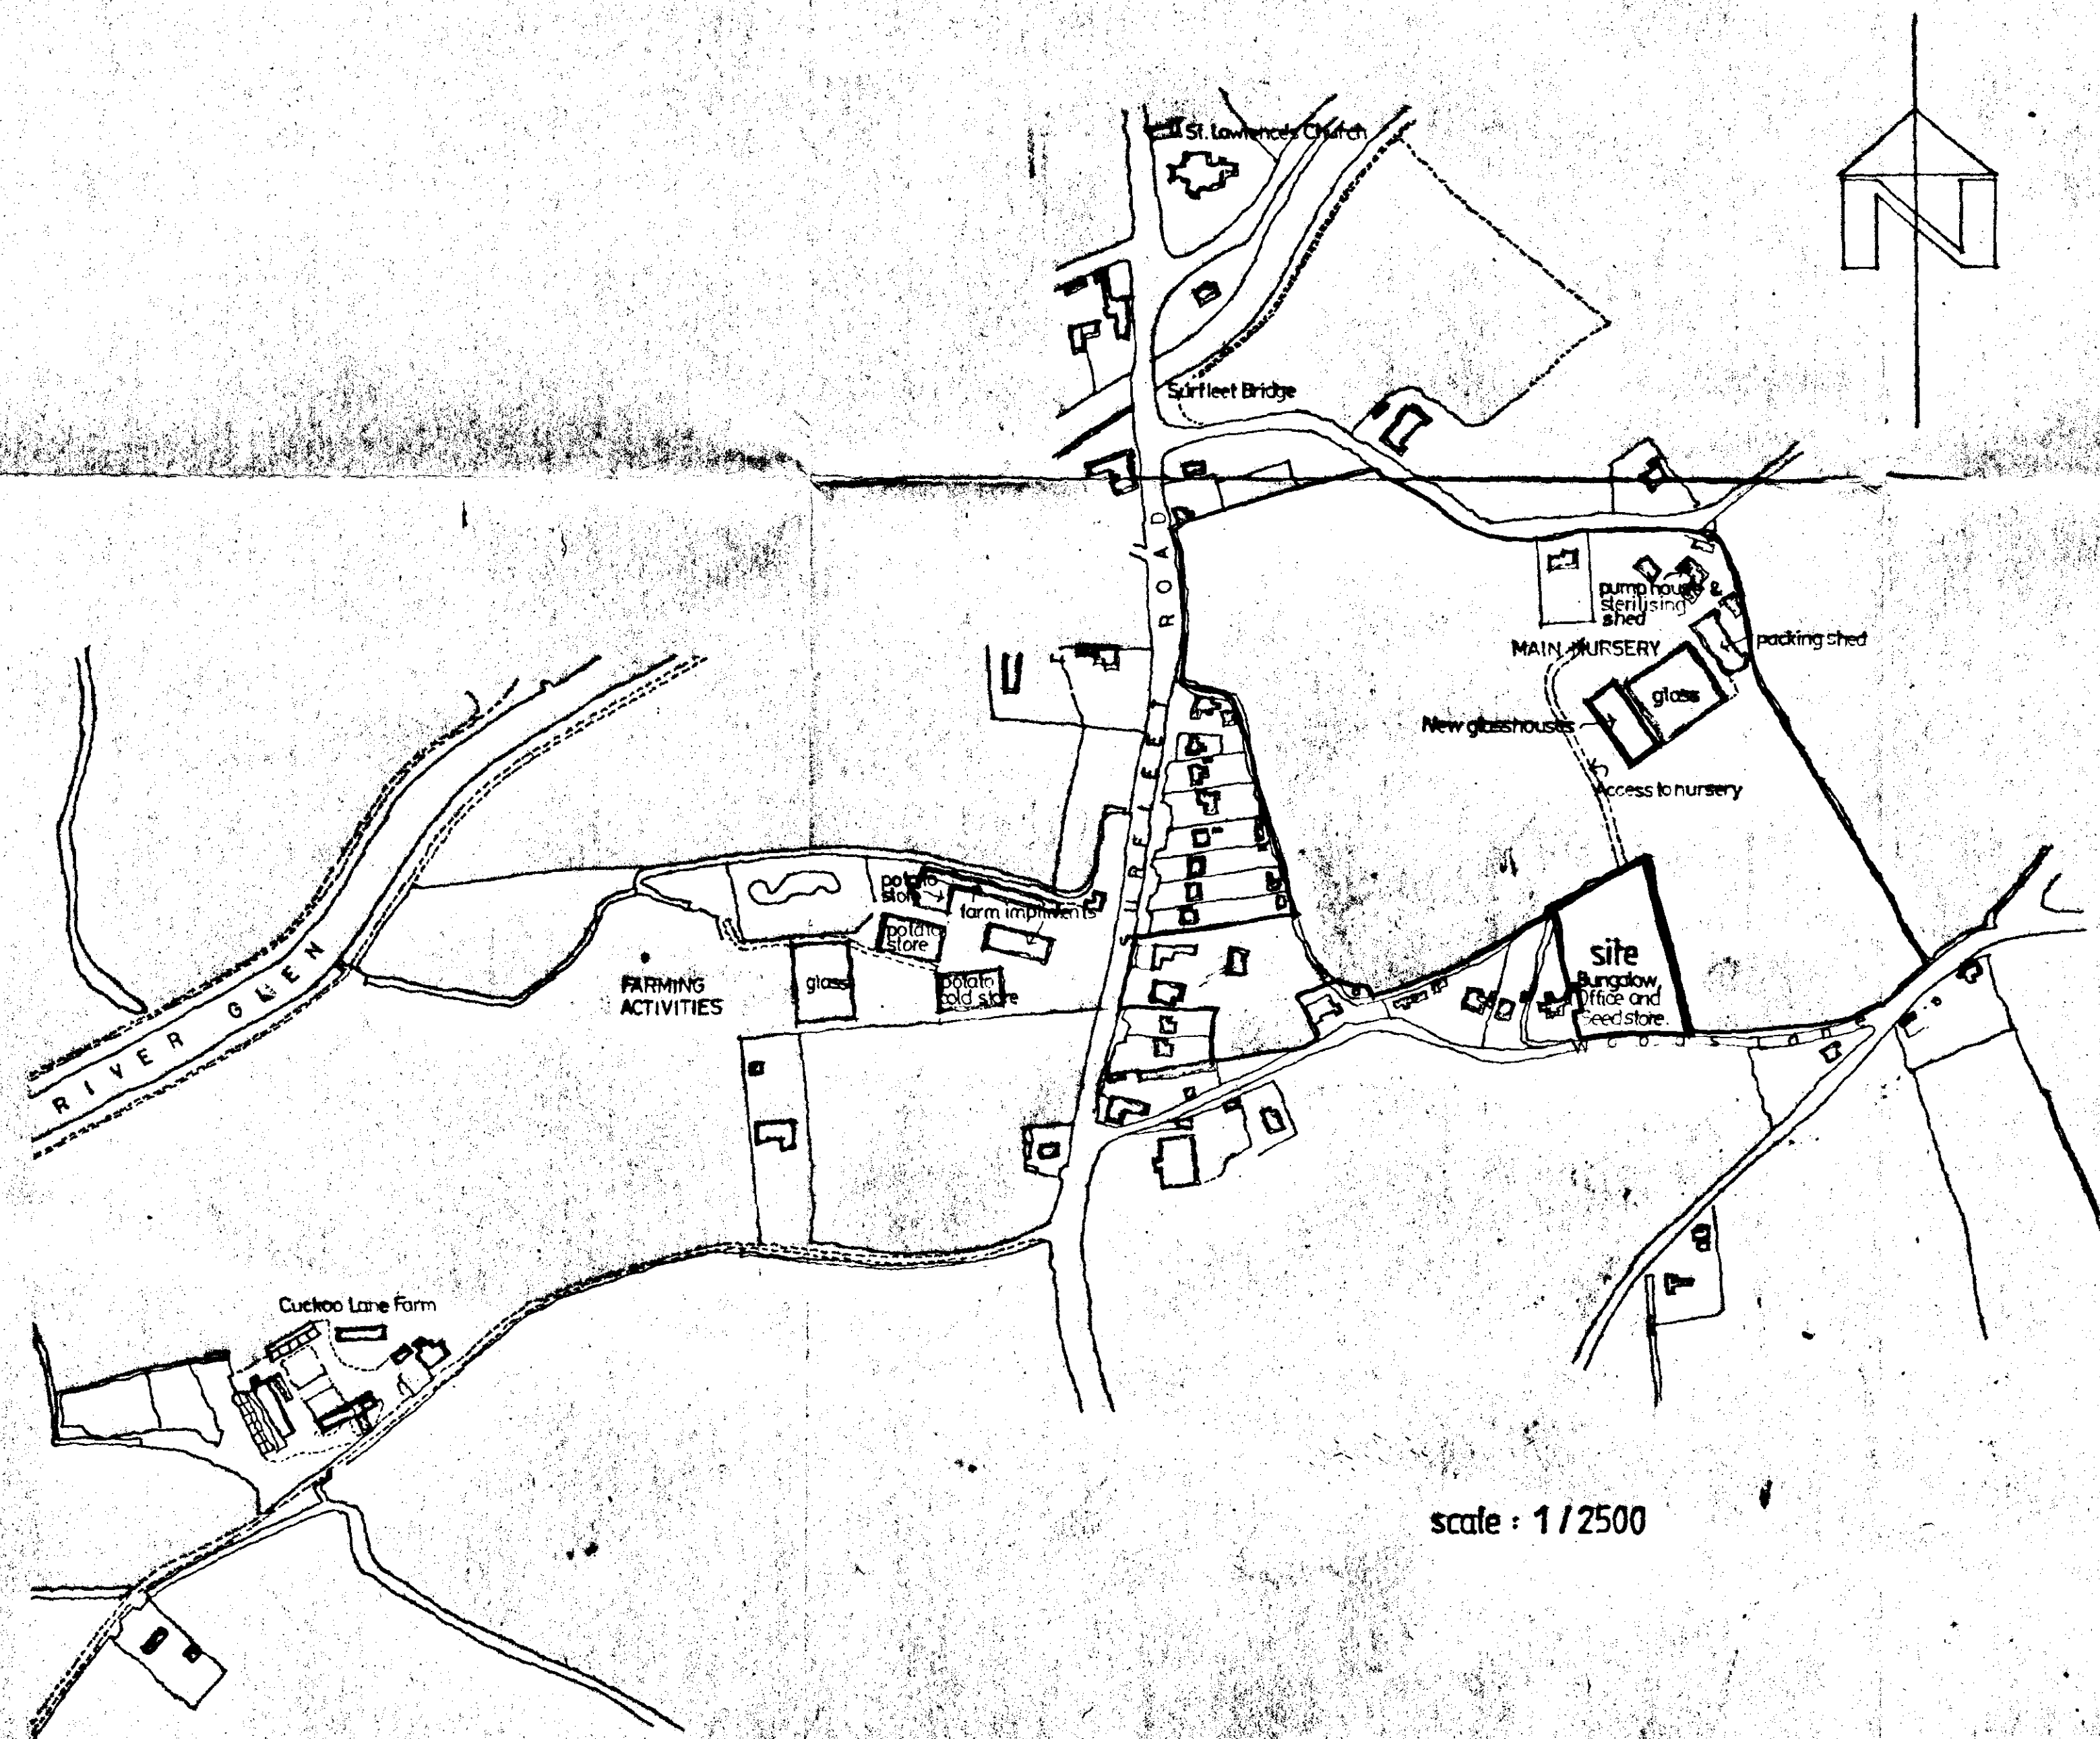

scale : 1/2500

REVISIONS:-

DETERMINED PLAN

M. PARKER & SONS LIMITED




BUILDERS & CONTRACTORS
ST. JOHNS RD · SPALDING · Lincs PE11 1JX
FAX. 0775 762171 ☎ 0775 724777
E. SAUNDERS. R.I.B.A. COMPANY ARCHITECT.

**PROPOSED BUNGALOW, OFFICE,
SEED STORE & GLASSHOUSE
WOODS LANE, SURFLEET, SPALDING
FOR
J.A. DOBNEY & SONS
LOCATION PLAN**

SCALES 1/2500
DRG. NO. DATE NOV 96

NOTES:-

DETERMINED
PLAN

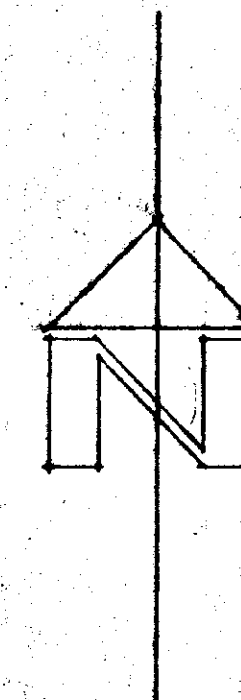

existing glasshouse
new glasshouse
764 sq.M total area
Three bays of 6.4M
38.0M
19.6M

REVISIONS:-

MARCH '97 POSITION OF BUNGALOW & SEED STORE AMENDED.


DETERMINED
PLAN


SOUTH EAST LINDS
HOUSE 100/100
110 APR 1997
Ref: 0132/97

**M. PARKER
& SONS LIMITED**
BUILDERS & CONTRACTORS
ST. JOHNS RD - SPALDING - Lincs PE11 1JX
FAX. 01775 762171
E. SAUNDERS. R.I.B.A. COMPANY ARCHITECT

PROPOSED BUNGALOW, OFFICE,
SEED STORE & GLASSHOUSE
WOODS LANE, SURFLEET, SPALDING
FOR
JA BOBNEY & SONS
SITE PLAN

SCALES 1/500
DRG. NO. DATE JULY '96

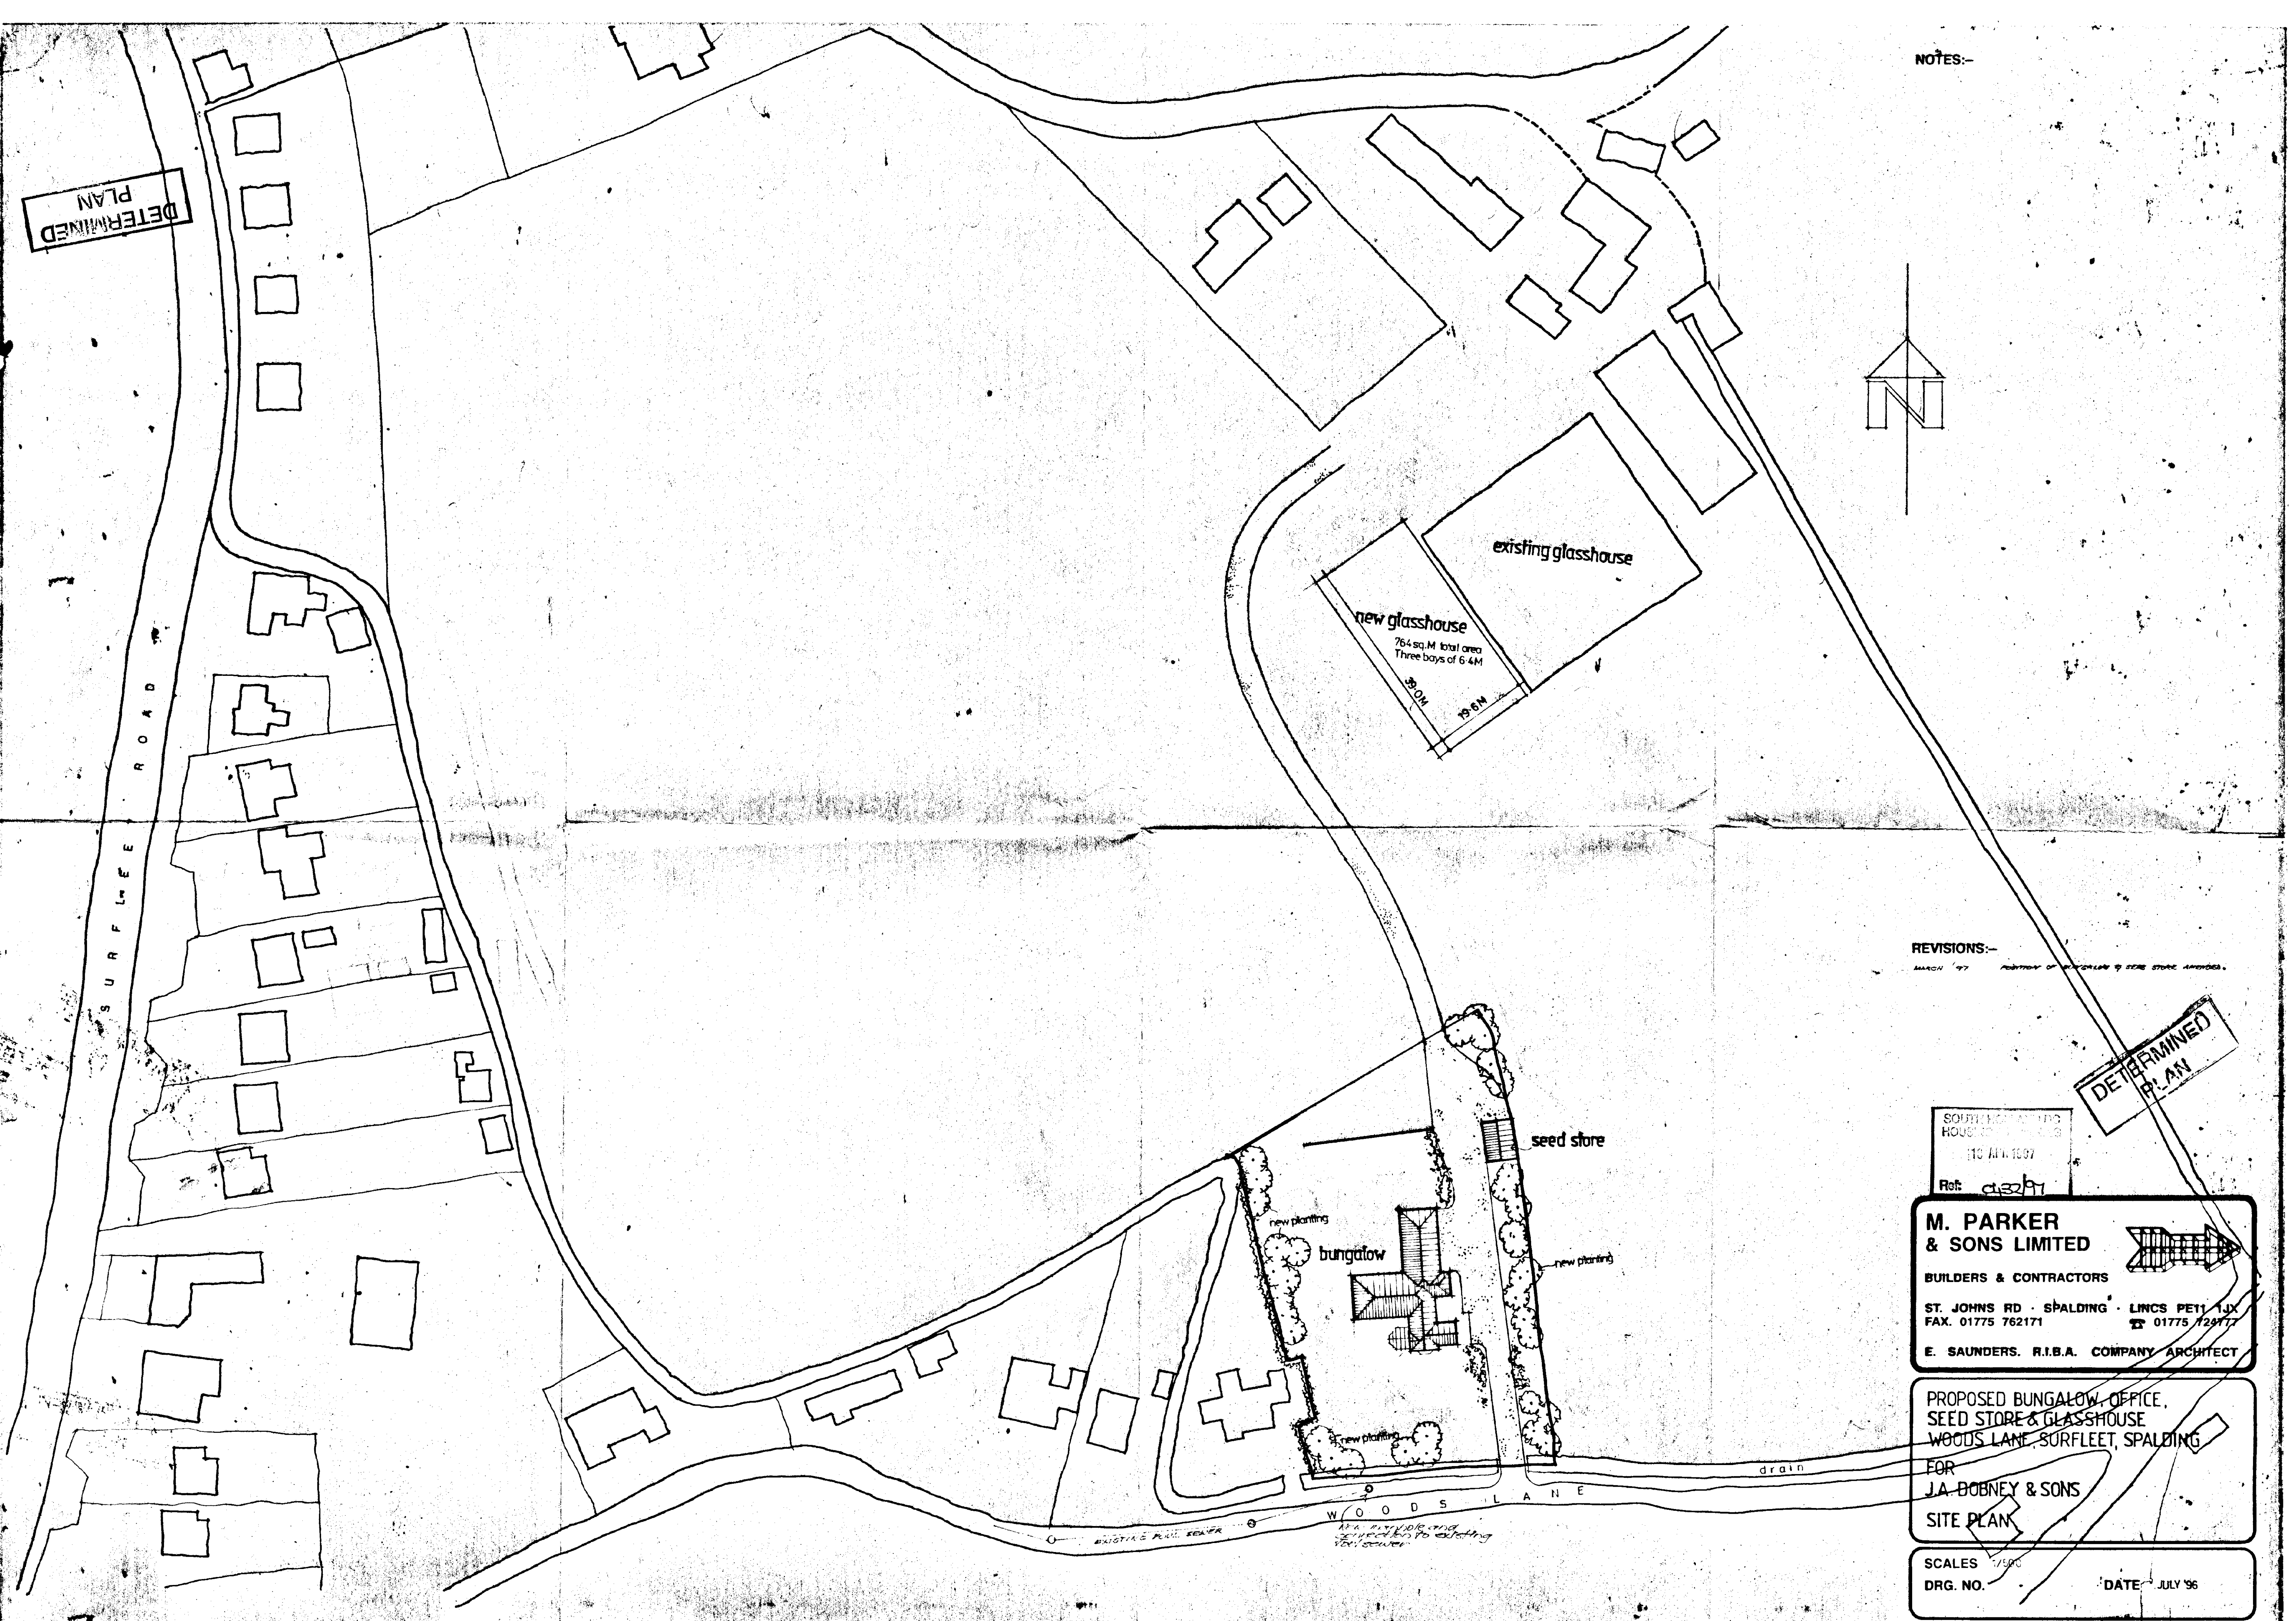


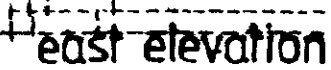[illegible]

Class in obs and side panels
to be laminated or fastened
to BS. G206 1981 within 600mm of floor level

[illegible]

Windows: 6 framed, double-glazed with 20" gap between shaft.

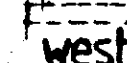



15 mm concrete floor slab
reinforced with 1 layer of 8 by
mesh on 100 g. ball of iron
d-pm on 100 g. ball of iron
core. felt d-pm to walls which
are to be constructed as
curb wall.
25 x 200 core strip found
on suitable load-bearing
stratum.

REVISIONS:-

1000 96. ~~Garage doors removed~~
 Garage doors removed
 May '97 ~~Interiors of school at 1000~~
 SHDC. Interiors of school at 1000
 Pass door added to fringe.
 May '97 window & door positions to school
 Store revisited
 chimney stack & large debris to
 Schoolyard revisited.
~~garage pass door set~~



BUNGALOW

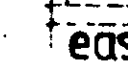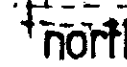

SEED STORE - plan, elevations, section

side,
glasshouse elevations scale - 1/200

SOUTH HOLLAND DC
HOUSING & PLANNING
27 MAY 1997
Ref: 0432/97

ASSIGNED PLAN

**M. PARKER
& SONS LIMITED**
BUILDERS & CONTRACTORS

ST. JOHNS RD • SPALDING • LINC'S PE11 1JX
FAX. 01775 762171 ☎ 01775 724777

E. SAUNDERS. R.I.B.A. COMPANY ARCHITECT

PROPOSED BUNGALOW, OFFICE,
SEED STORE & GLASSHOUSE
WOODS LANE, SURFLEET, SPALDING
FOR
J.A. DOBNEY & SONS
ELEVATIONS & SECTIONS, SEED ST. PLAN

SCALES 1/100, 1/50

DRG. NO.

DATE JULY '96