


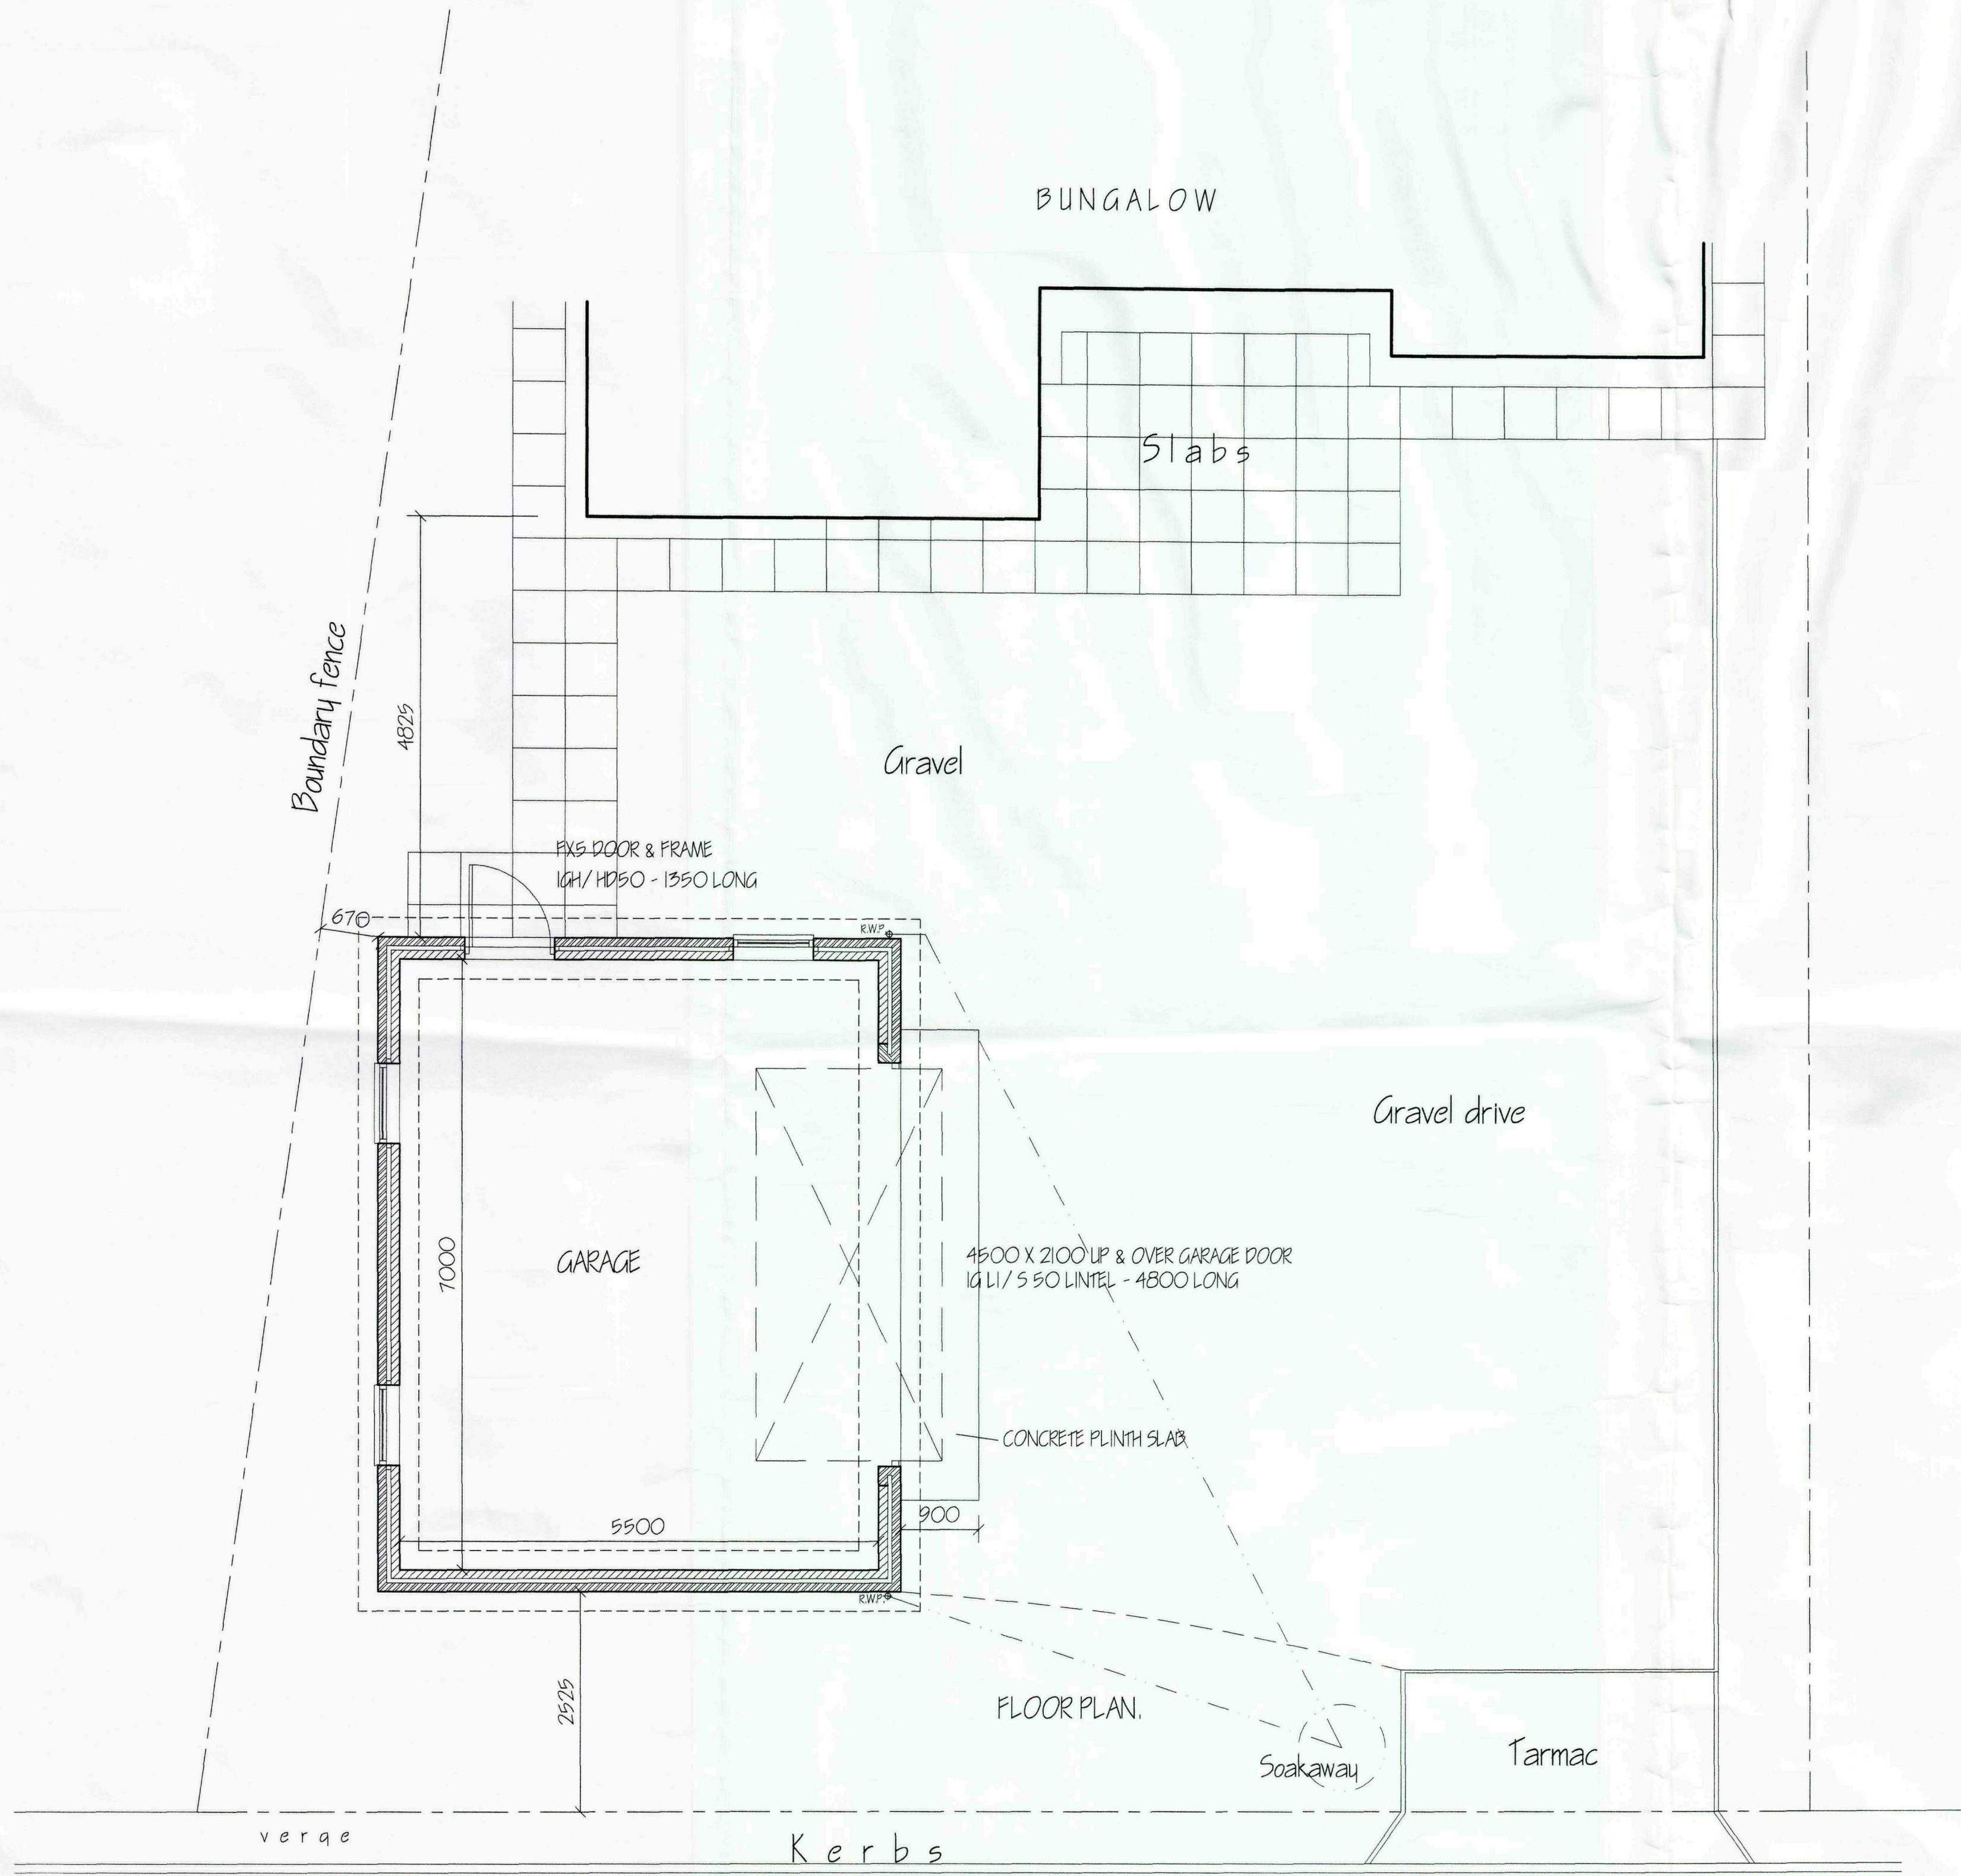

BUNGALOW

Slabs

Gravel


Gravel drive

FLOOR PLAN.


Tarmac

Kerbs


JARVIS GATE

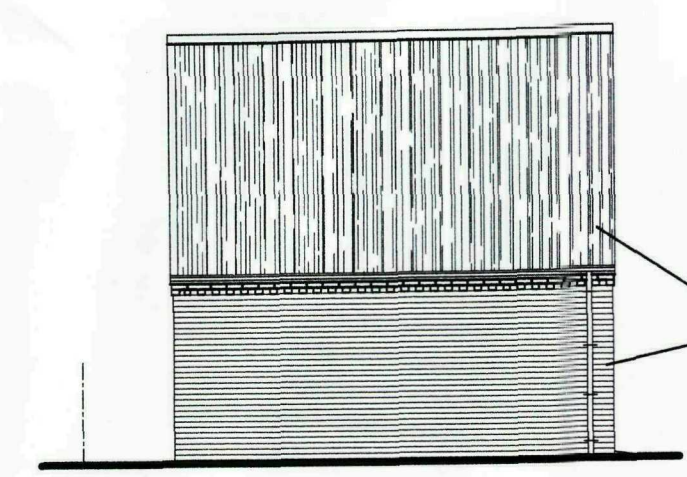


SIDE ELEVATION.

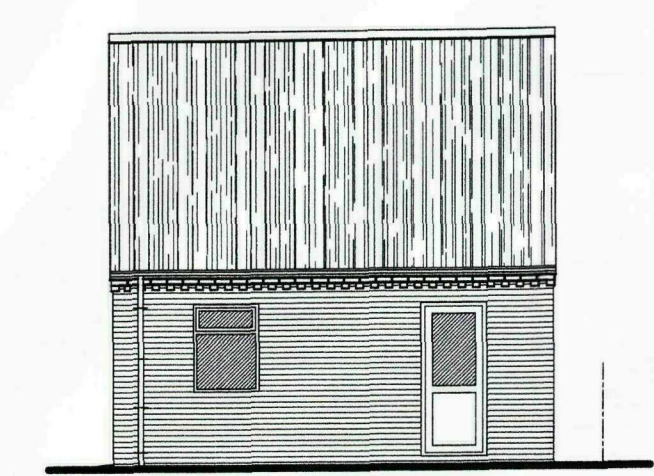


SIDE ELEVATION.

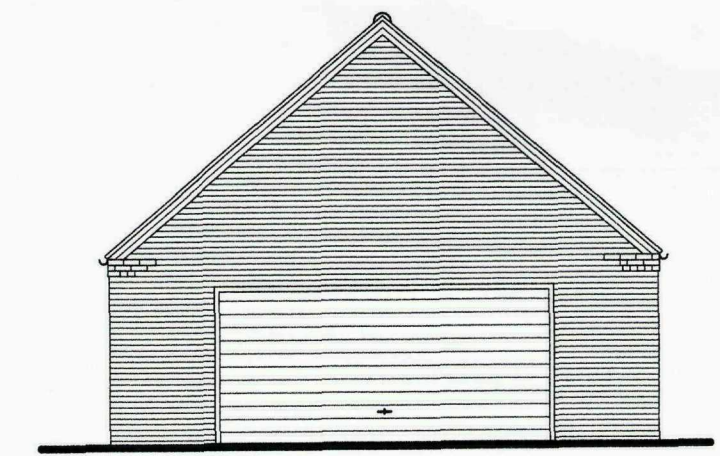

FRONT ELEVATION.

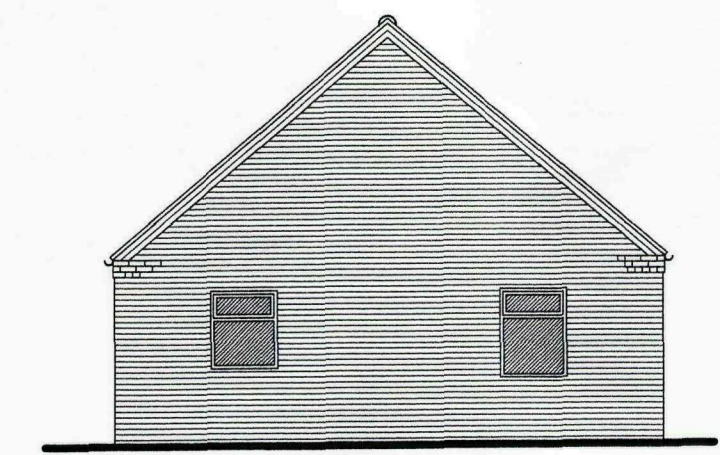

REAR ELEVATION.

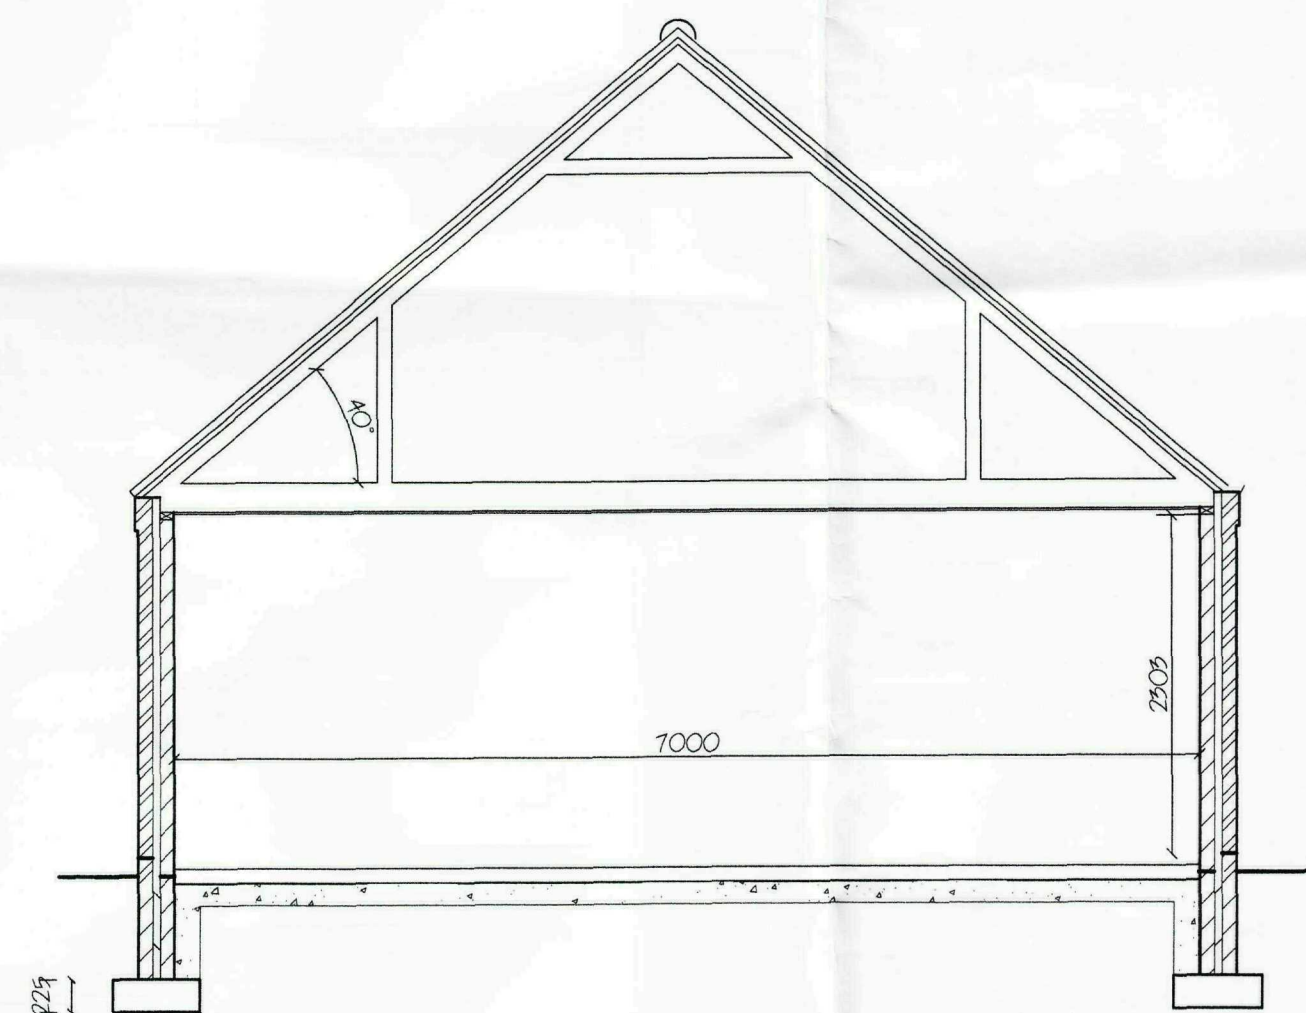

600 SECTION

ref	revision	date
F	AS BUILT SURVEY 26/01/10	JAN 10
E	CLIENTS AMENDMENTS	MAY 09
D	GLAZING REMOVED FROM PERSONAL DOOR - BY REG	JULY 08
C	BUILDING REGULATIONS APPLICATION	JULY 08
B	FOUNDATIONS ADDED	MAY 08
A	CLIENTS AMENDMENTS	APR 08

G. R. MERCHANT LTD.
I. ENG AMICE FIWO
**ARCHITECTURAL, STRUCTURAL
AND LAND DRAINAGE
CONSULTANTS**
4 Wrights Mews
12A Park Road, Holbeach,
Spalding, Lincs. PE12 7EE
Tel: 01406 480800
Fax: 01406 482744
E-Mail: gr.merchant@btconnect.com

Project
DETACHED DOUBLE GARAGE,
24 JARVIS GATE,
SUTTON ST JAMES,
SPALDING, Lincs.

Client
MR & MRS P. WATSON

Drawing
FLOOR PLAN & ELEVATIONS.
AS CONSTRUCTED

Job Ref.
1782/08.

Drawing No.
02F.

Date
APR 08

Drawn
S.H.

Scales
1/30, 1/100.

DO NOT SCALE FROM THIS DRAWING
This drawing is copyright and may not be altered, copied, photographed or used for any other purpose other than that for which it is issued. The Contractor is to check all dimensions on site and report any discrepancies to the Architect. All details shown on this drawing including foundations are based upon typical site conditions related to the area. No responsibility can be accepted for structural conditions which may be discovered during construction unless reported to the Architect in the Design Amendment form. Site not surveys are recommended in respect of foundations. The drawing is issued in the amount of information contained and does not purport to contain a full specification of the works. It is issued for the purpose of obtaining Planning / Building Regulations approval. This drawing must not be used as a contract document. The works will not be supervised or inspected on site by G.R. Merchant or any representative thereof. It is the client or their appointed agents responsibility to ensure workmanship, submission of materials, adherence to specifications, variations to contract etc. All materials to be used unless otherwise stated and all components and materials etc. to be used fixed and installed etc. in strict accordance with manufacturers instruction and relevant code of practice. Materials shall conform to appropriate British standard specification or BSIs certificate or European code equivalent. The Employer / Client shall ensure that the selected contractor is conversant with and adopts all measures necessary to ensure compliance with Health and Safety legislation for Building sites and Work places. The Employer / Client is advised that should the works need to comply with the Construction Design and Management Regulations an independent Planning Supervisor will be required. The works shall comprise of all that is shown on the drawing and details, which may not specifically be shown but may be reasonably inferred as necessary to carry out the works shall be carried out by the contractor. It is the client / contractor responsibility to be aware of the Party Wall etc. Act 1996, when building in close proximity to adjoining neighbours boundaries.

Ref: 1782/08-09
7 JAN 2010
S.H.C.