


PLANNING AMMENDMENT APPLICATION re 421/0027/02
EXTRA WINDOW AS SHOWN IN RED

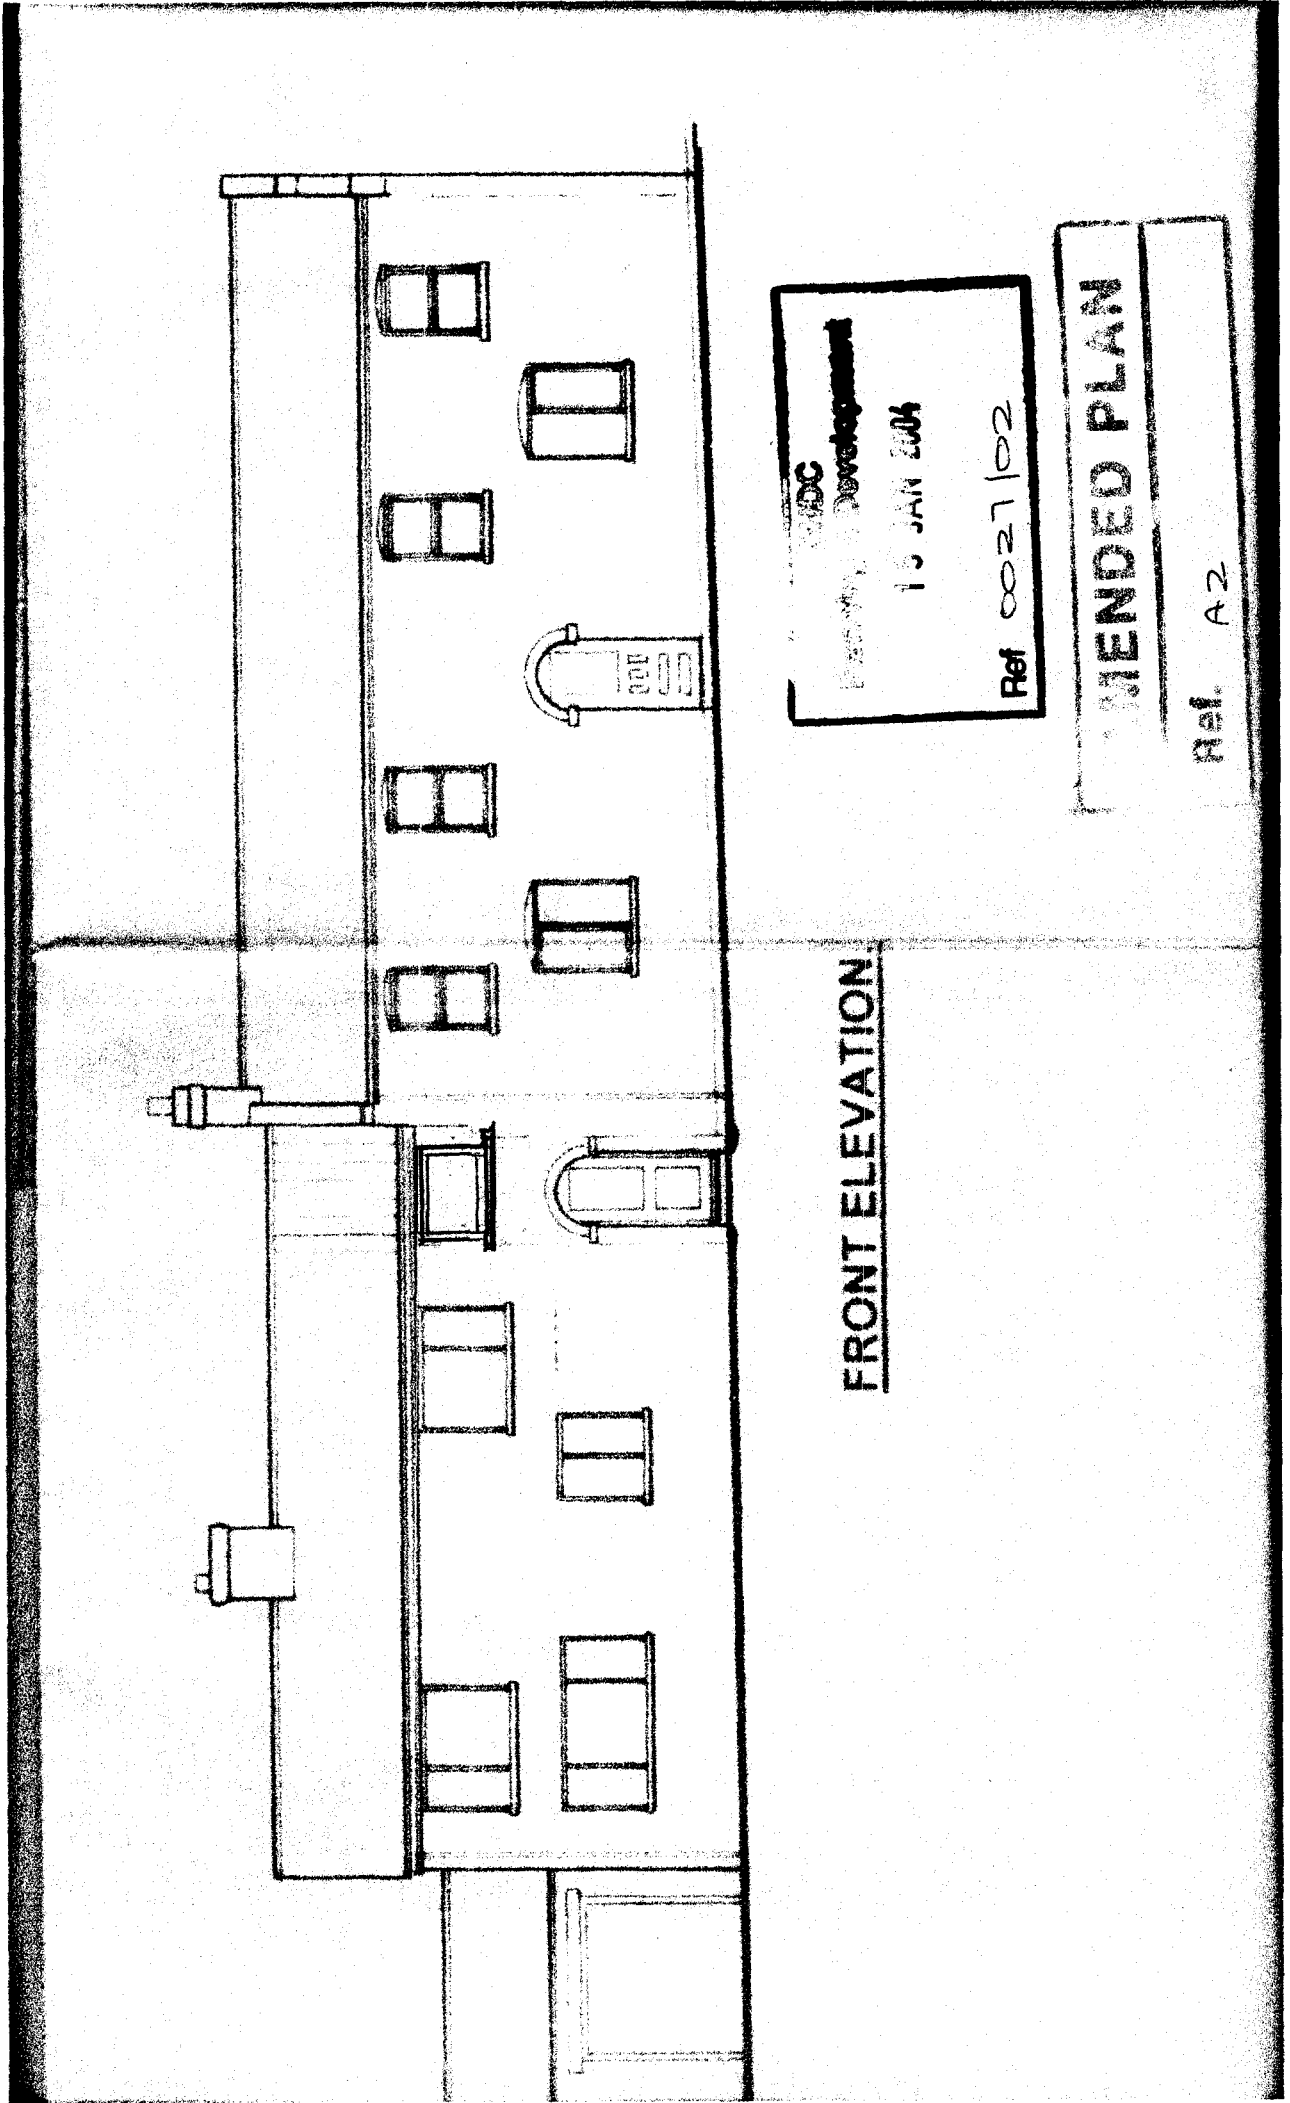


FRONT ELEVATION

DCDC
Development
15 JAN 2004
Ref 0027/02


RENDERED PLAN

Ref. A2

PLANNING AMMENDMENT APPLICATION re H21/0027/02.
EXTRA WINDOW AS DRAWN IN RED

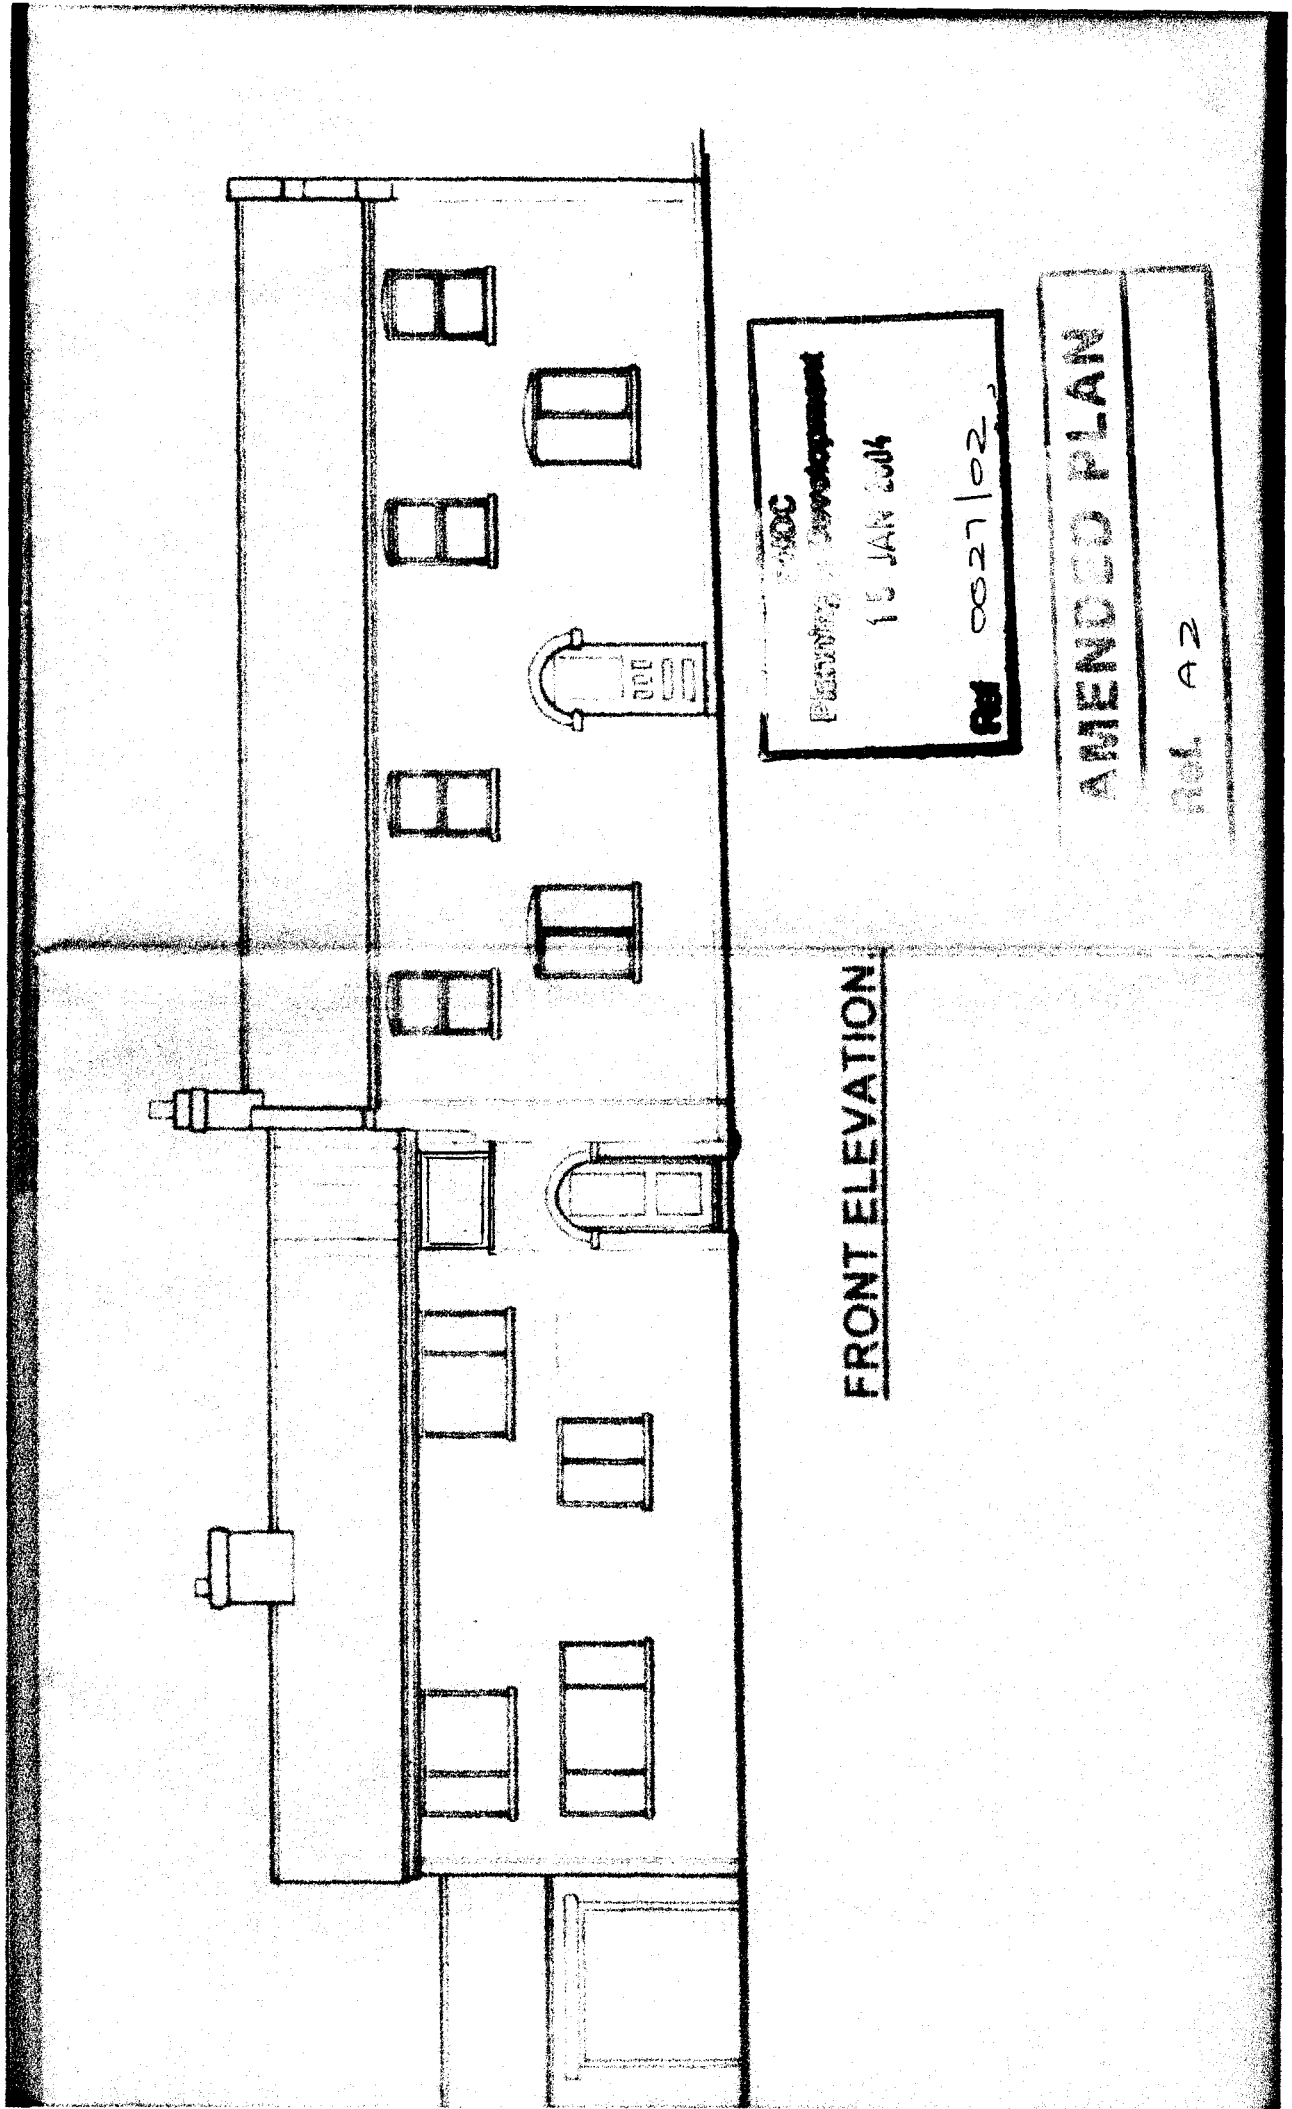

FRONT ELEVATION

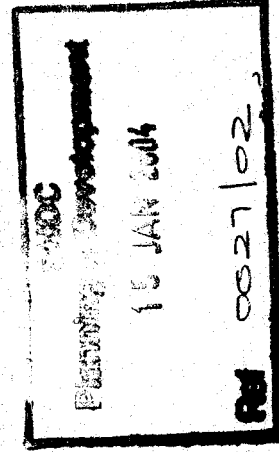

AMENDED PLAN

Ref. A2

PLANNING AMENDMENT

For office use only

Application No.

1121/0027/02

Date Registered

113 MAR 2002

Case Officer

~~2002~~ ~~WVH~~ ~~SL~~
LS

1. Please complete in block letters

NAME AND ADDRESS OF APPLICANT

MR + MRS J. BAKER
NO1 WEST ROAD + WESTGATE
HOUSE, WEST ROAD, TYDD GOTE
Tel. No. WISBECH

NAME AND ADDRESS OF AGENT

(if form completed by agent)

S. THROWER 3 NEWGATE ROAD
TYDD ST GILES, WISBECH, CAMBS

Tel. No.

(Contact)

Please complete in block letters

FULL POSTAL ADDRESS OF THE APPLICATION SITE

AS ABOVE.

Please complete

APPLICATION No. 1121/0027/02.

This amendment **cannot be considered**
unless the relevant reference is stated

Building Regulation reference relating to
same development (if any)

2. Please tick **one** box only

Amendment is proposed where
permission already granted

If yes, submit two forms and two plans.

A

☐

or

Amendment is to a proposal
currently being considered

If yes, submit four forms and four plans.

B

☒

Please complete

I attach the necessary plans and request that the changes described below be accepted as an amendment.
I understand that the Council may require a fresh application, together with fee if appropriate. If the
amendment relates to a current application, I agree to an extension of the terminal date.

Signed UNSWORTH pl. Applicant Date 13-3-02

3. Please complete in block letters

FULL DESCRIPTION OF DEVELOPMENT IN ORIGINAL APPLICATION

State details of amendments proposed

(Give a full detailed list of the changes, and
also mark these clearly on the accompanying plans.
Only the changes listed here will be considered.)

State drawing no's of the current submission

Has this amendment been requested by the Council?
(If so, state Officer dealing with the application)

Describe any part of the original development
which is excluded by virtue of the amendment,
and state any alteration to plot numbers

change of use of commercial areas
to residential plus elevational
alterations and extensions.

front window amendment.

SH 78601.

YES / ~~NO~~

Has a similar amendment been submitted under Building Regulations?

Yes / No

AMENDMENT RECORD SHEET - LIVE APPLICATION

Admin

Validation:

Inadequate/Inappropriate ☐

Clarification/Details required:

Appears valid ☒

Registered 24/11/02

Terminal date/committee updated 24/11/02

DC Procedural Assessment

Is the information given correct?

Yes/~~No~~ (If No, state above what details are needed)

Has this amendment been requested?
If Yes, is it what was asked for?

Yes/~~No~~ *
Yes/~~No~~ *

Who do you need to reconsult as a result of this amendment?

PC
WM
Press
Residents
Other -

None ☒

Is it an amendment in principle?

Yes/~~No~~

Is it the same character/description for fee purposes?

Yes/~~No~~ (Refer to Admin ?)

If No, but Yes to (*) requested :-

Do development objectives outweigh financial objectives?

Yes/~~No~~

Confirmed.....

REJECTED as an amendment - new application needed

Confirmed:

Notes/Advice/Rejection Reason:

☐

Tick if you wish this note to be a paragraph in the Rejection Notice

AUTHORISED to treat as amendment

Confirmed: U7S 13-3-02

Superseded details removed ☒

Give a revised description if the details accepted are different to the submission:

Acceptance issued:
Public register updated:

DC Professional Assessment

NOTES:

Application 

Location

Amendment Date

Type



Sub-Type



Description

Decision



Decision Date


ARCHITECTURAL

Design Services

3 Newgate Road,
Tydd St Giles,
Wisbech
Cambridgeshire
PE13 5LH

Telephone
01945 870022

Mr.B.Scriven
Director of Planning & Building Control,
South Holland District Council,
Council Offices,
Priory Road,
Spalding,
PE11 2XE

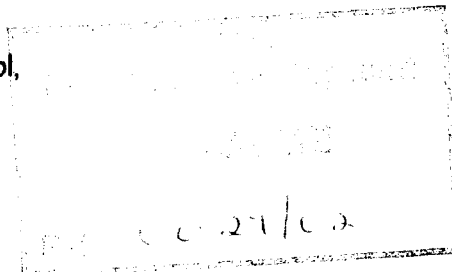

12th March 2002

Dear Sir

**REF: PROPOSED CHANGE OF USE OF COMMERCIAL AREAS TO RESIDENTIAL
ALONG WITH ELEVATIONAL ALTERATIONS AND EXTENSION AT NO 1 WEST ROAD
& WESTGATE HOUSE, WEST ROAD, TYDD GOTE, WISBECH.
FOR. MR.& MRS. J. BAKER.**

Following your recent discussions with Mr & Mrs Baker regarding the Main Showroom Window I now enclose a Sketch to show the Amendment

I await your further comments as soon as possible.


Yours faithfully
ARCHITECTURAL DESIGN SERVICES

S J Thrower

SHDC			
Planning & Development			
13 MAR 2002			
H P&D	PM	DC	POL
CONS	BC	ADMIN	PAO


6. 6000000 10000000 10000000

10000000 10000000 10000000
10000000 10000000 10000000
10000000 10000000 10000000

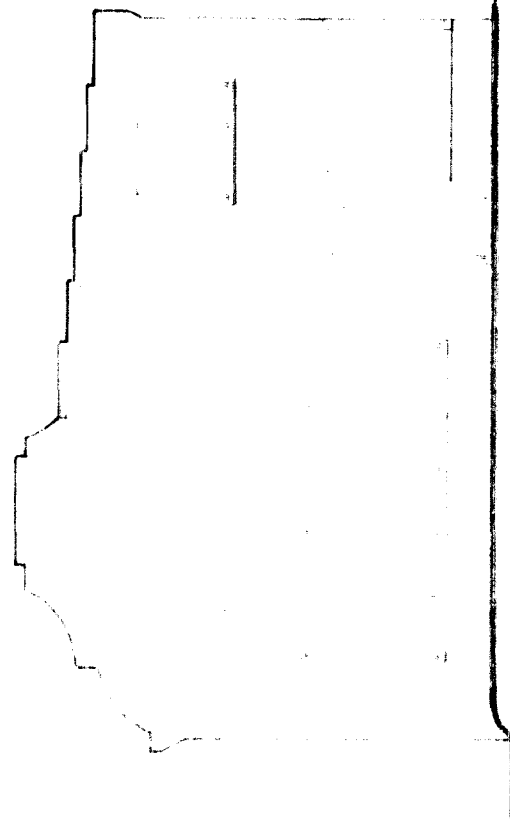

SIDE ELEVATION.

DETERMINED
10000000 10000000 10000000

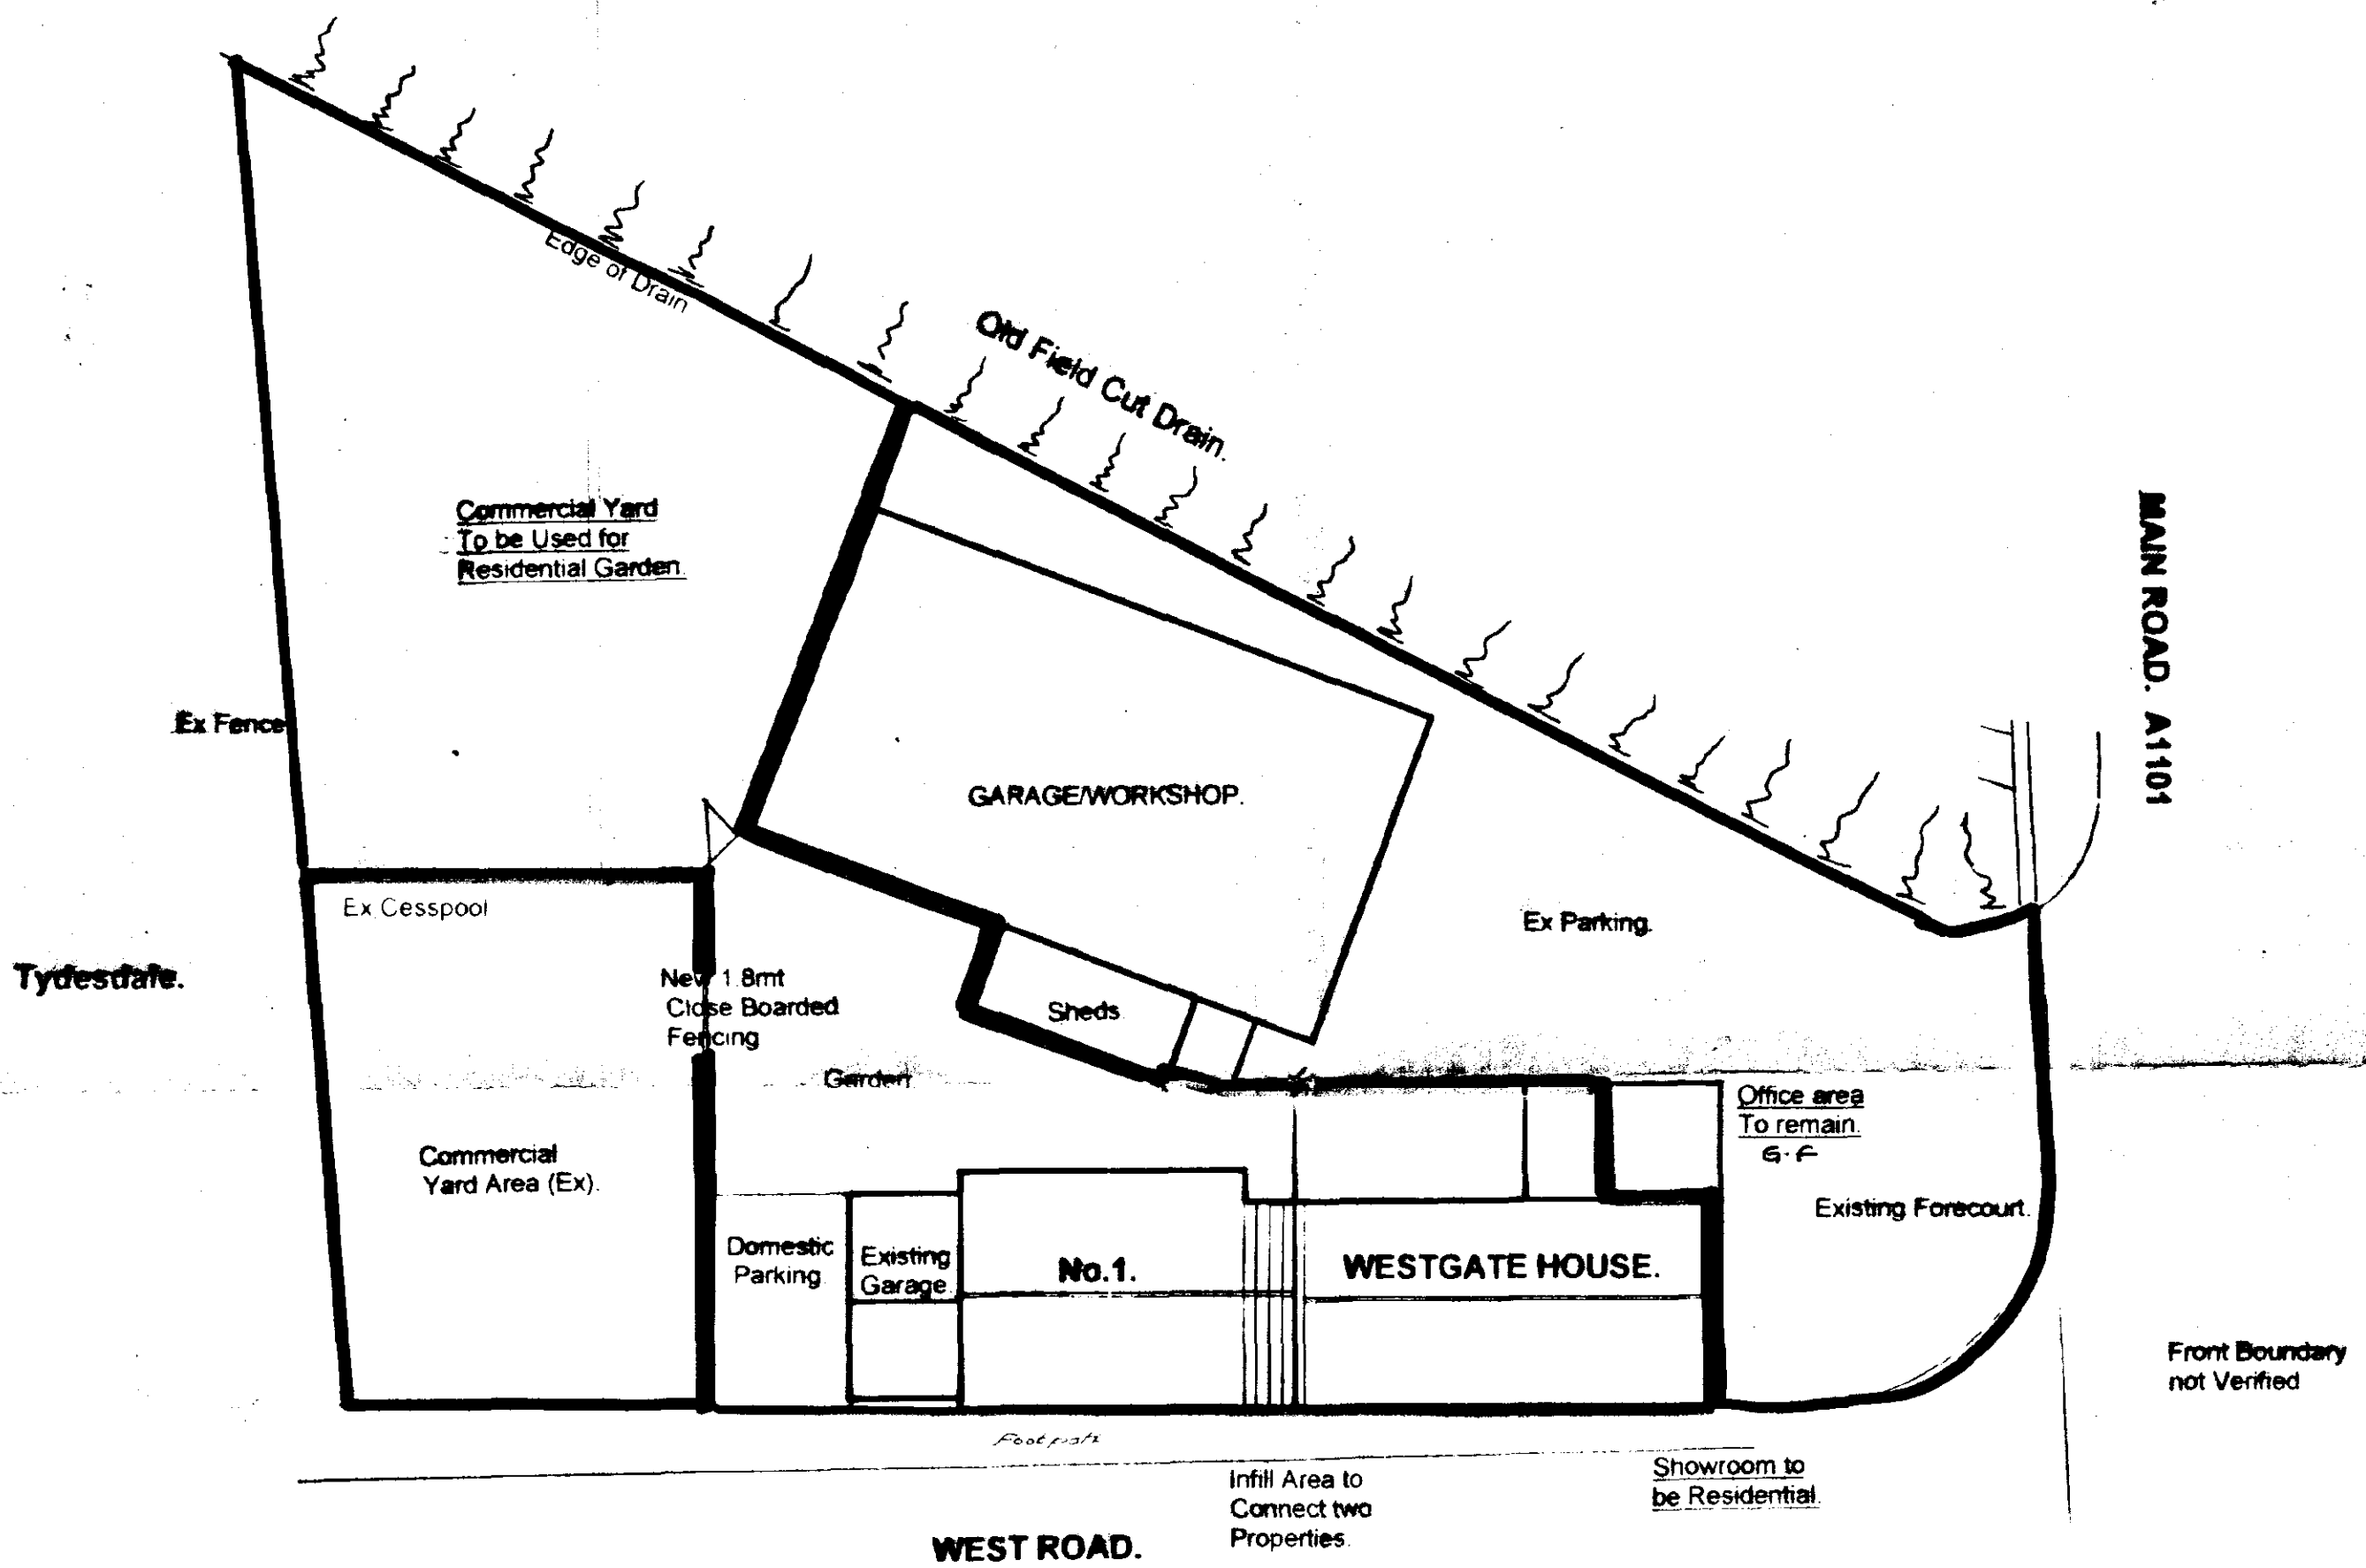

SITE PLAN 1:200.

PLANNING ISSUE.

Architectural
Design Services

S. J. Thrower

3 Newgate Road
Tydd St. Giles
Wisbech
Cambridgeshire
PE13 5LH
Telephone
01945 870022

**Change of Use of Commercial Areas
to Residential along with Elevational
Alterations and Extension at
No1 West Rd & Westgate House,
West Road, Tydd Gote, Wisbech.
For. Mr. & Mrs. J. Baker.**

SITE PLAN.

Scale 1: 200.	Date. Dec 01.	Drwn. J.	Chkd
---------------	---------------	-----------------	------

Drwg no. FD/78701.


SOUTH HOLLAND DC
HOUSING & PLANNING
11 JAN 2002

Ref: 0027102

EXISTING ELEVATIONS.




FRONT ELEVATION.

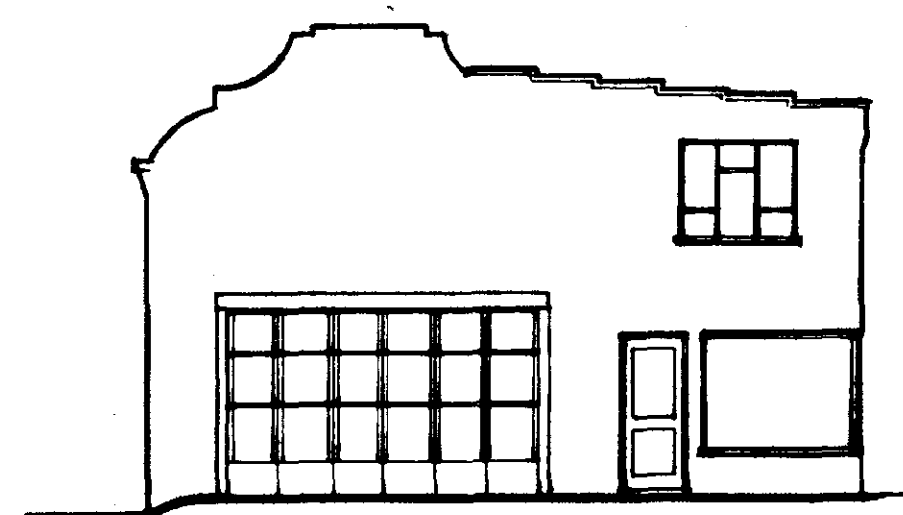

SIDE ELEVATION.



REAR ELEVATION.

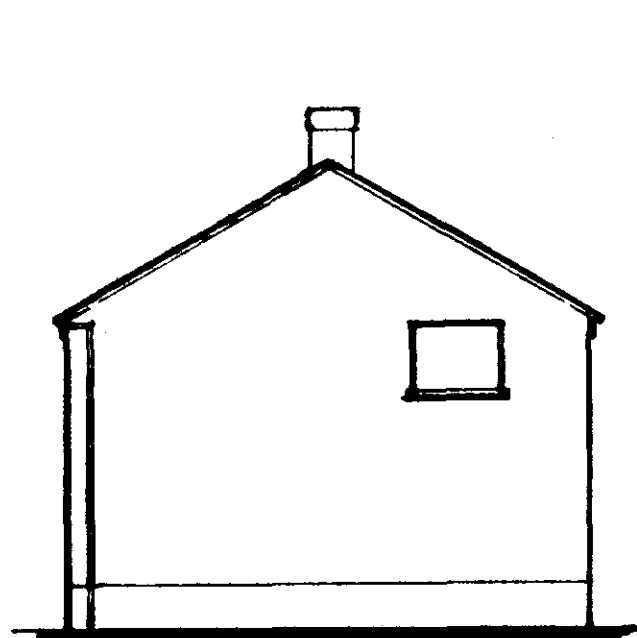


SIDE ELEVATION. (N=)




SIDE ELEVATION. (WESTGATE)

PROPOSED ELEVATIONS.

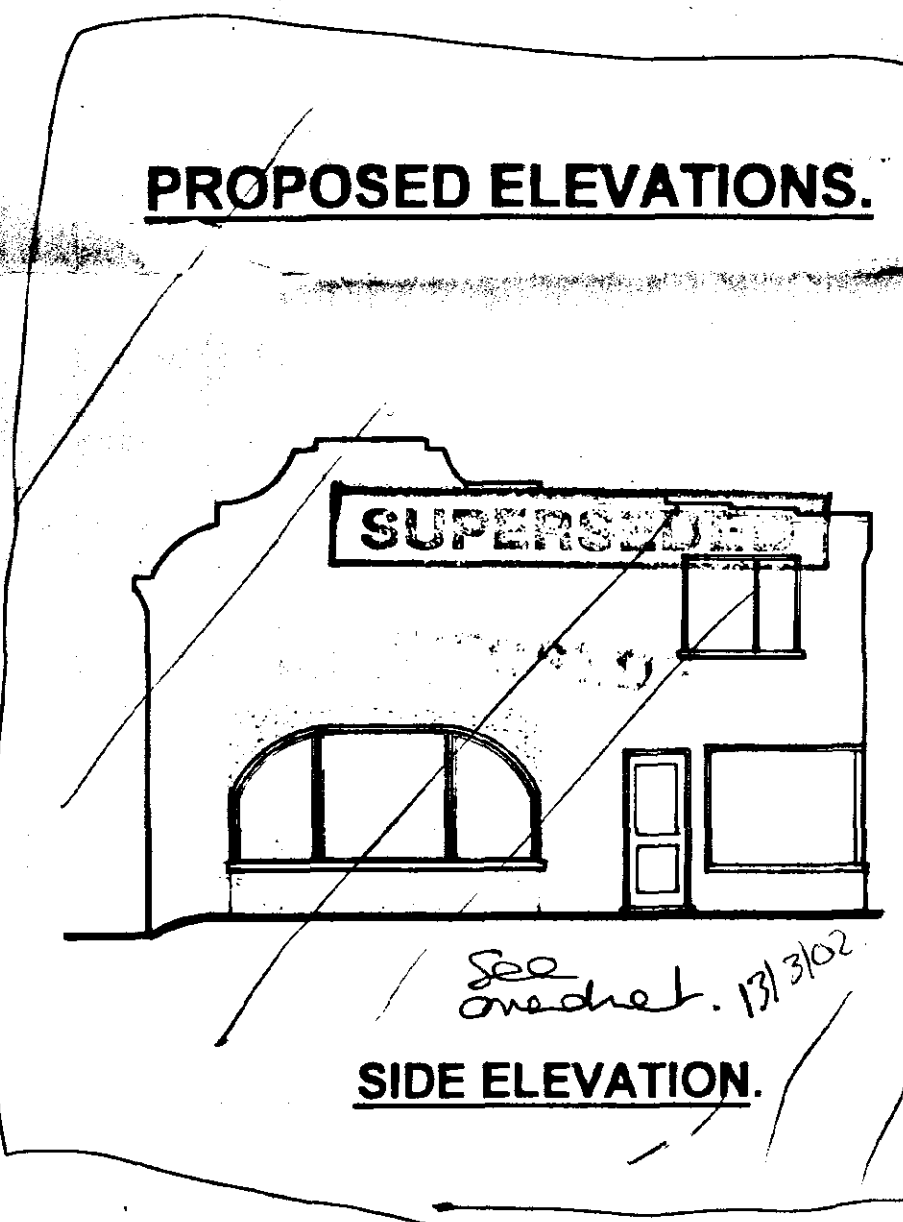

FRONT ELEVATION.

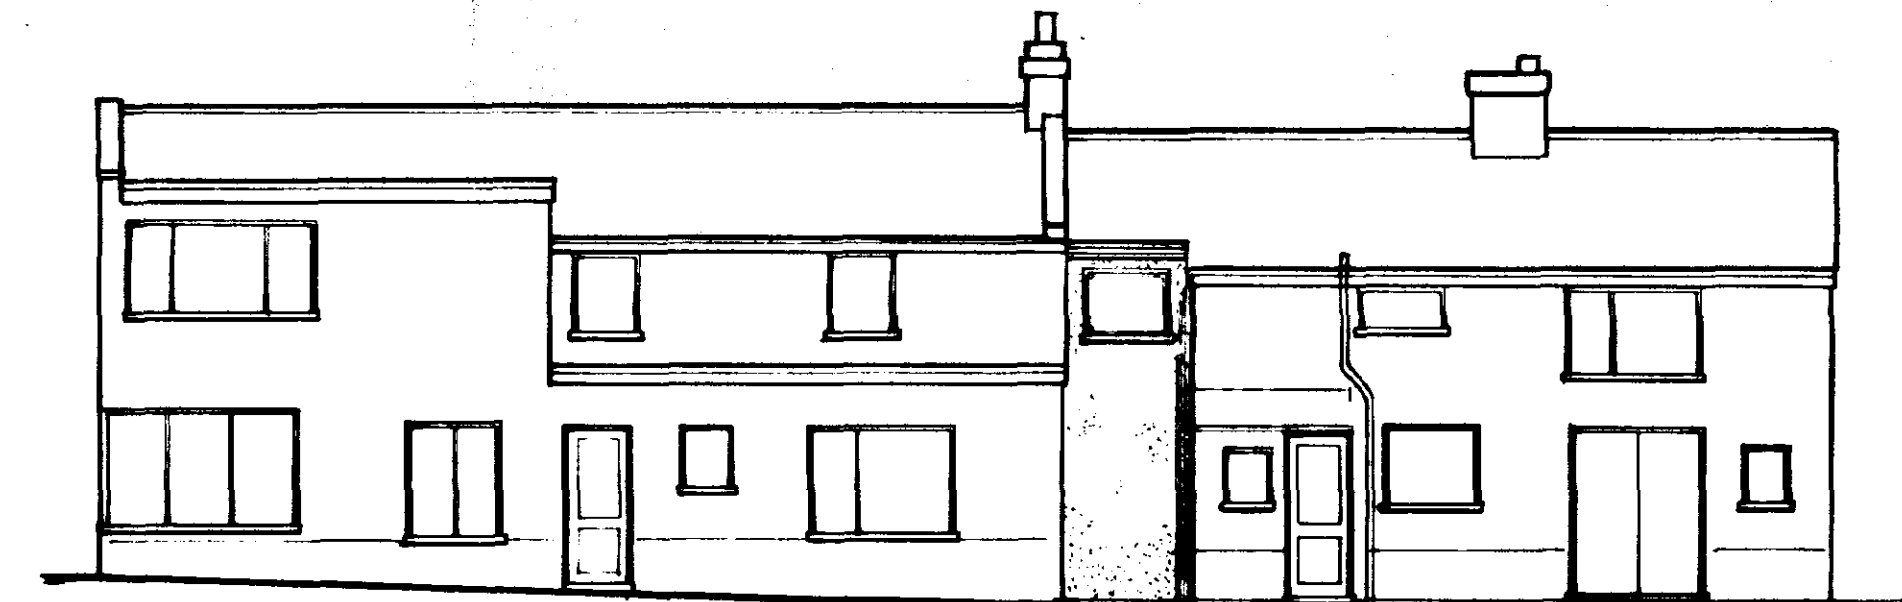

REAR ELEVATION.

**DETERMINED
PLAN**

PLANNING ISSUE

Architectural

Design Services.
S.J. Thrower.

3 Newgate Road, Tydd St. Giles, Wisbech, Cambridgeshire.
Tel. 01945 870122.


**Change of Use of Commercial Areas
to Residential along with Elevational
Alterations and Extension at
No1 West Road & Westgate House,
West Rd, Tydd Gote, Wisbech.
For. Mr. & Mrs. J. Baker.**

EX & PROPOSED ELEVATIONS.


Scale 1: 100. Date. Dec. 01. Drwn. Chkd.

Drwg no. SH/78601.

SOUTH HOLLAND DC
HOUSING & PLANNING
11 JAN 2002
Ref: 0027102

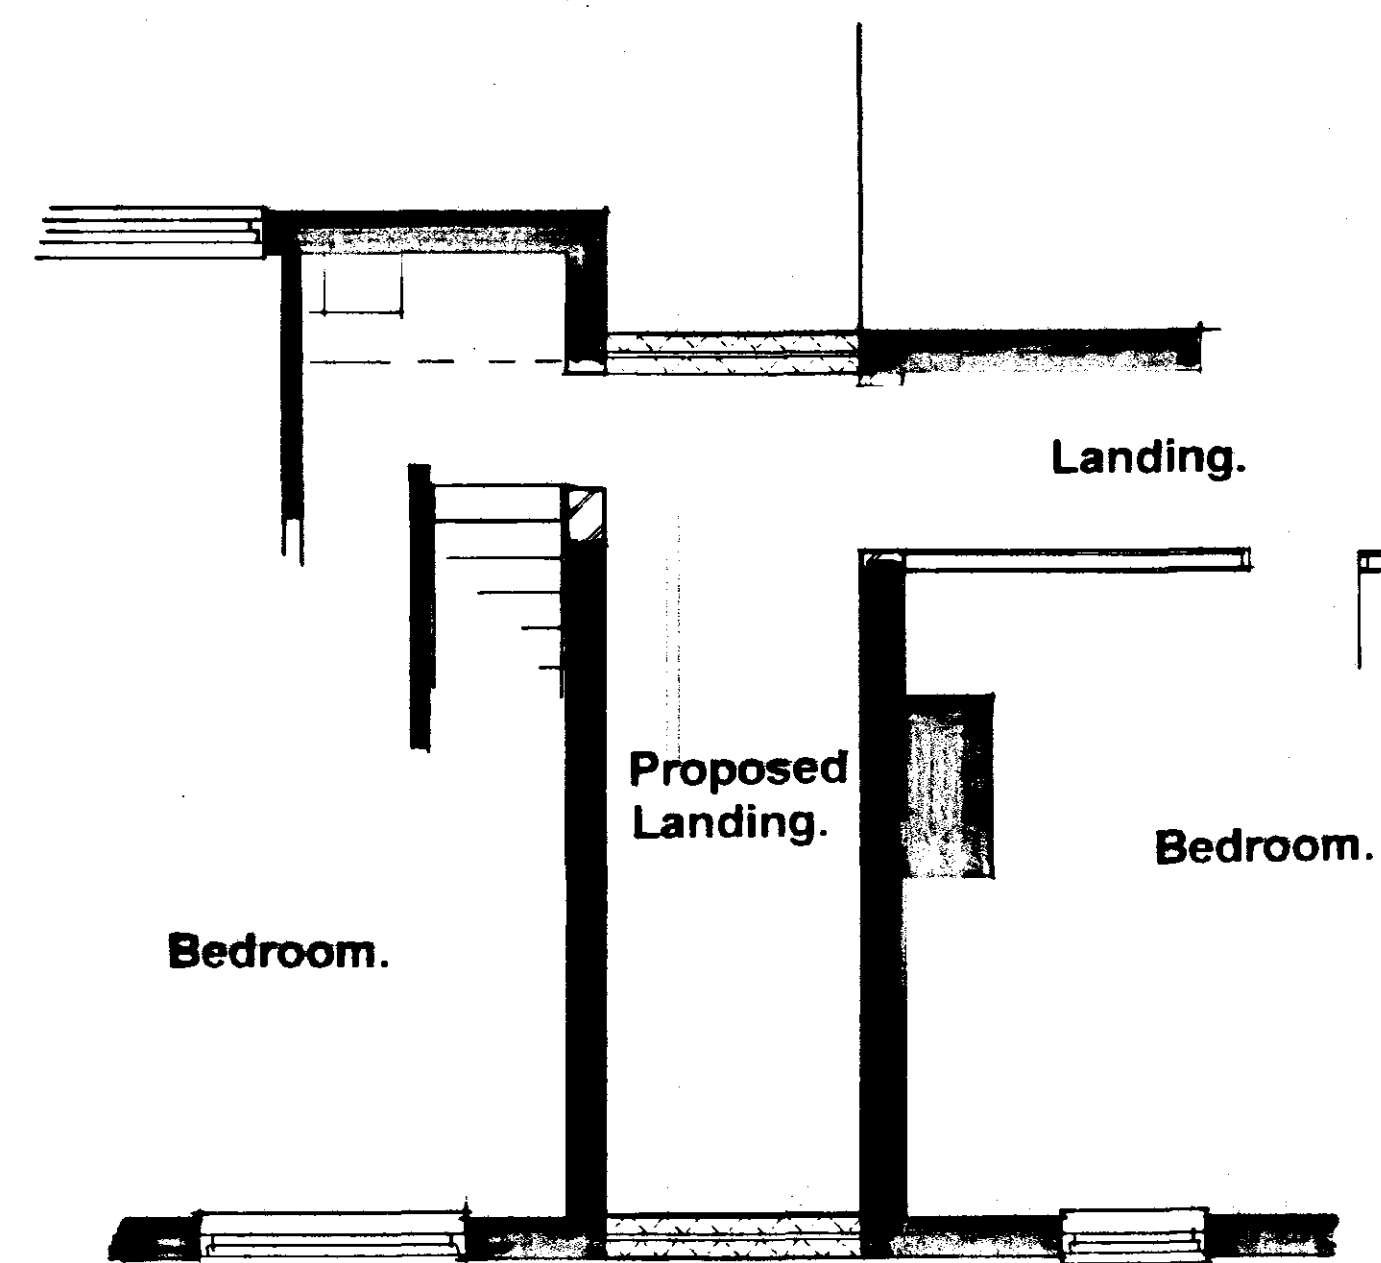

PROPOSED FIRST FLOOR PLAN.
Alterations to Combine Existing
Properties via new Landing.

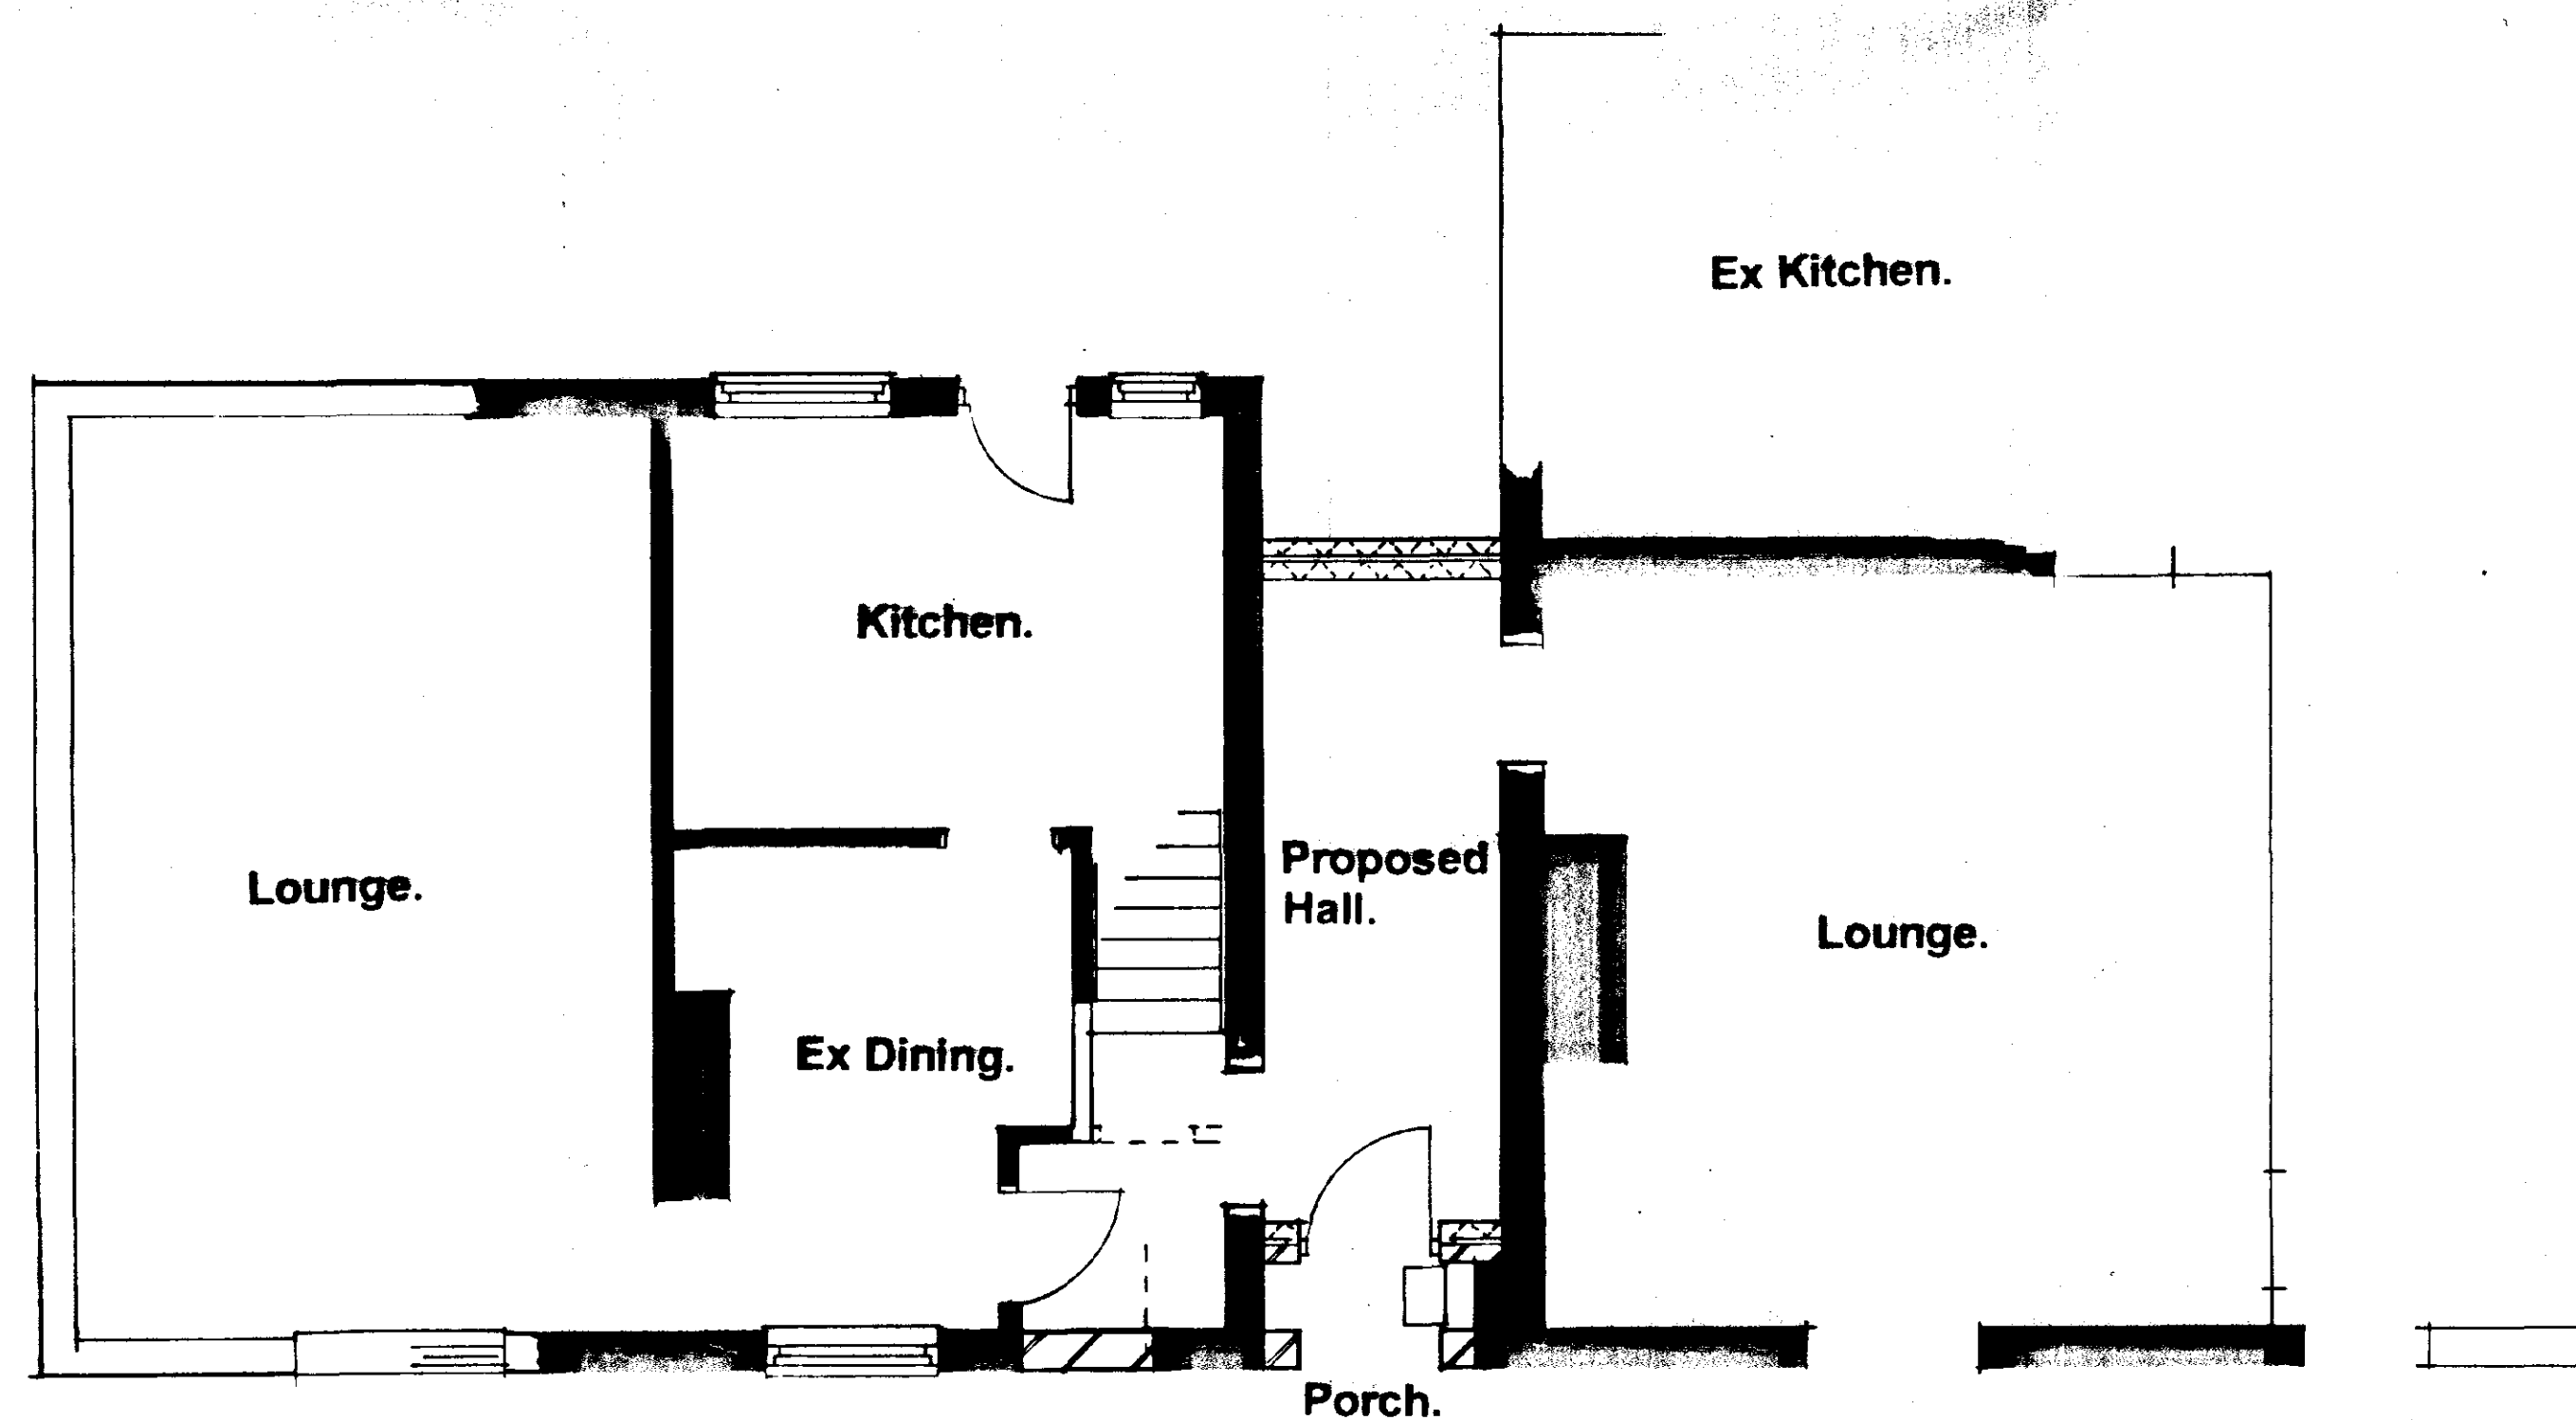

PROPOSED GROUND FLOOR PLAN.
Alterations to Combine Existing
Properties via new Hall.

**DETERMINED
 PLAN**

PLANNING ISSUE.

Architectural

Design Services.
 S.J. Thrower.

3 Newgate Road, Tydd St Giles, Wisbech, Cambridgeshire.
 Tel. 01945 870022.

**Change of Use of Commercial Areas
 to Residential along with Elevational
 Alterations and Extension at
 No1 West Rd & Westgate House,
 West Road, Tydd Gote, Wisbech.
 For Mr. & Mrs. J. Baker.**

EXTENSION & ALTERATIONS.

Scale 1: 50. Date: Dec 01. Drwn. JF Chkd.

Drwg no. SH/78501.

SOUTH FOLLAND DC
 HOUSING & PLANNING
 11 JAN 2002
 Ref: 0057100