

PLANNING AMENDMENT

For office use only

Application No.

Date Registered

Case Officer

H22/1119/96
16 JAN 1997
JRS

1. Please complete in block letters

NAME AND ADDRESS OF APPLICANT

WESTON VILLAGE HALL STEERING
COMMITTEE

Tel. No.

NAME AND ADDRESS OF AGENT

(if form completed by agent)

JOHN WOODWARD CONSULTANT
HIGH HOUSE
SCOPWICK LINCOLN LN4 3PA

Tel. No. 01526 320298 (Contact) Mr Woodward

Please complete in block letters

FULL POSTAL ADDRESS OF THE APPLICATION SITE

WESTON ST MARK PRIMARY SCHOOL PLAYING FIELD

Please complete

APPLICATION No.

This amendment cannot be considered
unless the relevant reference is stated

H22/1119/96

Building Regulation reference relating to
same development (if any)

N/A

OFFICE
COPY

2. Please tick **one** box only

Amendment is proposed where
permission already granted

If yes, submit two forms and two plans.

A

☐

or

Amendment is to a proposal
currently being considered

If yes, submit four forms and four plans.

B

☒

Please complete

I attach the necessary plans and request that the changes described below be accepted as an amendment.
I understand that the Council may require a fresh application, together with fee if appropriate. If the
amendment relates to a current application, I agree to an extension of the terminal date.

Signed John Woodward Date 15.1.97

3. Please complete in block letters

FULL DESCRIPTION OF DEVELOPMENT IN ORIGINAL APPLICATION

SITE FOR CONSTRUCTION OF
A NEW VILLAGE HALL

State details of amendments proposed

(Give a full detailed list of the changes, and
also mark these clearly on the accompanying plans.
Only the changes listed here will be considered.)

WIDENING OF MAIN ROAD
TO 5.0M. OVER A 40M LONG
SECTION OF ROAD AT ENTRANCE
TO SITE

State drawing no's of the current submission

NO NUMBER.

Has this amendment been requested by the Council?
(If so, state Officer dealing with the application)

YES / NO MY BLACKLOCK PER
HIGHWAYS DEPT.

Describe any part of the original development
which is excluded by virtue of the amendment,
and state any alteration to plot numbers

N/A

Has a similar amendment been submitted under Building Regulations?

☒ Yes / ☐ No

AMENDMENT RECORD SHEET - LIVE APPLICATION

Admin

Validation:

Inadequate/Inappropriate ☐

Clarification/Details required:

Appears valid ☒

Registered *16/11*

Terminal date/committee updated *13/3 2011*

DC Procedural Assessment

Is the information given correct?

Yes/~~No~~ (If No, state above what details are needed)

Has this amendment been requested?
If Yes, is it what was asked for?

Yes/~~No~~ *
Yes/~~No~~ *

Who do you need to reconsult as a result of this amendment?

PC ☒ None ☐
WM ☒
Press ☒ *20/11*
Residents
Other -

Is it an amendment in principle?

Yes/~~No~~

Is it the same character/description for fee purposes?

Yes/~~No~~ (Refer to Admin ?)

If No, but Yes to (*) requested :-

Do development objectives outweigh financial objectives?

Yes/No

Confirmed.....

REJECTED as an amendment - new application needed

Confirmed:

Notes/Advice/Rejection Reason:

☐ Tick if you wish this note to be a paragraph in the Rejection Notice

AUTHORISED to treat as amendment

Confirmed: *17/11/11*

Superseded details removed ☒

Give a revised description if the details accepted are different to the submission:

Acceptance issued:
Public register updated: *20/11*

DC Professional Assessment

NOTES:

Housing & Planning Services Department
Council Offices,
Priory Road, Spalding,
Lincolnshire. PE11 2XE

Telephone: (01775) 761161
Fax: (01775) 710772

OBJECTION



HOUSING & PLANNING
SERVICES DEPARTMENT

Application no: H22/1119/96

Applicant: Weston Village Hall Steering
Committee, c/o The Secretary
12 Golden Harvest Way
Whaplode
Spalding Lincs PE12 6UU

Agent: John Woodward Consultant
High House
Scopwick
Lincoln
LN4 3PA

Description: Site for construction of a
new village hall

Location: Weston St Mary Primary School
Playing Field, Small Drove
Weston
Spalding

Amendment: Widening of main road to 5.0 metres over a 40 metre long
section of road at entrance to site

20-JAN-97

Dear Sir/Madam

ACKNOWLEDGEMENT OF AMENDMENT

I acknowledge receipt of the amended details in respect of the above proposal. These have been incorporated into the application which will now only be considered in its amended form.

The terminal date for dealing with the application has now been extended to 13-MAR-97, based on the date of receipt of the amendment, and your rights of appeal remain as explained on the original acknowledgement.

You are reminded that revision to any submission made under the Building Regulations may also be necessary.

Yours faithfully

Director of Housing and Planning Services

PLANNING AMENDMENT

For office use only

Application No. H22/1119/96
Date Registered 24 FEB 1997
Case Officer JIS

1. Please complete in block letters

NAME AND ADDRESS OF APPLICANT

WESTON VILLAGE HALL
STEERING COMMITTEE

Tel. No.

NAME AND ADDRESS OF AGENT

(if form completed by agent)

JOHN WOODWARD CONSULTANT
HIGH HOUSE
SCOPWICK, LINCOLN, LN4 3PA
Tel. No. 01526 320498 (Contact) J. W.

Please complete in block letters

FULL POSTAL ADDRESS OF THE APPLICATION SITE

WESTON ST. MARY PRIMARY SCHOOL PLAYING FIELD

Please complete

APPLICATION No.

This amendment **cannot** be considered
unless the relevant reference is stated

H22/1119/96

Building Regulation reference relating to
same development (if any)

N/A

OFFICE
COPY

2. Please tick **one** box only

Amendment is proposed where
permission already granted

If yes, submit two forms and two plans.

A

☐

or

Amendment is to a proposal
currently being considered

If yes, submit four forms and four plans.

B

☒

Please complete

I attach the necessary plans and request that the changes described below be accepted as an amendment.
I understand that the Council may require a fresh application, together with fee if appropriate. If the
amendment relates to a current application, I agree to an extension of the terminal date.

Signed John Woodward

Date 21.2.97

3. Please complete in block letters

FULL DESCRIPTION OF DEVELOPMENT IN ORIGINAL APPLICATION

SITE FOR CONSTRUCTION OF A
NEW VILLAGE HALL

State details of amendments proposed

(Give a full detailed list of the changes, and
also mark these clearly on the accompanying plans.
Only the changes listed here will be considered.)

RETHAPING OF SITE BOUNDARY
AND RELOCATION OF LOCATION OF
HALL AND CAR PARK

State drawing no's of the current submission

NO NUMBER / ENTITLED "REVISED PRELIM.
STUDY FOR LOCATION OF BLDG"

Has this amendment been requested by the Council?
(If so, state Officer dealing with the application)

YES / NO

MW. J. BLACKLOCK

Describe any part of the original development
which is excluded by virtue of the amendment,
and state any alteration to plot numbers

N/A

Has a similar amendment been submitted under Building Regulations?

☐ / No

Housing & Planning Services Department
Council Offices,
Priory Road, Spalding,
Lincolnshire, PE11 2XE

Telephone: (01775) 761161
Fax: (01775) 710772



Application no: H22/1119/96

Applicant: Weston Village Hall Steering Committee, c/o The Secretary
12 Golden Harvest Way
Whaplode
Spalding Lincs PE12 6UU
Description: Site for construction of a new village hall

Agent: John Woodward Consultant
High House
Scopwick
Lincoln
LN4 3PA

Location: Weston St Mary Primary School
Playing Field, Small Drove
Weston
Spalding

Amendment: Reshaping of site boundary and relocation of hall and car park

27-FEB-97

Dear Sir/Madam

ACKNOWLEDGEMENT OF AMENDMENT

I acknowledge receipt of the amended details in respect of the above proposal. These have been incorporated into the application which will now only be considered in its amended form.

The terminal date for dealing with the application has now been extended to 21-APR-97, based on the date of receipt of the amendment, and your rights of appeal remain as explained on the original acknowledgement.

You are reminded that revision to any submission made under the Building Regulations may also be necessary.

Yours faithfully

Director of Housing and Planning Services

AMENDMENT RECORD SHEET - LIVE APPLICATION

Admin

Validation:

Inadequate/Inappropriate

Clarification/Details required:

Appears valid

Registered

Terminal date/committed
updated

DC Procedural Assessment

Is the information given correct?

Yes/No (If No, state above what
details are needed)

Has this amendment been requested?
If Yes, is it what was asked for?

Yes/No *
Yes/No *

Who do you need to reconsult as a
result of this amendment?

PC ✓ None
WM ✓ 27/12

Press

Residents

Other -

objectors only + 23 edgefield
3 size notices please
27/12

Is it an amendment in principle?

Yes/No

Is it the same character/description
for fee purposes?

Yes/No (Refer to Admin ?)

If No, but Yes to (*) requested :-

Do development objectives outweigh
financial objectives?

Yes/No

Confirmed.....

REJECTED as an amendment - new
application needed

Confirmed:

Notes/Advice/Rejection Reason:

AUTHORISED to treat as amendment

Confirmed: 27/12/17

Superseded details removed

Give a revised description if
the details accepted are
different to the submission:

☐ Tick if you wish this note to be
a paragraph in the Rejection Notice

Acceptance issued:
Public register updated: 27/12/17


DC Professional Assessment

NOTES:


AMENDED PLAN

Ref.

All rights under Sec4 of the
Copyright Designs and Patents Act 1988
are here asserted

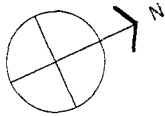

SOUTH WILKLAND DC
HOUSING & PLANNING
24 FEB 1997
Ref: 1119/96

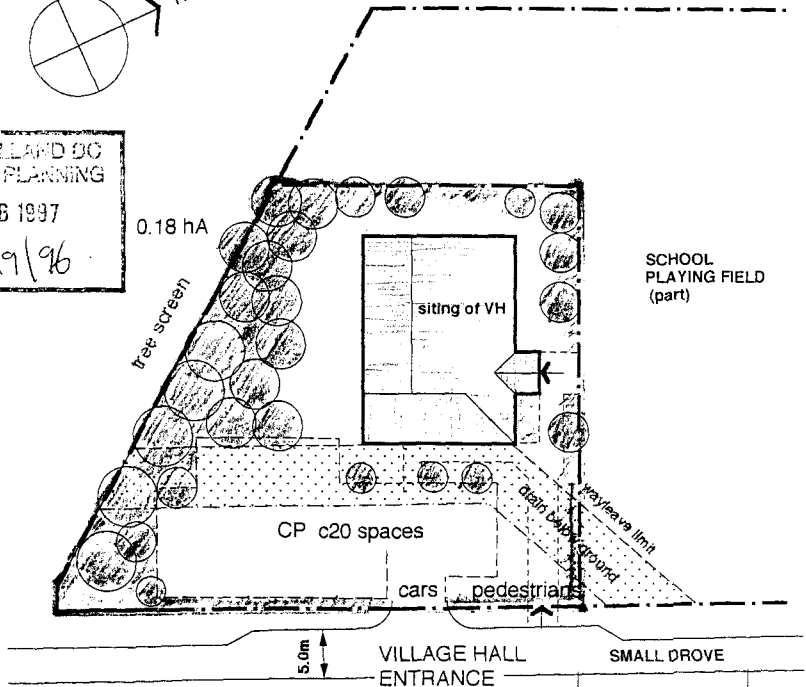

Revisions to previous Plan:

North & West boundaries of site squared up
site area increased by 0.03 ha.

Hall building moved east and northwards

Carpark and vehicle entrance moved northwards

Tree screen (nom. 10m wide) introduced on southern boundary



1:500

WESTON VILLAGE HALL

FEASIBILITY STUDY

REVISED

SITE PLAN SHOWING LOCATION OF BUILDING & CP

February 1997



AMENDED PLAN

Ref.

DO NOT REMOVE FROM
FILE

All rights under Sec4 of the
Copyright Designs and Patents Act 1988
are here asserted

SOUTH HOLLAND DC
HOUSING & PLANNING
24 FEB 1997
Ref: 1119/96

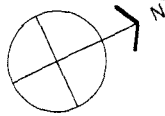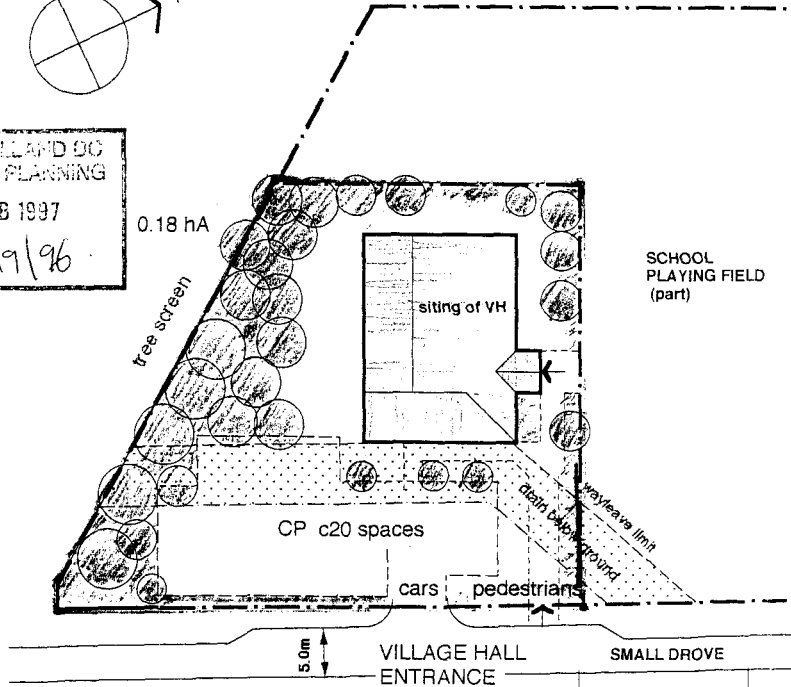

Revisions to previous Plan:

North & West boundaries of site squared up
site area increased by 0.03 hA.

Hall building moved east and northwards

Carpark and vehicle entrance moved northwards

Tree screen (nom. 10m wide) introduced on southern boundary



1:500

WESTON VILLAGE HALL

FEASIBILITY STUDY

REVISED

SITE PLAN SHOWING LOCATION OF BUILDING & CP

February 1997