

NEW GLASSHOUSE TO REPLACE PLASTIC TUNNEL
PART OF YARD AREA + PART OF GARDEN.
55 STONEGATE COURT
VERNON BROAD GARDEN

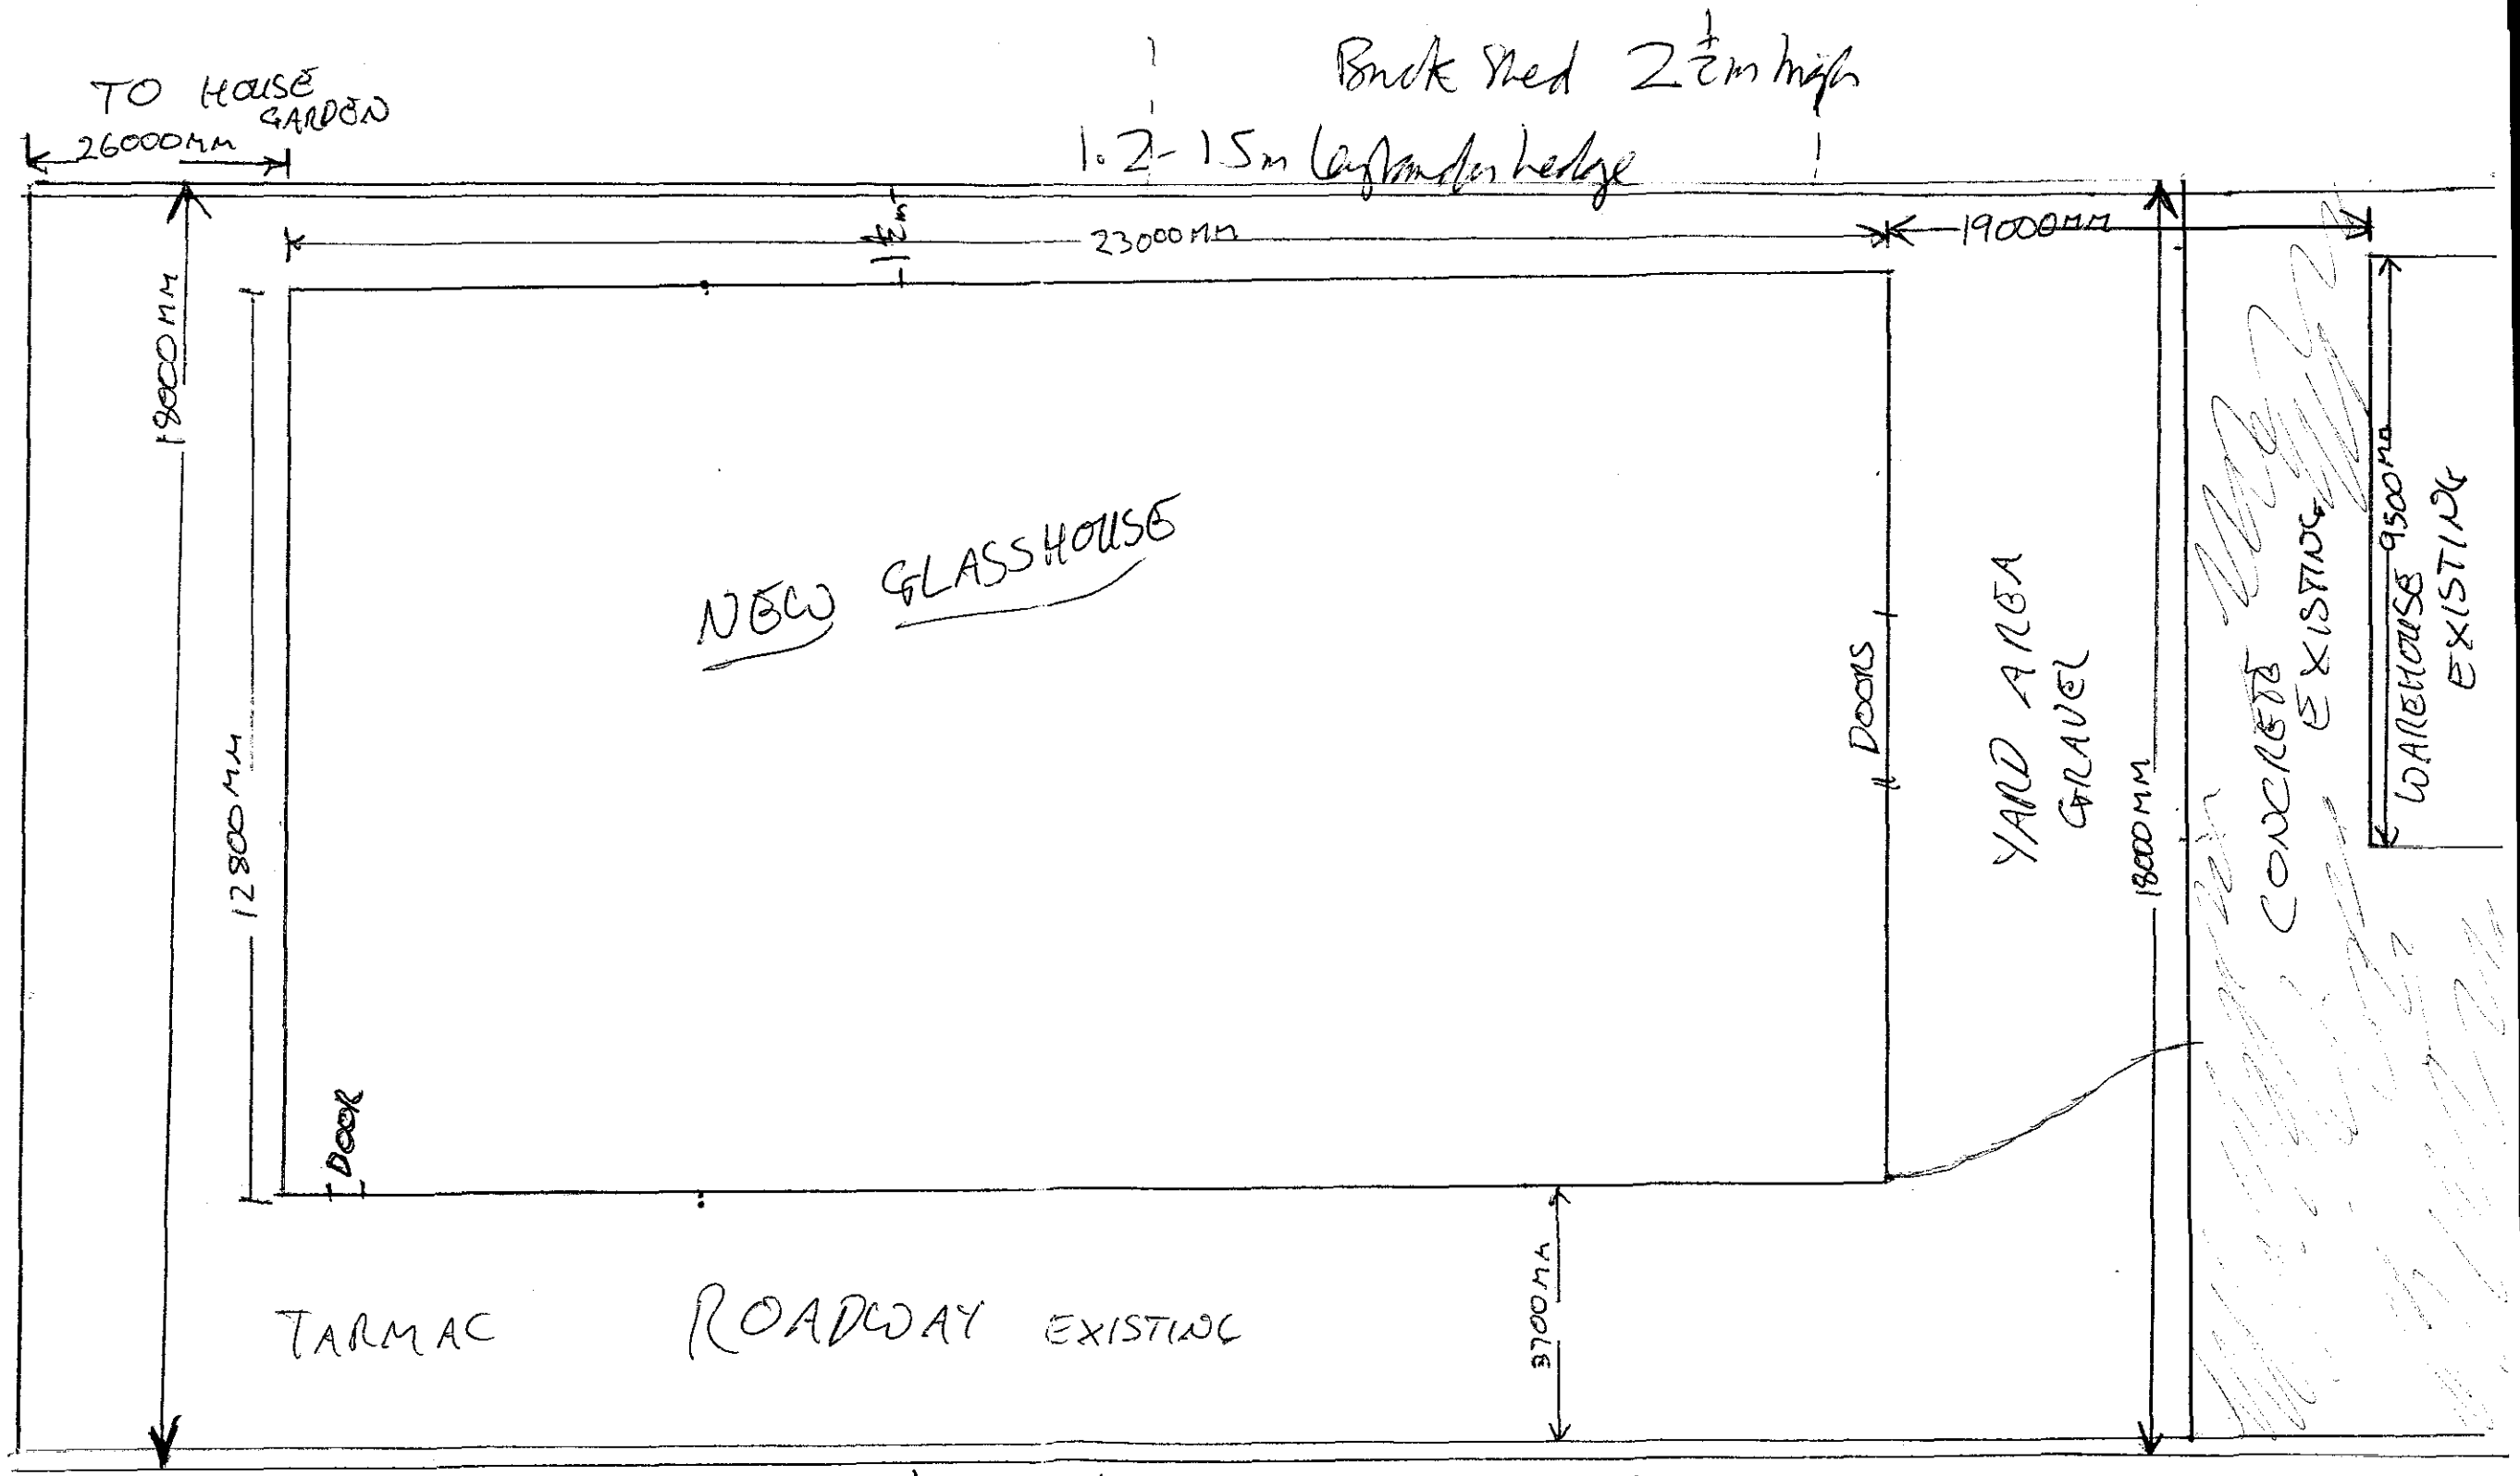


DETERMINED PLAN

Pl... ...nt
14 MAY 2002
0576/02

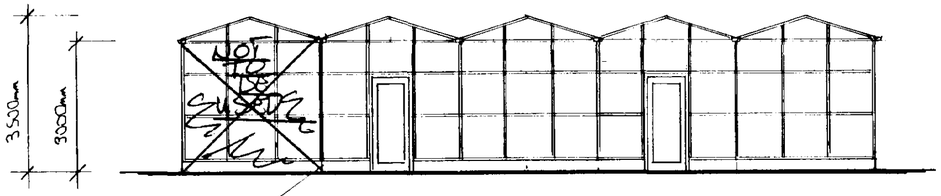


1 Course Concrete Blocks to Base

~~NORTH~~ ~~East~~ Elevation
~~SOUTH~~ (~~West~~ Similar)

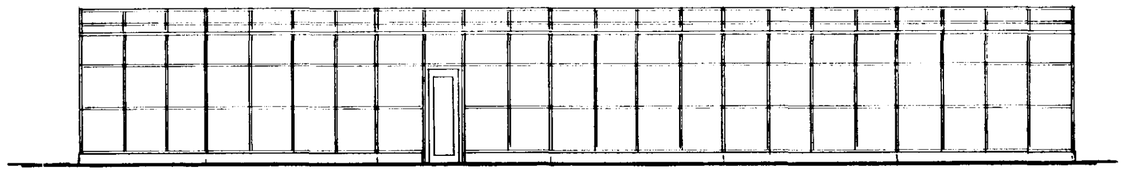

EAST ~~South~~ Elevation
WEST (~~North~~ Similar)

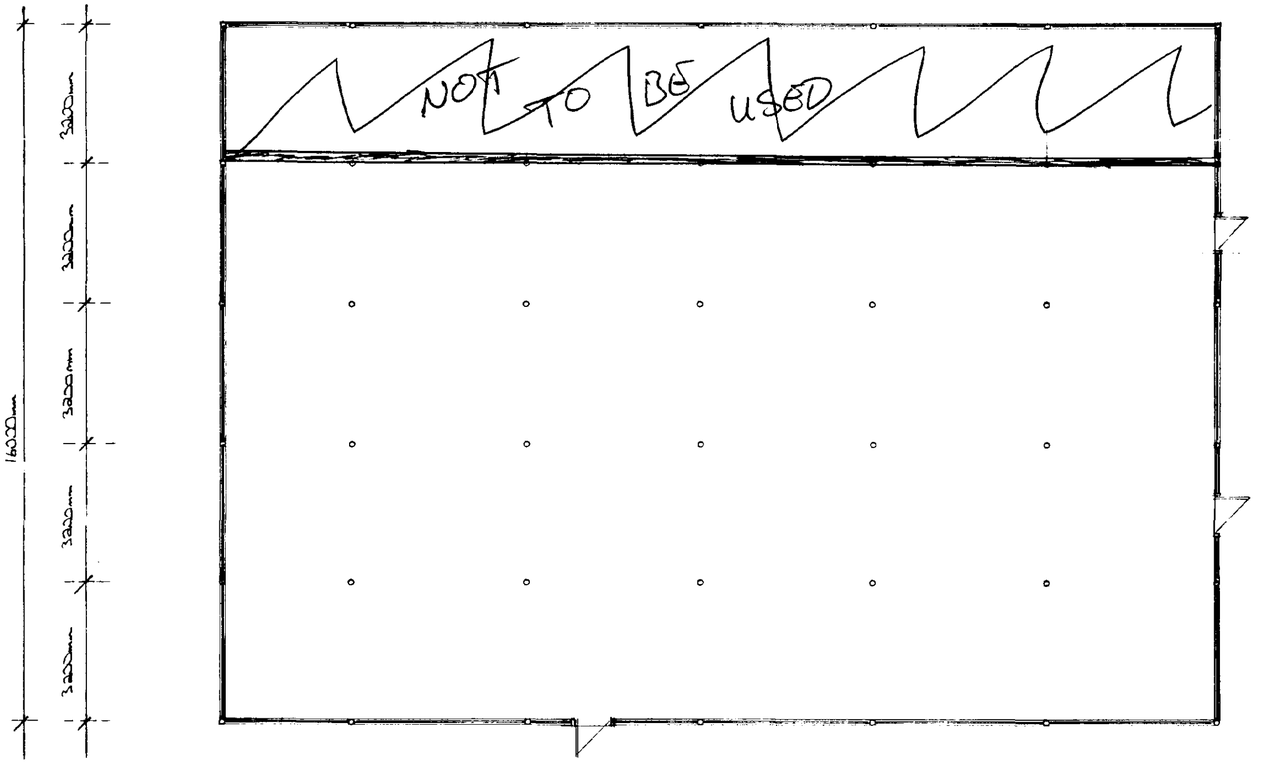

Floor Plan

DETERMINED PLAN

SHDC
Planning & Developm
14 MAY 2002
Ref 0576/02

THIS IS THE DRAWING OF THE SECOND HAND GLASSHOUSE I WISH TO ERECT AT 55 STONEGATE

CONTRACTOR TO CHECK ALL DIMENSIONS ON SITE BEFORE WORK COMMENCES.

revision	date	init.	revision details

PODDINGTONS
Architectural Design Consultants
43 Double Street, Spalding, Lincs. PE11 2AA
Tel: 0775 761856 & 768296. Fax: 0775 710218

project
Proposed Propagation House & Replacement Glasshouse
At.
Tom Tumb Nursery, Woolram Wygate, Spalding
For
Mr & Mrs R. Chapman

drawing
Plan & Elevations of Replacement Glasshouse

scale	drawing no
1/100	MRH / 2510/1
December 92	checked