



SOUTH ELEVATION

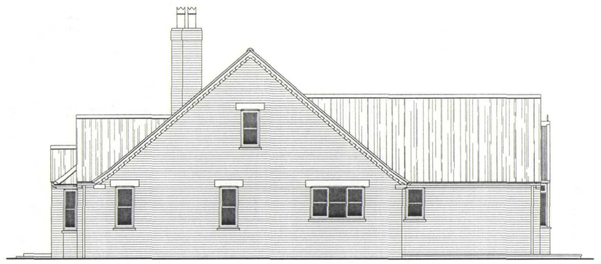


EAST ELEVATION



NORTH ELEVATION

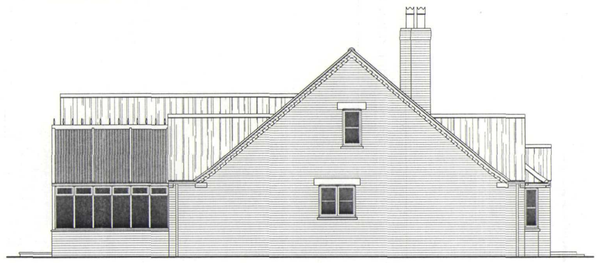

WEST ELEVATION

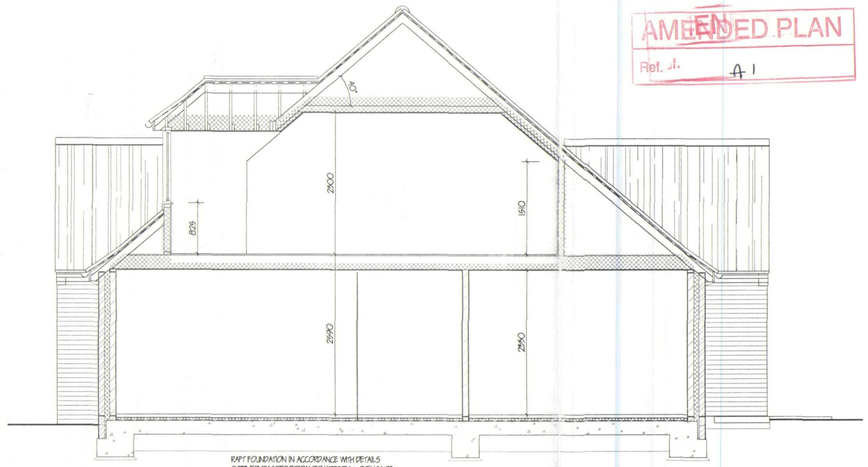

RAFT FOUNDATION IN ACCORDANCE WITH DETAILS SUPPLIED BY SIDDOTTOM RICHARDSON & CHENG LTD. PROJECT No. 2970A.

DWELLING SECTION

AMENDED PLAN
Ref. JL 41

LIMITATIONS.
This drawing is limited in the amount of information contained and does not purport to contain a full specification of the works. It is solely for the purpose of obtaining Planning/ Building Regulation approval.
The drawing must not be used as a contract document alone.
All dimensions shall be taken from site from actual work. Under no circumstances shall measurements be scaled from this drawing for construction or ordering purposes. All given dimensions shall be checked by the Builder/ Contractor and will be his responsibility from commencement of site works.
The works will not be supervised or inspected on site by G.R. Merchant, or any representative thereof. It is the client or their appointed agents responsibility to control workmanship, substitution of materials, adherence to specification, variations to contract etc.


COPYRIGHT RESERVED.
Copies of this drawing must be made only with the written permission of G. R. Merchant.

STANDARDS.
All materials to be new unless otherwise stated and all components and materials etc. to be used fitted and installed etc. in strict accordance with manufacturers instruction and relevant Code of Practice.
Materials shall conform to appropriate British Standard Specification or BBA Certificate or European Code equivalent.

HEALTH & SAFETY.
The Employer/ Client shall ensure that the selected contractor is conversant with and adopts all measures necessary to achieve compliance with Health & Safety legislation for Building Sites and Work Places.
The Employer / Client is advised that should the works need to comply with the Construction Design and Management Regulations an independant Planning Supervisor will be required.

SCOPE OF THE WORKS.
The works shall comprise of all that is shown on the drawing and details. Work that may not be specifically shown but may be reasonably inferred as necessary to carry out the works shall be deemed to be included.

SHDC
Planning & Development
18 OCT 2004
Ref: 04/821/04

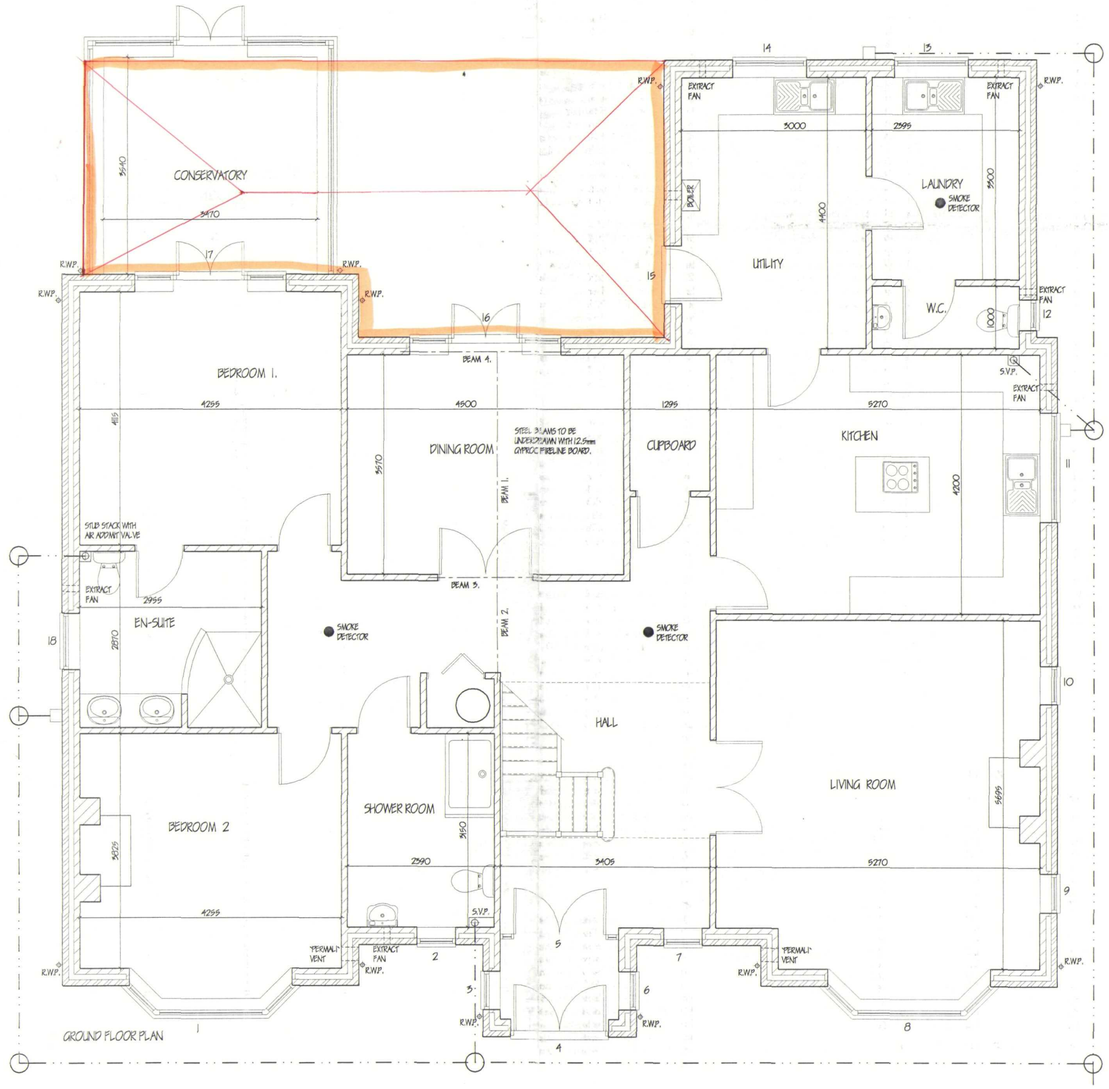

HOT WATER AND SPACE HEATING.
Provide Oil fired condensing boiler (min SEDBUK B5 X) with fan assisted balanced flue. Fit durable wire guard to externally to boiler flue. Provide timer switch, suitable zone and boiler control interlocks, fit thermostatic control valves to all radiators. Hot water system to be thermostatically controlled with timer switch and to be vented. All hot water storage cylinders to have min. 35mm thick factory applied foam insulation and pipe work to be insulated to B.S. 5422:2001. All oil storage tanks to be integrally bunded prefabricated type (2500 litre capacity). And to be fitted with fire valve system in accordance with B.S.5410-1 1997 pts. B.2 & B.3. Ensure tank has advice label regarding Oil spillage and Environment Agency emergency hotline telephone number. Tanks to be sited minimum 760mm from any boundary and minimum 1800mm from any building.
Heating Engineer to provide L/ A. Building Control with a suitable Commissioning Certificate in accordance with that published as part of the Benchmark Code of Practice upon completion. And operating and maintenance instructions for owner/ occupier

SMOKE DETECTORS.
Provide ceiling mounted mains operated self-contained smoke alarms to B.S. 5446: pt.1.1990 in positions shown on plan. Where more than one detector is to be provided they will be interconnected. All permanently wired to a separate fused circuit at distribution board.

LIGHTING.
To all Bedrooms provide energy efficient light fittings capable only of taking lamps having a luminous efficacy greater than 40 lumens per circuit.
External lighting to be fitted with Dawn-Dusk or movement sensors and capable only of taking lamps having a luminous efficacy greater than 40 lumens per circuit.

GENERAL
All electrical installations to be in accordance with the latest I.E.E. Regulations.
Provide hot & cold water supply to all wash basins.
All electrical switches, socket outlets, telephone and T.V. points to habitable rooms to be positioned at appropriate heights between 450mm & 1200mm from F.F.L.

FOUL DRAINAGE
Inspection chamber construction to be "Osma" and installed in accordance with makers' instructions with the internal diameter related to the depth in accordance with B.S. 8301:1985. Foul drainage pipes to be 110mm dia. UPVC, to B.S. 4660:1989 flexibly jointed and laid to makers' instructions to a fall of 1:70 bed and surround with 10Omm pea gravel: Where pipes pass under floors encase in 150mm pea gravel: Where pipes pass under drives surround in 150mm concrete with flexel joints to correspond with joints in pipe work. Provide 65 x 100 pre-stressed concrete lintel bridging where pipes pass through walls, provide compressible filler around pipe, openins masked both sides of wall with ridged sheets material and mastic seal to prevent entry of cass. Soil and vent pipes to be 110mm dia. PVC to B.S. 4514: 1989 and to extend 900mm above window head terminating with wire balloon. Waste pipes to be generally 40mm dia. If over 3.0m long run increase to 50mm dia. All PVC to B.S. 5955: 1979 complete with rodding eyes at every change of direction: Bath, basins and sink to have 75 deep seal traps: Shower to be raised on 150mm plinth with access plate to anti-syphon trap and 50mm waste. All redundant drains to be grubbed out or filled with lean-mix concrete. Condensation drainage from boiler flues to discharge via min. 22mm diameter pipe work through a 75mm condensation trap. Alternatively an additional trap should be provided externally to provide the required seal, an air gap should be provided between the boiler and the trap.
Septic tank / Treatment plants operating and maintenance instruction notice to be provided by installer.

SURFACE WATER DRAINAGE.
115mm dia. half round rainwater gutters to 65mm dia. rainwater pipes: 110mm dia. underground pipes flexibly joined to a fall of 1:70 pipes bedded and surrounded in pea gravel and discharge to 1.2m dia. soak away min. 5.0m to edge from dwelling and 3.5m from all boundaries. All footpaths and drives to slope away from building.

GLAZING.
Double glaze properly throughout with timber/ p.v.c.u windows (minimum 16mm air gap to all units with Low 'E' 0.1 Glass) max 'U' value 1.9 W/ sq.m. K excluding garages. All glazing between F.F.L. and 800mm high and between F.F.L. and 1500mm high in doors and side lights to be safety glass to B.S. 6206. All windows/ doors to be draught sealed.

LEVEL ENTRY THRESHOLD
Provide "Jeldwen Ltd." Mobility door frame & threshold (FN29M-MOB). Principal entrance to building. All External doors to be 838mm wide. And in all cases to provide minimum 775mm clear opening width.

INTERNAL DOORS.
All internal doors to ground floor habitable rooms and toilets accommodation to be 838mm wide.

FOOTPATHS / DRIVES.
Provide min. 900mm wide footpath positioned at D.P.C. level and min 150mm away from face of wall to perimeter of building. At entrance positions rise up to top of sub sill min 1:20. All footpaths to have slight fall away from building. Gap between wall & footp. th to be filled with 150mm depth of 20mm washed gravel. Form 1.0m wide footpath from dwelling to road from rear, suitable for wheelchair access
At least 5.0m of drive adjacent to building x 5.0m wide to be hard standing i.e. Concrete, Tarmac or Block paviors. All to be sloped up to footpath level 1:80 min. 1:20

STAIRCASE AND BALUSTRADE.
Construct staircase as follows: 900mm clear width between handrails. 13No. risers of 200mm or 215 x 225; 225 going ex 32 x 250; pitch 42deg. Min. head room 2.0m measured vertical above pitch line. All in accordance with B.S. 5395:1977. Staircase to have ex 38 x 50 shaped hardwood handrail at min. 900 above pitch line. 100 x 100 softwood newel post. Gap between vertical balusters not to exceed 99mm. Handrail and balustrade to be capable of resisting the appropriate load specified in B.S. 6399: Pt 1. Balustrade to be min. 900mm high.

FLUE CONSTRUCTION.
225mm internal diameter clay flue liners to B.S. 1181: 1971 and to be laid socket uppermost. 100 flue brickwork surround to flue and to extend min. 600mm above ridge line and terminate in corbelled out brickwork and clay pot: Infill around flue as work proceeds with 1 pt. Cement 6 pts vermiculite: Trim roof around flue, no combustible material within 40mm of chimney. At roof/ flue intersection provide code 4 lead flat ring and 2 course engineering bricks. Durable notice detailing performance capabilities to be affixed in building by installer

OPEN FIRE.
To be capable of burning smokeless fuel: Hearth to be constructed of non combustible material min. 125mm thick: To project from face of wall by min. 500mm and pass reveals by min. 150mm: All in accordance with approved document part J (part C1-29). Appliance to be in accordance with building regulations. Provide louvered permanent vent in ext. wall to give min. 50% of the appliance throat opening area positioned 150 above floor level. Provide 65 x 100 pre-stressed conc. lintel over chimney opening. Durable notice detailing performance capabilities to be affixed in building by installer

LINTELS.
All lintels to be manufactured by Messrs. IG Codes L1/ 575 and L1/ HD 75 all to be installed in accordance with makers' instructions, and to have min. end bearing of 150mm and at external positions to have cavity tray D.P.C. to CP. 121: Internal lintels to be I.G. 100 Slot type. Lintels in garage to be under med with 12.7 Fire line board or receive 12mm render and skim. Provide Perp-end weep holes and stop ends to cavity tray

VENTILATION.
All windows to have opening lights to give the equivalent of 1/ 20th the floor area. Provide background ventilation to habitable rooms min. 8000mm sq. permanent free air ventilation per room. To all other rooms provide min 4000 sq. All following rooms to have in addition to above Wall/ Window mounted mechanical extractor fan. Kitchen to extract min. 60 litres per second. Utility rooms to extract min 30 litres per second. Bathrooms to extract min. 15 litres per second which may be operated intermittently. W.C. to extract min. 6 litres per second with 15 minute overrun.

PITCHED ROOF CONSTRUCTION.
Blue / Black Fibre cement slates with riven surface and dressed edges to B.S. EN 492:1994, on 25 x 38 softwood treated battens on under felt to B.S. 747 (type 1F) and in all cases to be lapped by 190mm both vertically and horizontally. Slates to be laid with min. head lap of 110mm and to be fixed in accordance with regard to wind speed, roof pitch and exposure category as detailed in B.S. 5534: Pt 2. Timber to be specialist made prefabricated roof trusses to comply with B.S. 5268 part 3 1988. TRUSS CALC'S TO BE SUBMITTED TO L/ A. MIN. 28 DAYS PRIOR TO ERECTION. Trusses to be at 600c/ c to a pitch of 40 deg. 38 x 100 ridge node binder 38 x 100 ceiling binders: All trusses to be strapped to wall plate by 30 x 5 galvanised metal straps acting as anchor and lateral restraint straps at min. 1.5m c/ c. Note: provide solid bridging beneath struts: 50 x 100 wall plate bedded on sand and cement: 25 x 175 fascia boards: 6mm ext. grade plywood soffit complete with 10mm wide continuous air gap and 5% proof screen: All structural timber to be min. 50 grade, stamped "DRY" or "SD" to indicate moisture content of 20% or less in accordance with BS 4978. Where span of trussed rafter exceeds 5.0m provide additional bracing within the plane of the web in accordance with Truss Plate Assoc. tech. bulletin sheet 4: Timber supports are to be provided beneath water storage tanks over 450 ceiling joists. At roof intersections provide 25 x 100 lay boards and diminishing trusses at 600 c/ c: Install code 4 lead valley liner.

FIRE ESCAPE WINDOWS.
All habitable rooms in the upper story of a dwelling should have a window with an unobstructed openable area of at least 0.33 sq.m. and at least 450mm wide x 750mm high (the route through the opening may be at an angle rather than straight through) The bottom of the openable area should not be more than 1100mm above floor level

CEILINGS / INSULATION.
Roof Level: Flat ceilings lay 250mm glass fibre insulation total thickness. 100mm between joists & 150mm over Joists to provide max. 'U' value of 0.16 W/ sq.m.K. Sloped ceilings lay "Celotex GA4090Z + GA4040Z" to provide a max 'U' value of 0.2 w/ sq.m.K. Ensure 50mm air gap over all insulation. 12.5mm Gyproc wallboard, skim finish: Provide min. 38 x 38 noggins to all plasterboard edges. All joints to be taped and filled. Provide access trap to roof space: opening to be lined with 25 x 25 planted stops: Access panel to be 12mm ply with layer of 12.7mm Fireline board fixed to face. 100mm Jablite to top surface. Provide slide bolt fastening & draught seal all round
Mid Floor Level: 12.5mm Gyproc SoundBloc skim finish. 100mm Isowool General Purpose roll infill between joists. Provide min. 38 x 95 noggins to all board edges. All joints to be taped and filled.

WALLING.
280 cavity walling to consist of face brickwork to B.S. 3921:1974 for clay bricks and B.S. 187:1978 for calcium silicate bricks: 88 cavity: build into cavity Dritherm cavity wall batt insulation boarding in accord. with makers instructions and agreement cert' No.84/1268 & 86/1584. 100mm Tarmac Hemelite 3.6 N/ mm2 solid insulation blocks or similar: Cavity walls tied together using galvanised iron twist ties set 750 horizontally and 450 vertically to B.S. 1243:1978 wall ties positioned at 300 vertical centres at all unbonded closures of cavity: Close cavities with "Thermabate" preformed closer and provide bitumen felt DPC to C.P. 121: All work to be carried out in accordance with BS Code of Practice 121 Pt.1. 1979. External walls to have max. 'U' value of 0.35 W/ sq.m.K. Internal walls of 100mm Tarmac Hemelite solid insulation blocks.
Movement joints to be installed in blockwork in accordance with B.S. 5628 pt. 3 1985.
All to receive 13mm lightweight plaster finish, (except garage). Stud walls to consist of 38 x 89mm c.l.s studs at 600mm c/ c, both sides to be clad with 12.5mm Gyproc SoundBloc and skim. 25mm Isowool Acoustic partition roll infill between studs

JOINERY / LINTEL SCHEDULE

POSITION	JOINERY	LINTEL	LENGTH
1	SP5/H15C/H15CC/H15C	I.G. L1/ HD 75	3000
2	H15C	I.G. L1/ S 75	900
3	H15C	I.G. L1/ S 75	900
4	PURPOSE MADE	I.G. L1/ S 75	1950 (PROVIDE LEVEL ENTRY THRESHOLD)
5	PURPOSE MADE	I.G. L1/ HD 75	2700
6	H15C	I.G. L1/ S 75	900
7	H15C	I.G. L1/ S 75	900
8	SP5/H15C/H15CC/H15C	I.G. L1/ HD 75	3000
9	H15C	I.G. L1/ S 75	900
10	H15C	I.G. L1/ S 75	900
11	H2IOCC	I.G. L1/ HD 75	2100
12	H1IOC	I.G. L1/ S 75	900
13	H2IOCC	I.G. L1/ S 75	1500
14	H2IOCC	I.G. L1/ S 75	1500
15	FN29M-MOB	I.G. L1/ S 75	1350
16	H15C/ FCP120/ H15C	I.G. L1/ HD 75	2850
17	H15C/ FCP120/ H15C	I.G. L1/ HD 75	2850
18	H2IOCC	I.G. L1/ S 75	1900

ALL JOINERY CODES "JELD-WEN LTD" ALL LINTEL CODES "I.G. LTD."

ref:	revision	date
E	LEVEL ENTRY THRESHOLD	SEPT '04
D	BEAMS OVER DINING AREA	AUG '04
C	BUILDING REGS.	AUG '04
B	CENTRAL DORMER ADDED	JUNE '04
A	CLIENT REQUIREMENTS	MAY '04

G. R. MERCHANT
I.ENG AMICE FIWO
ARCHITECTURAL, STRUCTURAL AND LAND DRAINAGE CONSULTANTS
Unit 4, Wrights Mews
12A Park Road, Holbeach,
Spalding, Lincs. PE12 7EE
Tel: 01406 490600
Fax: 01406 425744
E-Mail: G. R. Merchant @ Merchant. Fs. Co. UK

Project
PROPOSED BUNGALOW & GARAGE
STONEGATE
COWBIT
SPALDING LINC'S.

Client
D. SWALLOW & M SEARSON

Drawing
SECTION
GROUND FLOOR PLAN - ELEVATIONS

Job Ref.	Drawing No.
856-03	01-E
Date: JAN. '04	Drawn: J.C.

Scales
1:50 1:100

DO NOT SCALE FROM THIS DRAWING
This drawing is copyright and may not be altered, traced, photographed or used for any other purpose other than that for which it is issued.
The General Contractor is to check all dimensions on site and report any discrepancies to the Architect.
All details shown on this drawing including foundations are based upon typical site conditions related to the area. No responsibility can be accepted for abnormal conditions which may be discovered during construction unless reported to the Architect so that design ammendments may be considered. Site soil surveys are recommended in respect of foundations to establish specific site conditions before foundation work is undertaken.