
THE RAMS, NENE TERRACE, CROWLAND.

PROPOSED ELEVATIONS.


Scale 1:100

0 1·0 2·0 3·0 4·0 5·0


PROPOSED VIEW "A" 1:100

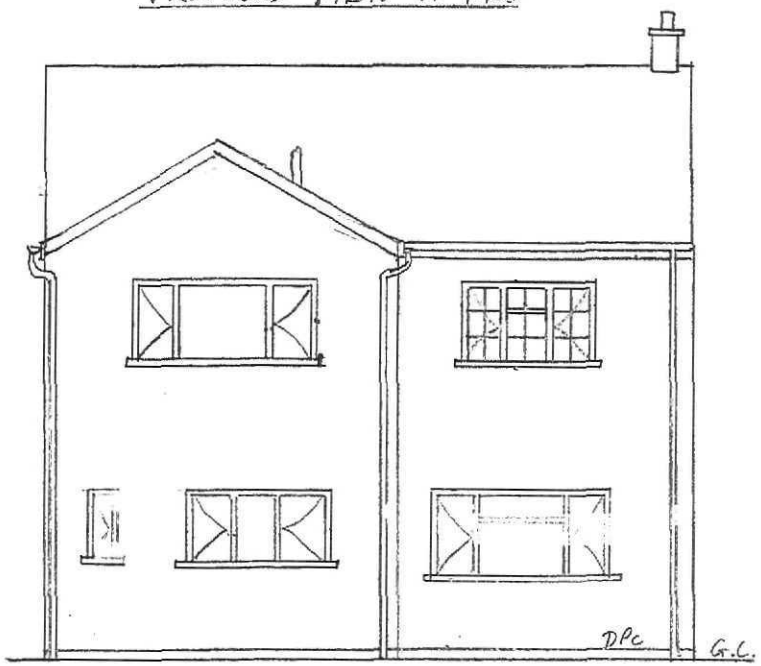

PROPOSED VIEW "B" 1:100

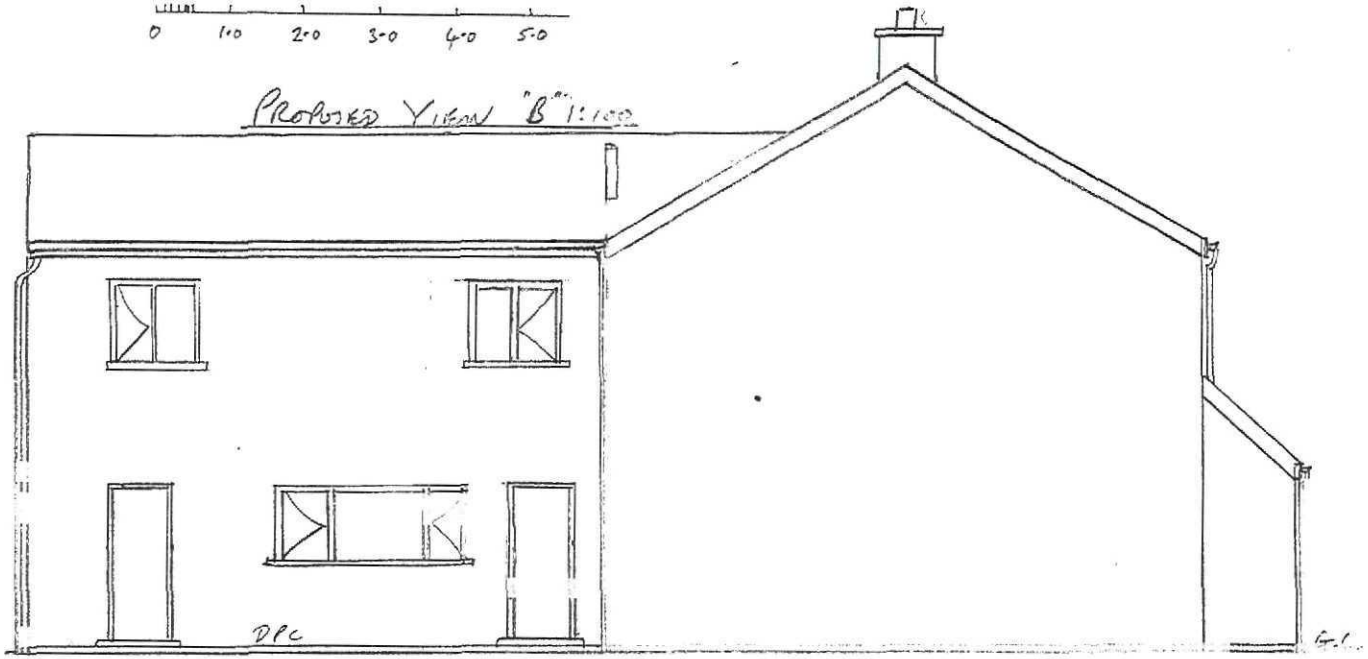

PROPOSED VIEW "D" 1:100

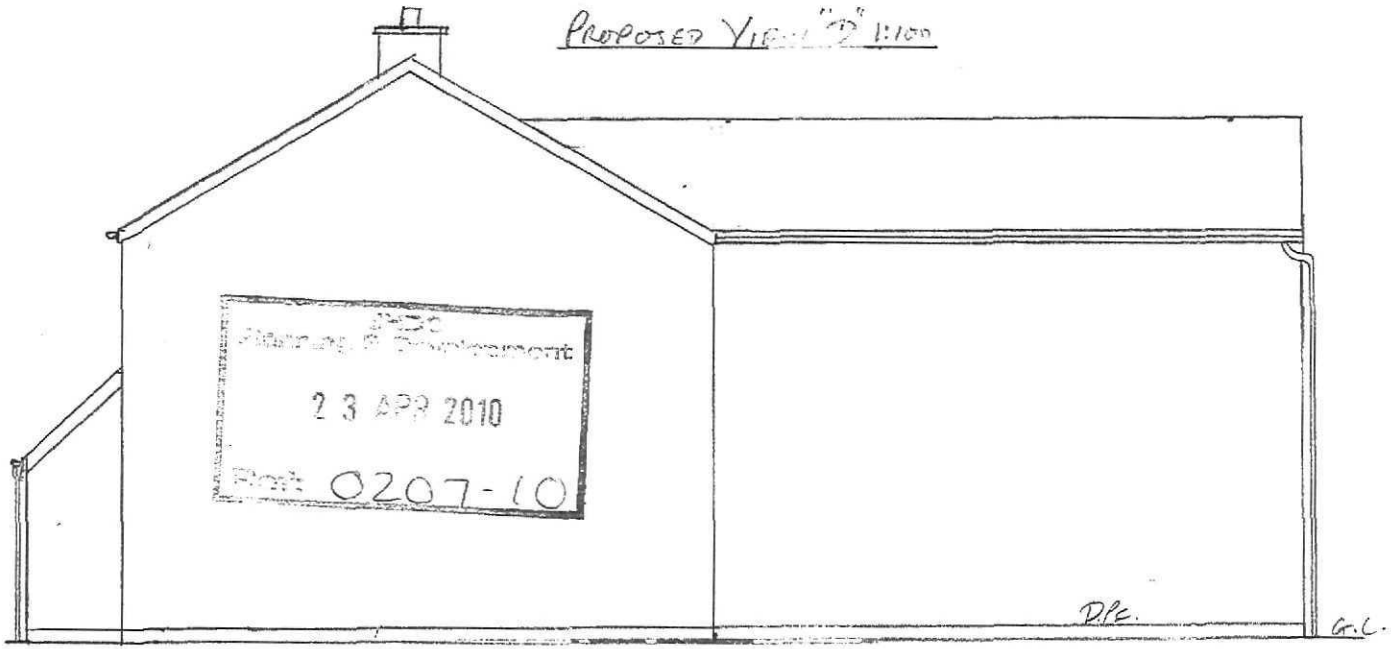

2 3 APR 2010

Ref: 0207-10

AMENDED PLANS

Ref:

ISSUE: AMENDED ROOF PITCH.	
BUILDER TO CONFIRM ALL ANGLES AND	
MEASUREMENTS ON SITE PRIOR TO	
COMMENCEMENT AND DURING EACH	
STAGE OF WORK.	
NOTE: VIEW "C" IS NOT CHANGED FROM	
EXISTING VIEW DRAWING No 6.	
ALL MEASUREMENTS IN METRES.	DRAWING No 7 of 9
	DRAWN BY D. BRIGHT.
	ISSUE No 2

SOUTH HOLLAND DISTRICT COUNCIL
Council Offices
Priory Road
Spalding
Lincolnshire
PE11 2XE

tel: 01775 761161
fax: 01775 710772
web: www.sholland.gov.uk

TO CHRIS CREW

PLAN AMENDED AS DISCUSSED

REGARDS

DAVE

Mr D Bright
34 Franklyn Crescent
Peterborough
Cambs
PE1 5ND
PE1 5ND

Date: 13 April 2010

Dear Sir/Madam.

TOWN AND COUNTRY PLANNING ACT 1990
PLANNING APPLICATION SUBMISSION: REQUEST FOR ADDITIONAL INFORMATION OR FEE

Reference Number: **H02-0207-10**

Proposal: Two-storey extension to rear of dwelling including alteraterations

Site Location: The Rams Nene Terrace Crowland Peterborough

Applicant: Mr and Mrs R Godman

I am writing with reference to your recently submitted planning application and advise you that the application cannot be registered as it is currently considered to be invalid.

We will require the following before the application can be progressed:

- Please clarify the roof pitch of the proposed extension - dwg. no. 7 indicates a pitch of 25 degrees whilst dwg. no. 8 indicates a pitch of 30 degrees.

Please return one copy of this letter with your reply to enable us to deal with the application without further delay. If we do not hear from you within the next 21 days it will be assumed that you no longer wish to continue with the application and it will be returned to you (one copy of the application will be kept for our records). Any fees already received will be reimbursed.

If you have any queries regarding the above please contact Chris Crew on 01775 761161, quoting the above reference number.

Yours faithfully

Chris Crew
Planning Officer

SHDC
Planning & Dev...
23 APR 2010
Ref:

Terry Huggins Chief ...
Corporate Directors ...