

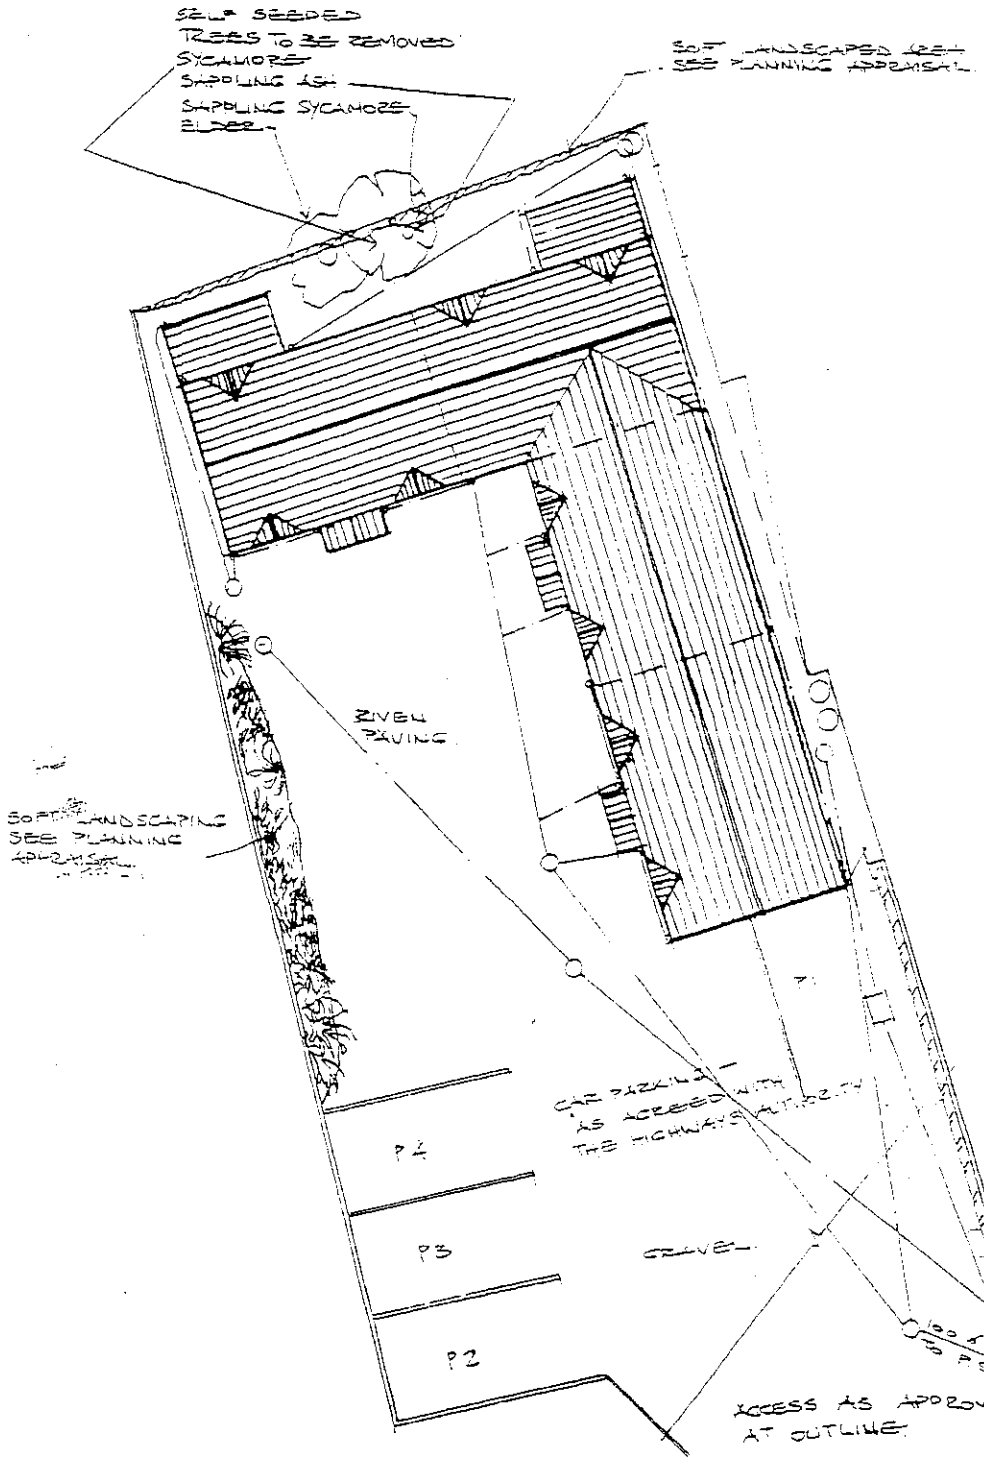


BLOCK PLAN
1:200

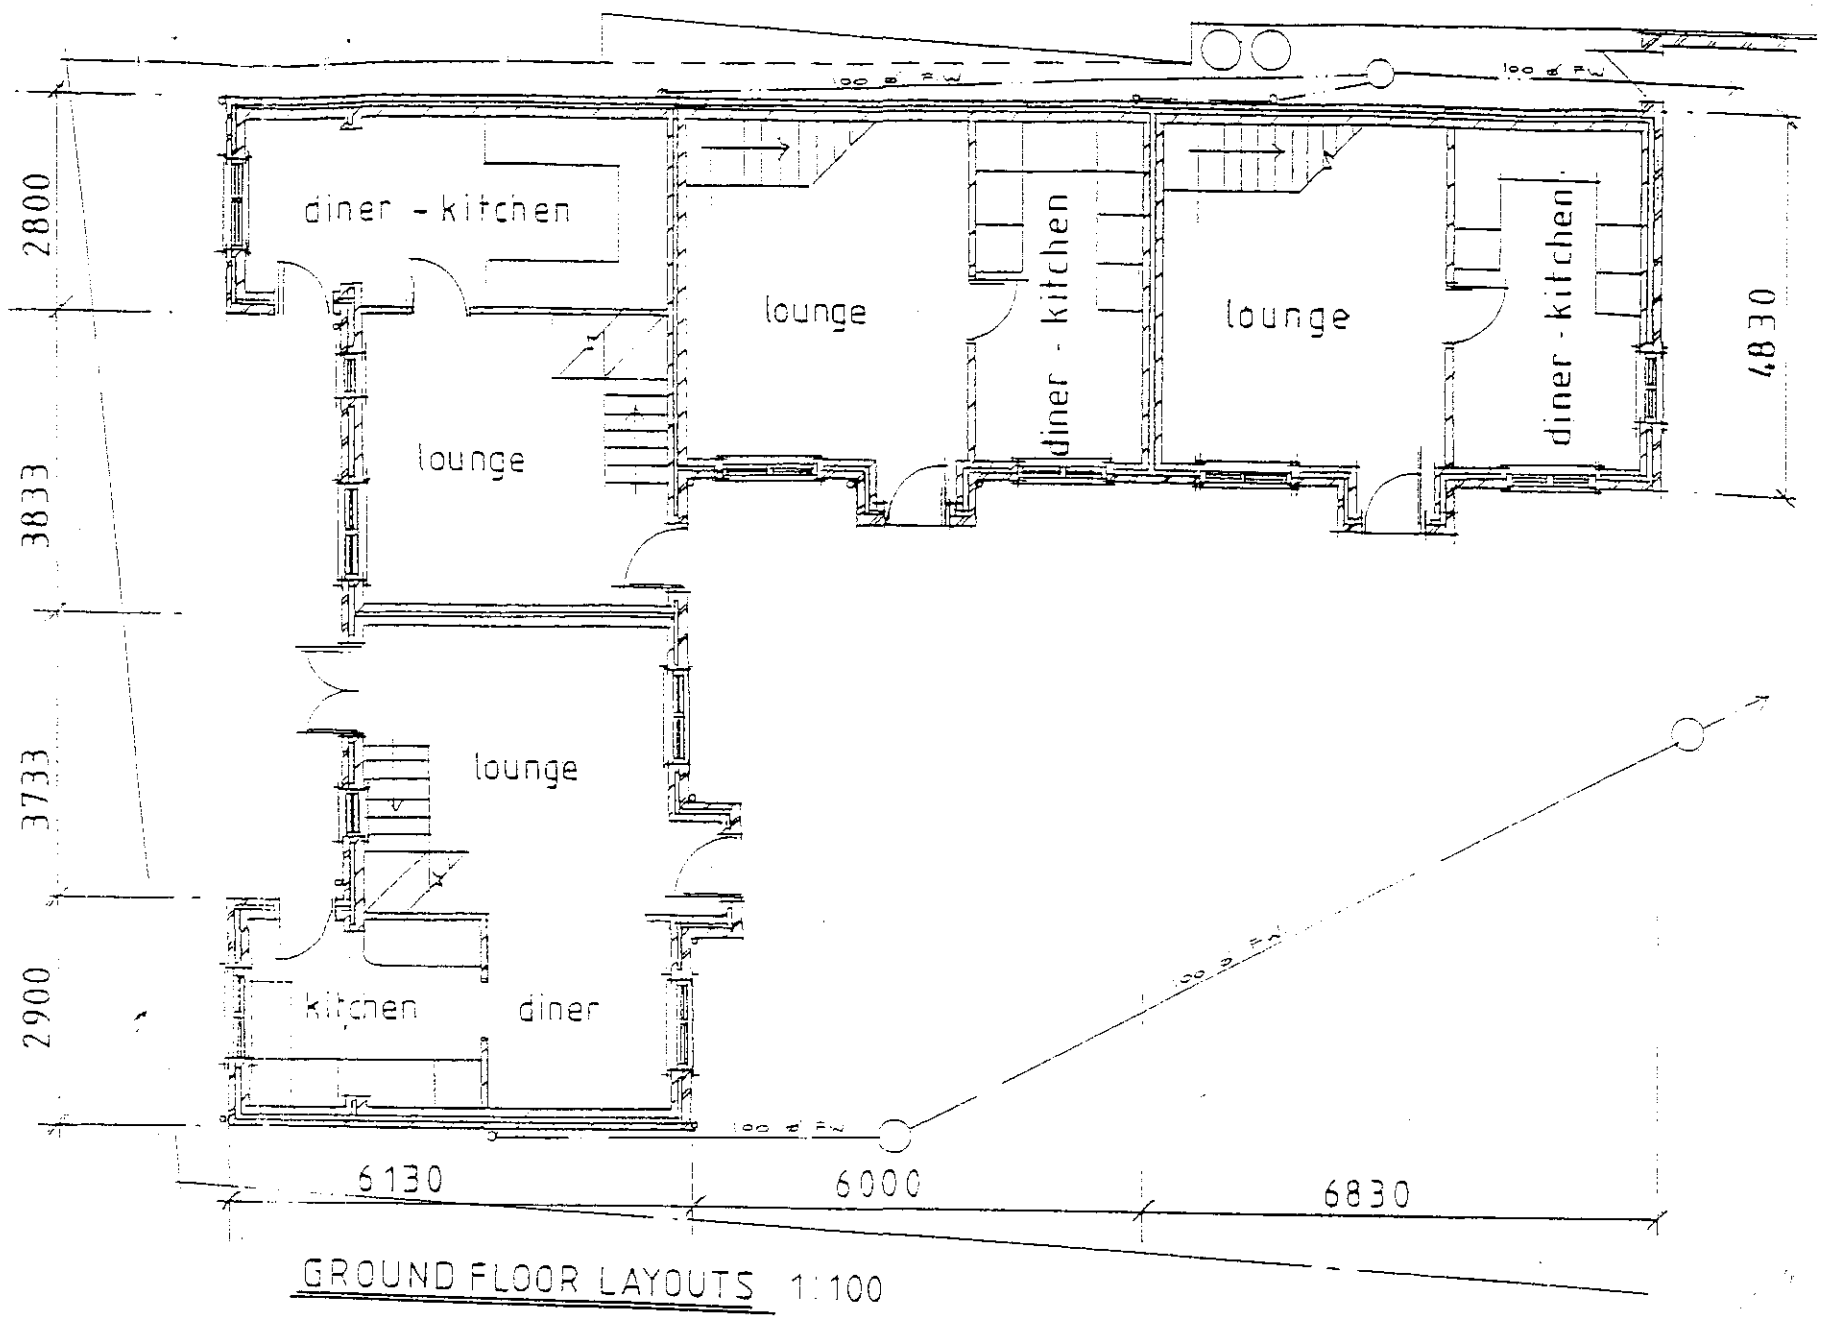

GROUND FLOOR LAYOUTS 1:100

IBSTOCK IVANHOE
COTTAGE BLEND
FACING BRK

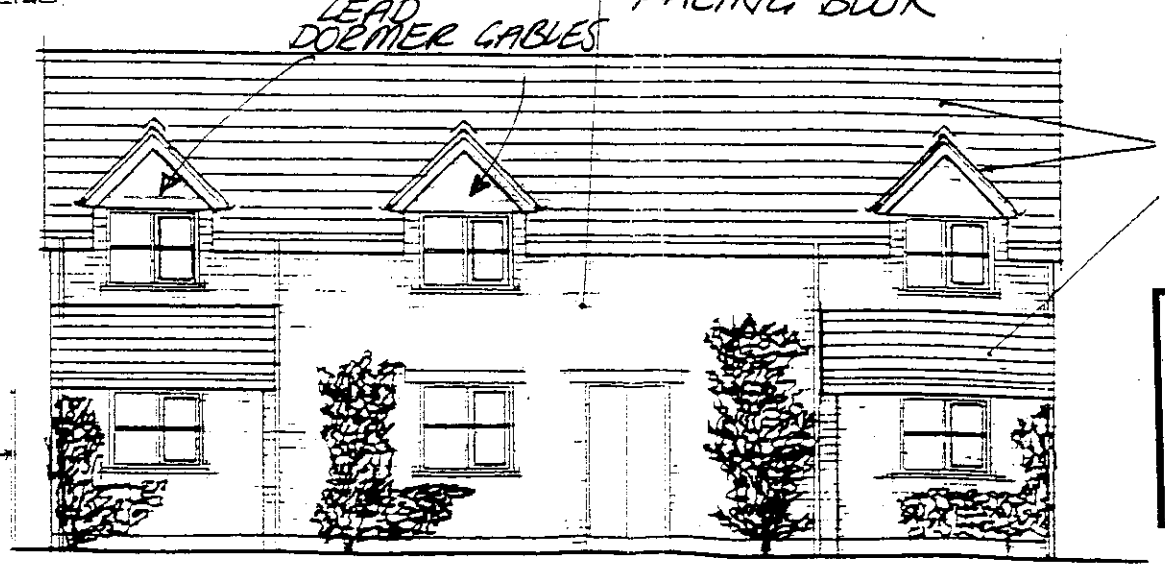

NORTH FACING ELEVATION 1:100

A1

SHDC
Planning & Development
11 AUG 2005
Ref: 1199/00

PLANNING PERMISSION


APPROVED.

Proposed 4No.Dwellings
at Land to the rear of 1-3 West St.
Crowland.
for Mr & Mrs P.Drury.
Scale:As shown. Date: Sept.2000.

PD/001A


PLANNING PERMISSION

APPROVED.

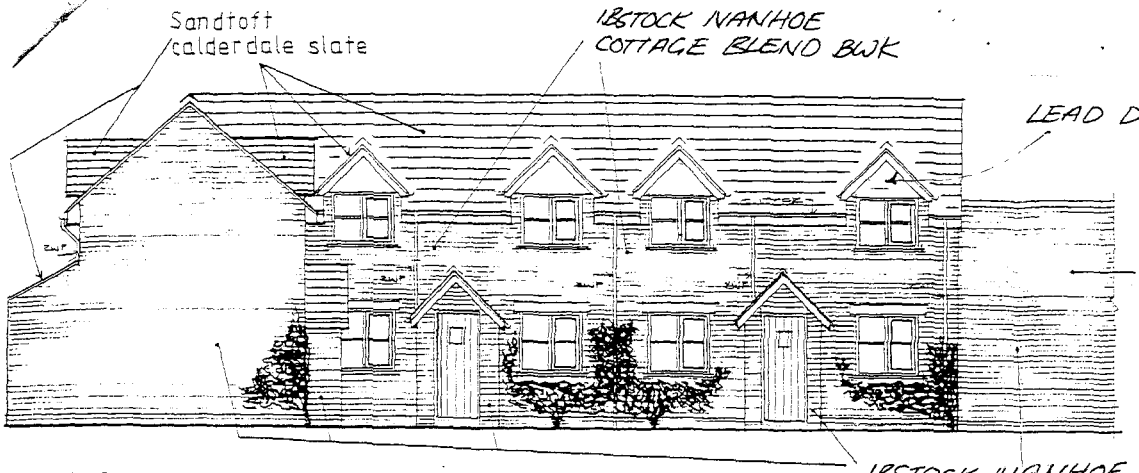


WEST FACING ELEVATION 1:100

English Oak - over ground floor windows

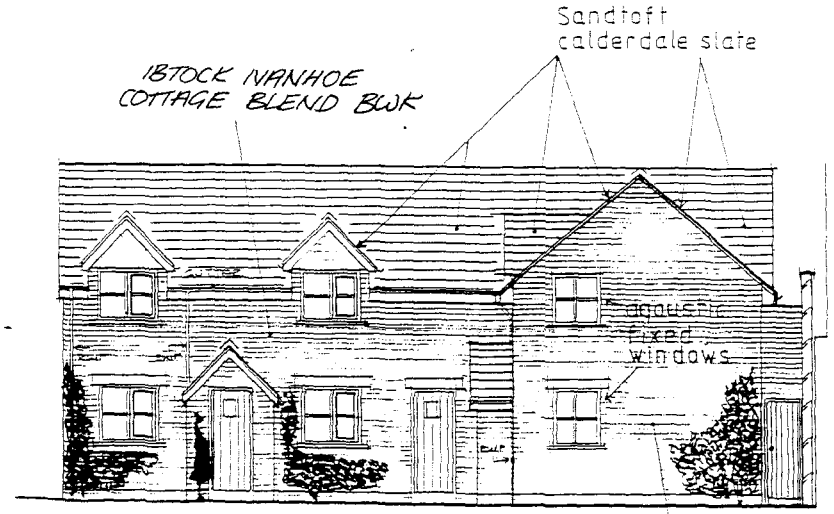

SOUTH FACING ELEVATION 1:100

~~Desimpel~~
~~otnello brickwork~~
IBSTOCK IVANHOE
COTTAGE BLEND.

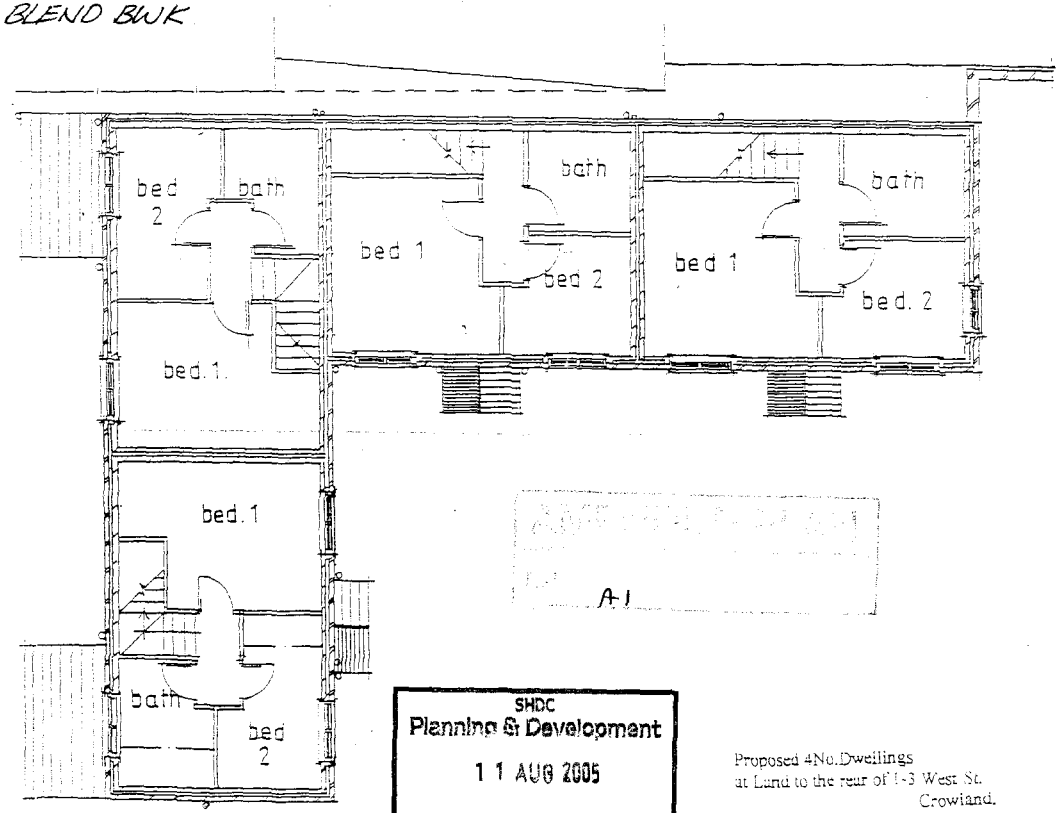

A1

SHDC
Planning & Development
11 AUG 2005
Ref: 1199/00

Proposed 4No.Dwellings
at Land to the rear of 1-3 West St.
Crowland.
for Mr & Mrs P.Drury.
Scale: As shown. Date: Sept.2000.

FIRST FLOOR LAYOUTS 1:100

PD002 A