


DO NOT SCALE

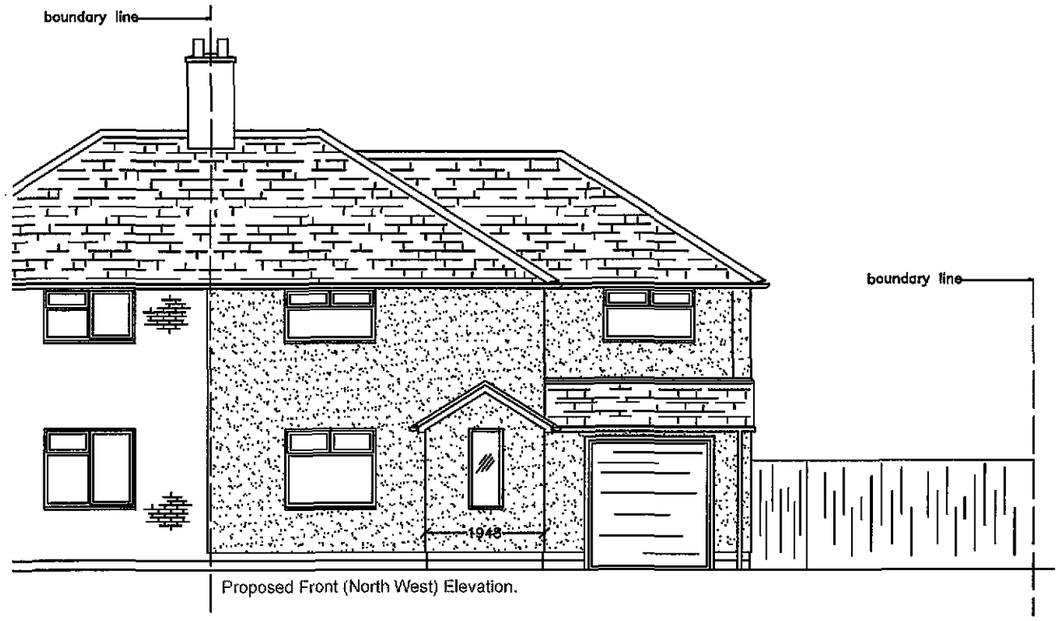


Proposed Front (North West) Elevation.

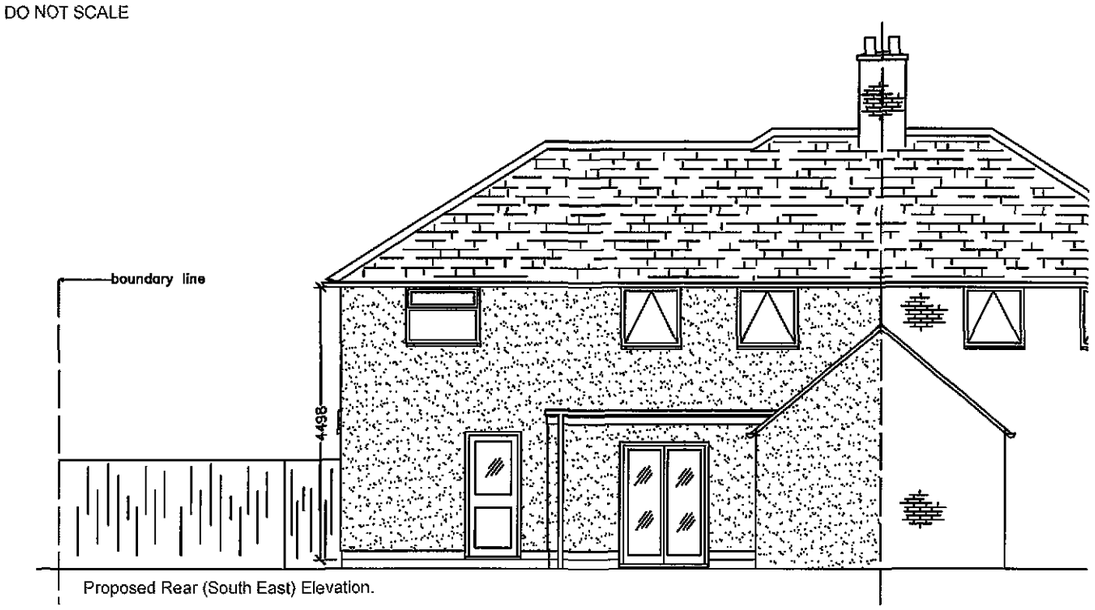


Proposed Rear (South East) Elevation.

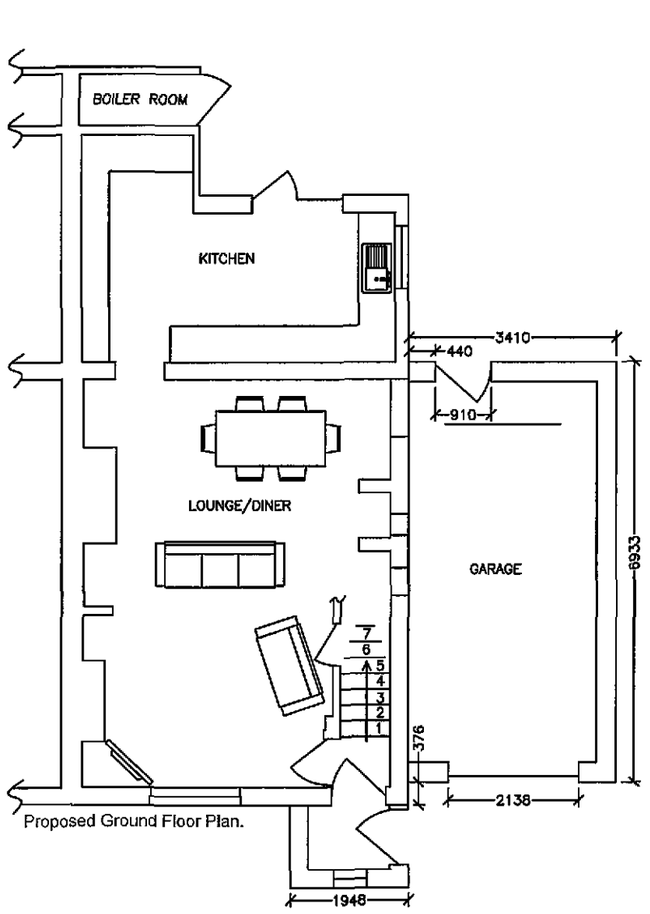

Proposed Ground Floor Plan.

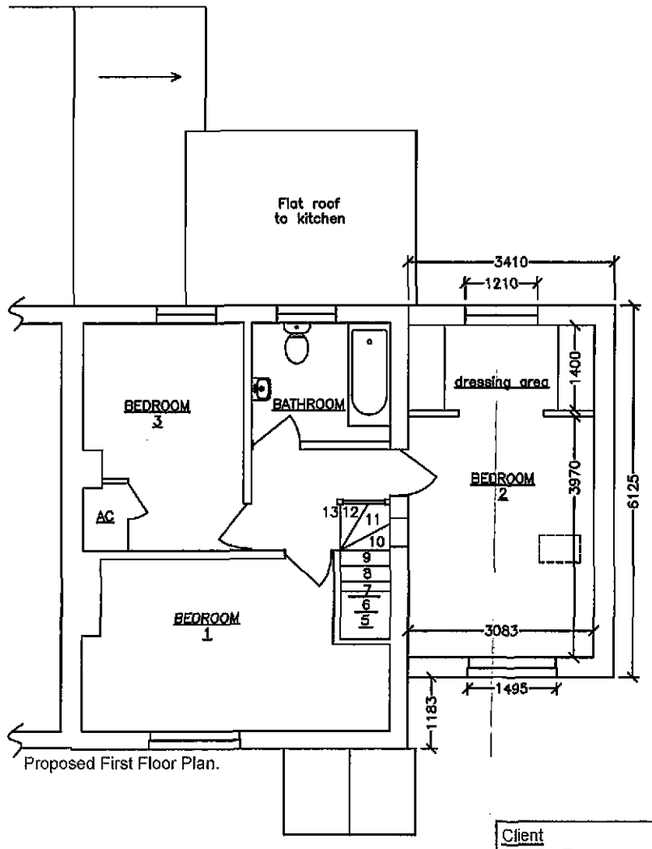

Proposed First Floor Plan.

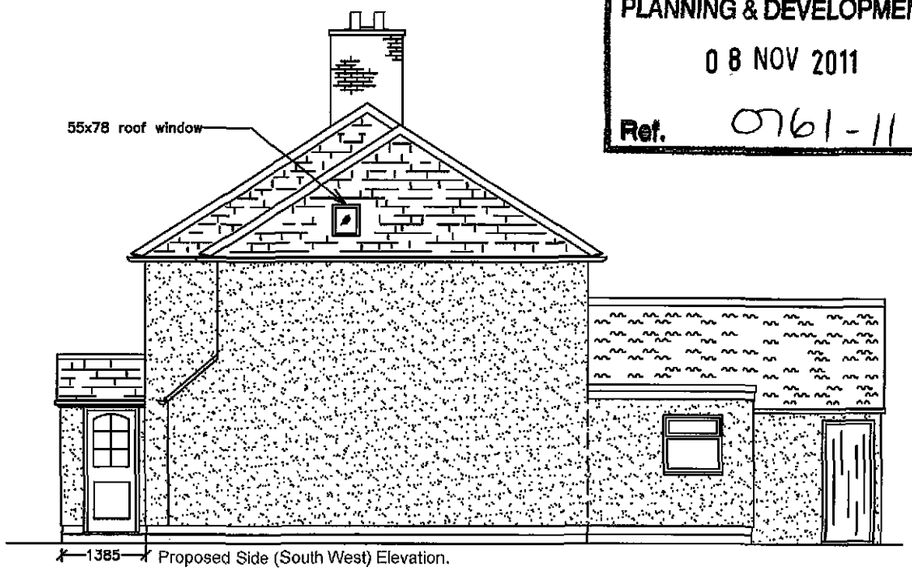

Proposed Side (South West) Elevation.

SHDC
PLANNING & DEVELOPMENT
0 8 NOV 2011
Ref. 0761-11

AMENDED PLAN
Ref. A1

0 10m 20m 30m 40m 50m
1:1250

0 5m 10m 15m
1:500

0 2m 4m 6m
1:200

0 1m 2m 3m
1:100

0 0.5m 1m 1.5m
1:50

Client
Mr C. Freeman.

Project
6 Church Council House, Main Road,
Deeping St. Nicholas, Spalding.
PE11 3EU.

Drawing Title
Proposed Ground/First Floor Plans & Elevations.

Rev.	Date	Amendment	Initial
A	08-11-11	Window removed- roof light added.	JPT

Drawn JPT Date 20-09-11 | Check - Date -

Ref No. 201108 | Dwg No. PL5 | Revision A

Scale(s) 1/100 | Paper A3

Preliminary ☐ For Info ☐ For Comment ☐ Planning ☒ Building Regs ☐ Construction ☐ As built ☐

Architectural Design Services
Jason Thomas
JasonADServices@yahoo.co.uk
07841521271