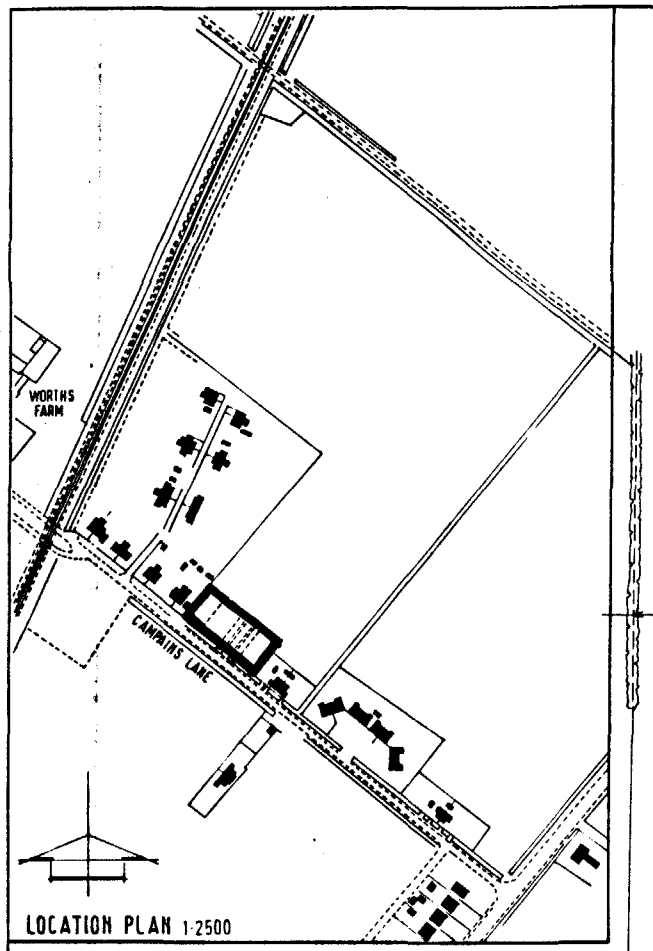


LOCATION PLAN 1:2500

AMENDED PLAN
Dwl.

SOUTH CAMBRIDGESHIRE DC
HOUSING & PLANNING
- 1 NOV 1991
Ref 0853/91

99300

15400 15400 15400 15400

EXISTING HEDGE

1800 5500 1800

COLLE TON ROAD

10500 KERB RADII

30000

Letter posted this Box 12-8

Notice

VISIBILITY SPLAY

VISIBILITY SPLAY

4500

70000

CAMPAINS LANE

61600

DETERMINED PLAN

Dimensions.
Precisely site check. Do not scale from this drawing.

CARTER JONAS
CHARTERED SURVEYORS
62-64 Hills Road Telephone 0223 68771
Cambridge CB2 1LA FAX 0223 69950 FAX

Client
LORD CARRINGTON'S 1971 SPALDING ESTATE TRUST

Job Title
LAND CAMPAINS LANE
DEEPING ST NICHOLAS

Drawing Title
PROPOSED DEVELOPMENT PLAN

Scale ~~1:200~~ 1/1250 Drawn by ~~TPC~~

Date OCT 90

Drg. No. CBN 1535 Rev

T. L.C.C 8/11/90