
MR JIM WYERS. EAST REACH FARM. HOP HOLE. DEEPING ST NICHOLAS. PE11 3HJ

drawing number
JW/10/B

NOTES
1 Do not scale from the drawings.
2 All drawings are the copyright of sharman architecture.
3 This drawing is to be read in - conjunction with all relevant Detail Drawings,Architects Drawings, Structural Engineers Drawings & Design Specifications.
4 This drawing is intended to identify the main features and principal components.Construction work should be carried out and supervised by experienced and competent personnel and hence exhaustive detail is not required.

0 5 10

AS BUILT PLANS

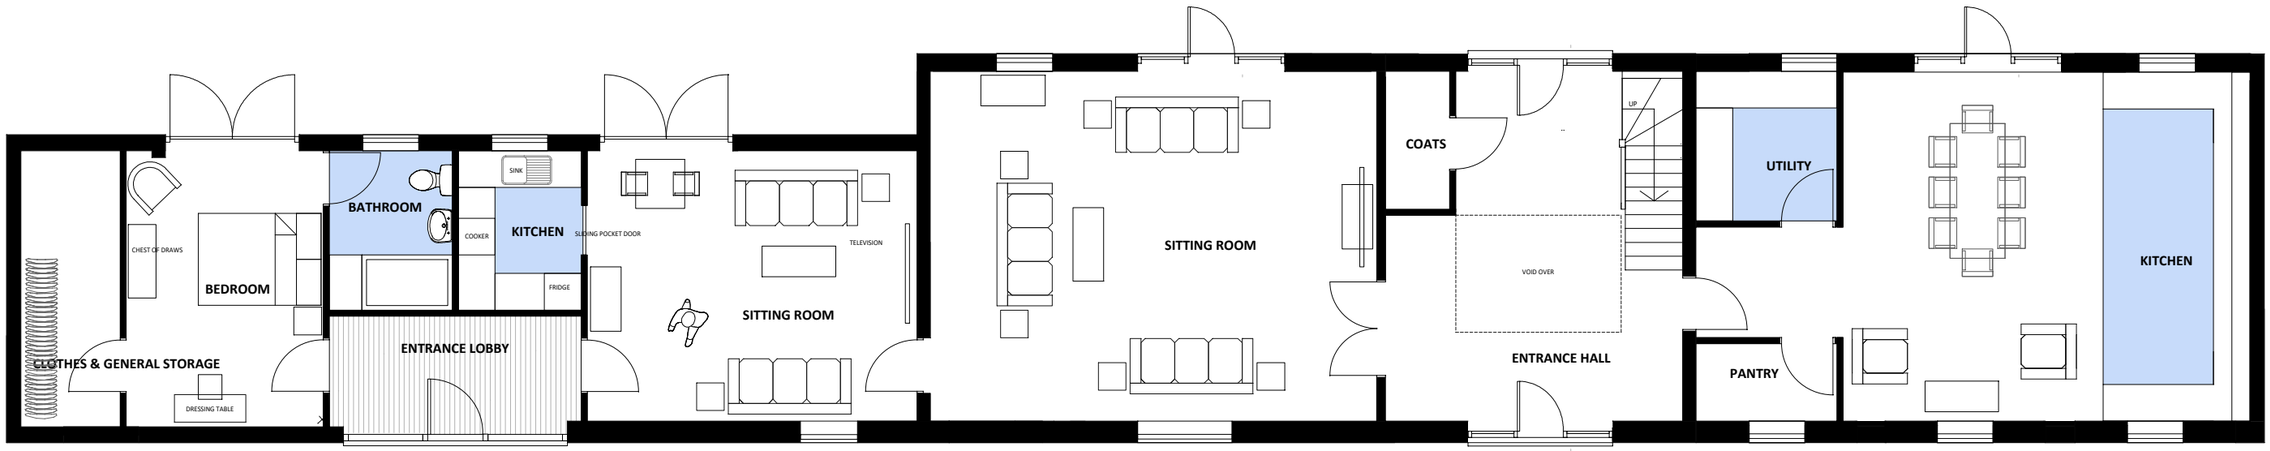

PROPOSED GROUND FLOOR PLAN

SCALE	DATE	REVISIONS
1:100 Print at A3	OCTOBER 2021	A 13/10/2021 Drawing first issued. B 28/10/2026 REVISED TO AS BUILT

PROJECT
PROPOSED GROUND FLOOR PLAN

sharman architecture
OAK BARN. WILLOW DROVE. BOROUGH FEN. PETERBOROUGH. PE6 7QB
tel: 07724 529 094
email: paulsharman1@btinternet.com