
PROPOSED EXTENSION TO WOODLANDS


All dimensions must be checked on site.
Written dimensions to take precedence.
The copyright of this drawing is the property of Templeman Associates Ltd




PROPOSED FRONT ELEVATION SCALE 1:100

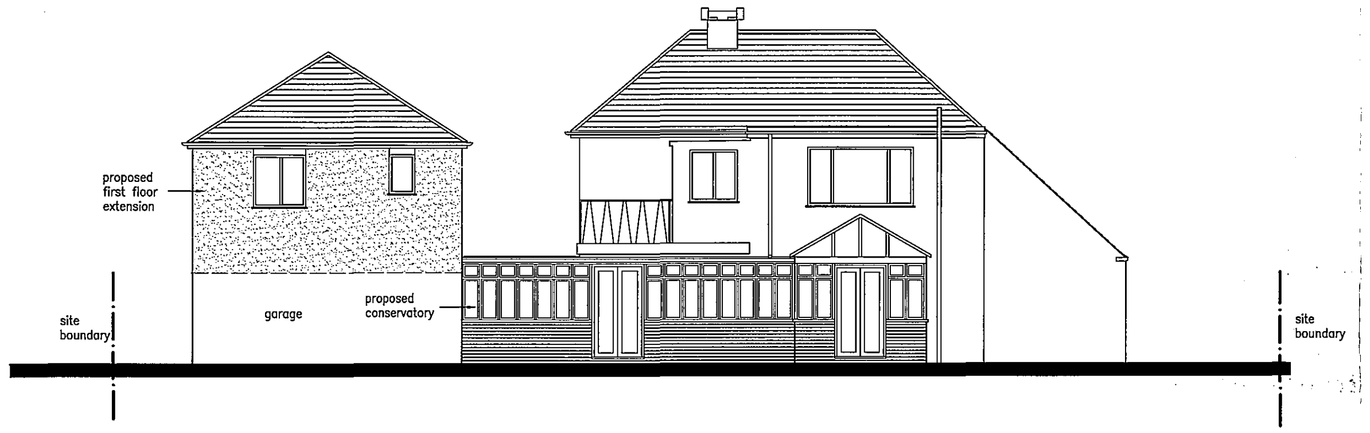


PROPOSED REAR ELEVATION SCALE 1:100

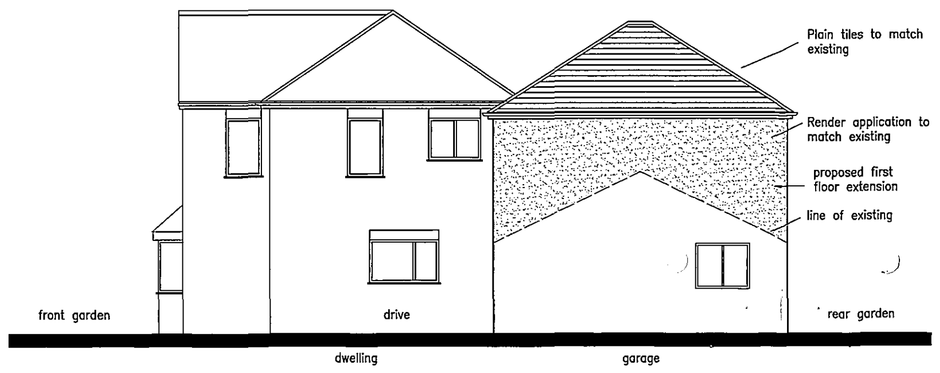

PROPOSED SIDE ELEVATION SCALE 1:100

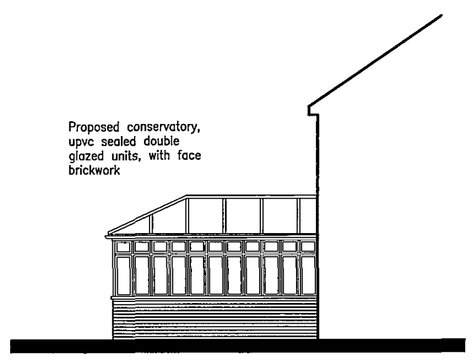

PROPOSED SIDE ELEVATION SCALE 1:100

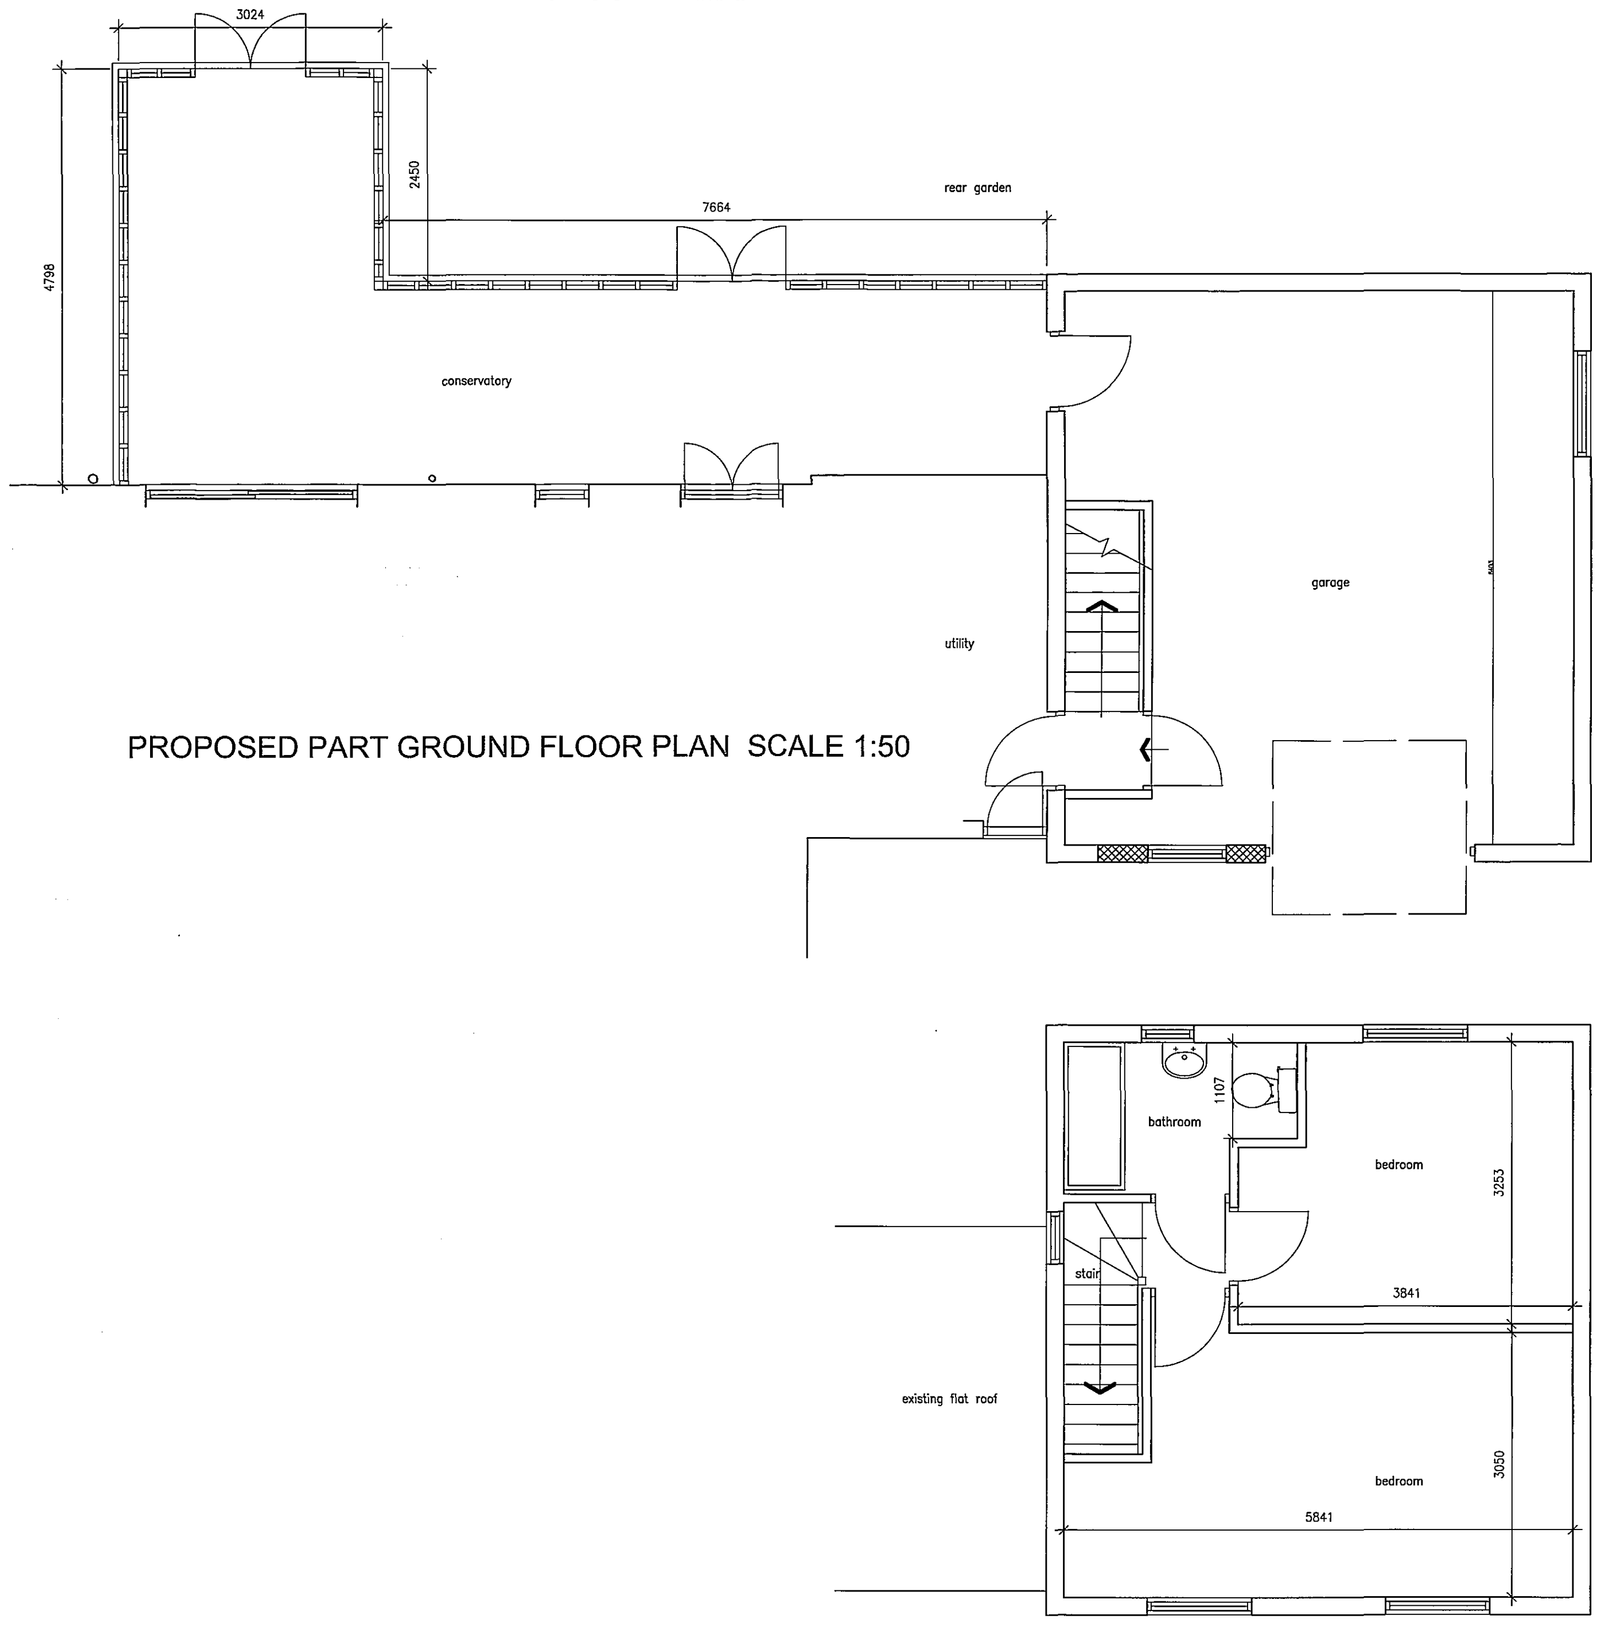

PROPOSED PART GROUND FLOOR PLAN SCALE 1:50

PROPOSED FIRST FLOOR PLAN SCALE 1:50

AMENDED PLAN
Ref. A1

SHDC
PLANNING & DEVELOPMENT
2 6 MAY 2006
Ref. 0669/06

A	May 06	Window to side elevation first floor omitted from plan
Revisions	Date	Description
Amendments		

Templeman Associates
ARCHITECTURE
BUILDING SURVEYING
PROJECT MANAGEMENT
BUILT ENVIRONMENT DESIGN
RICS
Templeman Associates Ltd
Litton House, Global Business Park,
Saville Road, Peterborough. PE3 7PR
Tel: (01733) 843380 Fax: (01733) 333976

Project Title: Proposed Extension to Woodlands 15 Town Dam Lane Donington	Drawing Title: Proposed Elevations & plans
Works Request No.	Dwg No 2354–02 rev A
Drawn RG Date Apr 06	Project Status: Draft / Tender / Construction / As Built
Checked GECT Date Apr 06	
Scale shown CAD Ref 2354–01	

PROPOSED PLANS & ELEVATIONS SCALE 1:50 & 1:100