SOUTH HOLLAND DISTRICT COUNCIL

Council Offices
Priory Road
Spalding
Lincolnshire
PE11 2XE

tel: 01775 761161
fax: 01775 710772
web: www.sholland.gov.uk

Application no: H05-0641-10

Applicant: Mr R Brewer
Five Bells
Fleet Bank
Gedney Dyke
Spalding Lincs
PE12 0AW

FILE COPY

Agent: Mr P Lindsay-Hemmens
The Coach House
Haverholme Priory
Haverholme
Sleaford Lincs
NG34 9PF

Description: Single-storey extension to provide two bedrooms, study and shower room

Location: Five Bells
Fleet Bank
Gedney Dyke
Spalding
PE12 0AW
PE12 0AW

Amendment: Pitched roof added to proposed flat roof extension
(Revision A)

Letter Sent: 10th September 2010

Dear Sir/Madam

ACKNOWLEDGEMENT OF AMENDMENT

I acknowledge receipt of the amended details in respect of the above and confirm that the changes are able to be incorporated in the application which will now **only be considered in its amended form.**

Your rights of appeal remain as explained on the original acknowledgement.

You are reminded that revision to any submission made under the Building Regulations may also be necessary.

Yours faithfully

Head of Planning & Development

AMENDMENT RECORD SHEET – LIVE APPLICATION

Admin to Complete

Date Received ..K.P.....1.0.....9 Registered ☑ 10/98

Case Officer to Complete

Has this amendment been requested? **Yes/~~No~~**

If Yes, is it what was asked for? **Yes/~~No~~**

Is it an amendment in principle? **Yes/~~No~~**

Is it the same character/description for fee purposes? **Yes/No**(Refer to Admin if in doubt)
If No, but amendment requested, the following must be completed if the amendment is to be accepted

Certified That The Development Objectives Outweigh The Financial Objectives
Senior Officer's Signature: ..... **Date:** .....

Re-Consults as a result of this amendment None ☒ All ☒

Partial Parish Council ☐ Ward Member ☐ Press ☐ Site Notice ☐

Residents/Other ☑ - *Name/Address:* ...Residents as before

.....

..... Allz 10 days .....

.....

Case Officer's Decision:

REJECTED – New Application Required ☒

Reason .....

Do you want this reason to be added to the Rejection Notice? **YES/NO**

ACCEPTED – Superseded Details Removed ☑

Note .....

Do you want this note to be added to the Acceptance Notice? **YES/NO**

Revised Description (if applicable) .....

Case Officers Signature G. Dewhurst ..... **Date** 10.9.10 .....

Admin To Complete

Agreed Term Date Updated ☒ Re-Consultations Carried Out (*if necessary*) ☐

Public Register Updated ☑ Acceptance/~~Rejection~~ Letter Issued ☑ 10/98

(Plus Library if Re-Consulting Residents) ~~SCANNED~~

PLANNING AMENDMENT

For Office Use only
Application No: H05-0641-10/A1
Date Registered: 10 SEP 2010
Case Officer: GD

SOUTH HOLLAND DISTRICT COUNCIL

(Please complete using block capitals and black ink)

APPLICANT NAME AND ADDRESS	AGENT NAME AND ADDRESS
MR. R. BREWER FIVE BELLS FLEET BANK GEDNEY DYKE Telephone:	MR. P. LINDSAY-HEMMEDS THE COACH HOUSE HAVERHOLME PRIORY LINCS. NG34 9PF Telephone:

SITE ADDRESS DETAILS

FIVE BELLS, FLEET BANK

FILE COPY

CURRENT APPLICATION NO: This amendment cannot be considered unless the relevant reference is stated.	H05-0641-10
Building Regulation reference relating to same development (if applicable)	—


I attach four copies of this form and necessary plans and request that the changes described below can be accepted as an amendment. As the amendment relates to a current application, I agree to an extension of the terminal date (if applicable).

Signed: [signature] Date: 10.9.10


FULL DESCRIPTION OF DEVELOPMENT OF CURRENT APPLICATION THAT THIS AMENDMENT RELATES TO	SINGLE STOREY EXTENSION	
State details of amendments proposed. (Give a full detailed list of the changes, and also mark these clearly on the accompanying plans. Only the changes listed here will be considered)	PROPOSED PITCH ROOF OVER FLAT ROOF	
State drawing numbers of the current submission		
Has this amendment been requested by the Council? (If so, state Officer dealing with the application)	YES/~~NO~~	G. DEWHURST
Describe any part of the original development which is excluded by virtue of the amendment, and state any alteration to plot numbers	N/A	
Has a similar amendment been submitted under *Building Regulations? (If so, state Building* Control Surveyor dealing with application)	YES/NO	—




FRONT ELEVATION (ROADWAY)

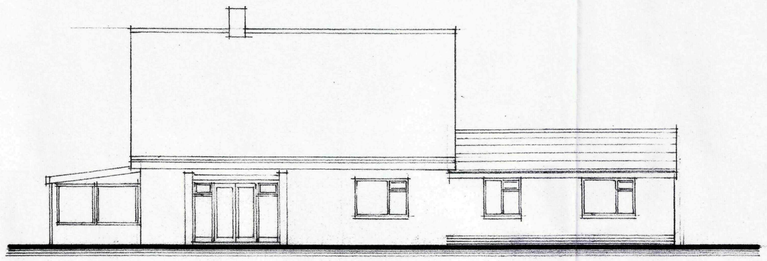


REAR ELEVATION (SOUTH)
1:100

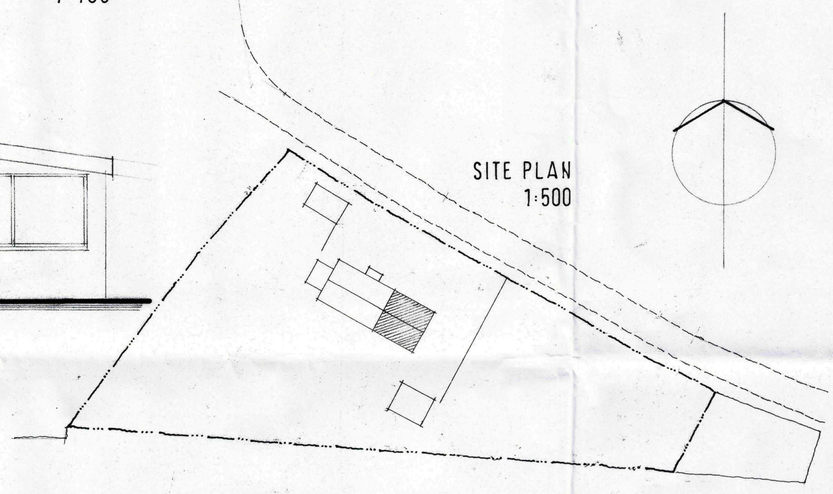

SITE PLAN
1:500

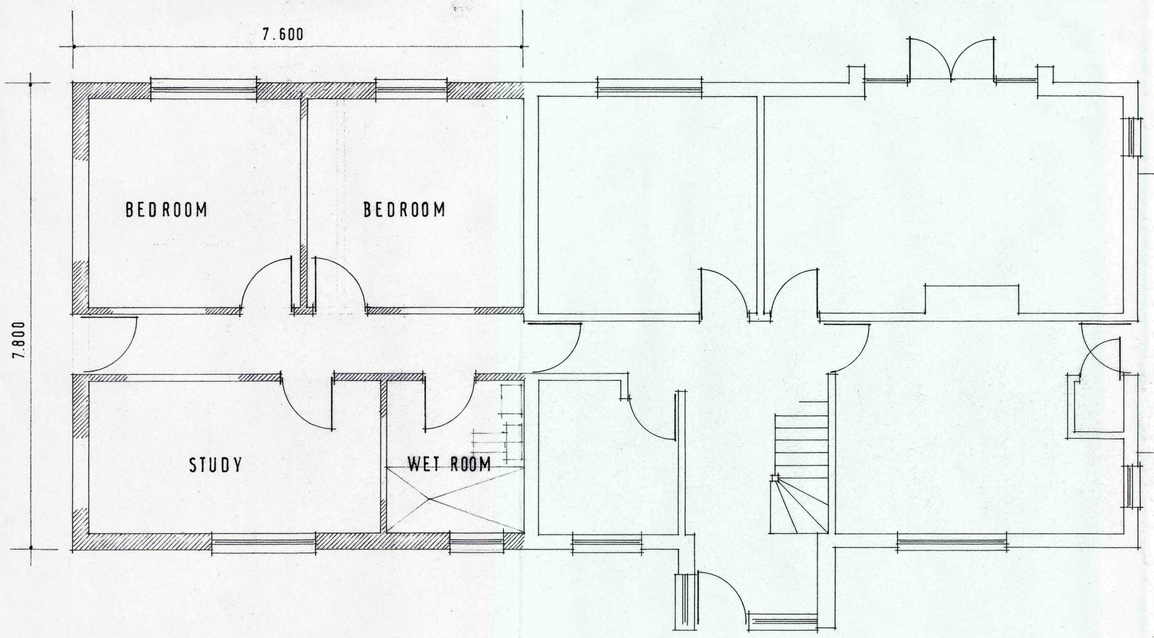

GROUND FLOOR PLAN

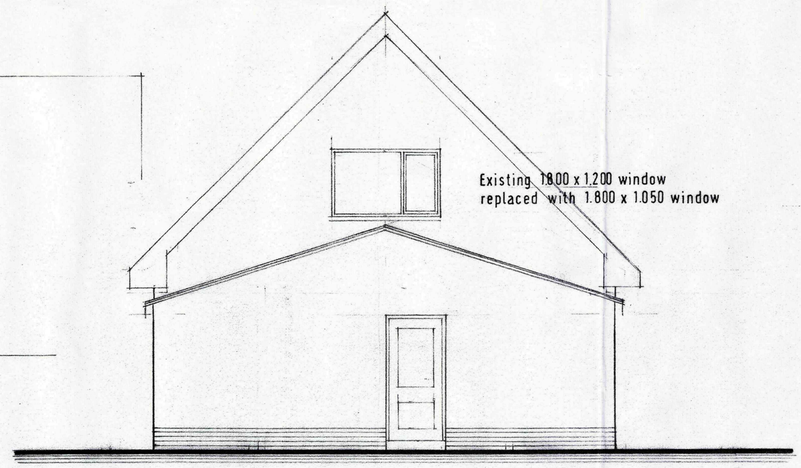

END ELEVATION (EAST)

AMENDED PLAN
Ref. A1

REV.A 20 Aug. 2010
Pitched roof added to proposed extension

Planning & Development
10 SEP 2010
Ref. 0641-10

Peter Lindsay-Hemmens dip.arch.RIBA
Chartered Architect

The Coach House - Haverholme Priory – Lincolnshire NG34 9PF
01-526 834407

e-mail lindsayhemmens002@btinternet.com

Proposed Single Storey Extension
for Mr + Mrs R Brewer

Five Bells – Fleet Bank - Gedney Dyke

Planning Application

Scale 1:50 July 2010