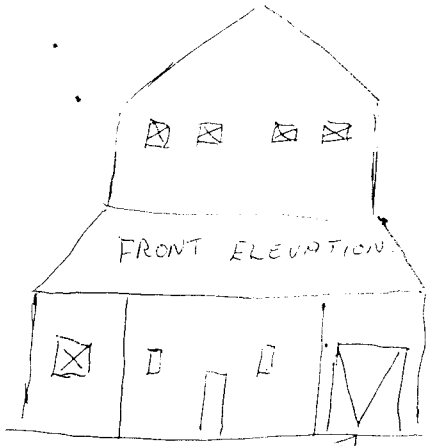



PROPOSED NEW PROVISION FOR 2 CAR GARAGE.

A BRIEF DISCUSSION WAS HELD BETWEEN PLANNING OFFICER MR BLACKLOCK. LCC HIGHWAYS INSPECTOR MR BRIGGS AND MYSELF. ON OFF RD PARKING. HALL LANE DWINDLES DOWN TO A TRACK ONLY.

WOULD LIKE TREES REMOVED OR TOPPED

SOUTH HOLLAND DC
HOUSING & PLANNING
05 JUL 1995
Ref: 0704/95

REAR GARDEN.

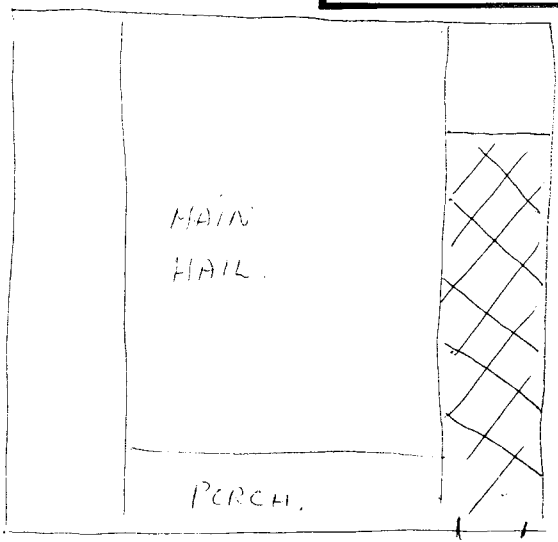


SHADED AREA PROPOSED NEW GARAGE.


INTERNAL LENGTH 36 FT.

WIDTH 8'8".


HALL GATE

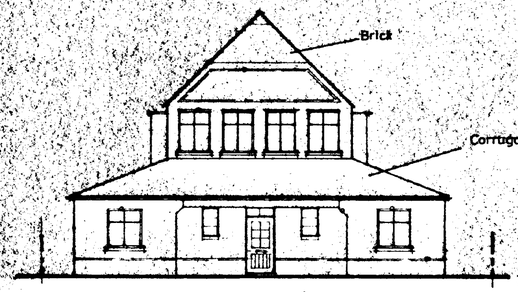

FRONT

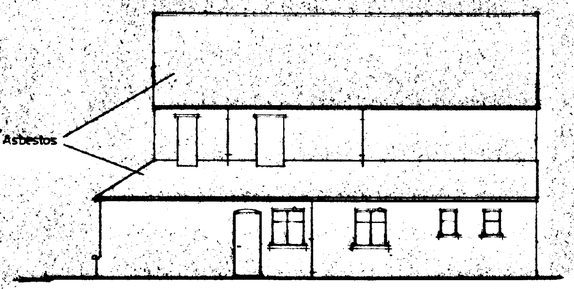


SIDE

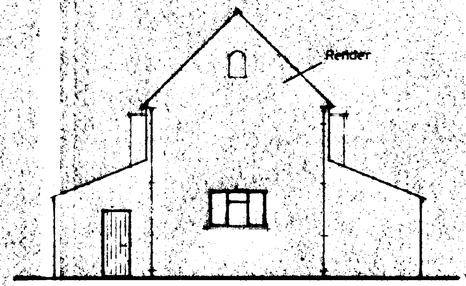


REAR




SIDE

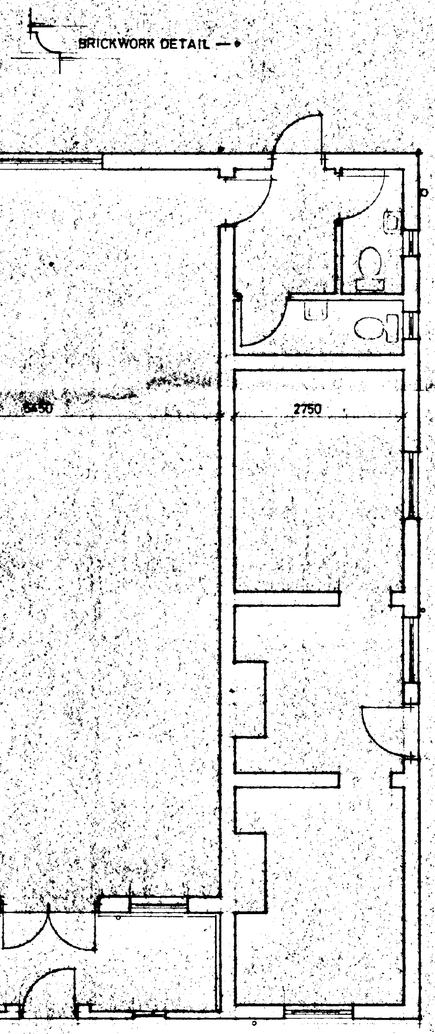

PLAN

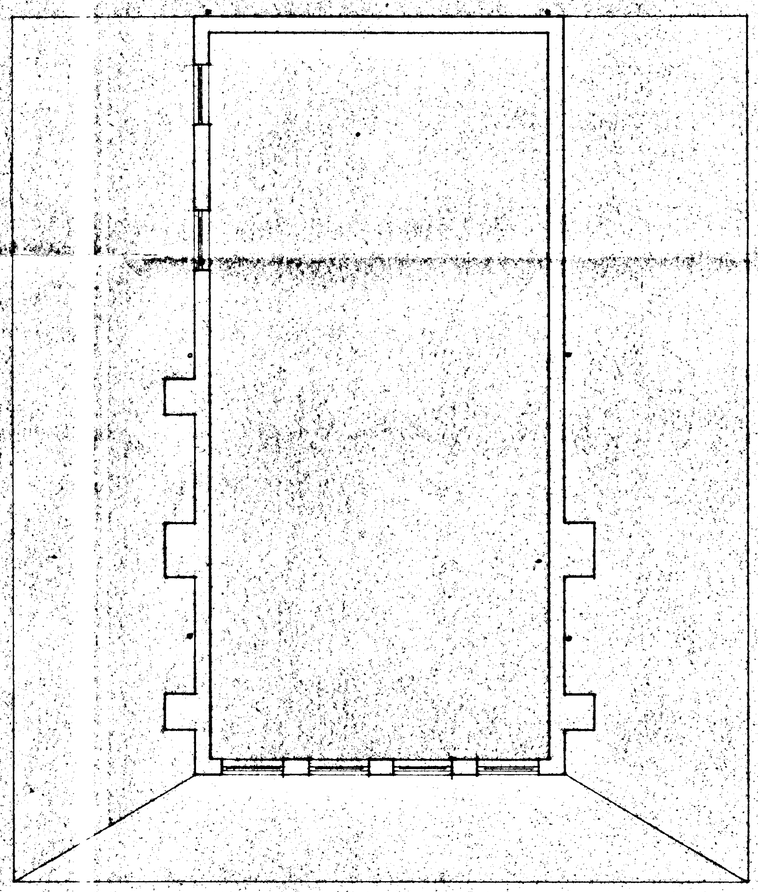

ATTIC PLAN

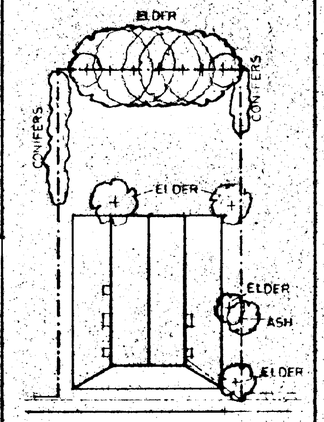

HALLGATE

SITE PLAN SCALE 1/250

SOUTH HOLLAND DC
HOUSING & PLANNING
27 JUL 1995
Ref. 704/95

DETERMINED

G. R. MERCHANT
I.ENG AMICE, FIWO,
ARCHITECTURAL, STRUCTURAL
& LAND DRAINAGE CONSULTANT
TEL: HOLBEACH (01406) 490800

PROJECT:
CONVERSION OF
FLEET VILLAGE HALL
HALLGATE
FLEET

CLIENT:
L. SHOOSMITH.


SCALES:	DATE:
1/50 1/100	JULY 1995
G.R. MERCHANT	DRAWING No.: LS.1

REVISIONS:


EXISTING

DO NOT SCALE FROM THIS DRAWING

This drawing is copyright and may not be altered, erased, photographed or used for any purpose other than that for which it is issued.
The General Contractor is to check all dimensions on site and report discrepancies to the Architect.
All details shown on this drawing including functions are based upon typical site conditions relating to the area. No responsibility can be accepted for abnormal conditions which may be encountered during construction unless reported to the Architect & any design amendments may be considered. Site soil surveys are recommended in respect of foundations to establish specific site conditions before foundation work is undertaken.

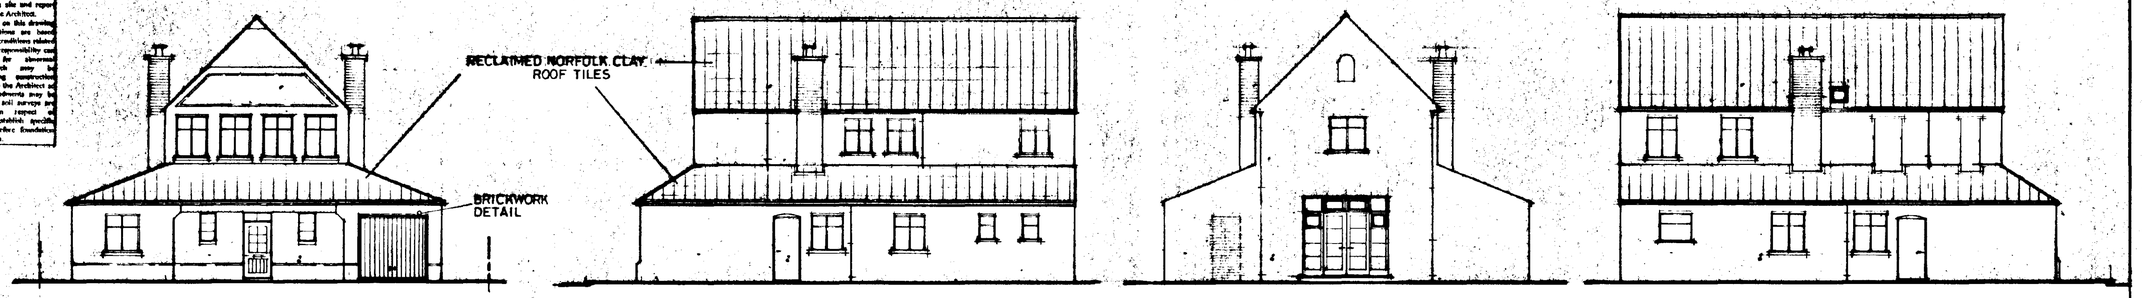


FRONT SIDE REAR SIDE

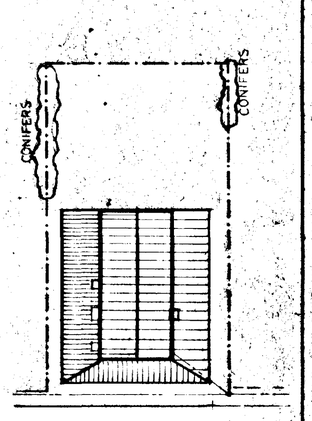


HALLGATE

SITE PLAN SCALE: 1/250

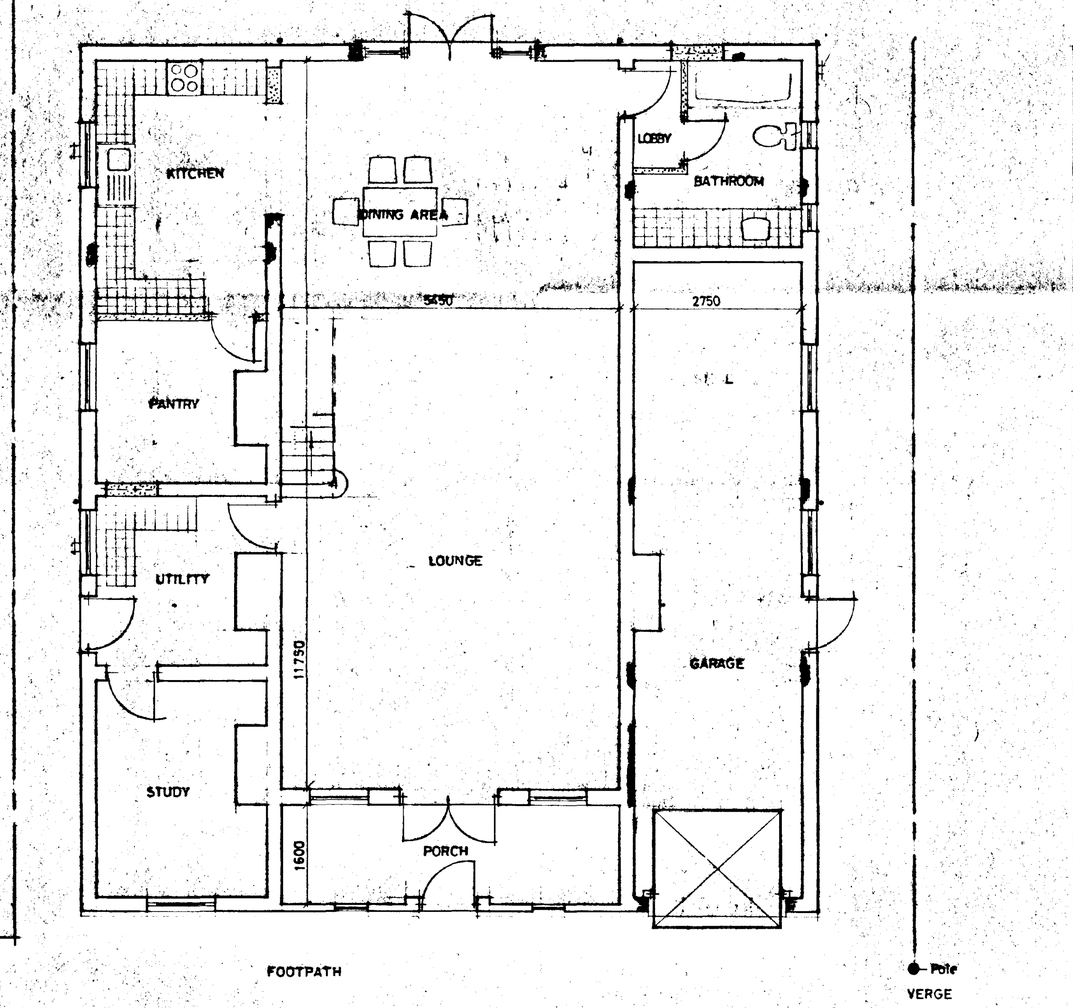

PLAN

HALLGATE

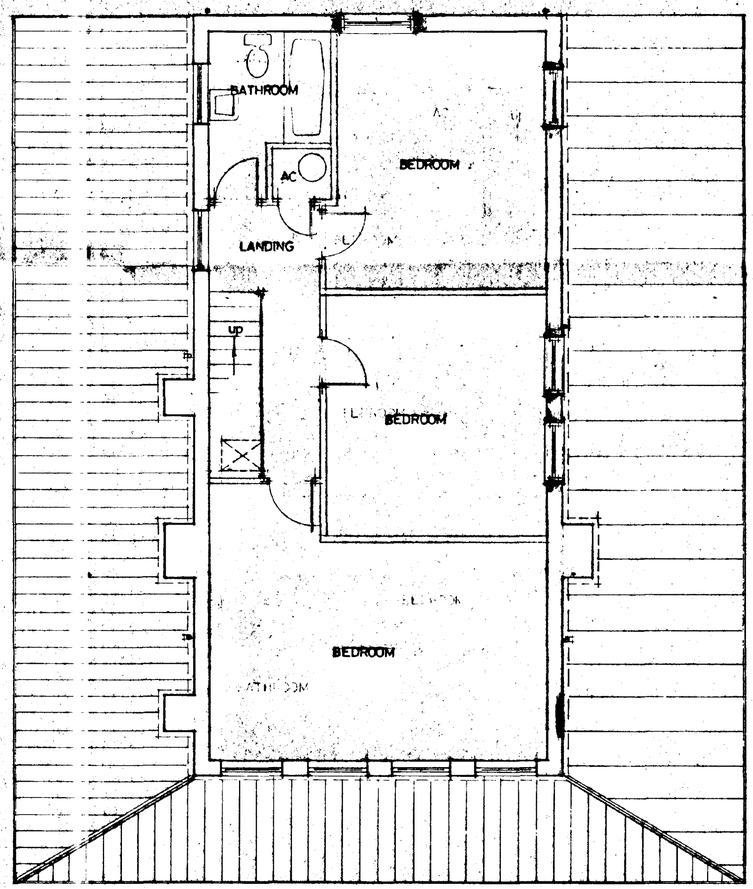

FIRST FLOOR PLAN

PROPOSED

AMENDED PLAN
Ref. A1

SOUTH HOLLAND DC
HOUSING & PLANNING
11 DEC 1995
Ref: 0704/95

A. 28.11.95 Additional Windows & Re-Roofing Stock.
A. 28.7.95 Re-Introduction stock.

G. R. MERCHANT
I.ENG AMICE, FIWO,
ARCHITECTURAL, STRUCTURAL
& LAND DRAINAGE CONSULTANT
TEL: HOLBEACH (01406) 490800

PROJECT:
CONVERSION OF
FLEET VILLAGE HALL
HALLGATE
FLEET


CLIENT:
L. SHOOSMITH.

SCALES: 1/50 1/100
DATE: JULY 1995

G.R.MERCHANT
DRAWING No.: LS.2.B


REVISIONS:
A.B.

SUMMIT
6046-11847

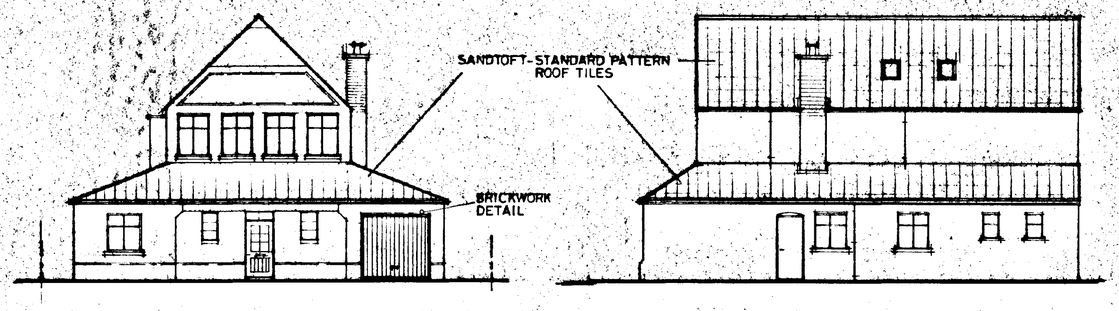


FRONT


SIDE

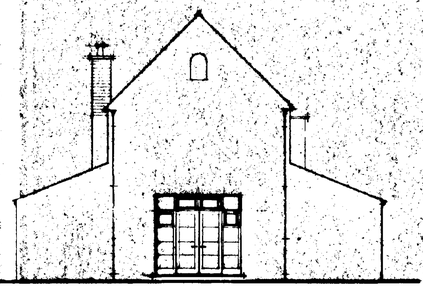

REAR

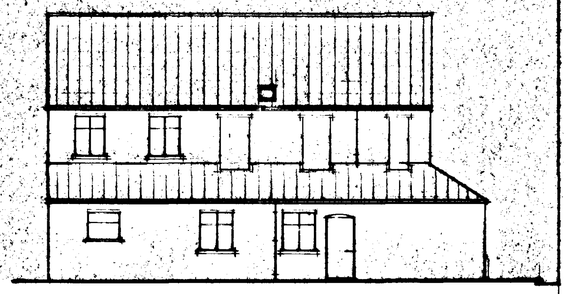


SIDE

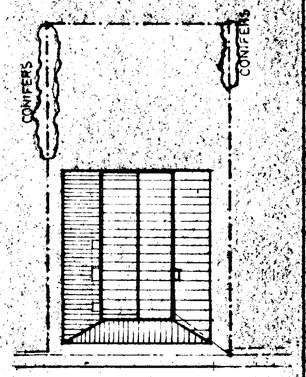


HALLGATE

SITE PLAN SCALE 1/250

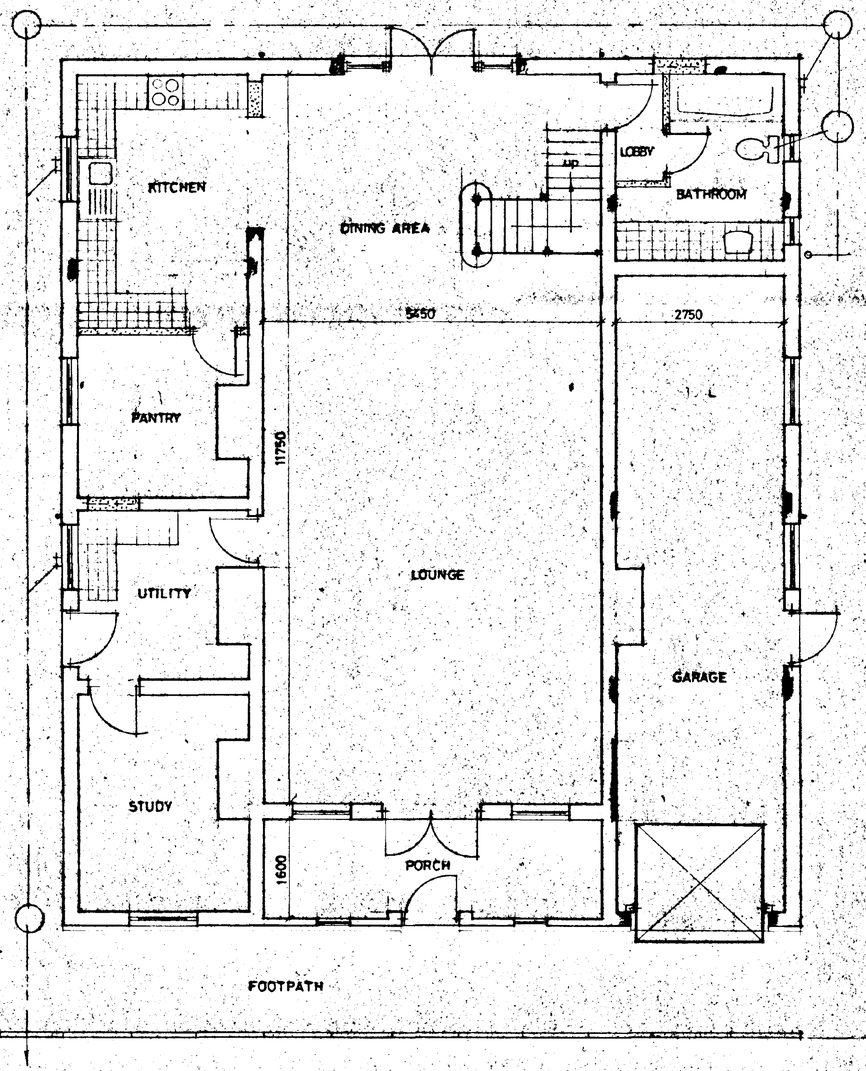

PLAN

HALLGATE

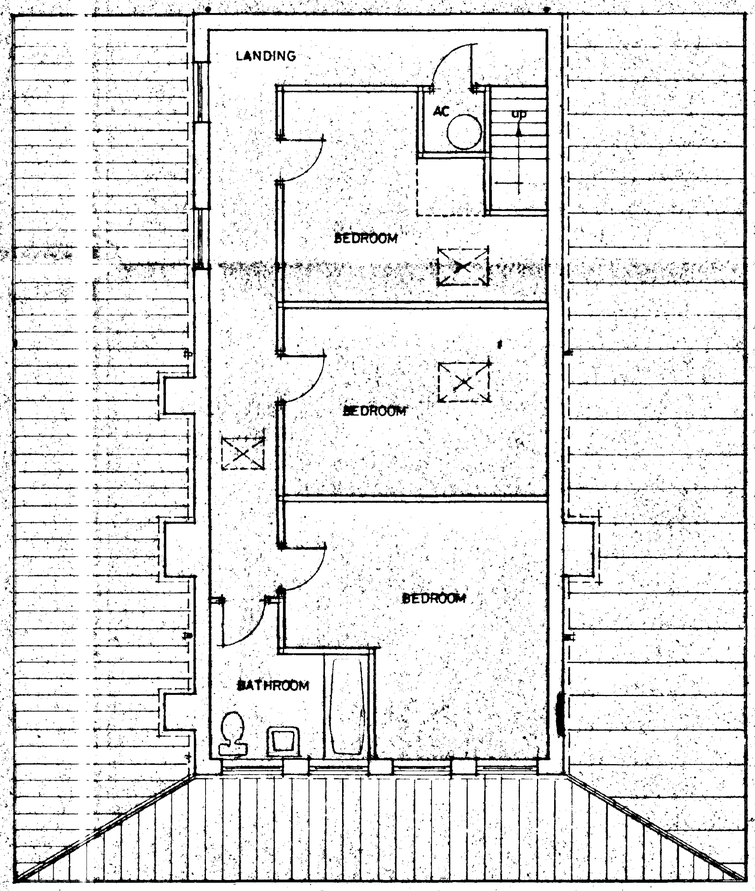

FIRST FLOOR PLAN

PROPOSED

AMENDED PLAN
Ref.

DETERMINED PLAN

SOUTH HOLLAND DC
HOUSING & PLANNING
31 JUL 1995
Ref: 0704/95

A 28795 Re Introduce Stack

G. R. MERCHANT
LENG AMICE, FIWO,
ARCHITECTURAL, STRUCTURAL & LAND DRAINAGE CONSULTANT
TEL: HOLBEACH (01406) 490800

PROJECT:
CONVERSION OF
FLEET VILLAGE HALL
HALLGATE
FLEET

CLIENT:
L. SHOOSMITH.

SCALES:	DATE:
1/50 1/100	JULY 1995
G.R. MERCHANT	DRAWING No.: LS.2A

REVISIONS:
A


SUMMIT
6048-11847

DO NOT SCALE FROM THIS DRAWING

This drawing is copyright and must not be altered, traced, photographed or used for any purpose other than that for which it is issued.

The General Contractor is to check all dimensions on site and report discrepancies to the Architect.

All details shown on this drawing including foundations are based upon typical site conditions related to the area. No responsibility can be accepted for abnormal conditions which may be discovered during excavations unless reported to the Architect so that design amendments may be considered. Site soil surveys are recommended in respect of foundations to establish specific site conditions before foundation work is undertaken.

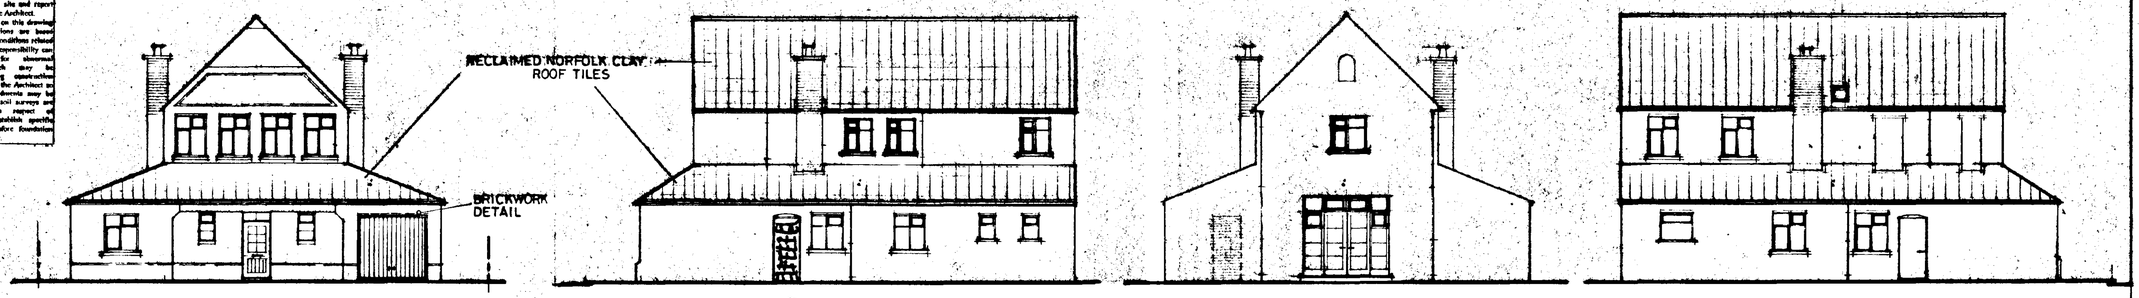


FRONT

SIDE


BLOCK UP DOOR WITH MATCHING BWK.

REAR


SIDE

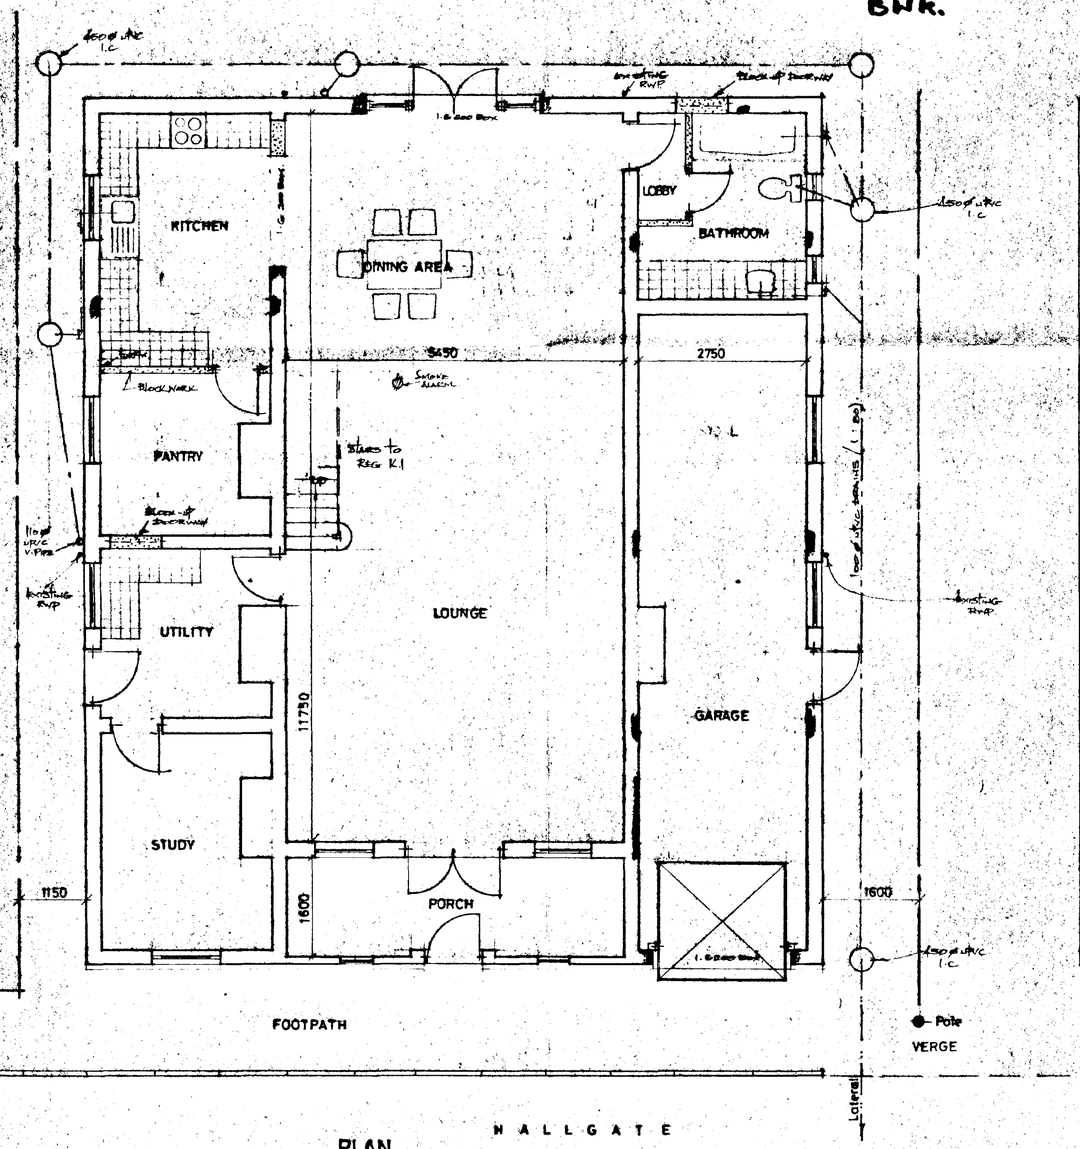

PLAN

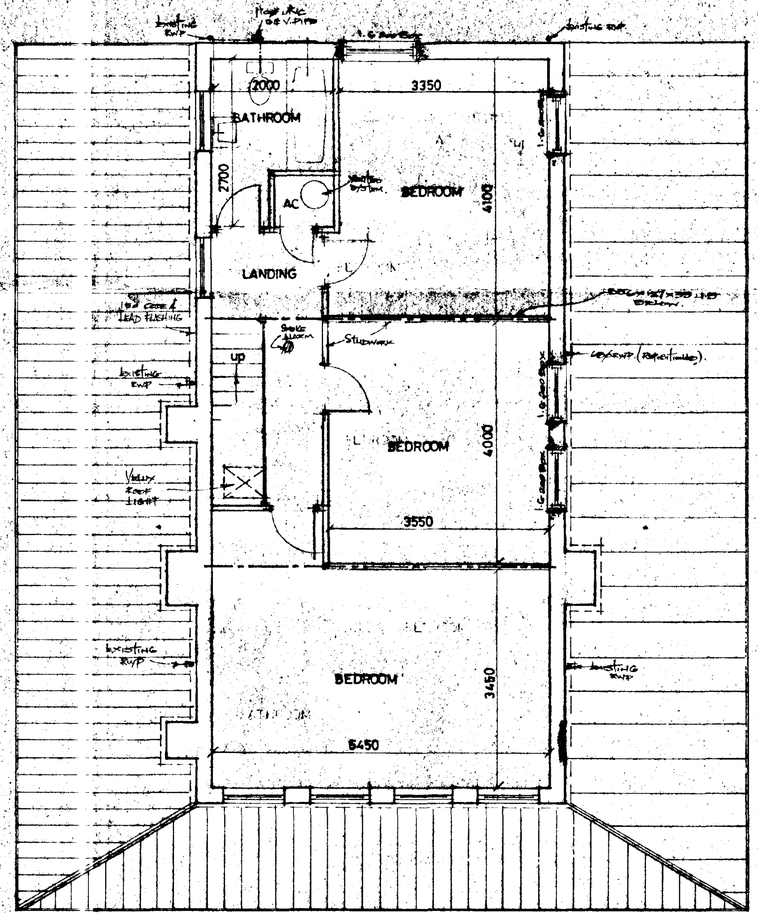

FIRST FLOOR PLAN

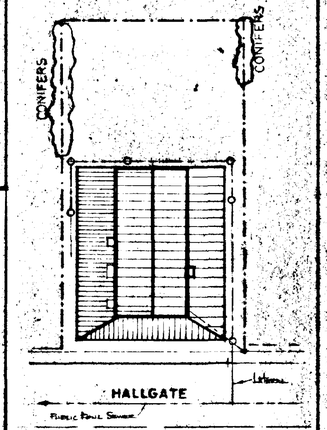

SITE PLAN SCALE: 1/250

SOUTH HOLLAND DC
HOUSING & PLANNING
11 MAR 1996
Ref: 0704/95

PROPOSED

AMENDED PLAN
Ref. A3

8.8.1995 ADDITIONAL WINDOWS & TO BLIND STAIR
A.2695 RE-INTERFACE STAIR.

G. R. MERCHANT
LENG AMICE, FIWO,
ARCHITECTURAL, STRUCTURAL
& LAND DRAINAGE CONSULTANT
TEL: HOLBEACH (01406) 490800

PROJECT:
CONVERSION OF
FLEET VILLAGE HALL
HALLGATE
FLEET

CLIENT:
L. SMOOSMITH.

SCALES: 1/50 1/100

DATE: JULY 1995


G.R. MERCHANT.

DRAWING No.: LS.2.B

REVISIONS:
N.B.


DO NOT SCALE FROM THIS DRAWING

This drawing is copyright and may not be altered, reused, photographed or used for any purpose other than that for which it is issued.
The General Contractor is to check all dimensions on site and report discrepancies to the Architect.
All details shown on this drawing including foundations are based upon typical site conditions encountered in this area. No responsibility can be accepted for abnormal conditions which may be discovered during construction unless reported to the Architect and their design amendments may be required. Site soil surveys are recommended in respect of foundations to establish specific site conditions before foundation work is undertaken.

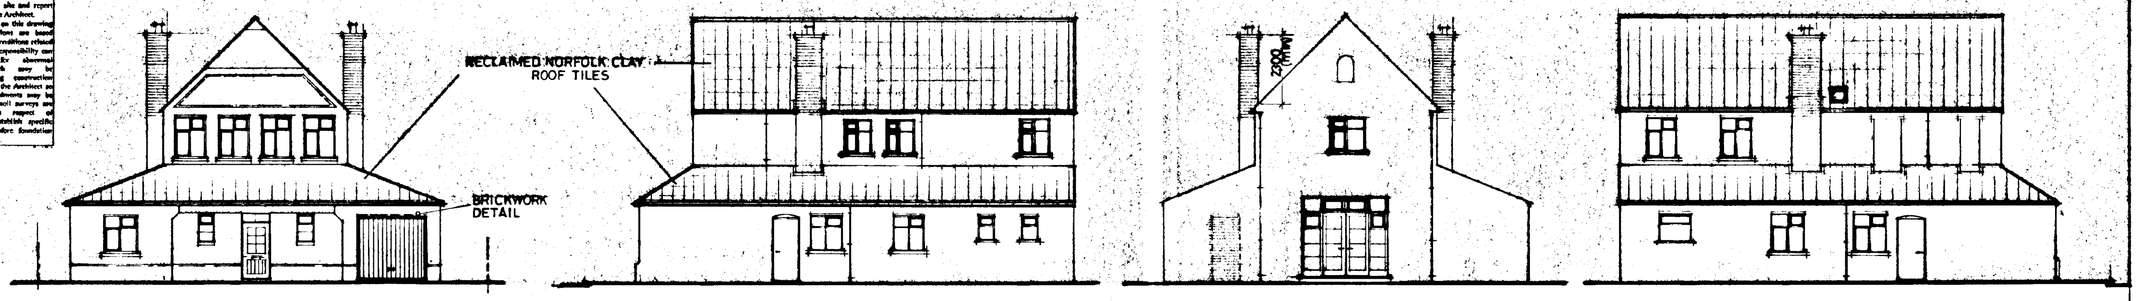


FRONT SIDE REAR SIDE


Note:- ALL INSPECTION CHAMBER INVERTS BELOW EXISTING G.L (1:80 FALL).

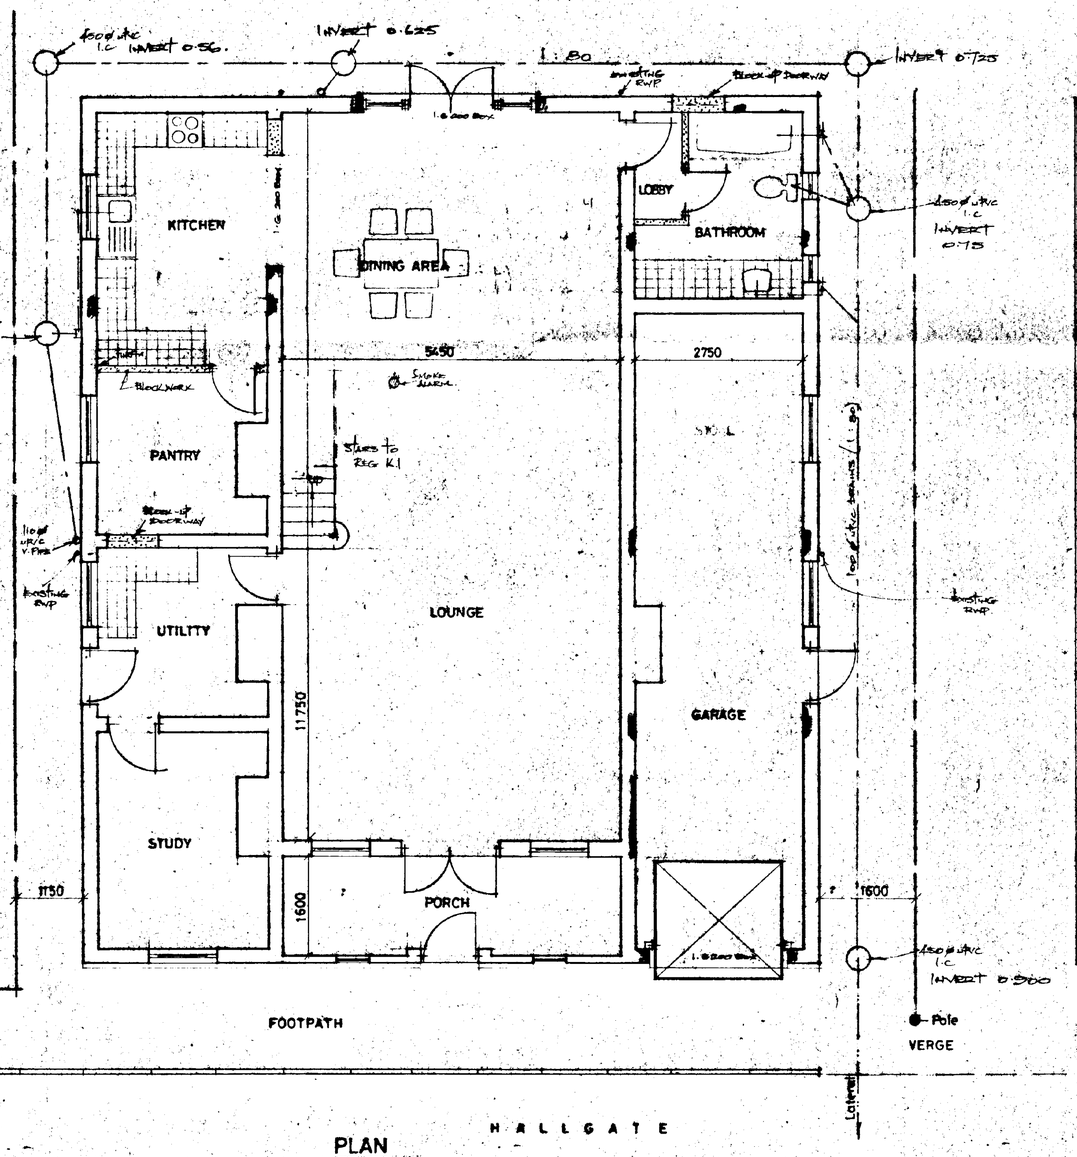

PLAN

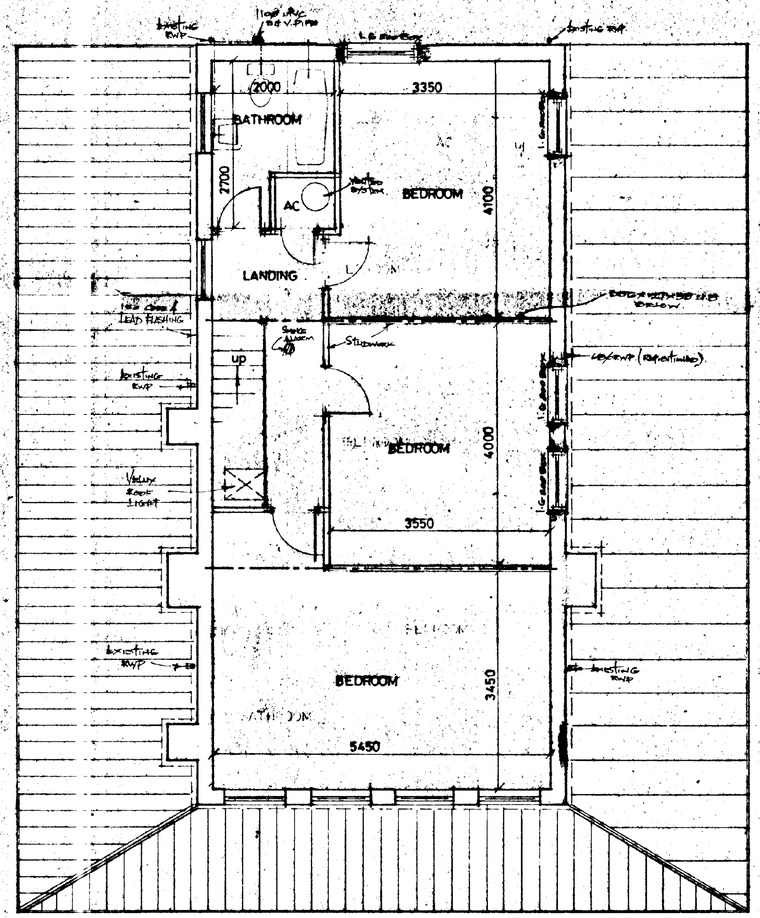

FIRST FLOOR PLAN

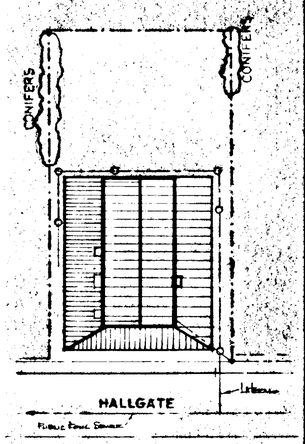

SITE PLAN SCALE: 1/250

PROPOSED

AMENDED PLAN
Ref. A2

07 MAR 1996
Ref: 0704/95


C. 6.3.96 Re-Positioning of Windows
B. 8.12.95 Additional Windows & Re-Build Stack.
A. 28.7.95 Re-Introduce Stack.


G. R. MERCHANT
LEng AMICE, FIWO,
ARCHITECTURAL, STRUCTURAL & LAND DRAINAGE CONSULTANT
TEL: HOLBEACH (01406) 490800


PROJECT:
CONVERSION OF FLEET VILLAGE HALL HALLGATE FLEET

CLIENT:
L. SHOOSMITH.

SCALES: 1/50 1/100
DATE: JULY 1995
G.R. MERCHANT
DRAWING No.: LS.2.C
REVISIONS: A B C

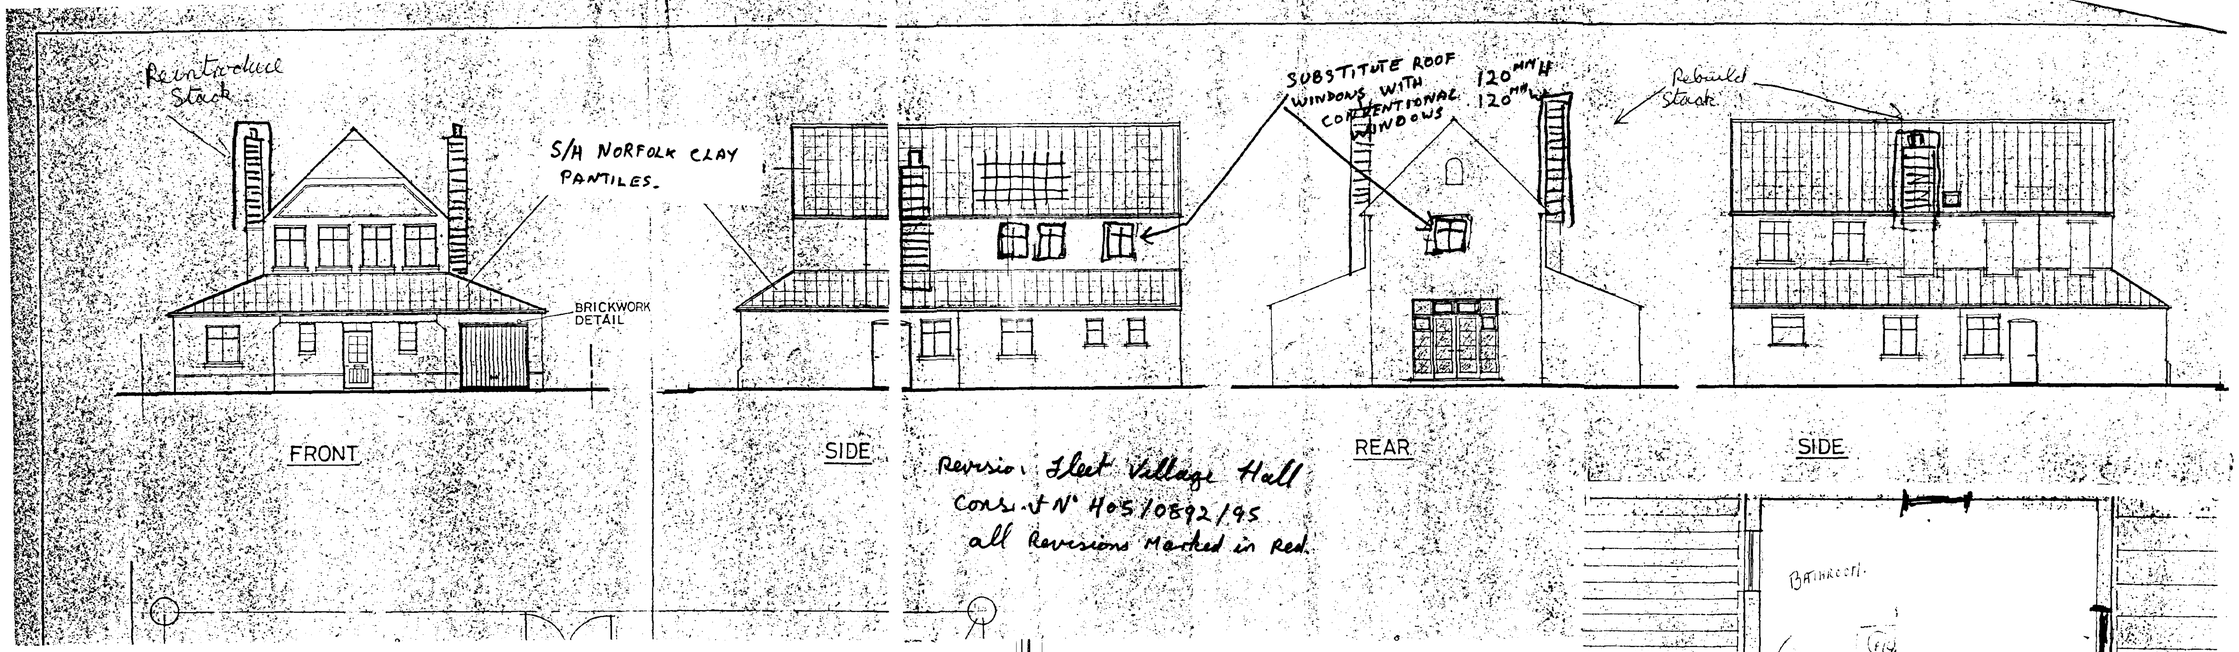
Reintroduce Stack
S/H NORFOLK CLAY PANTILES.
BRICKWORK DETAIL
FRONT
SIDE
SUBSTITUTE ROOF WINDOWS WITH CONVENTIONAL WINDOWS
120MM H
120MM W
REAR
Rebuild Stack
SIDE
Revision: Fleet Village Hall
Cons. N° H05/0892/95
all Revisions Marked in Red.

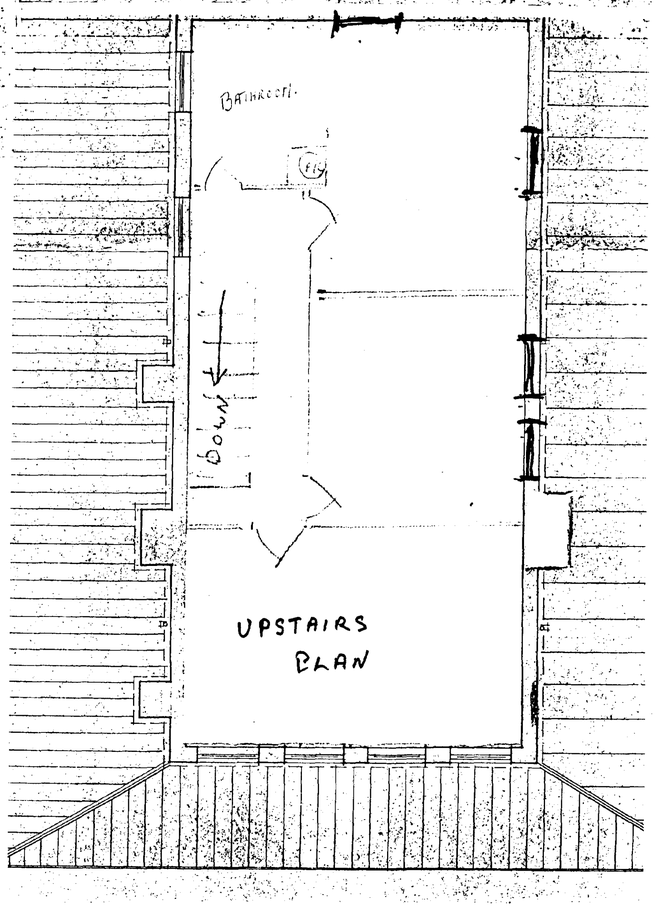
BATHROOM
UPSTAIRS PLAN

 

S/H NORFOLK CLAY PANTILES.

BRICKWORK DETAIL

SIDE

SUBSTITUTE ROOF WINDOWS WITH CONVENTIONAL WINDOWS


120 MM
120 MM

REAR


Reintroduce Stack

SIDE

Revision for Fleet Village Hall
Current N HOS/0892/95
all Revisions Marked in Red.

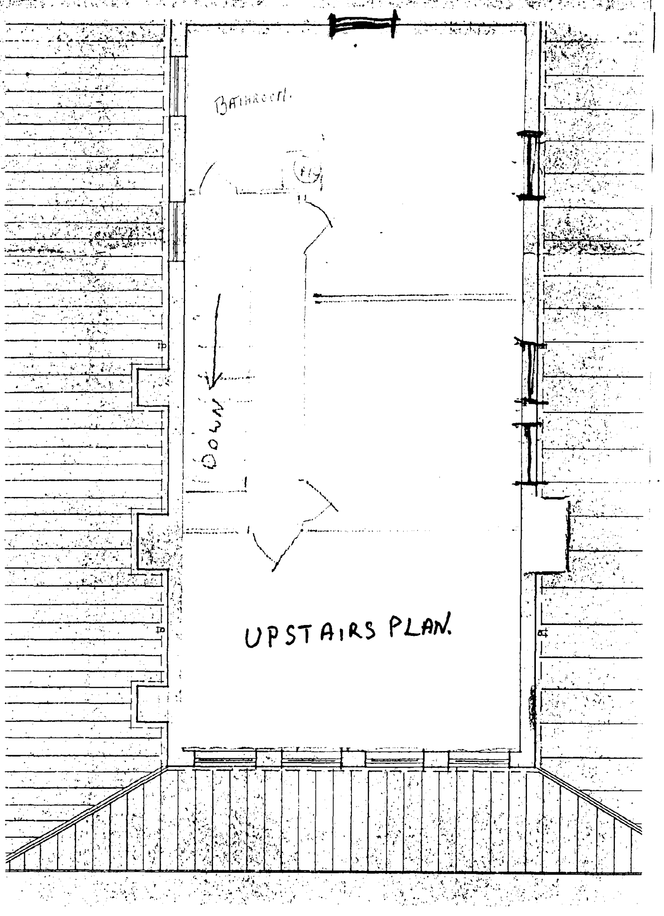


UPSTAIRS PLAN.

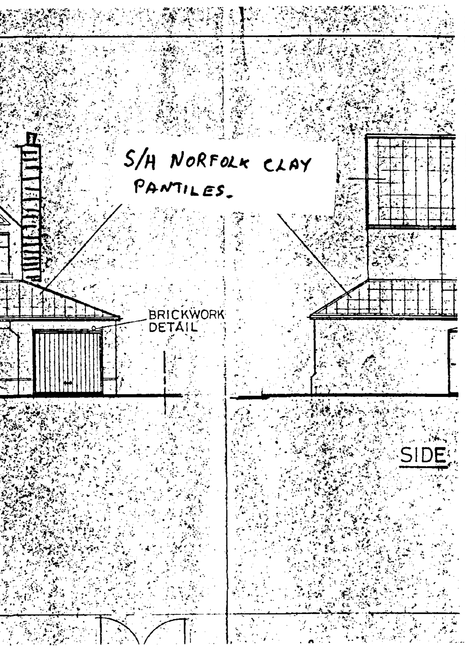

SIDE




REAR

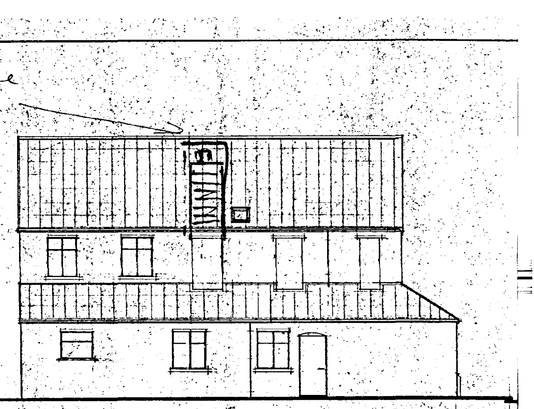

SIDE

Revisions for Sleat Village Hall
consent No H05/0892/95
All revisions marked in RED.

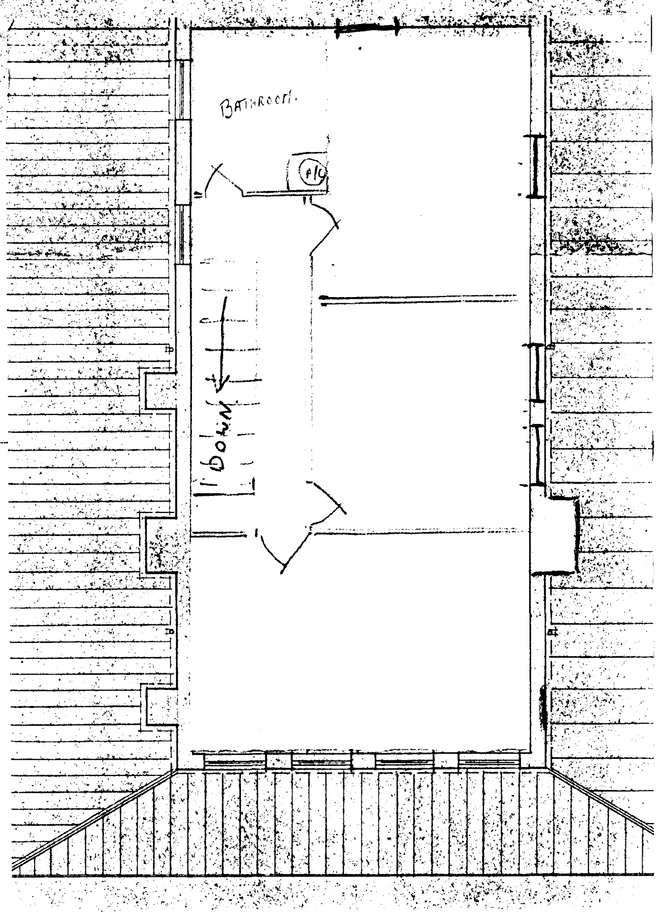

S/H NORFOLK CLAY PANTILES.

BRICKWORK DETAIL

SIDE

SUBSTITUTE ROOF WINDOWS WITH CONVENTIONAL WINDOWS

120 MM
120 MM

REAR

Reintroduce Stack

SIDE

Revision for Sleat Village Hall.
consent No H05/0892/95
all Revisions Marked in Red

