

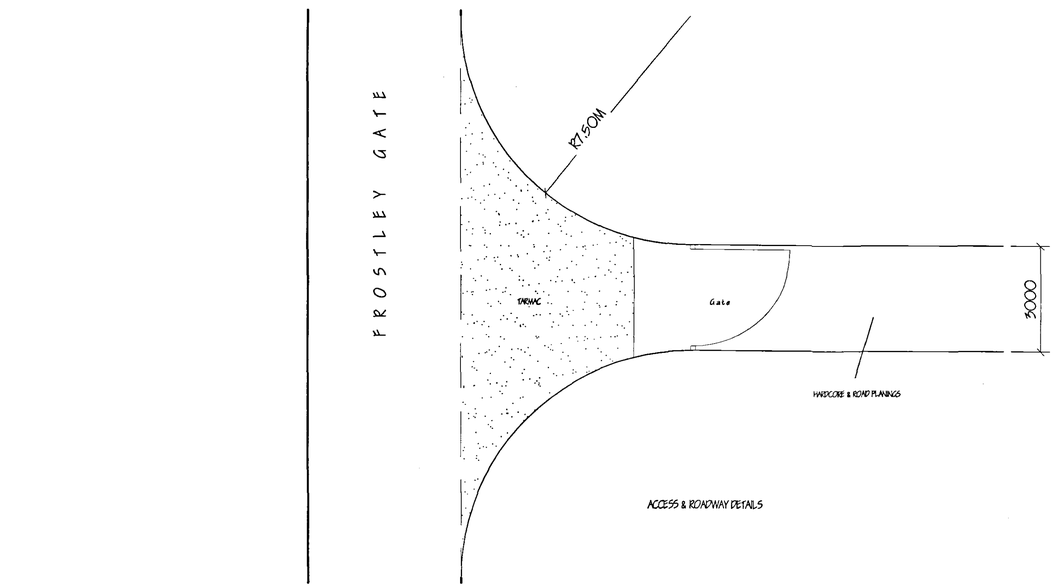



ACCESS & ROADWAY DETAILS

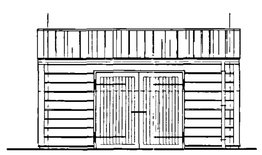


FRONT ELEVATION

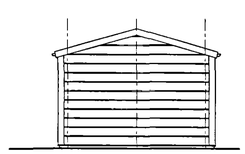


END ELEVATION

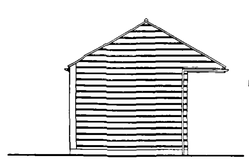


END ELEVATION

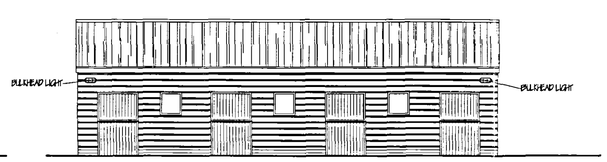


FRONT ELEVATION

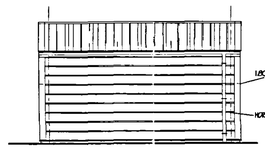


REAR ELEVATION

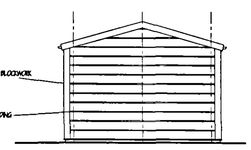


END ELEVATION

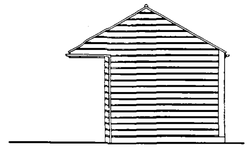


END ELEVATION

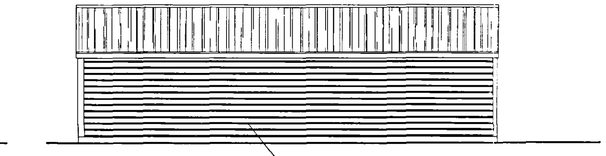

REAR ELEVATION

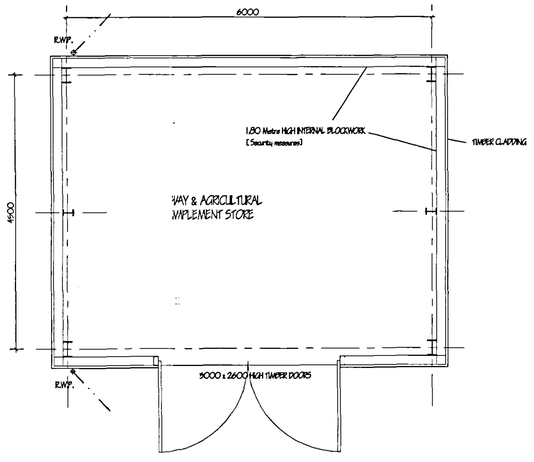

FLOOR PLAN - HAY STORE

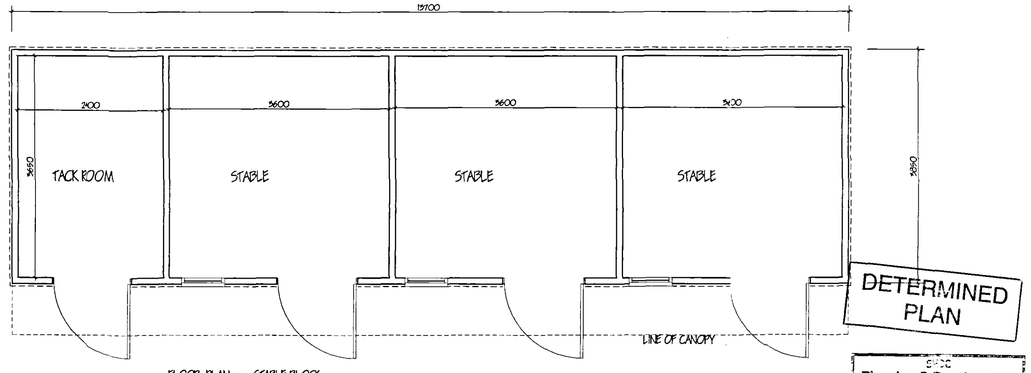

FLOOR PLAN - STABLE BLOCK

DETERMINED PLAN

Planning & Development

07 JUL 2006

Ref: 0837/06

AMENDED PLAN

Ref. A1

A	AMEND ACCESS ROADWAY WIDTH - PLANNING	JLY '06
ref.	revision	date

G. R. MERCHANT LTD.
I.ENG AMICE FIWO

ARCHITECTURAL, STRUCTURAL AND LAND DRAINAGE CONSULTANTS

4 Wrights Mews
12A Park Road, Holbeach,
Spalding, Lincs. PE12 7ZE
Tel: 01406 420600
Fax: 01406 426744
E-Mail: gr.merchant@btconnect.com

Project
PROPOSED STABLES & BARN.
LAND OFF FROSTLEY GATE.
HOLBEACH FEN.
SPALDING. LINC'S.

Client
MR. N. SMITH.

Drawing
FLOOR PLANS & ELEVATIONS OF BUILDINGS & CONDITION COMPLIANCE DETAILS.

Job Ref.	Drawing No.
1288-05.	02 A.
Date	Drawn
JUNE '06.	GRM.

Scales
1/50. 1/100.

DO NOT SCALE FROM THIS DRAWING

This drawing is copyright and may not be altered, traced, photographed or used for any other purposes other than that for which it is issued. The General Contractor is to check all dimensions on site and report any discrepancies to the Architect. All details shown on this drawing including foundations are based upon typical site conditions noted to the area. No responsibility can be accepted for abnormal conditions which may be discovered during construction unless reported to the Architect so that design amendments may be considered. Site soil surveys are recommended in respect of foundations to establish specific site conditions before foundation work is undertaken. This drawing is limited in the amount of information contained and does not purport to contain a full specification of the works. It is solely for the purpose of obtaining Planning / Building Regulation approval. The drawing is not to be used for the purpose of obtaining tenders or quotations. Unless otherwise stated on the drawing or by the statement of any representative thereof, it is the client or their appointed agents responsibility to control workmanship, substitution of materials, adherence to specification, variations to surveyed AS-LAID materials to be new unless otherwise stated and all components and materials etc. to be used fixed and installed etc. in strict accordance with manufacturers instruction and relevant code of practice. Materials shall conform to appropriate British standard specification or BBA certificate or European code equivalent. The Employer / Client shall ensure that the selected contractor is conversant with and adopts all measures necessary to achieve compliance with Health and Safety legislation for Building sites and Work places. The Employer / Client is advised that should the works need to comply with the Construction Design and Management Regulations an Independent Planning Supervisor will be required. The works shall comprise of all that is shown on the drawing and details. Work that may not specifically be shown but they be reasonably inferred as necessary to carry out the works shall be deemed to be included. It is the plot / land owners responsibility to be aware of the Party Wall etc. Act 1996, when building in close proximity to adjoining neighbors boundaries.