PLANNING AMENDMENT

For office use only

Application No. HOS/1492/00/AZ

Date Registered 30 OCT 2001

Case Officer Dmer.

1. Please complete in block letters

NAME AND ADDRESS OF APPLICANT

Mrs L Leicester
Patria Lodge
Jekyll's Gate
Tel. No. Fleet Fen

NAME AND ADDRESS OF AGENT
(if form completed by agent)

Tel. No. (Contact)

Please complete in block letters

FULL POSTAL ADDRESS OF THE APPLICATION SITE

Cottage, Jekyll's Gate, Fleet Fen

Please complete

APPLICATION No.

This amendment **cannot be considered** unless the relevant reference is stated

HOS/1492/00

Building Regulation reference relating to same development (if any)

2. Please tick **one** box only

A — Amendment is proposed where permission already granted ☑ or
If yes, submit two forms and two plans.

B — Amendment is to a proposal currently being considered ☐
If yes, submit four forms and four plans.

Please complete

I attach the necessary plans and request that the changes described below be accepted as an amendment. I understand that the Council may require a fresh application, together with fee if appropriate. If the amendment relates to a current application, I agree to an extension of the terminal date.

Signed ..... Date .....

3. Please complete in block letters

FULL DESCRIPTION OF DEVELOPMENT IN ORIGINAL APPLICATION

Paddock + Stables

State details of amendments proposed

(Give a full detailed list of the changes, and also mark these clearly on the accompanying plans. Only the changes listed here will be considered.)

Reposition Stables

State drawing no's of the current submission

Has this amendment been requested by the Council? (If so, state Officer dealing with the application)

YES / NO

Describe any part of the original development which is excluded by virtue of the amendment, and state any alteration to plot numbers

Has a similar amendment been submitted under Building Regulations? Yes / No

FILE COPY

SOUTH HOLLAND DISTRICT COUNCIL

Chris Simpkins
Chief Executive
Terry Huggins
Director of Customer Services
Bob Atkins
Director of Corporate Services

Application no: H05/1492/00

Original Applicant:
Mr and Mrs B J Holmes
The Cottage
Jekils Gate
Holbeach
Spalding, Lincs

Original Agent:
David Broker Design
Danbrooke House
Station Road
Wisbech St Mary
Wisbech Cambs PE13 4RW

Description: Use of land as paddocks, plus erection of stables & associated access/parking

Location: The Cottage
Jekils Gate
Holbeach
Spalding

Amendment: Reposition stables
Dwg. No. 614BJHOLMES

01-NOV-01

Dear Sir/Madam

TOWN AND COUNTRY PLANNING ACT 1990
NOTICE OF ACCEPTANCE OF AMENDMENT

The amended details submitted in respect of the above proposal have now been considered and there are no objections to the amendment being implemented to the extent described above.

Note: This Notice does not convey any approval under the Building Regulations and you may need to make a new submission.

Yours faithfully

Director of Customer Services

Mrs L Leicester
Patria Lodge
Jekylls Gate
Fleet Fen
Nr Holbeach Lincs PE12 8QS

Council Offices
Priory Road
Spalding
Lincolnshire
PE11 2XE

Telephone: (01775) 761161
Fax: (01775) 711253
Email: Info@sholland.gov.uk

AMENDMENT RECORD SHEET - POST DECISION

Admin

Validation:

Inadequate/Inappropriate ☐

Clarification/Details required:

Appears valid ☑ VKP

Registered 31/10/01

DC Procedural Assessment

Is the information given correct? Yes/~~No~~ (If No, state above what details are needed)

Is it an amendment in principle? Immaterial/~~Needs new app~~

Confirmed: ..... 31/10.

Give a revised description if the details accepted are different to the submission:

Acceptance issued: 1/11/01



DG

Patria Lodge
Jekylls Gate
Fleet Fen
Nr Holbeach
Lincs
PE12 8QS

29.10.01

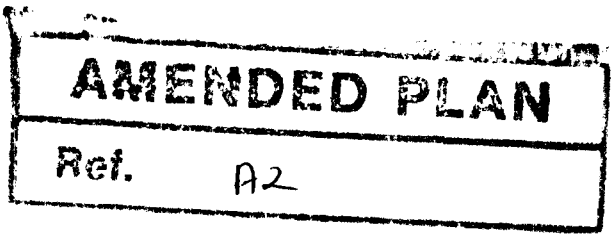

Tel 01406 422554 (eve
01553 616459 (da

Dear Mr Gedney

Further to out telephone conversation on Friday regarding the plans for stables please find attached a copy of the layout an scale plan as requested. Please withdraw the previous amendment, we would now like the construction to remain in wood but to build the stables in an L shape rather than a straight line.

I would be grateful if you would confirm if this is possible at your earliest convenience.

Many thanks

L. Leicester

Mrs L Leicester

RECEIVED PLAN
No. A2

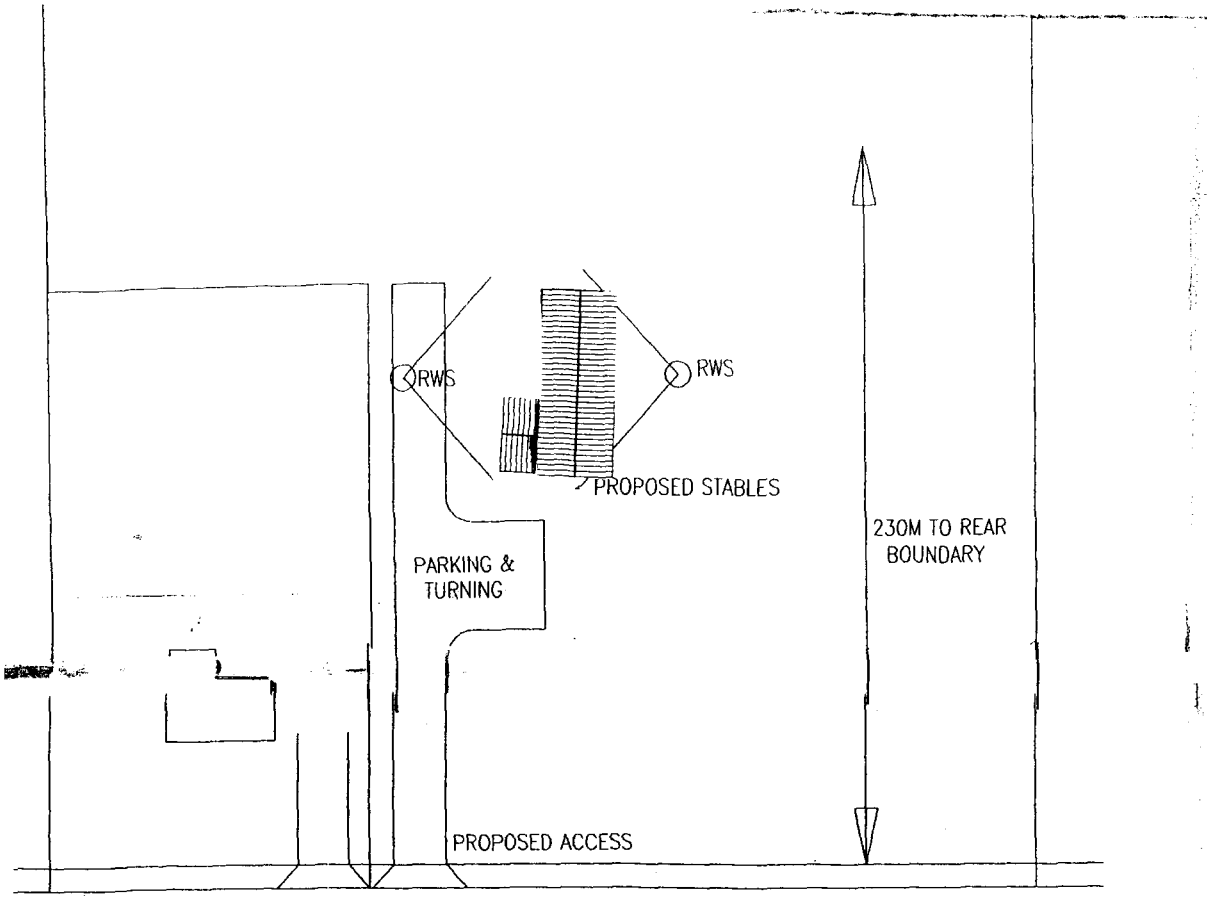

BLOCK PLAN

SOUTH HOLLAND DC
HOUSING & PLANNING
30 OCT 2001
Ref: 1492/00

DRAWING/FILE No 614BJHOLMES-

PROPOSED STABLES

SCALE 1=50 1=100
DATE 20/12/2000
DRAWN M.D.BROKER

Issued	
Revisions	

A2.

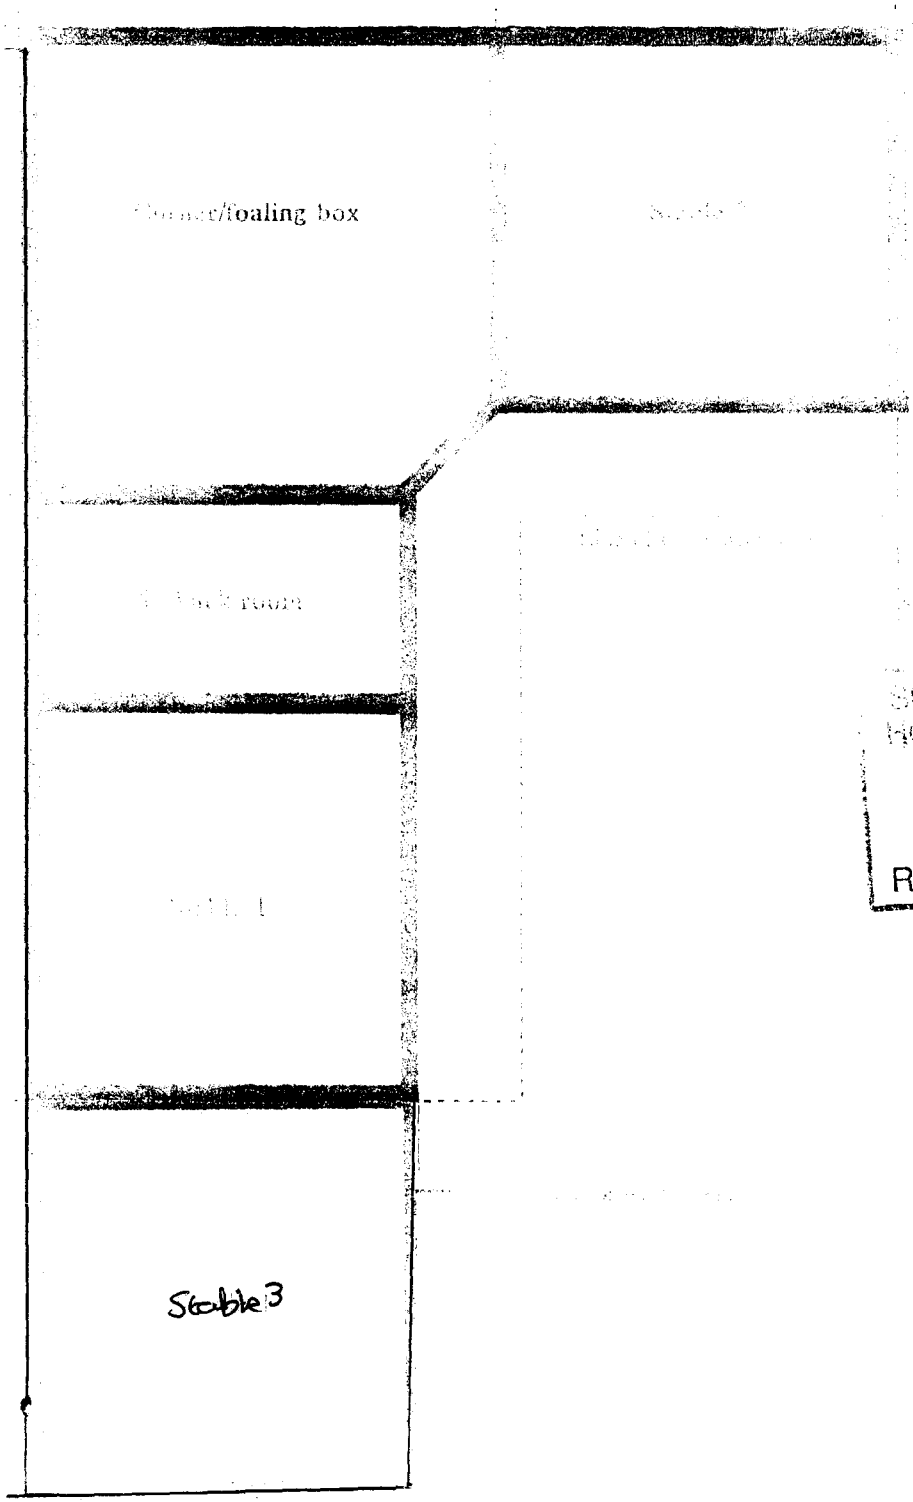

SOUTH HOLLAND DC
HOUSING & PLANNING
30 OCT 2001
Ref: 1492/00

PLANNING AMENDMENT

For office use only

Application No. H05/1492/00/A1

Date Registered 18 OCT 2001

Case Officer DG

1. Please complete in block letters **NAME AND ADDRESS OF APPLICANT** MRS L. LEICESTER, PATRIA LODGE, JEKYLLS GATE, FLEET FEN, HOLBEACH. Tel. No.	**NAME AND ADDRESS OF AGENT** (if form completed by agent) — Tel. No. (Contact)
Please complete in block letters **FULL POSTAL ADDRESS OF THE APPLICATION SITE** AS ABOVE	
Please complete **APPLICATION No.** This amendment **cannot be considered** unless the relevant reference is stated	H05/1492/00.
Building Regulation reference relating to same development (if any)	

2. Please tick **one** box only

A		B
Amendment is proposed where permission already granted If yes, submit two forms and two plans.	✓	or Amendment is to a proposal currently being considered If yes, submit four forms and four plans.

Please complete

I attach the necessary plans and request that the changes described below be accepted as an amendment. I understand that the Council may require a fresh application, together with fee if appropriate. If the amendment relates to a current application, I agree to an extension of the terminal date.

Signed ..... Date .....

3. Please complete in block letters **FULL DESCRIPTION OF DEVELOPMENT IN ORIGINAL APPLICATION**	Use of land as paddocks, plus erection of stables + associated access, parking.
State details of amendments proposed (Give a full detailed list of the changes, and also mark these clearly on the accompanying plans. Only the changes listed here will be considered.)	Amended design + construction.
State drawing no's of the current submission	
Has this amendment been requested by the Council? (If so, state Officer dealing with the application)	~~YES~~ / NO
Describe any part of the original development which is excluded by virtue of the amendment, and state any alteration to plot numbers	

Has a similar amendment been submitted under Building Regulations? Yes / No

SOUTH HOLLAND DISTRICT COUNCIL

Chris Simpkins
Chief Executive
Terry Huggins
Director of Customer Services
Bob Atkins
Director of Corporate Services

FILE COPY

Application no: H05/1492/00

Original Applicant:
Mr and Mrs B J Holmes
The Cottage
Jekils Gate
Holbeach
Spalding, Lincs

Original Agent:
David Broker Design
Danbrooke House
Station Road
Wisbech St Mary
Wisbech Cambs PE13 4RW

Description: Use of land as paddocks, plus erection of stables & associated access/parking

Location: The Cottage
Jekils Gate
Holbeach
Spalding

Amendment: Amended design and construction Plan received 16 Oct.2001

24-OCT-01

Dear Sir/Madam

TOWN AND COUNTRY PLANNING ACT 1990
PROPOSED AMENDMENT

The amended details submitted in respect of the above proposal have been received and I consider that the changes are too significant to be treated merely as a amendment. A fresh application will therefore be required (forms enclosed). This does not imply that premission will or will not be forthcoming for any such revised application.

Yours faithfully

Director of Housing and Planning Services

Mrs L Leicester
Patria Lodge
Jekylls Gate
Fleet Fen
Holbeach, Lincolnshire

Council Offices
Priory Road
Spalding
Lincolnshire
PE11 2XE

Telephone: (01775) 761161
Fax: (01775) 711253
Email: Info@sholland.gov.uk

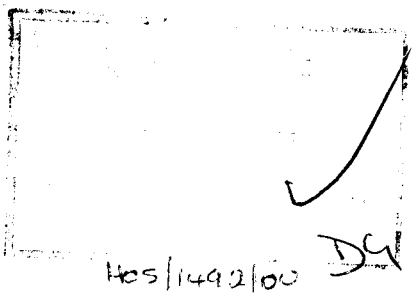

Patria Lodge
Jekylls Gate
Fleet Fen
Holbeach
Lincs
PE12 8QS

15.10.2001

Dear Sirs

RE : Reference H05/1492/00 (property formerly known as The Cottage)

Please could the planning permission for the above reference be amended so that stables can be built in an L shape as detailed on the enclosed copy, please could you also advise if it would be possible to build the stables in block rather than wood.

I would be grateful if you would advise if the above is possible.

Many thanks

Mrs L Leicester

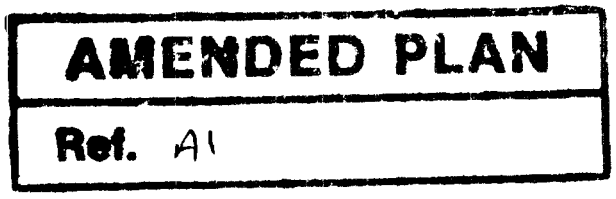

AMENDED PLAN

Rej HCS/1492/00

SOUTH HOLLAND D.C.
HOUSING & PLANNING
16 OCT 2001
Ref: 1492/00

AMENDMENT RECORD SHEET - POST DECISION

Admin

Validation:

Inadequate/Inappropriate ☐

Clarification/Details required:

Appears valid ☑

Registered .....

DC Procedural Assessment

Is the information given correct? (Yes)/~~No~~ (If No, state above what details are needed)

Is it an amendment in principle? ~~Immaterial~~/(Needs new app)

Confirmed: ..... 24/10.

Give a revised description if the details accepted are different to the submission:

~~Acceptance~~ issued: .....