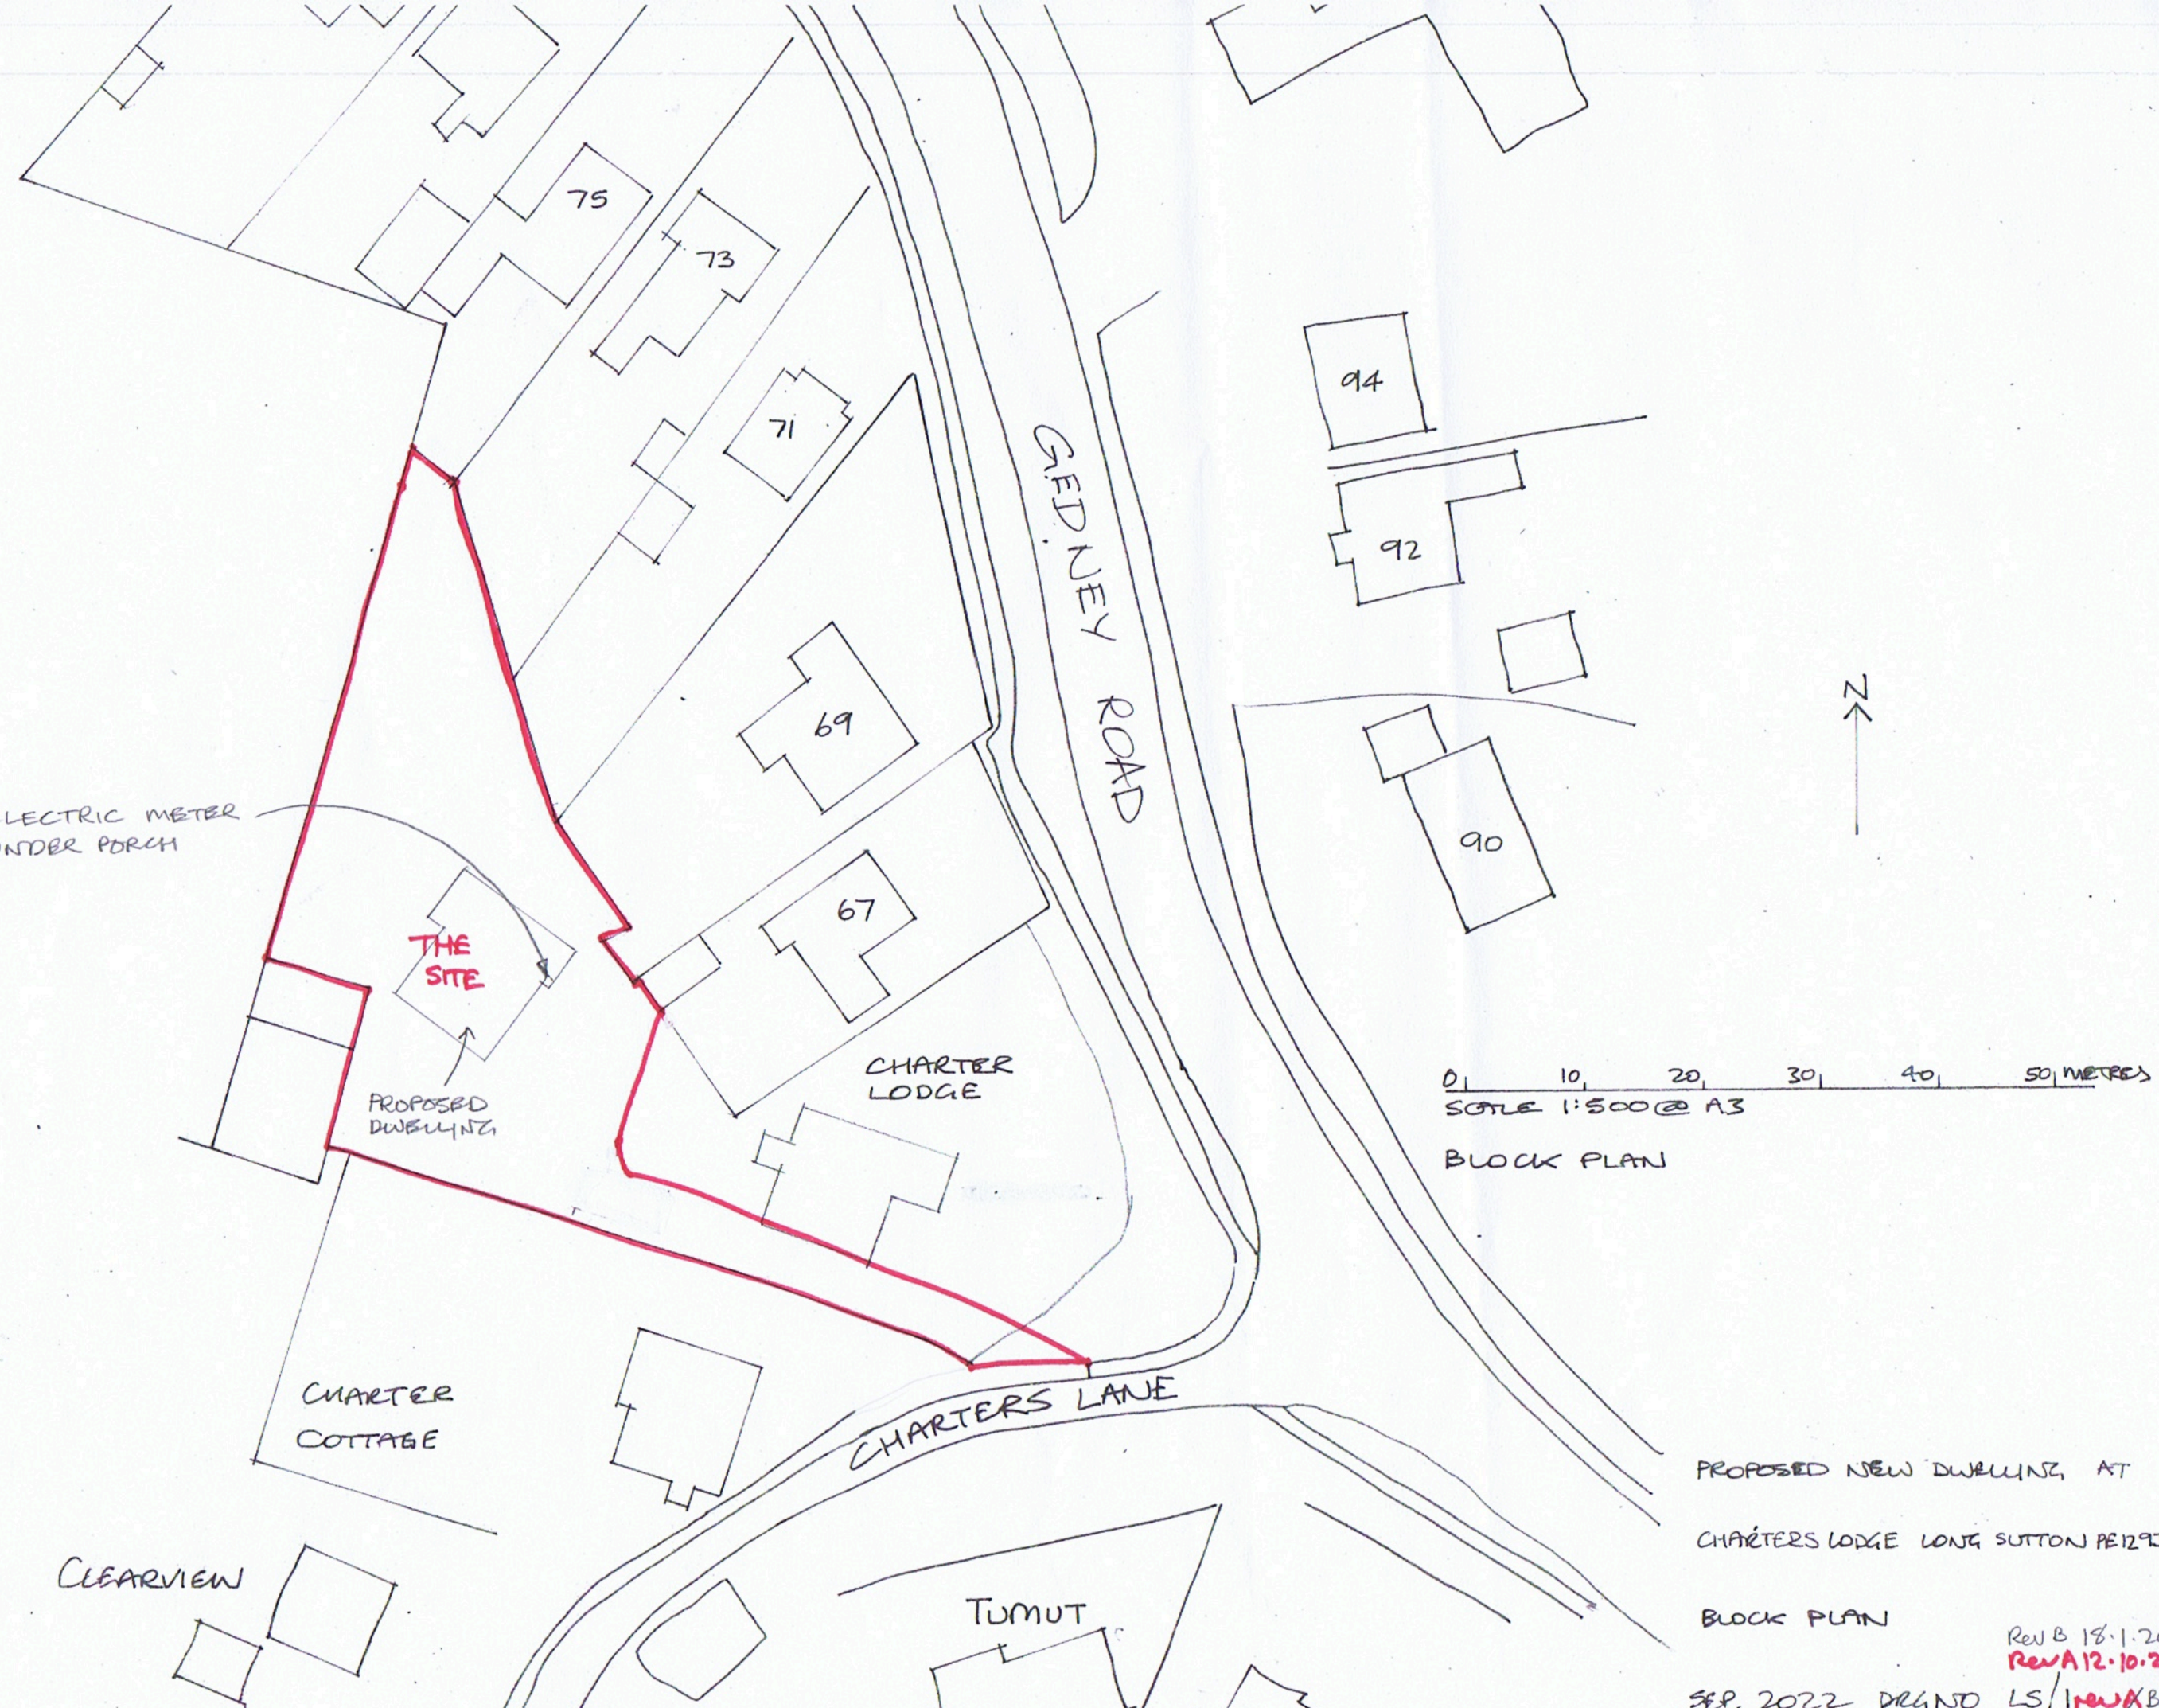


BLOCK PLAN

PROPOSED NEW DWELLING AT

CHARTERS LODGE LONG SUTTON PE12 9JX

BLOCK PLAN

REV B 18.1.2023
REV A 12.10.2022

SEP. 2022 DRG NO LS/1 REV A/B