
UK MAP CENTRE .com

North

15m

Scale 1:500

Map data

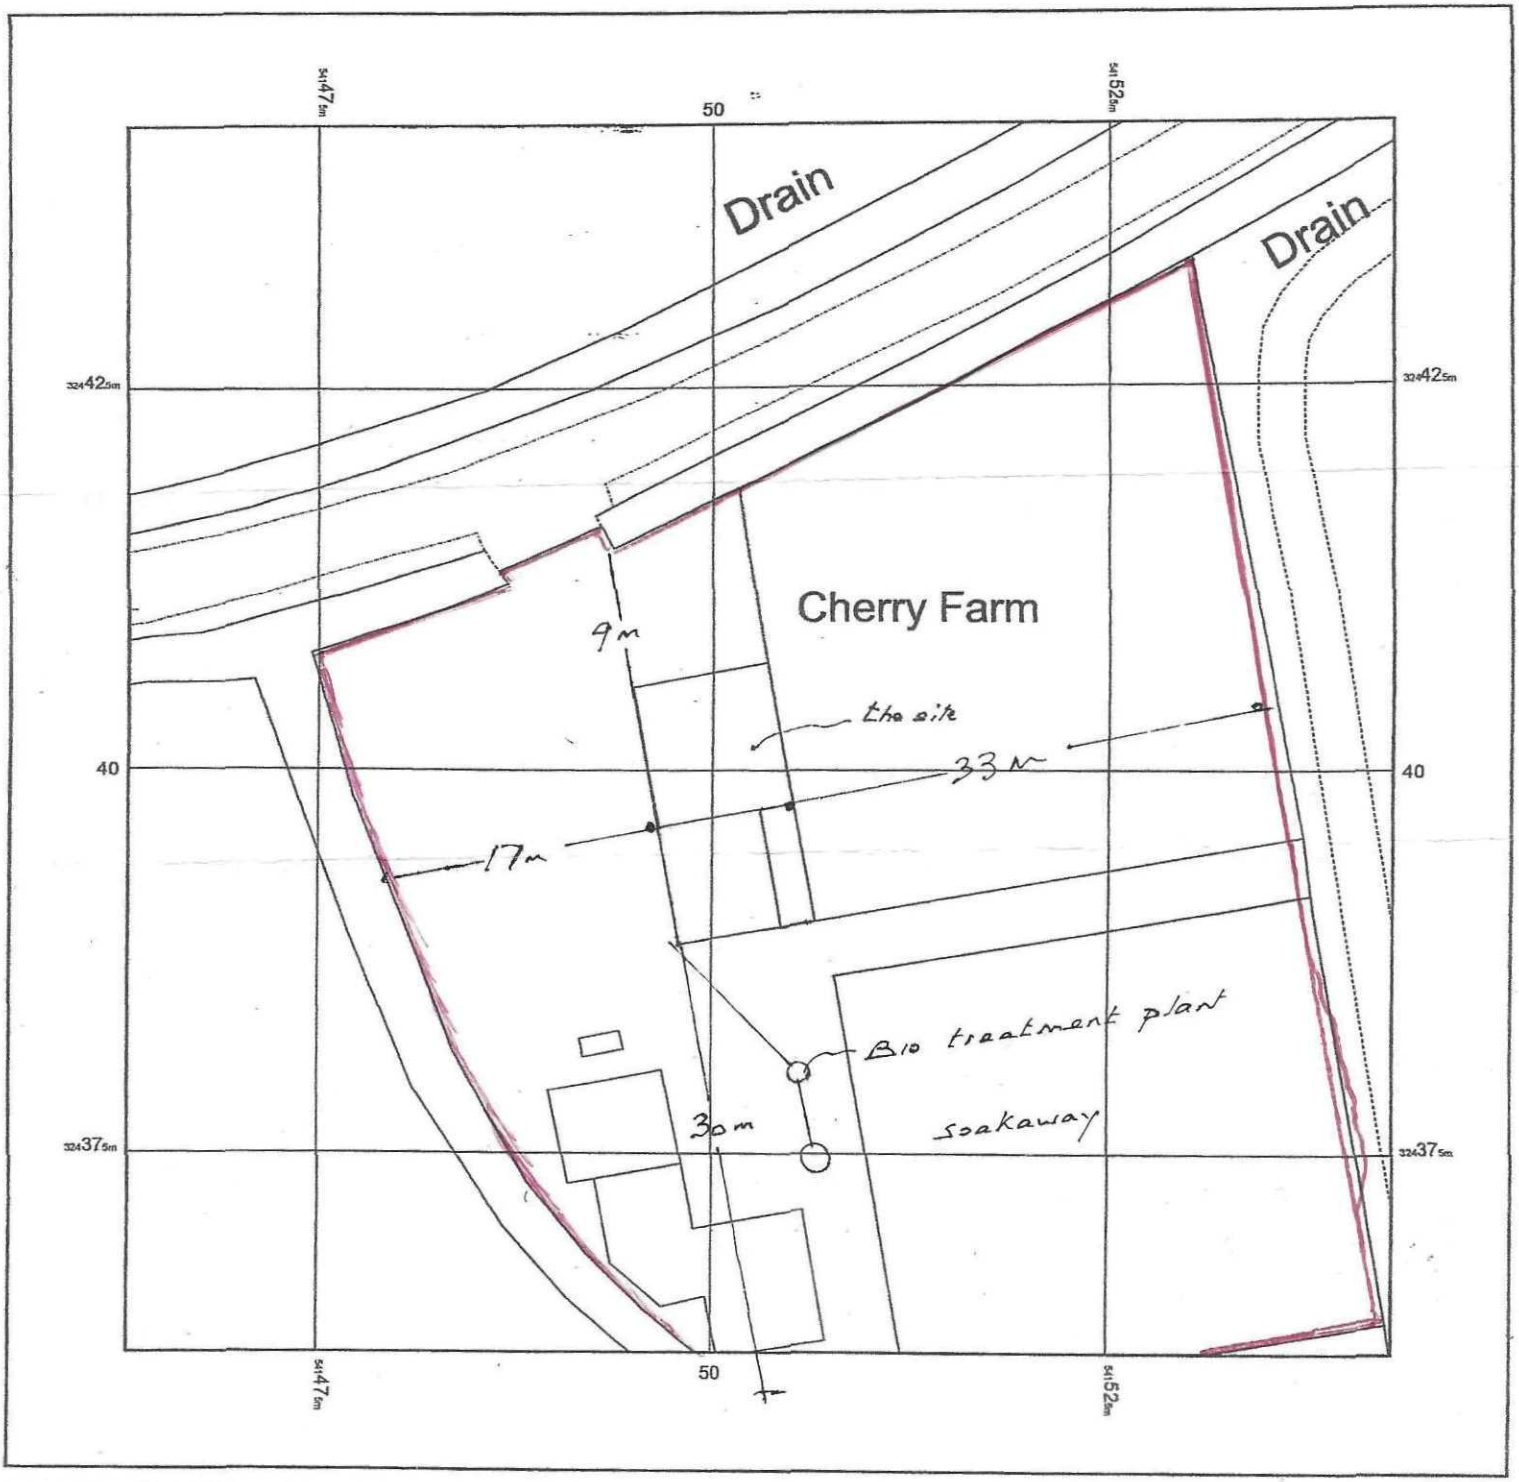

© Crown copyright and database rights 2015 Ordnance Survey 100048957. The representation of road, track or path is no evidence of a boundary or right of way. The representation of features as lines is no evidence of a property boundary.

Supplied by: www.ukmapcentre.com
Serial No:74215
Centre Coordinates:541503,324402
Production Date: 13/07/2015 16:45:02

Cherry Farm, PE12 0AD

Seymour, Sarah

From: Grant, David
Sent: 18 August 2015 15:51
To: _planningadvice
Cc: Seymour, Sarah
Subject: FW: bio disc siting, etc. at Cherry Farm

H06-0698-15

From: Seymour, Sarah **On Behalf Of** _planningadvice
Sent: 18 August 2015 14:22
To: Grant, David
Subject: RE: bio disc siting, etc. at Cherry Farm

Please provide a planning reference number – thanks.

Sarah

From: Grant, David
Sent: 18 August 2015 13:14
To: _planningadvice
Subject: FW: bio disc siting, etc. at Cherry Farm

Hi,

Please attach this information to the file under 1BP.

Thanks,

Dave

David Grant | Planning Officer | **South Holland District Council**
DDI: 01775 764472
www.sholland.gov.uk

From: ronlarby@aol.com [mailto:ronlarby@aol.com]
Sent: 18 August 2015 12:29
To: Grant, David
Subject: bio disc siting, etc. at Cherry Farm

Hope the attached answers question.

Ron