PLANNING AMENDMENT

For office use only
Application No. H08/0663/96
Date Registered 09 SEP 1996
Case Officer PC

1. Please complete in block letters
NAME AND ADDRESS OF APPLICANT
MR & MRS G PAULIN
"CROWLES"
CAESTROVE LANE,
GOSBERTON RISEGATE, SPALDING,
Tel. No. LINCS

NAME AND ADDRESS OF AGENT
(if form completed by agent)
L.A. BUILDING DESIGN
Architectural & Surveying Practice
55 Hannam Boulevard
Spalding, Lincolnshire PE11 1LB
Telephone: (01775) 711437
Tel. No. Principal: Peter S. Billingsley, MCIOB, MBIAT (Contact)

Please complete in block letters
FULL POSTAL ADDRESS OF THE APPLICATION SITE
AS ABOVE

OFFICE COPY

Please complete
APPLICATION No.
This amendment **cannot be considered** unless the relevant reference is stated
H08/0663/96

Building Regulation reference relating to same development (if any)
N/A. - (GARAGE EXEMPT.)

2. Please tick **one** box only
Amendment is proposed where permission already granted — A [ ]
If yes, submit two forms and two plans.
or
Amendment is to a proposal currently being considered — B [✓]
If yes, submit four forms and four plans.

Please complete
I attach the necessary plans and request that the changes described below be accepted as an amendment. I understand that the Council may require a fresh application, together with fee if appropriate. If the amendment relates to a current application, I agree to an extension of the terminal date.
Signed P Billingsley Date 6/8/96

3. Please complete in block letters
FULL DESCRIPTION OF DEVELOPMENT IN ORIGINAL APPLICATION
ERECT SINGLE GARAGE.

State details of amendments proposed
(Give a full detailed list of the changes, and also mark these clearly on the accompanying plans. Only the changes listed here will be considered.)
ACCESS AGREED AS PER DISCUSSIONS WITH LCC HIGHWAYS (MR CHRIS BRIGGS) TO MAINTAIN VEHICLE TURNING WITHIN SITE.

State drawing no's of the current submission
96/22/01B.

Has this amendment been requested by the Council? (If so, state Officer dealing with the application)
YES / ~~NO~~ MR PETER UDY

Describe any part of the original development which is excluded by virtue of the amendment, and state any alteration to plot numbers
NONE

Has a similar amendment been submitted under Building Regulations? [ ] / No NOT REQUIRED.

MRS SALLY WALTHAM BA (Hons) F.C.I.H. Director of Housing & Planning Services

H. ng & Planning Services Department
Council Offices,
Priory Road, Spalding,
Lincolnshire. PE11 2XE

Telephone: (01775) 761161
Fax: (01775) 710772

FILE COPY

SOUTH HOLLAND DISTRICT COUNCIL

HOUSING & PLANNING SERVICES DEPARTMENT

Application no: H08/0663/96

Applicant: Mr & Mrs G Paulin
'Croakers'
Chesboule Lane
Gosberton Risegate
Spalding Lincs

Agent: L A Building Design
55 Hannam Boulevard
Spalding
Lincs

Description: Erect single garage

Location: 'Croakers', Chesboule Lane
Gosberton Risegate
Spalding
Lincs

Amendment: Access altered as per discussions with LCC highways to maintain vehicle turning within site. (Drg No. 96/22/01B)

12-SEP-96

Dear Sir/Madam

ACKNOWLEDGEMENT OF AMENDMENT

I acknowledge receipt of the amended details in respect of the above proposal. These have been incorporated into the application which will now only be considered in its amended form.

The terminal date for dealing with the application has now been extended to 04-NOV-96, based on the date of receipt of the amendment, and your rights of appeal remain as explained on the original acknowledgement.

You are reminded that revision to any submission made under the Building Regulations may also be necessary.

Yours faithfully

Director of Housing and Planning Services

AMENDMENT RECORD SHEET – LIVE APPLICATION

Admin

Validation:

Inadequate/Inappropriate ☐

Clarification/Details required:

Appears valid ☑

Registered .....

Terminal date/committee updated 4/11

DC Procedural Assessment

Is the information given correct? Yes/~~No (If No, state above what details are needed)~~

Has this amendment been requested? Yes/No •
If Yes, is it what was asked for? Yes/No •

Who do you need to reconsult as a result of this amendment? PC None ☑
WM
Press
Residents
Other –

Is it an amendment in principle? Yes/No

Is it the same character/description for fee purposes? ~~Yes/No (Refer to Admin ?)~~ •

If No, but Yes to (*) requested :-

Do development objectives outweigh financial objectives? Yes/No Confirmed.....

REJECTED as an amendment – new application needed

Confirmed: .....

Notes/Advice/Rejection Reason:

☐ Tick if you wish this note to be a paragraph in the Rejection Notice

AUTHORISED to treat as amendment

Confirmed: PJM 11-9-96

Superseded details removed ☑

Give a revised description if the details accepted are different to the submission:

Acceptance issued: ✓
Public register updated: 9/11

DC Professional Assessment

NOTES:

PLANNING AMENDMENT

For office use only

Application No. H08/0663/96/1

Date Registered 1996

Case Officer PM

1. Please complete in block letters

NAME AND ADDRESS OF APPLICANT

MR & MRS. PAULIN
'CROAKERS'
CHESBOULE LANE
GOSBERTON RISEGATE

Tel. No. 01775 750074

NAME AND ADDRESS OF AGENT
(if form completed by agent)

BROADGATE BUILDERS LTD
THE RACE GROUND
SPALDING PE11 3AP

Tel. No. 01775 765616 (Contact) R. ROLFE

Please complete in block letters

FULL POSTAL ADDRESS OF THE APPLICATION SITE

'CROAKERS', CHESBOULE LANE, GOSBERTON RISEGATE

Please complete

APPLICATION No.

This amendment **cannot be considered** unless the relevant reference is stated

H08/0663/96

Building Regulation reference relating to same development (if any)

B08/0407/96

2. Please tick **one** box only

A — Amendment is proposed where permission already granted
If yes, submit two forms and two plans.
[✓]

or

B — Amendment is to a proposal currently being considered
If yes, submit four forms and four plans.
[ ]

Please complete

I attach the necessary plans and request that the changes described below be accepted as an amendment. I understand that the Council may require a fresh application, together with fee if appropriate. If the amendment relates to a current application, I agree to an extension of the terminal date.

Signed ..... Date 3.10.96

3. Please complete in block letters

FULL DESCRIPTION OF DEVELOPMENT IN ORIGINAL APPLICATION

ERECT SINGLE GARAGE

State details of amendments proposed

(Give a full detailed list of the changes, and also mark these clearly on the accompanying plans. Only the changes listed here will be considered.)

ACCESS DRIVE AMENDMENT as attached and as discussed MR. CHRIS BRIGGS HIGHWAYS/PLANNING LINCOLN.

State drawing no's of the current submission

96/22 013.

Has this amendment been requested by the Council? (If so, state Officer dealing with the application)


YES / NO — PETER UDY

Describe any part of the original development which is excluded by virtue of the amendment, and state any alteration to plot numbers

Has a similar amendment been submitted under Building Regulations? Yes / No

1. Builder to check all dimensions on site before work commences.
2. This drawing is the copyright of L A Building Design and shall not be copied or reproduced without written permission.

Drawing to be read in conjunction with separate "Specification Notes"

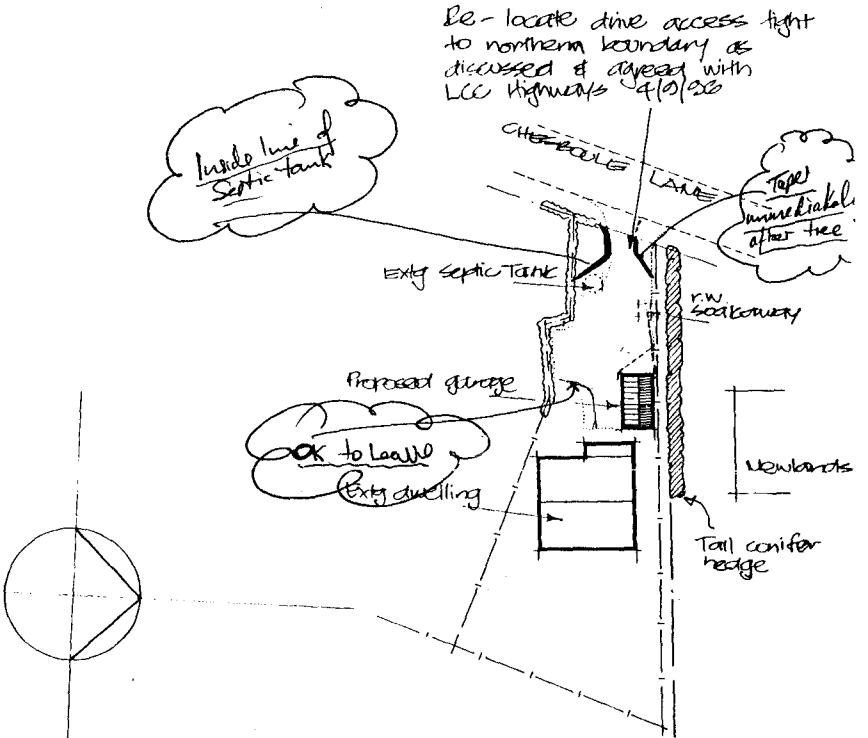

BLOCK PLAN
1 500

AMENDMENT RECORD SHEET – POST DECISION

Admin

Validation:

Inadequate/Inappropriate ☐

Clarification/Details required:

Appears valid ☐

Registered 9/10

DC Procedural Assessment

Is the information given correct? Yes/~~No (If No, state above what details are needed~~)

Is it an amendment in principle? Immaterial/~~Needs new app~~

Confirmed: 9-10

Give a revised description if the details accepted are different to the submission:

Acceptance issued:

File: .....

HIGHWAYS DEVELOPMENT CONTROL
RECORD OF GENERAL ADVICE

~~Telephone Call / Meeting~~ / Planning Application (Ref. No. H08/0663/96/1

Date:- 9 - 10 - 96

~~Enquirer~~ / District Council:- S-HDC

~~Pre-Application~~ / Current Application / ~~Development Road / General~~


Advice Given / ~~Information Requested / Notes of Meeting~~:- on Amended Application

I confirm the amendment now submitted will be acceptable as agreed on site.

Signed:- C Briggs

Date:- 9-10-96

Confirmed in writing: ~~Y / N~~ or passed to District Council

Form: H / A / GA 1

MRS SALLY WALTHAM BA (Hons) FC.I.H. Director of Housing & Planning Services

Housing & Planning Services Department
Council Offices,
Priory Road, Spalding,
Lincolnshire. PE11 2XE

Telephone: (01775) 761161
Fax: (01775) 710772

COPY

SOUTH HOLLAND DISTRICT COUNCIL
HOUSING & PLANNING SERVICES DEPARTMENT

Application no: H08/0663/96

Applicant: Mr & Mrs G Paulin
'Croakers'
Chesboule Lane
Gosberton Risegate
Spalding Lincs

Agent: L A Building Design
55 Hannam Boulevard
Spalding
Lincs

Description: Erect single garage

Location: 'Croakers', Chesboule Lane
Gosberton Risegate
Spalding
Lincs

Amendment: Access drive amendment (Drawing No. 96/22 01B)

11-OCT-96

Dear Sir/Madam

TOWN AND COUNTRY PLANNING ACT 1990
NOTICE OF ACCEPTANCE OF AMENDMENT

The amended details submitted in respect of the above proposal have now been considered, and I am able to inform you that there are no objections to the amendment being implemented to the extent described above.

Note: This Notice does not convey any approval under the Building Regulations and you may need to make a new submission.

Yours faithfully

Director of Housing and Planning Services

Broadgate Builders Ltd
The Race Ground
Spalding
Lincs
PE11 3AP