
Deleted will be agreed
& David Broker.
DMG 11/11.


~~FACING BRICKS IBSTOCK GOLDEN PURPLE WITH PURPLE QUOINS~~
~~ROOF TILES SANDTOFT HARVEST GOLD~~
CREAM UPVC WINDOWS

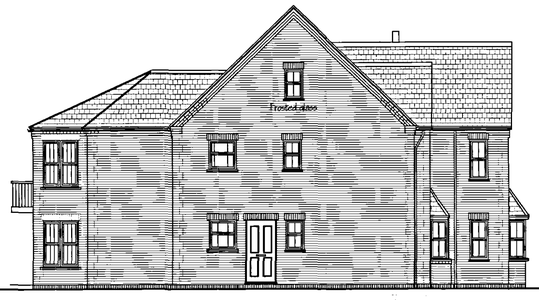

FRONT ELEVATION



SIDE ELEVATION

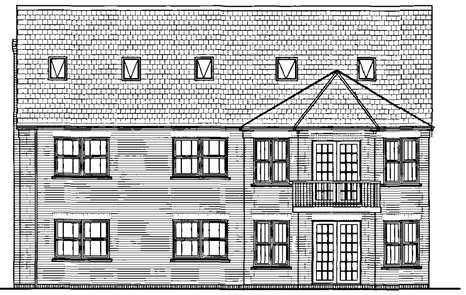

REAR ELEVATION


SHDC
Planning & Development
19 SEP 2005
Ref. 0534/05

David Broker Design Services
Concept 2000 Design & Development Ltd


AMENDED PLAN
Ref. A2




SIDE ELEVATION

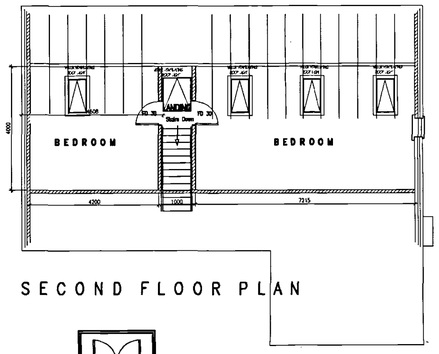


SECOND FLOOR PLAN

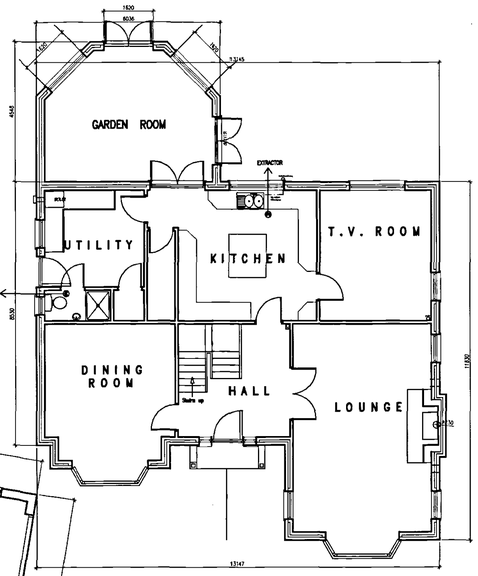


GROUND FLOOR PLAN

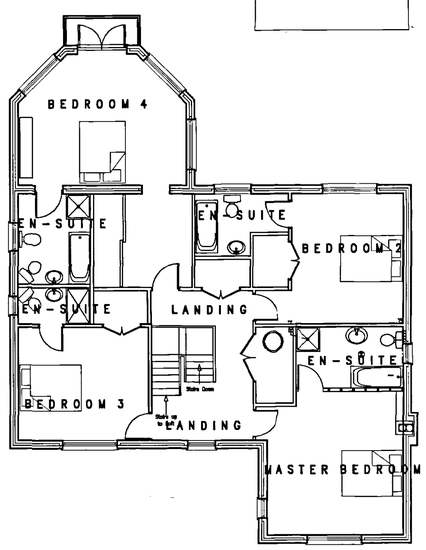


FIRST FLOOR PLAN

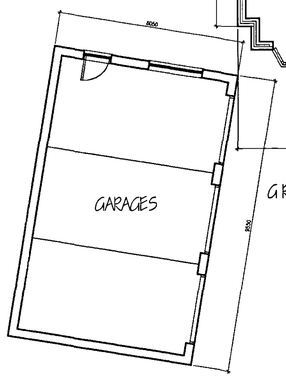

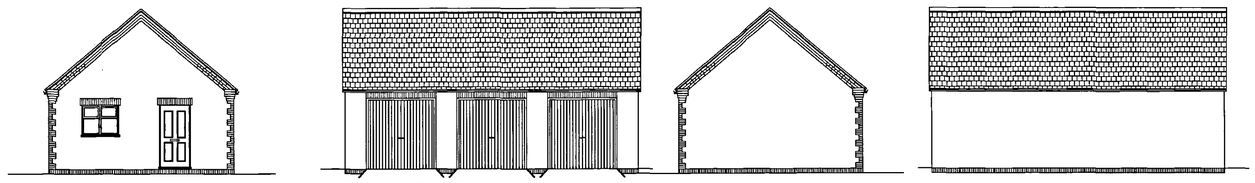

GARAGE ELEVATION

EXISTING PICKET FENCE
in neighbours ownership

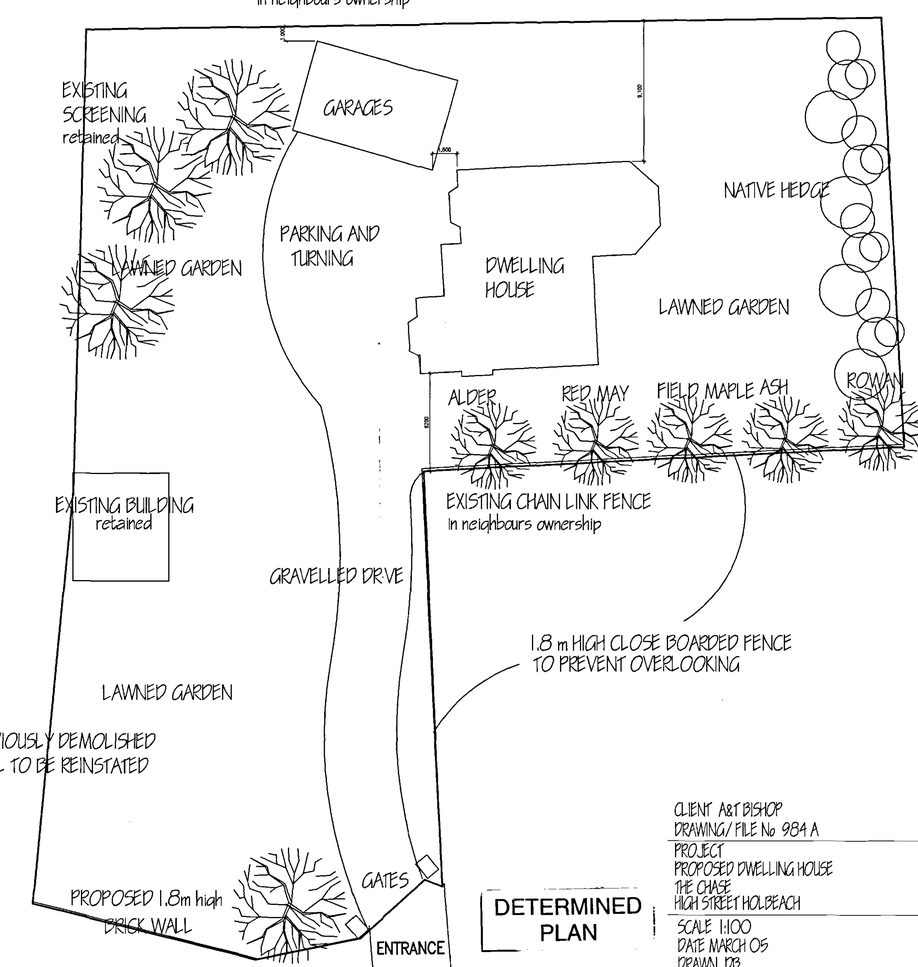

BLOCK PLAN 1:200

DETERMINED PLAN

CLIENT A&T BISHOP
DRAWING/ FILE No 984 A
PROJECT
PROPOSED DWELLING HOUSE
THE CHASE
HIGH STREET HOLBEACH
SCALE 1:100
DATE MARCH 05
DRAWN DB

Issued	
Revisions	A Planning

ARCHITECTURAL TECHNICIANS
DANBROOKE HOUSE STATION ROAD
WISBECH ST MARY
WISBECH CAMBS. PE13 4RW
Telephone 01945410421
Facsimile 01945410400

DO NOT SCALE ALL DIMENSIONS TO BE VERIFIED ON SITE THIS DRAWING AND DESIGN REMAINS THE COPYRIGHT OF DAVID BROKER AND MAY NOT BE REPRODUCED WITHOUT PERMISSION.

\984A\BISHOP NEW HOUS.dwg, Plotted 2005-09-16 18:28:11