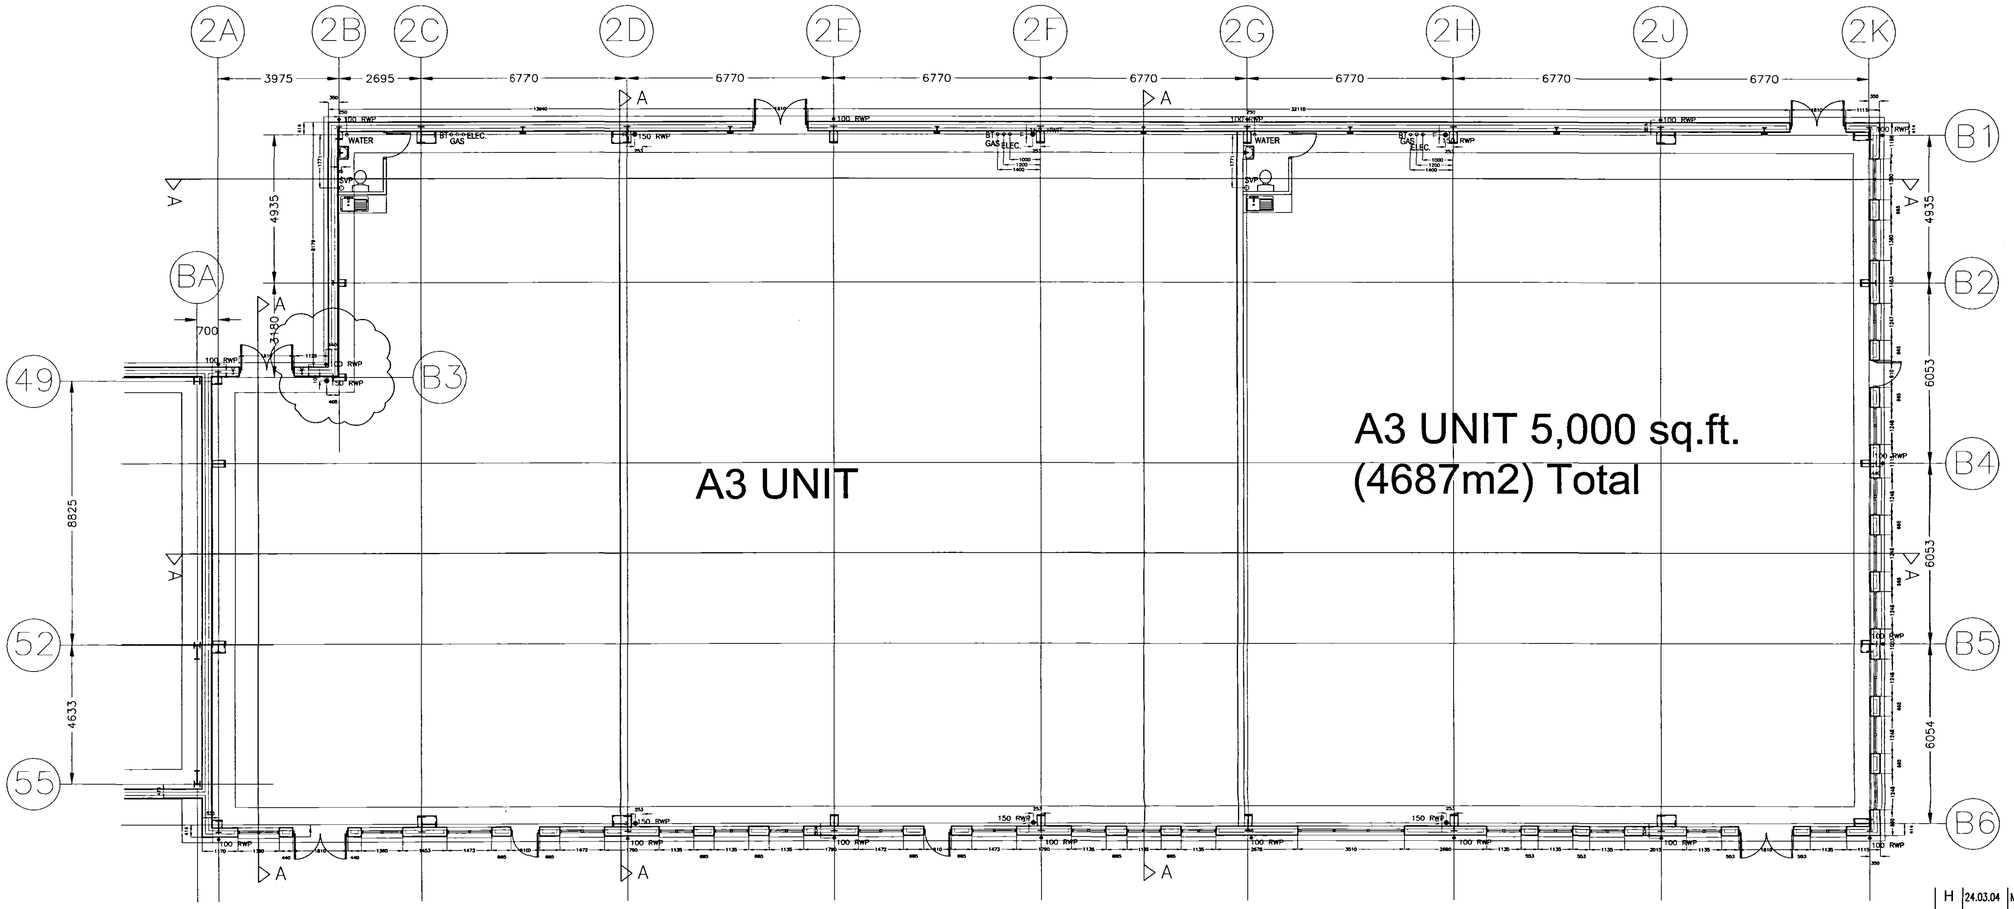


A3 Unit plan 1:100

REV.	DATE	DESCRIPTION		
H	24.03.04	Made AS BUILT drawing	Revised By:	smg
			Checked By:	
G	08.10.03	Additional RWP added at grid 2B/B3.	Revised By:	smg
			Checked By:	sb
F	26.09.03	RWP locations added.	Revised By:	smg
			Checked By:	sb
E	19.08.03	Elevations & Section omitted. Plan updated in line with current steelwork	Revised By:	S.Shepherd
			Checked By:	smg
D	28.07.03	Plans, Section & Elevations amended to include steel grid setting out. Brick dims added.	Revised By:	SMG
			Checked By:	S.Bush
C	July'03	Rationalise grids, adjust O/A dims	Revised By:	S.Bush
			Checked By:	S.Bush

Received: | Action:

Comments:

Interserve Building

AS BUILT

Springfields Outlet Shopping & Festival Gardens
Holbeach Road / Camel Gate
Spalding, Lincolnshire

SHDC
Planning & Development
16 APR 2004
Ref: 1067/03

AMENDED PLAN
Ref.

PROPOSED GENERAL ARRANGEMENT
RESTAURANT (A3) LAYOUT

Date:	Scale:	Drawn	Drawing No.
09.05.03	Varies	S.Geering	3729-1-Rest 2001H
		Checked S.Bush	

WATSON BATTY ARCHITECTS LTD
1-3 TOWN GATE, GUISELEY, LEEDS LS20 9JB
Telephone 01943 876665
Facsimile 01943 882300
Email enquiries@watsonbatty.com
Web www.watsonbatty.com

ISO 9001:2000

WATSON BATTY ARCHITECTS LTD

Copyright © Watson Batty Architects Ltd

CAD REF: G:\Interserve\Spalding\Restaurant-2000\3397-GA-10C