


Front Elevation (West)



Rear Elevation (East)

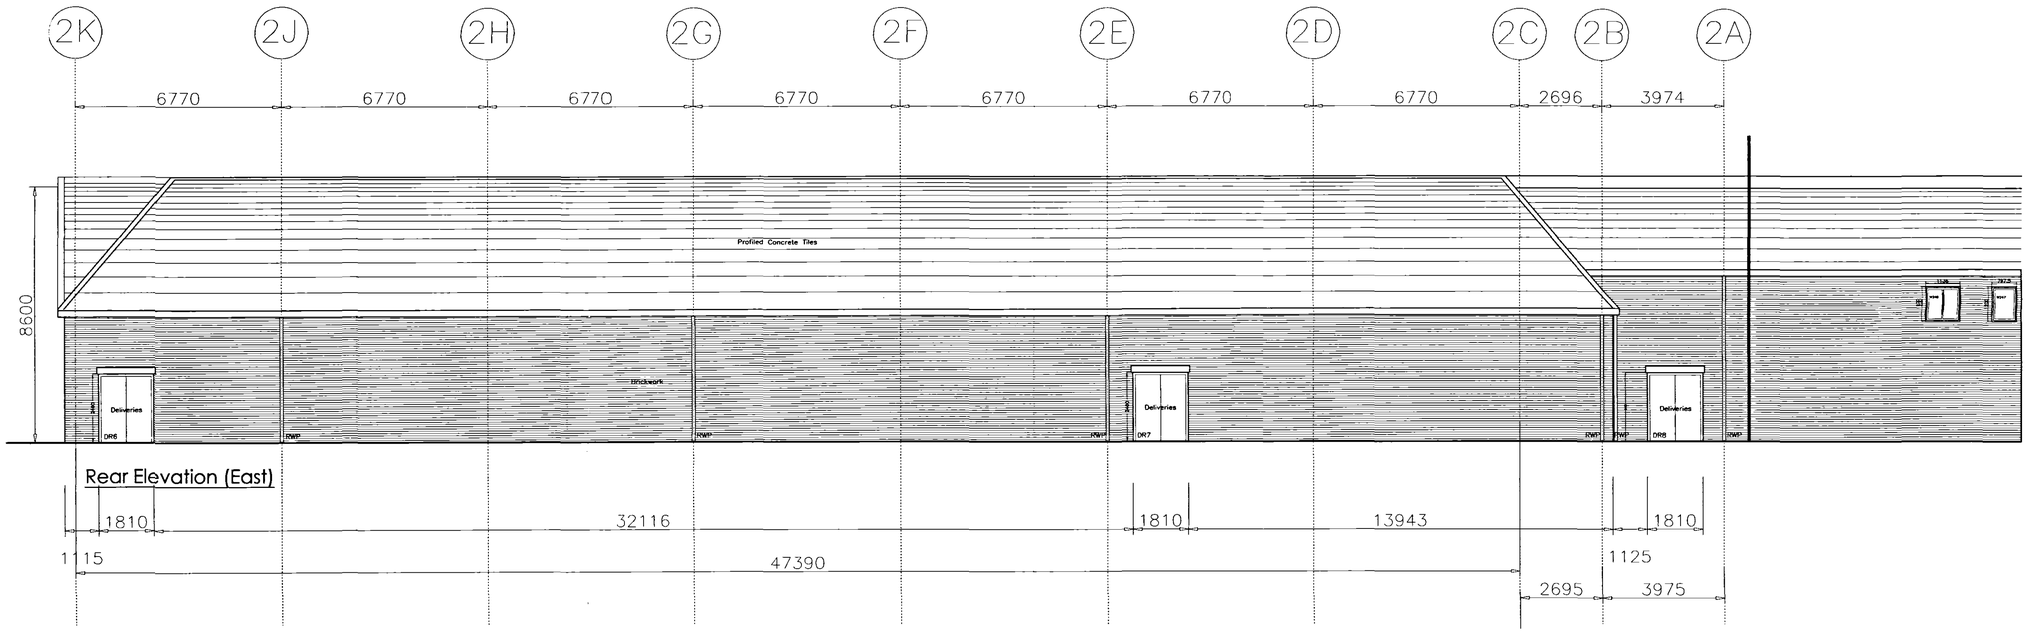

Side Elevation (South)

AS BUILT

SMPC Planning & Development 16 APR 2004 Ref: 106703

AMENDED PLAN Ref.

REV.	DATE	DESCRIPTION	
D	24.03.04	Made AS BUILT drawing	Revised By: smg; Checked By:
C	08.10.03	Adjoining building B added to East elevation.	Revised By: smg; Checked By: sb
B	08.10.03		Revised By: smg; Checked By: sb
A	25.09.03	Chamfered corner omitted. RWP's added. Window & door refs. added.	Revised By: smg; Checked By:

Received: Action:

Comments:

Interserve Building

Springfields Outlet Shopping & Festival Gardens
Holbeach Road / Camel Gate
Spalding, Lincolnshire

PROPOSED GENERAL ARRANGEMENT
RESTAURANT (A3) ELEVATIONS

Date: 19.08.03 Scale: 1:100 Drawn: smg Checked: sb Drawing No. 3729-1-Rest 2002 D

WATSON BATTY ARCHITECTS LTD 1-3 TOWN GATE, GUISELEY, LEEDS LS20 9JB
Telephone 01943 876665 Email enquiries@watsonbatty.com
Facsimile 01943 882300 Web www.watsonbatty.com

ISO 9001:2000 · constructionline · WATSON BATTY ARCHITECTS LTD

Copyright © Watson Batty Architects Ltd

CAD REF: G:\interserve\Spalding\Restaurant-2000\3397-GA-10C