
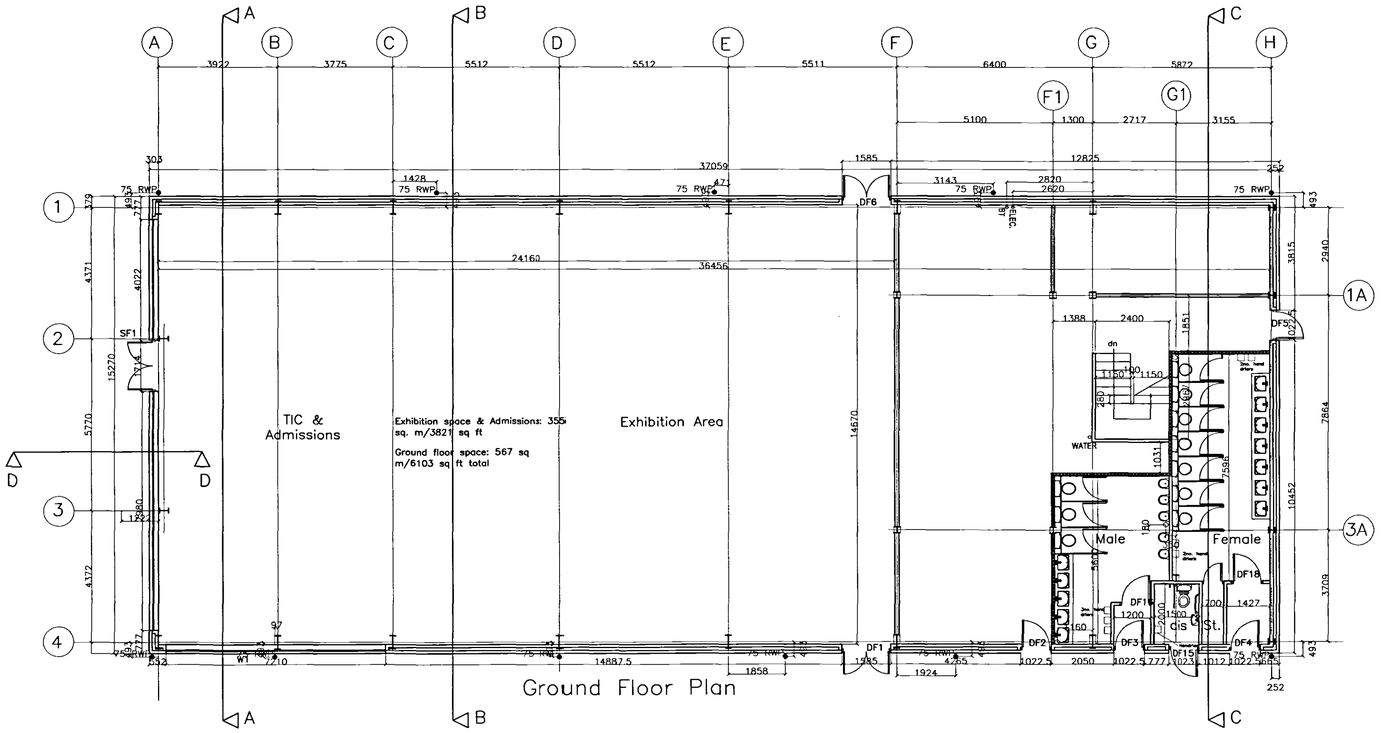


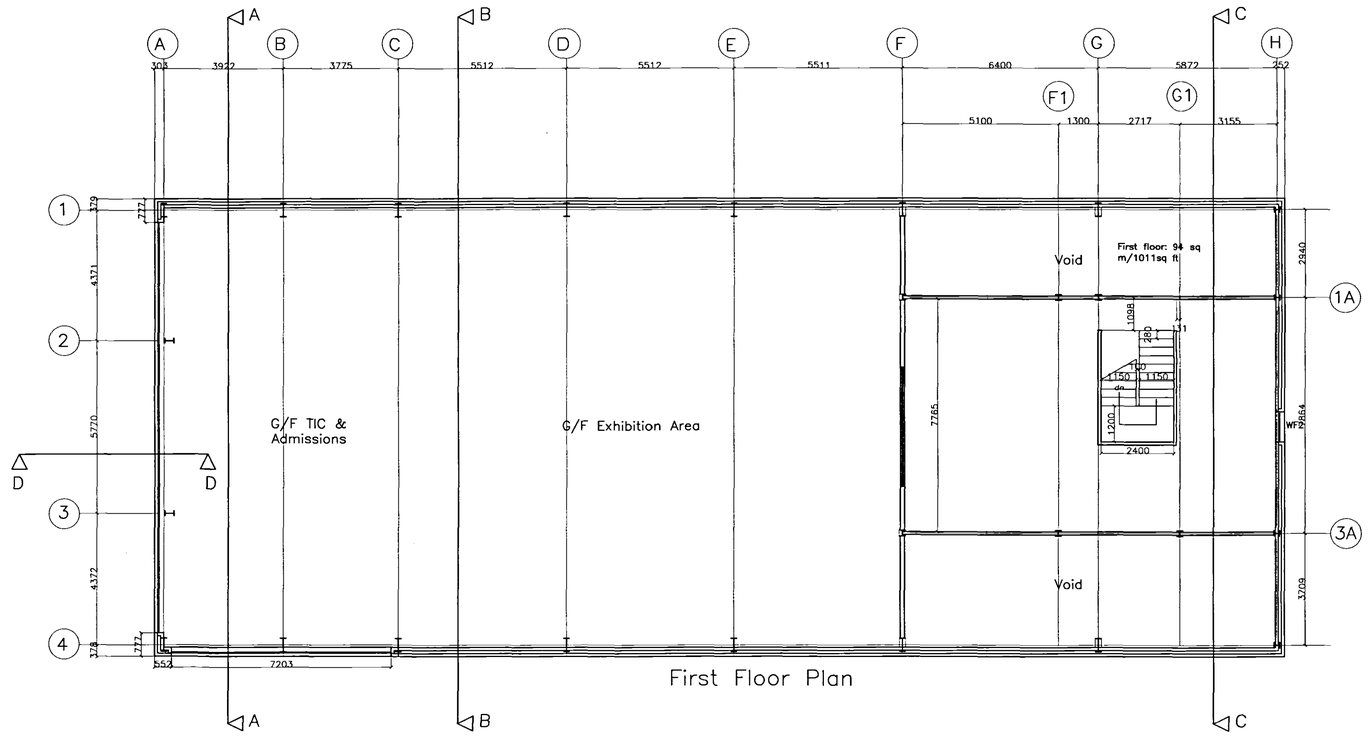

REV.	DATE	DESCRIPTION	
X	24.03.04	Made AS BUILT drawing	Revised By: sng / Checked By:
W	18.02.04	Entrance lobby & store amended to suit on site conditions	Revised By: sng / Checked By: sb
V	16.02.04	Door DF5 rehung	Revised By: sng / Checked By: sb
U	06.02.04	Handdriers added to Male, Female and Disabled toilets (8 No.)	Revised By: sng / Checked By: sb
T	30.01.04	Female wc's and IPS moved 110mm to accommodate SVP.	Revised By: sng / Checked By: sb
S	13.01.04	vanity Units to Public Toilets introduced.	Revised By: sng / Checked By: sb
R	19.12.03	Walls to staircase reintroduced.	Revised By: sng / Checked By: sb
Q	18.12.03	Walls to staircase omitted. Conference Room walls & door added at Ground Floor.	Revised By: sng / Checked By: sb
P	16.12.03	All internal walls to offices,etc. & doors, toilets omitted to Ground & First Floor.	Revised By: sng / Checked By: sb
N	08.12.03	Updated First Floor curtain walling. Fused spurs for hand-driers to toilets added.	Revised By: sng / Checked By: sb
M	3.12.03	Vanity units omitted	Revised By: SL / Checked By: sng
L	27.11.03	Door references altered to suit position in scheme	Revised By: SL / Checked By: S.G
K	26.11.03	Toilets updated to include IPS and vanity units. Dims altered to main entrance door.	Revised By: SL / Checked By: S.G
J	13.11.03	Dividing Wall Altered to 140 Dis Wc Dims Altered	Revised By: SL / Checked By: S.G
I	11.11.03	Doors amended to ground and first floors	Revised By: SB / Checked By: SB
H	22.09.03	Staircase to Mezzanine level amended. RWP's added	Revised By: sng / Checked By: SB
G	17.9.03	Dims altered to front elevation	Revised By: S.Lonie / Checked By: sng
F	11.9.03	Main entrance door moved to new location	Revised By: S.Lonie / Checked By: S.Geering
E	20/8/03	Updated steelwork details	Revised By: S.Lonie / Checked By: S.Bush
D	27/6/03	RENAMED FENS DISCOVERY CENTRE OMIT GLASS ROOF REVISED CONSTRUCTION	Revised By: S.LONIE / Checked By: S.Bush

AMENDED PLAN Ref.

SHDC Planning & Development 16 APR 2004 Ref: 1067/03

AS BUILT

Springfields Outlet Shopping & Festival Gardens
Holbeach Road / Camel Gate
Spalding, Lincolnshire

Proposed Fens Discovery Centre
(Formally Glasshouse)
Scheme Drawing (to be read with 3002)

Date: 27 June 03 | Scale: 1:100 | Drawn: S.Lonie | Checked: S.Bush | Drawing No. 3729-1-3001 X

WATSON & BATTY ARCHITECTS LTD 1-3 TOWN GATE, GUISELEY, LEEDS LS20 9JB
Telephone: 01943 876665 Email: enquiries@watsonbatty.com
Facsimile: 01943 882300 Internet: www.watsonbatty.com

ISO 9001 | WATSON & BATTY ARCHITECTS LIMITED

Copyright © Watson & Batty Architects Ltd

CAD REF: G:\Interserve\Spalding\Glasshouse-3000\3729-1-3001E