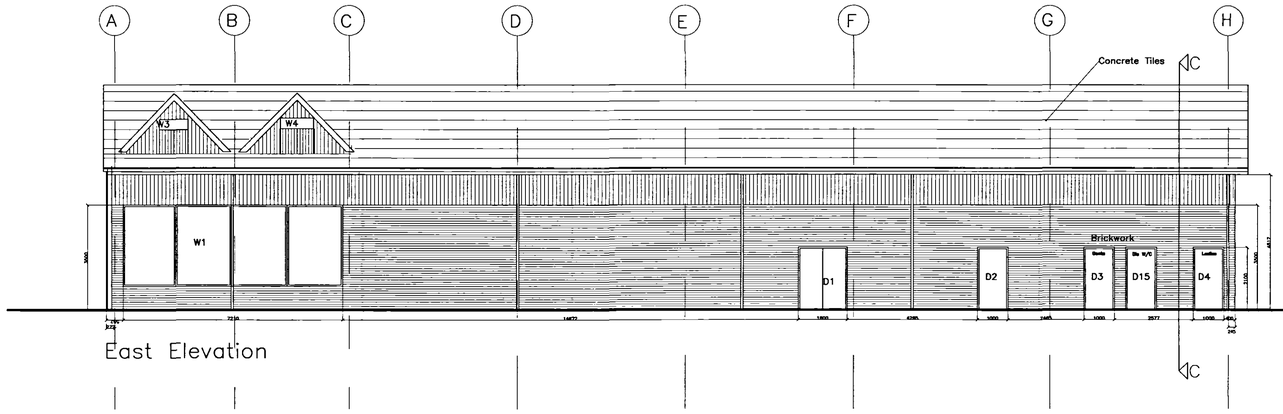
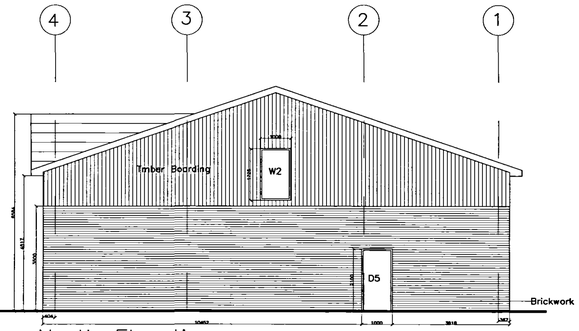
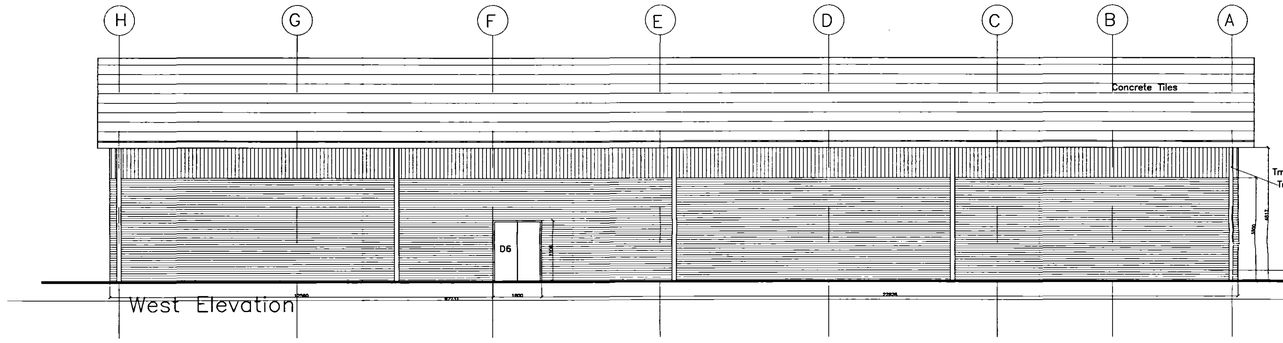


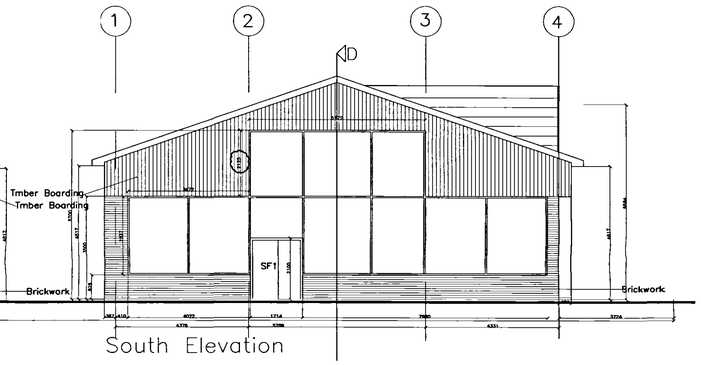

East Elevation




North Elevation




West Elevation




South Elevation

AMENDED PLAN
Ref.

SHDC
Planning & Development
1 6 APR 2004
Ref: 1067/03

| REV. | DATE | DESCRIPTION | | |
|---|---|---|---|---|
| D | 24.03.04 | Made AS BUILT drawing | Revised By: | smg |
| | | | Checked By: | |
| C | 14.01.04 | Window SF1 amended. Top pane altered from 2198mm to 2125mm | Revised By: | smg |
| | | | Checked By: | sb |
| B | 11.11.03 | Door to disabled WC moved to elevation | Revised By: | SB |
| | | | Checked By: | smg |
| A | 30.10.03 | Dormer/ Gable feature amended | Revised By: | mdp |
| | | | Checked By: | smg |

Springfields Outlet Shopping & Festival Gardens
Holbeach Road / Camel Gate
Spalding, Lincolnshire

AS BUILT

Proposed Fens Discovery Centre
(Formally Glasshouse)
Elevations

Date: 27 June 03 | Scale: 1:100 | Drawn: S.Lonie | Checked: | Drawing No. 3729-1-3002 D

WATSON & BATTY ARCHITECTS LTD 1-3 TOWN GATE, GUISELEY, LEEDS LS20 9JB
Telephone: 01943 876665 Email: enquiries@watsonbatty.com
Facsimile: 01943 882300 Internet: www.watsonbatty.com

ISO 9001 | constructionline | WATSON & BATTY ARCHITECTS LIMITED

Copyright © Watson & Batty Architects Ltd

CAD REF: G:\Interserve\Spalding\Glasshouse-3000\3729-1-3002