

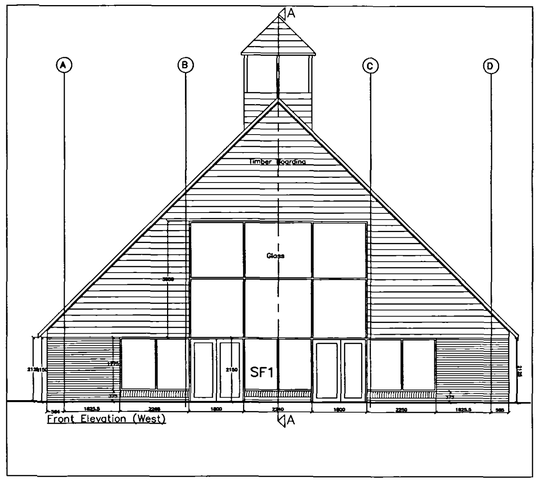


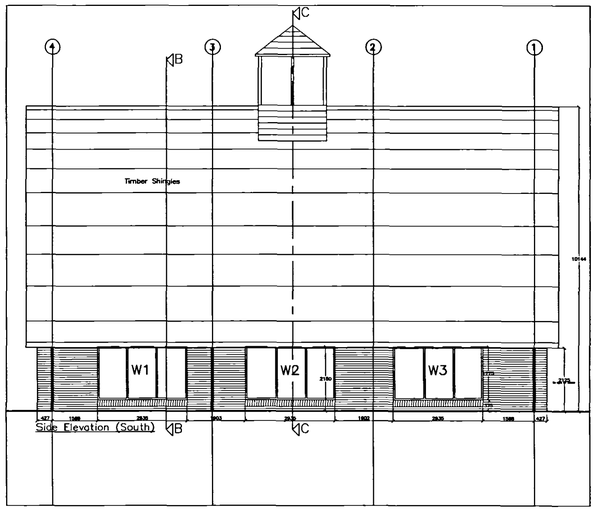

Bell Tower installed
to manufacturers (Good Directions OEA)
specification and recommendations.
See drawing 3729-1- 4006 for details of
proposed cupola

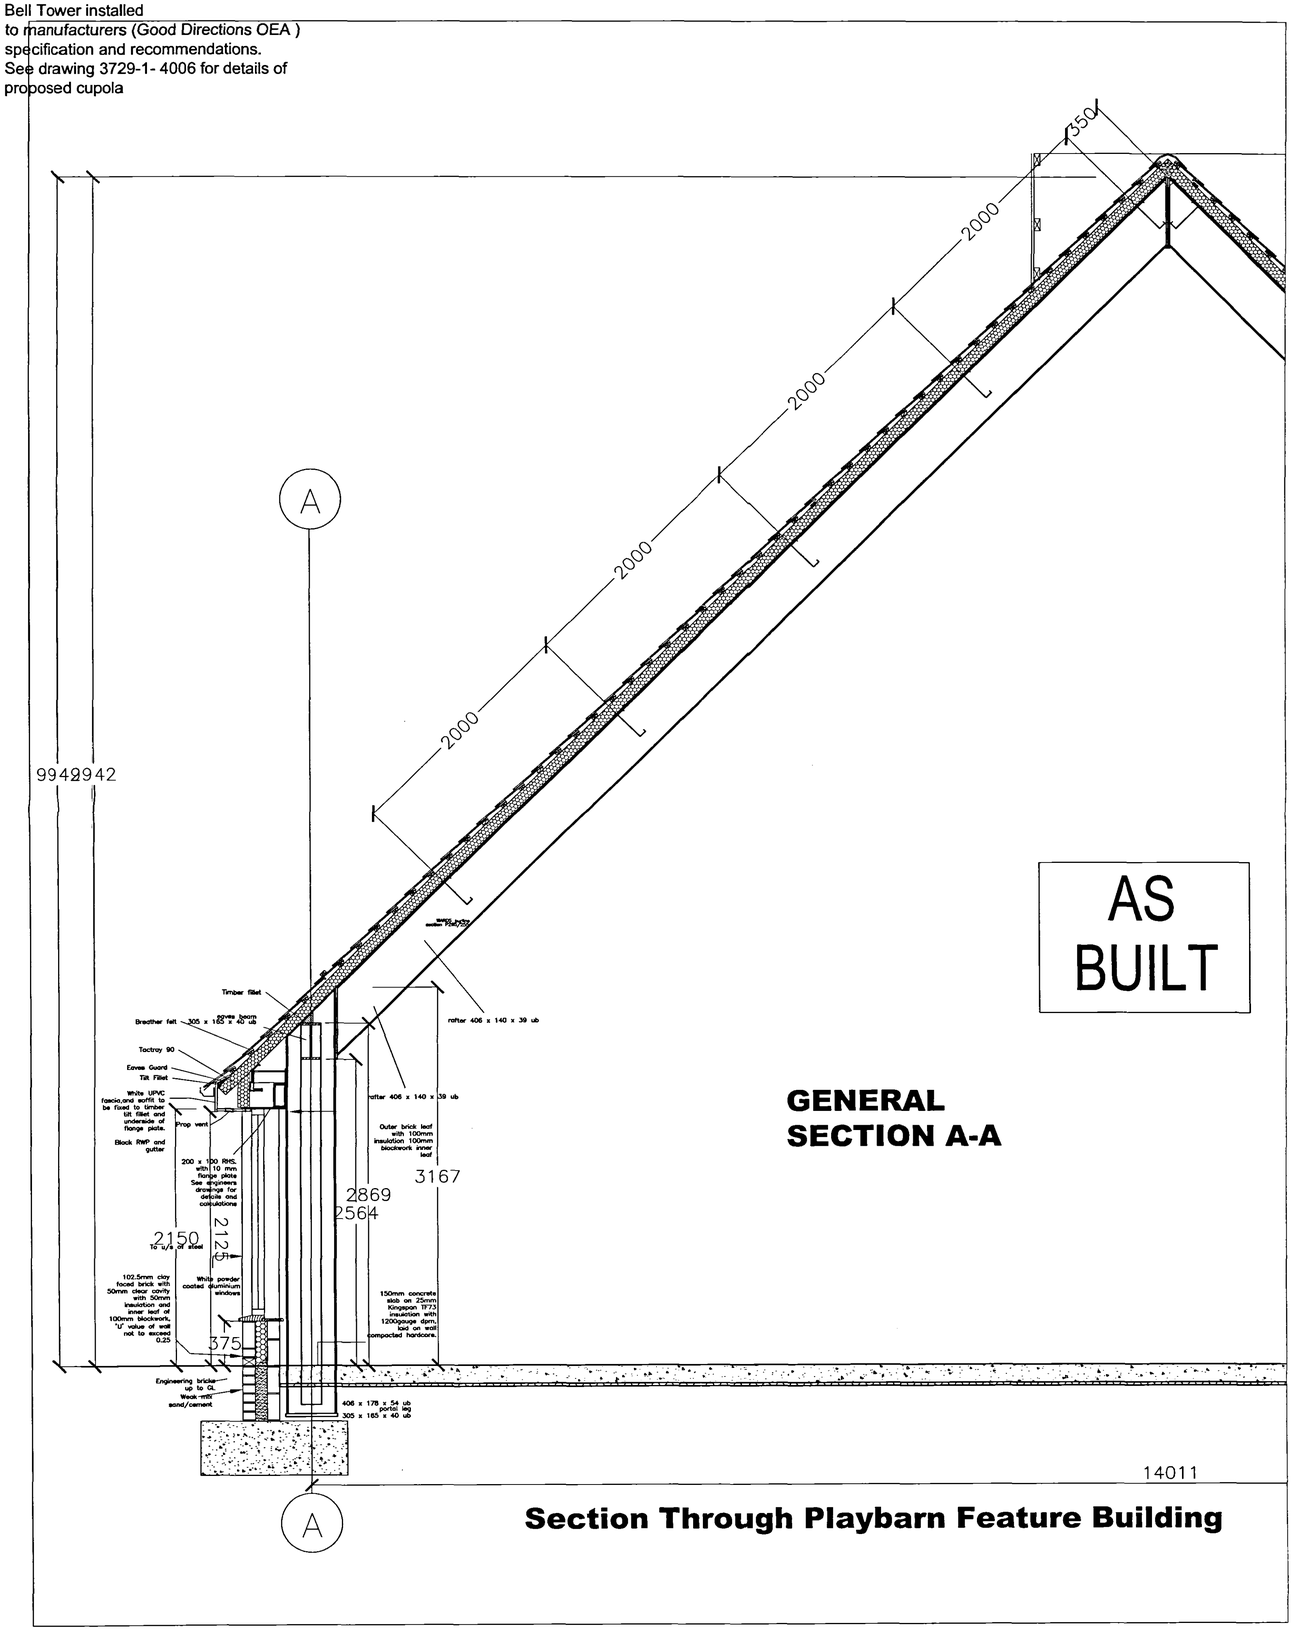

AS BUILT

GENERAL SECTION A-A

14011

Section Through Playbarn Feature Building

SHDC
Planning & Development
16 APR 2004
Ref: 1067/03

AMENDED PLAN
Ref.

REV.	DATE	DESCRIPTION	
E	24.03.04	Made AS BUILT drawing	Revised By: smg
D	22.10.03	Updated steelwork details. eaves tie beam and purlins shown to engineers details	Revised By: MDP Checked By: smg
C	20/803	Updated steelwork details	Revised By: S.Lonie Checked By: smg
B	03.07.03	Revised front and rear gable, omit side gable, partial brickwork to side and front elevations	Revised By: S.Shepherd Checked By: S.Bush

Received: Action:

Comments:

Interserve Building

Springfields Outlet Shopping & Festival Gardens
Holbeach Road / Camel Gate
Spalding, Lincolnshire

PLAYBARN FEATURE BUILDING
SCHEME DRAWING

Date:	Scale:	Drawn	Drawing No.
JUNE 2003	1:100	S.LONIE	3729-1-4001 E
		Checked S.Bush	

WATSON BATTY ARCHITECTS LTD 1-3 TOWN GATE, GUISELEY, LEEDS LS20 9JB
Telephone 01943 876665 Email enquiries@watsonbatty.com
Facsimile 01943 882300 Web www.watsonbatty.com

ISO 9001:2000 WATSON BATTY ARCHITECTS LTD constructionline

Copyright © Watson Batty Architects Ltd

CAD REF: G:\INTERSERVE\SPALDING\PLAYBARN-4000\3729-1-4001C

