




Northern Block - Front Elevation (Units 1-8 and 19-25)

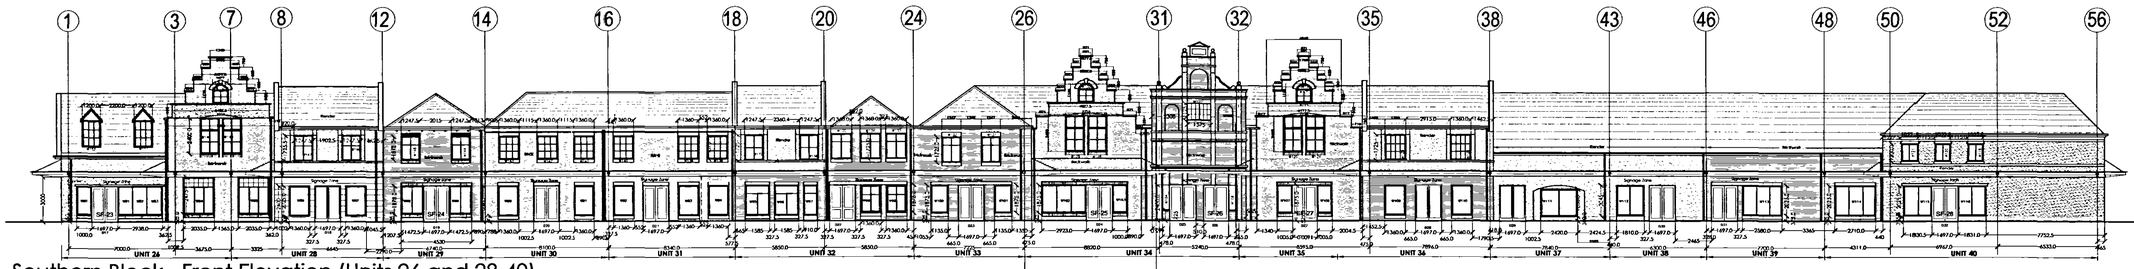


Southern Block - Front Elevation (Units 26 and 28-40)

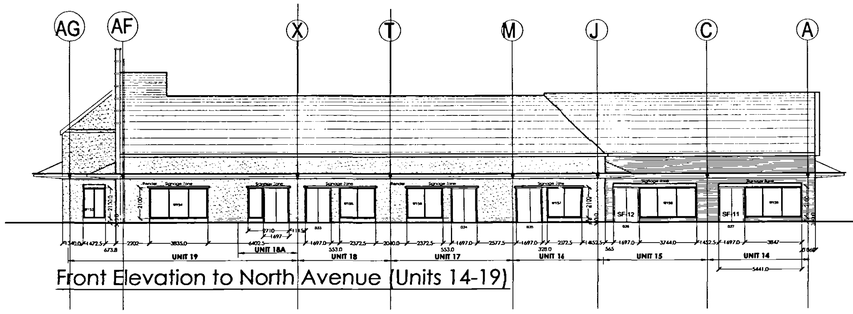

Front Elevation to North Avenue (Units 14-19)

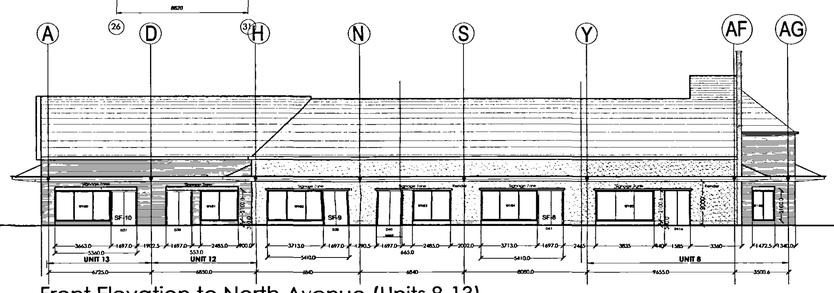


Front Elevation to North Avenue (Units 8-13)

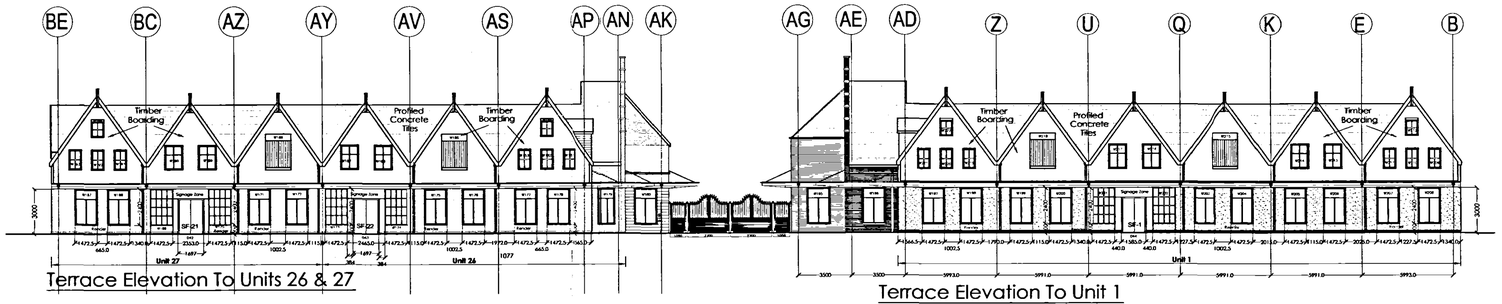

Terrace Elevation To Units 26 & 27

Terrace Elevation To Unit 1

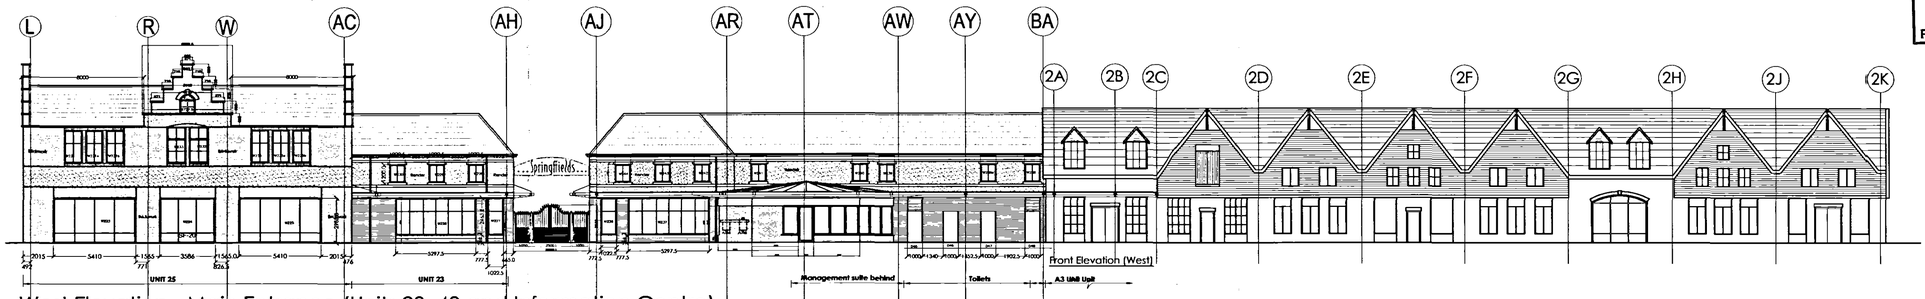

West Elevation - Main Entrance (Units 23, 40 and Information Centre)

AS BUILT

AMENDED PLAN

Ref.

MATERIALS:-

Roofs
- Profiled Concrete Tiles

Walls
- Brickwork to Match Locality
- Sand / Cement Render
- Timber Boarding

SHDC
Planning & Development
1 6 APR 2004
Ref: 1067/03

REV.	DATE	DESCRIPTION	
AC	17.03.04	Information Centre updated to suit latest design.	Revised By: smg / Checked By: tb
AB	10.03.04	Shopfront to Unit 18A added to suit Change Variation.	Revised By: smg / Checked By: tb
AA	22.01.04	Terrace Elevation between grids AN & AK amended.	Revised By: smg / Checked By: tb
Z	19.12.03	Ventilation dormers above Management Suite omitted.	Revised By: smg / Checked By: tb
Y	10.12.03	Window W105 (Unit 34) omitted to avoid clash with windpost and to suit as built on site.	Revised By: smg / Checked By: tb
X	05.12.03	Stepped elevation to Units 26/28 amended to suit revised rafter level on site.	Revised By: smg / Checked By: tb
W	2.12.03	Canopy level altered to Unit 24,25	Revised By: SL / Checked By: smg
V	28.11.03	Dormers above Mangmnt. Suite added for ventilation.	Revised By: smg / Checked By: SB
U	26.11.03	Dormer to Elevation on GL BE added.	Revised By: SL / Checked By: smg
T	12.11.03	Canopy added to units 23,40. Canopy altered to A3 unit	Revised By: SL / Checked By: smg
S	4.11.03	Information Centre Dims Updated.	Revised By: SL / Checked By: SG
R	4.11.03	Information Centre Updated. Canopy omitted from Unit 25 elevation	Revised By: SL / Checked By: SG
Q	24.10.03	Canopies re-introduced to units 24,25,40 Dims altered to unit8	Revised By: SL / Checked By: SG
P	16.10.03	Door opening size and piers to unit 1 amended. Information Centre amended	Revised By: MDP / Checked By: S.G
O	30.9.03	Dims altered to unit 39 grid lines 46-48	Revised By: S.Lonie / Checked By: S.G
N	26.9.03	New management suite added	Revised By: S.Lonie / Checked By: S.Geering
M	15.09.03	Feature fascias & cement render omitted on all elevations. Dims altered on Units 3&8 Canopy removed from W Elevation Elev. between GL 4 & 9 at 1st floor amended to suit steel frame	Revised By: S.Lonie / Checked By: S.Geering
L	10/09/03	Elevation amended between Grids 4 and 9 at First Floor level to suit steelwork frame location	Revised By: S.Geering / Checked By: S.Bush
K	03/09/03	Unit 3 amended to suit arrangement of windposts.	Revised By: S.Geering / Checked By: sbush
J	1.8.03	Dims altered to Units 1-13 Units 3,4&31 altered in line with windposts Doors altered in line with GA100N Units 24-25 altered	Revised By: S.Lonie / Checked By: smg
I	11/8/03	Roof details altered on Units 23 & 40 Springfied canopy omitted	Revised By: S.Lonie / Checked By: S.Geering
H	08.08.03	Additional dims. added to external walls (units 1-13 & 26-40)	Revised By: smg / Checked By: SB
G	07.08.03	Shopfront references added	Revised By: S.Shepherd / Checked By: smg
F	9/8/03	Brickwork omitted to arch windows replaced by artsone Units 25,19,8, 1,34,35	Revised By: S.Lonie / Checked By: S.Bush
E	22-7-03	Roofs on grid, fenestration alteration to Unit 2,3,28,30,31,32,33,19-23 incl. Add ext RWP,s	Revised By: SB / Checked By: S.Bush
D	09.06.03	Side elevation of dormers to units 1 & 26 added to Terrace elevations	Revised By: smg / Checked By: S.Bush
C	28.05.03	Roof ridge & eaves levels updated.	Revised By: smg / Checked By: S.Bush
B	23.05.03	Brickwork dimensions added. Grid lines added. Updated to latest GA.	Revised By: smg / Checked By: S.Bush
A	09.05.03	Windows/doors amended to suit latest GA's	Revised By: SMG / Checked By: S.Bush

AD	24.03.04	Made AS BUILT drawing	Revised By: smg / Checked By:

Received: Action:

Comments:

Interserve Building

Springfields Outlet Shopping & Festival Gardens
Holbeach Road / Camel Gate
Spalding, Lincolnshire

NORTH, EAST & WEST AVE ELEVATIONS

Date:	Scale:	Drawn	Drawing No.
feb2003	1:200	S Bush	3729-1-GA-105 AD
		Checked S.Bush	

WATSON BATTY ARCHITECTS LTD 1-3 TOWN GATE, GUISELEY, LEEDS LS20 9JB
Telephone 01943 876665 Email enquiries@watsonbatty.com
Facsimile 01943 882300 Web www.watsonbatty.com

ISO 9001:2000 WATSON BATTY ARCHITECTS LTD

Copyright © Watson Batty Architects Ltd

CAD REF: G:\Thornfield\Spalding\GA\3729-1-GA-105