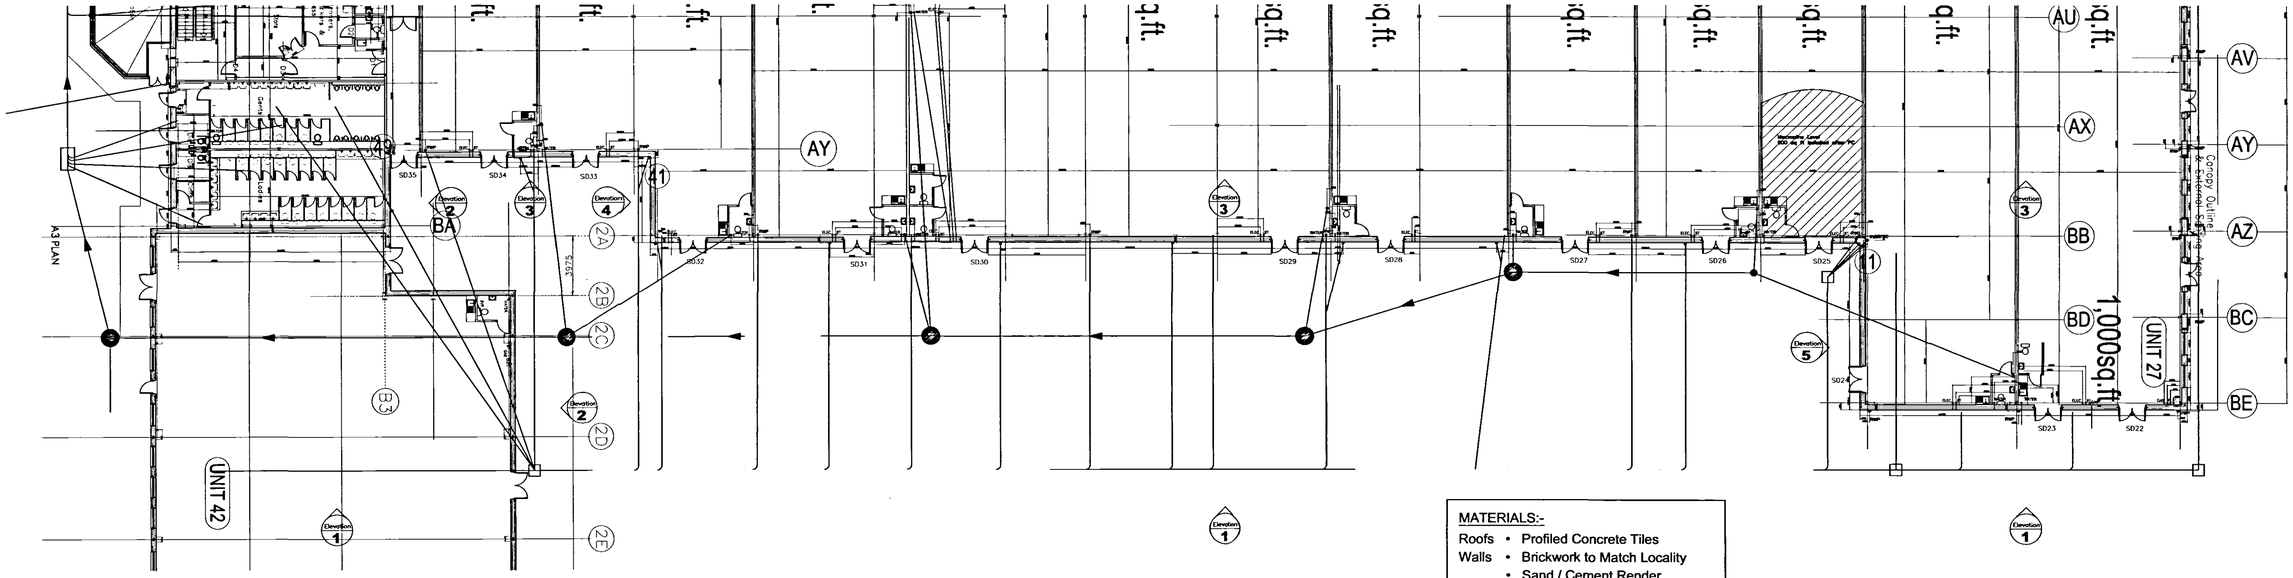
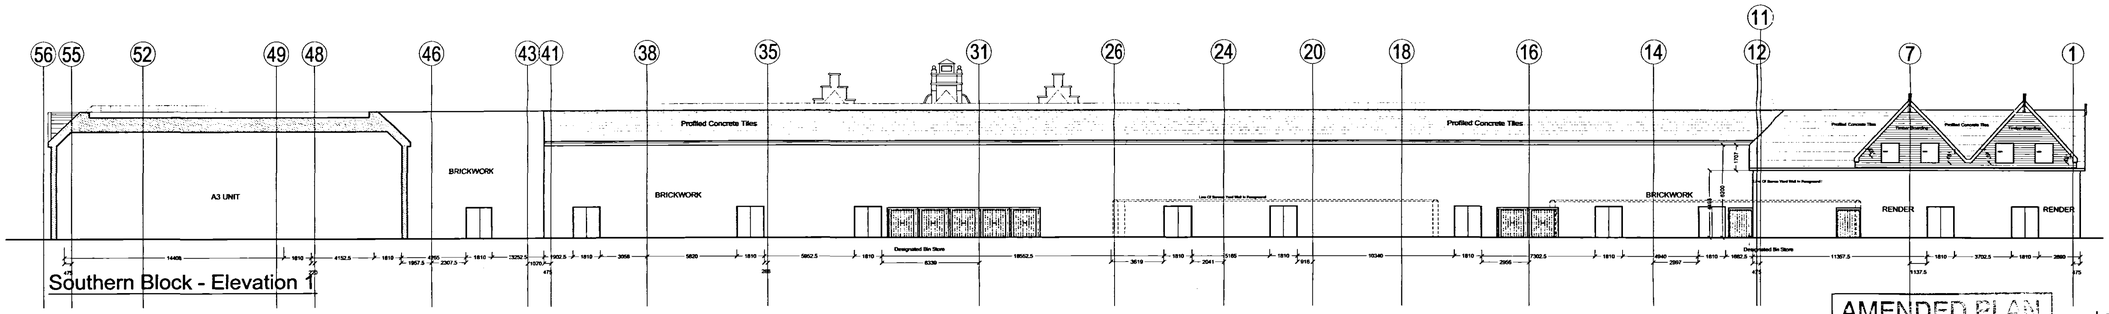
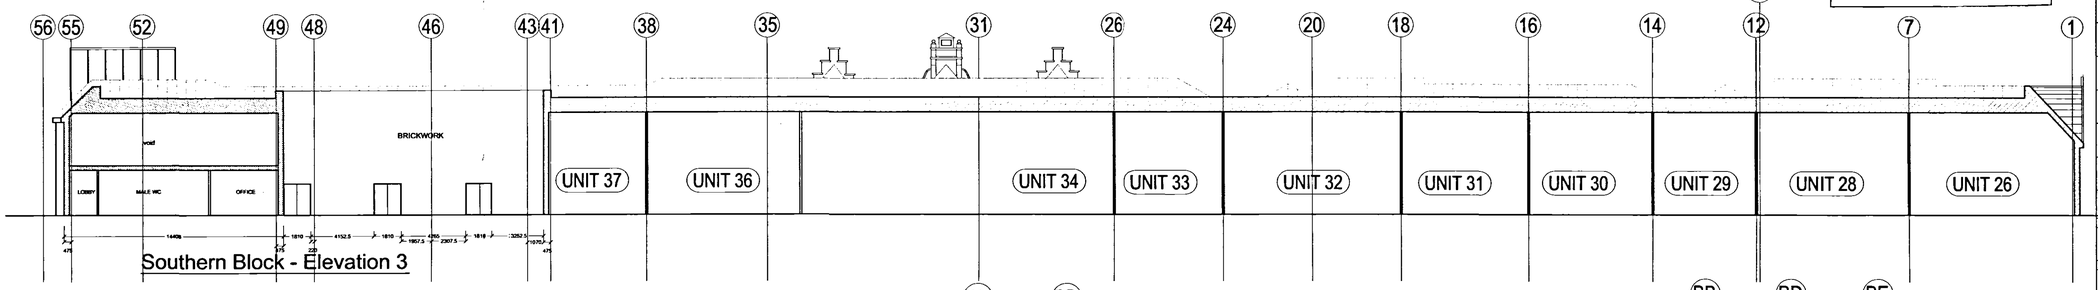



MATERIALS:-

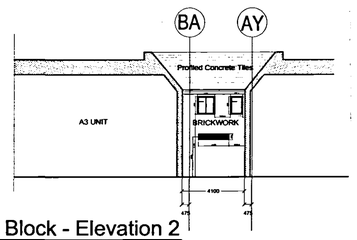
Roofs • Profiled Concrete Tiles
Walls • Brickwork to Match Locality
• Sand / Cement Render
• Timber Boarding





Southern Block - Elevation 1





Southern Block - Elevation 3




Southern Block - Elevation 2

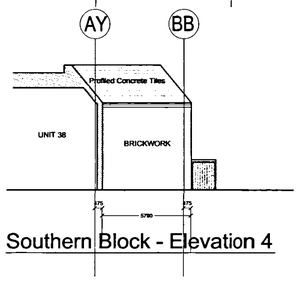


Southern Block - Elevation 4

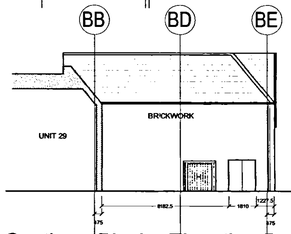


Southern Block - Elevation 5

# AS BUILT

SHDC
Planning & Development
16 APR 2004
Ref: 1067/03

AMENDED PLAN
Ref.

CONTRACT DRAWING (Formally 3397-GA-09D)

| REV. | DATE | DESCRIPTION | |
|---|---|---|---|
| G | 24.03.04 | Made AS BUILT drawing | Revised By: / Checked By: |
| F | 28.11.03 | Elevation to Grid Line BE amended. Louvre setting out to Elevation 2 added. | Revised By: / Checked By: |
| E | 26.11.03 | Elevation to Grid Line BE amended. | Revised By: / Checked By: |
| D | 27.10.03 | Window W247 amended to 797.5mm wide (brick dim.) Gable end on Grid Line BE omitted. | Revised By: / Checked By: SD |
| C | 22.10.03 | Windows added to F/F management Center | Revised By: / Checked By: |
| B | 07.10.03 | Elevations on Grid Line BE & 11 updated to suit steelwork Door omitted on Elevation 2 | Revised By: smg / Checked By: SJB |
| A | 23.05.03 | General update to suit GA. Grid lines & dimensions added. | Revised By: smg / Checked By: sbush |

Received: Action:

Comments:

Interserve Buildin

Springfields Outlet Shopping & Festival Gardens
Holbeach Road / Camel Gate
Spalding, Lincolnshire

thornfield properties

RETAIL UNITS
SERVICE YARD ELEVATIONS
SOUTH BLOCK

| Date: | Scale: | Drawn: | Drawing No. |
|---|---|---|---|
| Feb 03 | 1:200 | S Bush | 3729-1-GA-106 G |
| | | Checked: smg | |

WATSON BATTY ARCHITECTS LTD
1-3 TOWN GATE, GUISELEY, LEEDS LS20 9JS
Telephone 01943 876665
Facsimile 01943 882300
Email enquiries@watsonbatty.com
Web www.watsonbatty.com

ISO 9001:2000

WATSON BATTY ARCHITECTS LTD

Copyright © Watson Batty Architects Ltd

CAD_REF: G:\Interserve\Spalding\GA\3729-1-GA-106