
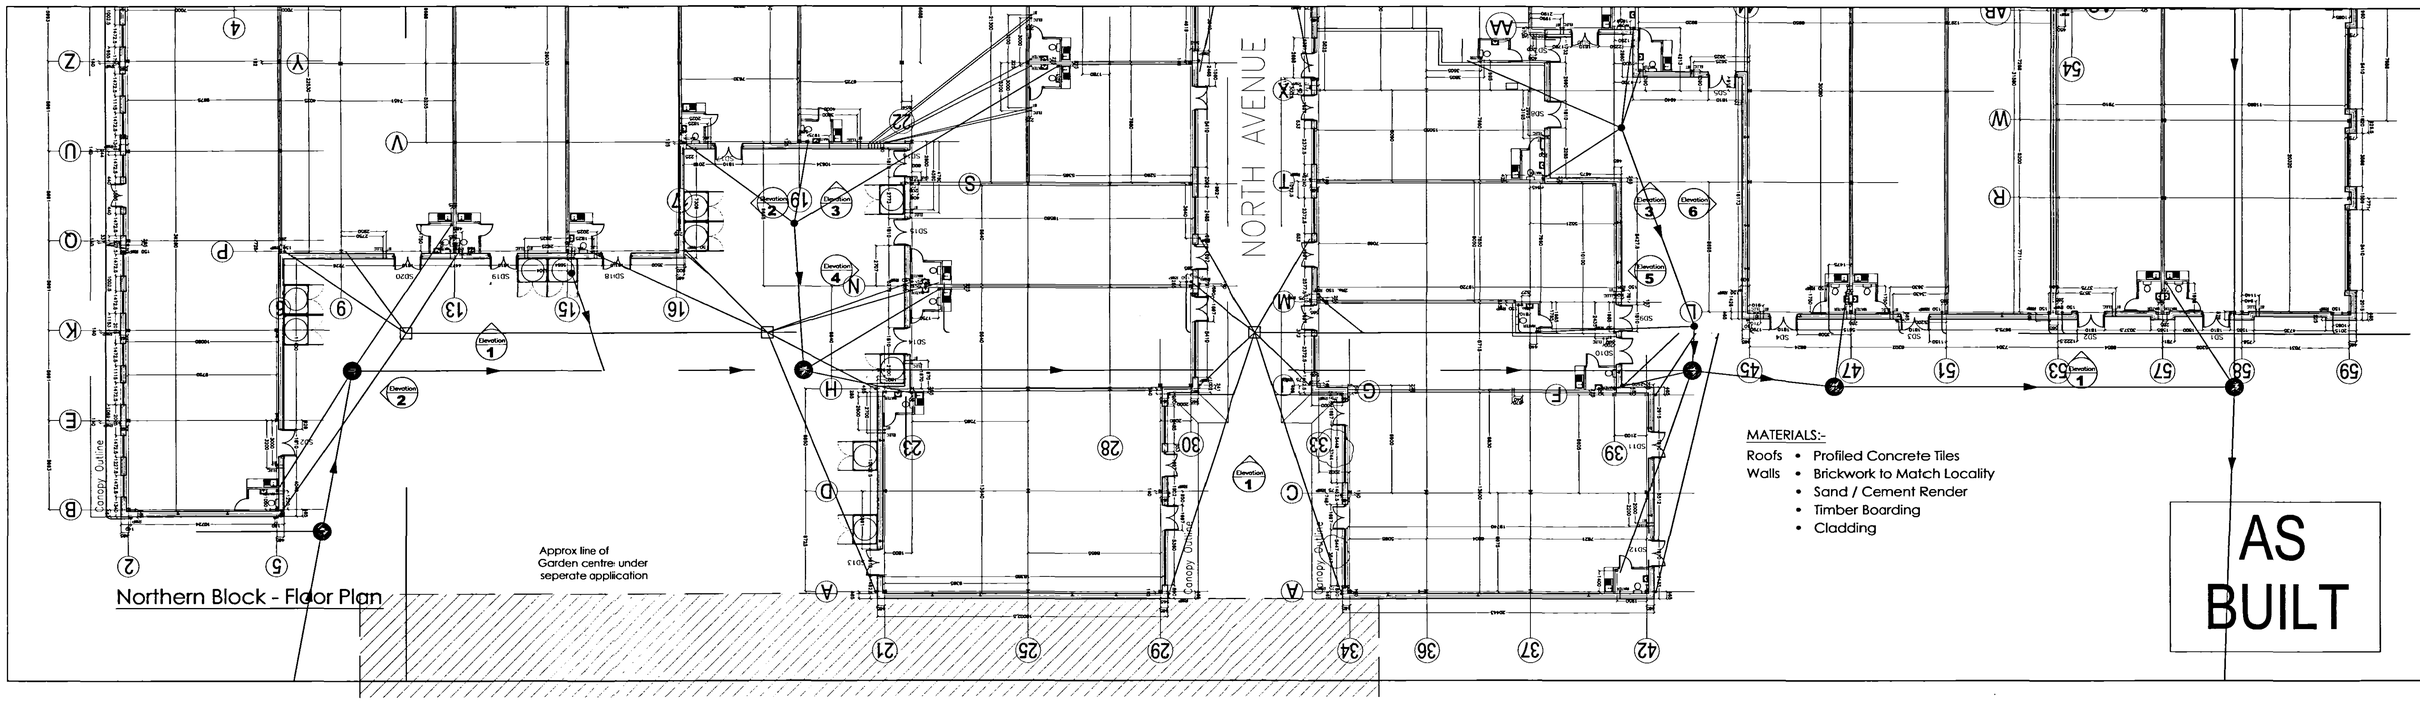


Northern Block - Floor Plan


MATERIALS:-

Roofs • Profiled Concrete Tiles
Walls • Brickwork to Match Locality
• Sand / Cement Render
• Timber Boarding
• Cladding


AS BUILT

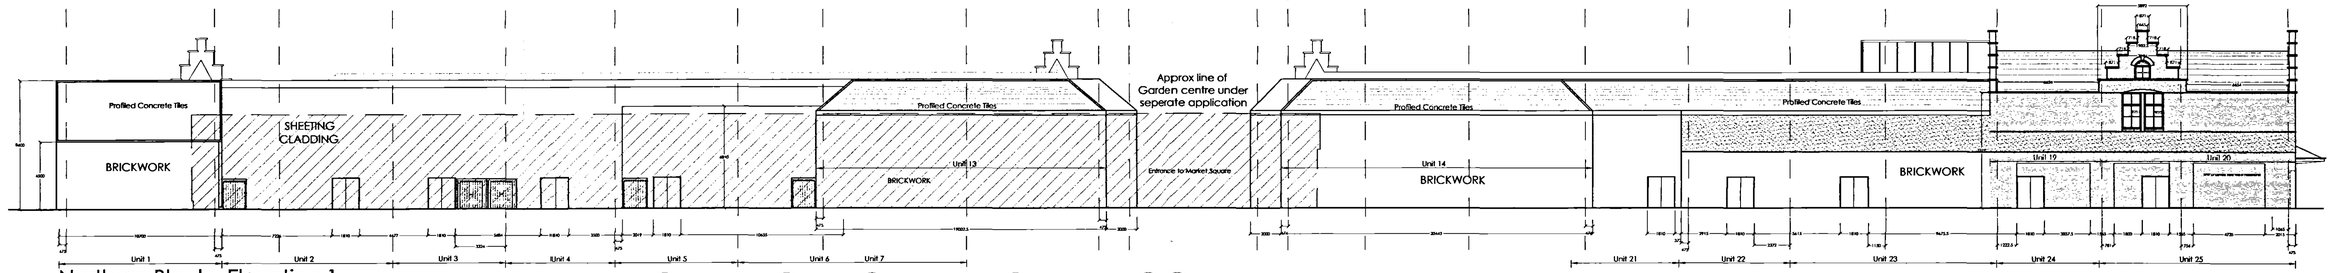


Northern Block - Elevation 1

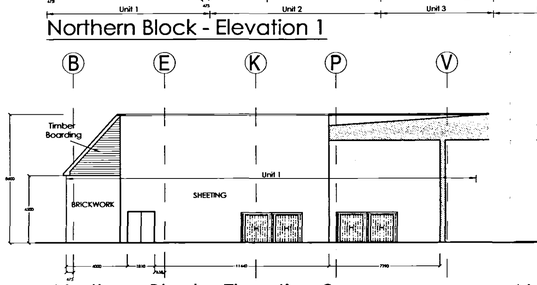


Northern Block - Elevation 2

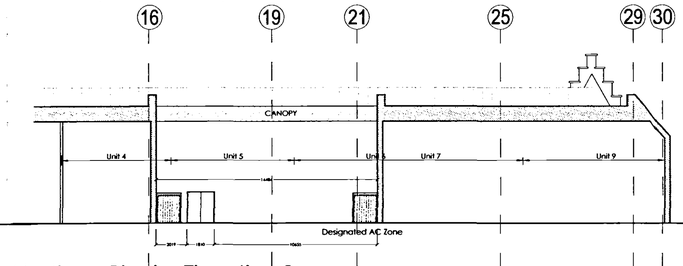


Northern Block - Elevation 3

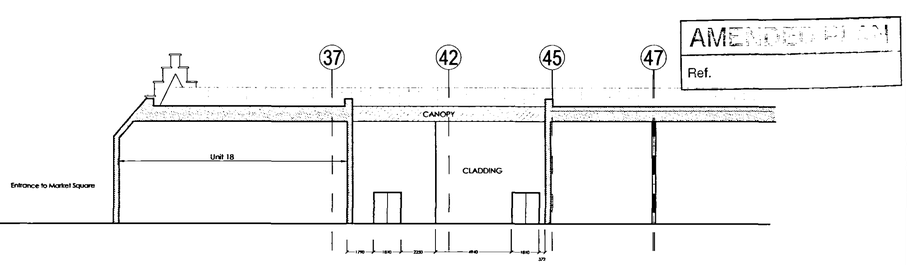


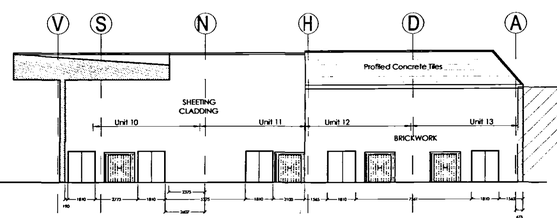

Northern Block - Elevation 4

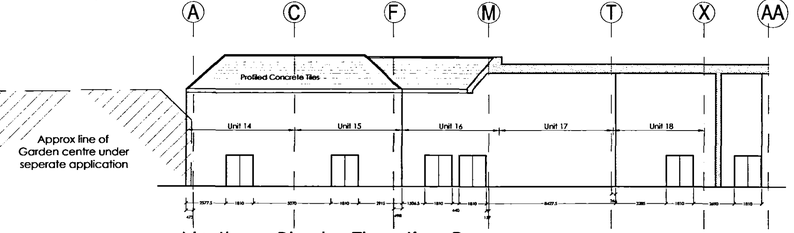

Northern Block - Elevation 5

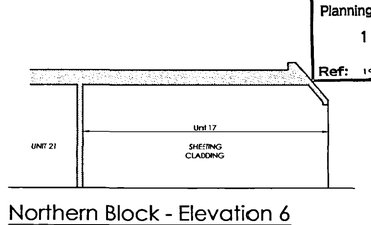

Northern Block - Elevation 6

SHDC
Planning & Development
16 APR 2004
Ref: 1067/03

AMENDED PLAN
Ref.

REV.	DATE	DESCRIPTION	
F	24.03.04	Made AS BUILT drawing	Revised By: smg / Checked By:
E	03.03.04	Elevation to Units 22 & 23 amended to show render panel as built.	Revised By: AJ / Checked By:
D	24.10.03	Amendments made to Elevations to Units 24&25	Revised By: SJ. / Checked By: smg
C	25.06.03	Outline of Garden Centre added	Revised By: S.Shepherd / Checked By: S.G
B	23.06.03	Brickwork dimensions & grid lines added. Updated to suit latest GA	Revised By: smg / Checked By: S.Bush
A	19-5-03	Revise Elev 2 , clarify sheeted areas remove indicative A\C areas	Revised By: S. Bush / Checked By: S.Bush

Received: Action:

Comments:

Interserve Building

CONTRACT DRAWING (Previousley 3397-1-GA-017E

Springfields Outlet Shopping & Festival Gardens
Holbeach Road / Camel Gate
Spalding, Lincolnshire

RETAIL UNITS
SERVICE YARD ELEVATIONS 2
NORTH BLOCK

Date: Feb 03 | Scale: 1:200 | Drawn: S Bush | Checked: S.Bush | Drawing No. 3729-1-GA-107 F

WATSON BATTY ARCHITECTS LTD
1-3 TOWN GATE, GUISELEY, LEEDS LS20 9JB
Telephone 01943 876665 Email enquiries@watsonbatty.com
Facsimile 01943 882300 Web www.watsonbatty.com

ISO 9001:2000

Copyright © Watson Batty Architects Ltd

CAD REF: G:\Interserve\Spalding\GA\3729-1-GA-107