REV.	DATE	DESCRIPTION	
G	24.03.04	Made AS BUILT drawing	Revised By: smg / Checked By:
F	08.01.04	Door GC/D6 (Type 5) amended	Revised By: smg / Checked By: sb
E	05.01.04	Window added between Grids 1J & 1K	Revised By: smg / Checked By: sb
D	5.12.03	Window & Door References Added	Revised By: S.L / Checked By: smg
C	9.10.03	Rainwater pipes added to Elevations. Roof line looking from North Avenue amended.	Revised By: S.L / Checked By: S.G
B	4.9.03	Updated elevations	Revised By: S.Lonie / Checked By: S.G

AS BUILT

MATERIALS
Roof - Kingspan KS 1000 RW Goosewing Grey
Mansard Redland Regent Slate Grey

Walls Masonry Red Banbury Multi Red Stock T6DR
Render Finish White
Powder coated Aluminium Shopfronts

Walls Sheeted Kingspan KS1000 MR Colour beige- Honesty

SPRINGFIELDS
OUTLET SHOPPING • FESTIVAL GARDENS
LINCOLNSHIRE

PROPOSED GARDEN CENTRE ELEVATIONS

Date:	Scale:	Drawn	Drawing No.
05-2002	1/200	S Bush	3729-1-GC-1004 G
		Checked S Bush	

WATSON & BATTY ARCHITECTS LTD 1-3 TOWN GATE, GUISELEY, LEEDS LS20 9JB
Telephone: 01943 876665 Email: enquiries@watsonbatty.com
Facsimile: 01943 882300 Internet: www.watsonbatty.com

Copyright © Watson Batty Architects Ltd


WATSON & BATTY ARCHITECTS LIMITED

Copyright © Watson & Batty Architects Ltd


CAD REF: G:\Interserve\Spalding\Garden center\DWG-9-03\3729-1-GC-1004

SHDC
Planning & Development
16 APR 2004
Ref: 1067/03


AMENDED PLAN
Ref.

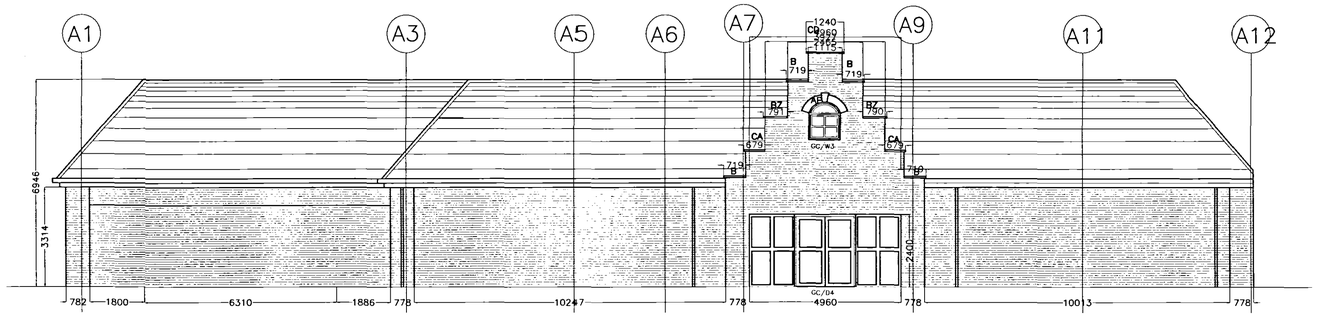


NORTH ELEVATION

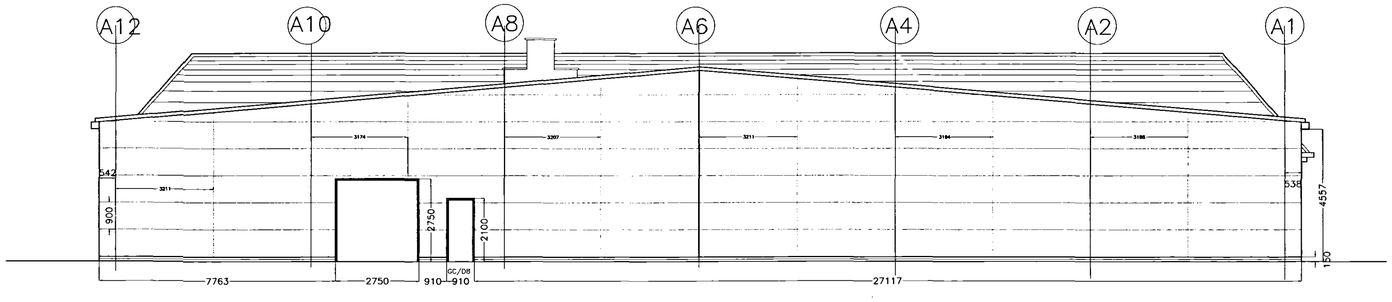


REAR ELEVATION TO SERVICE YARD

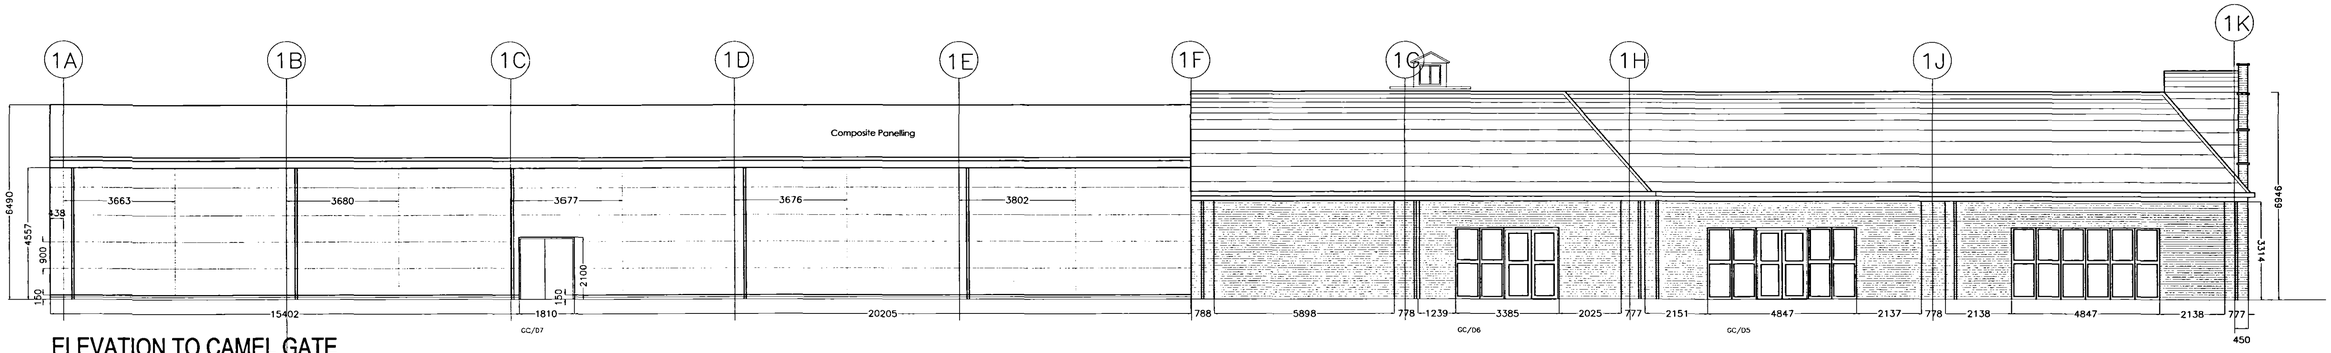

ELEVATION TO CAMEL GATE

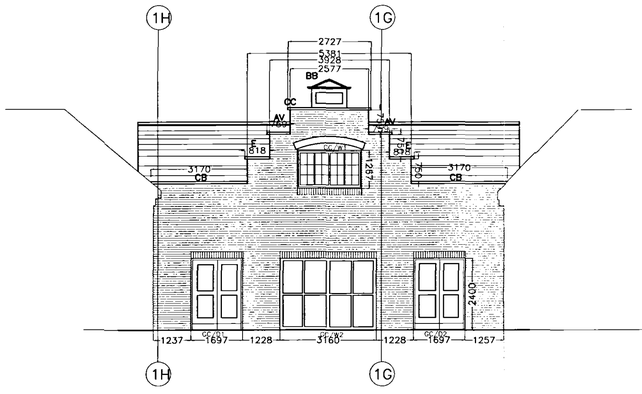

Elevation from North Avenue

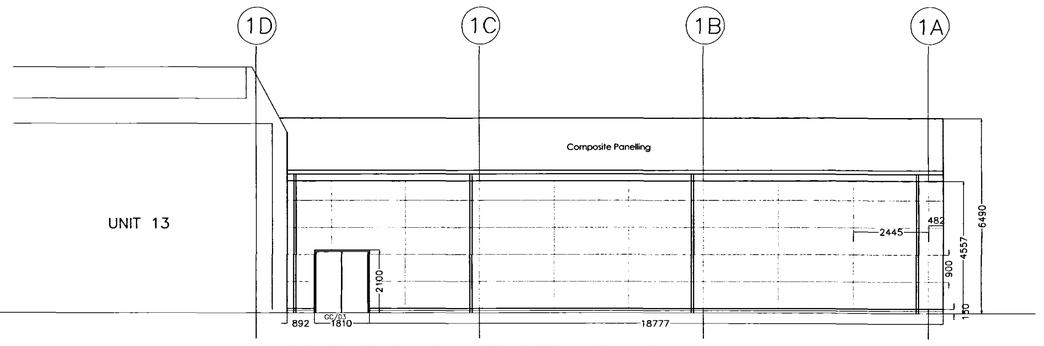

SOUTH ELEVATION TO SERVICE YARD