~~FACING BRICKS IBSTOCK GOLDEN PURPLE WITH PURPLE COINS~~
~~ROOF TILES SANDTOFT HARVEST GOLD~~
CREAM TIMBER WINDOWS


Revised samples brought in 6/11/08.
Ibstock Ivanhoe Red brick.
Natural slate roof.



FRONT ELEVATION



SIDE ELEVATION

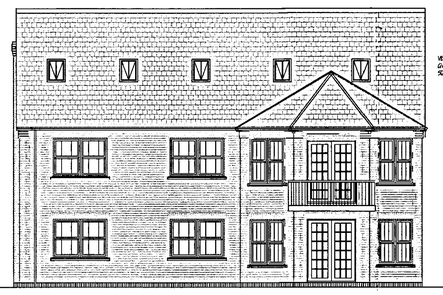


REAR ELEVATION


SHDC
Planning & Development
13 OCT 2008
Ref: 1078/08



SIDE ELEVATION

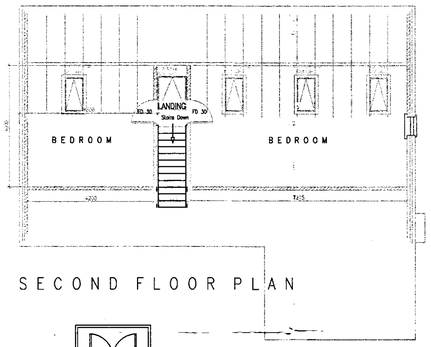


SECOND FLOOR PLAN

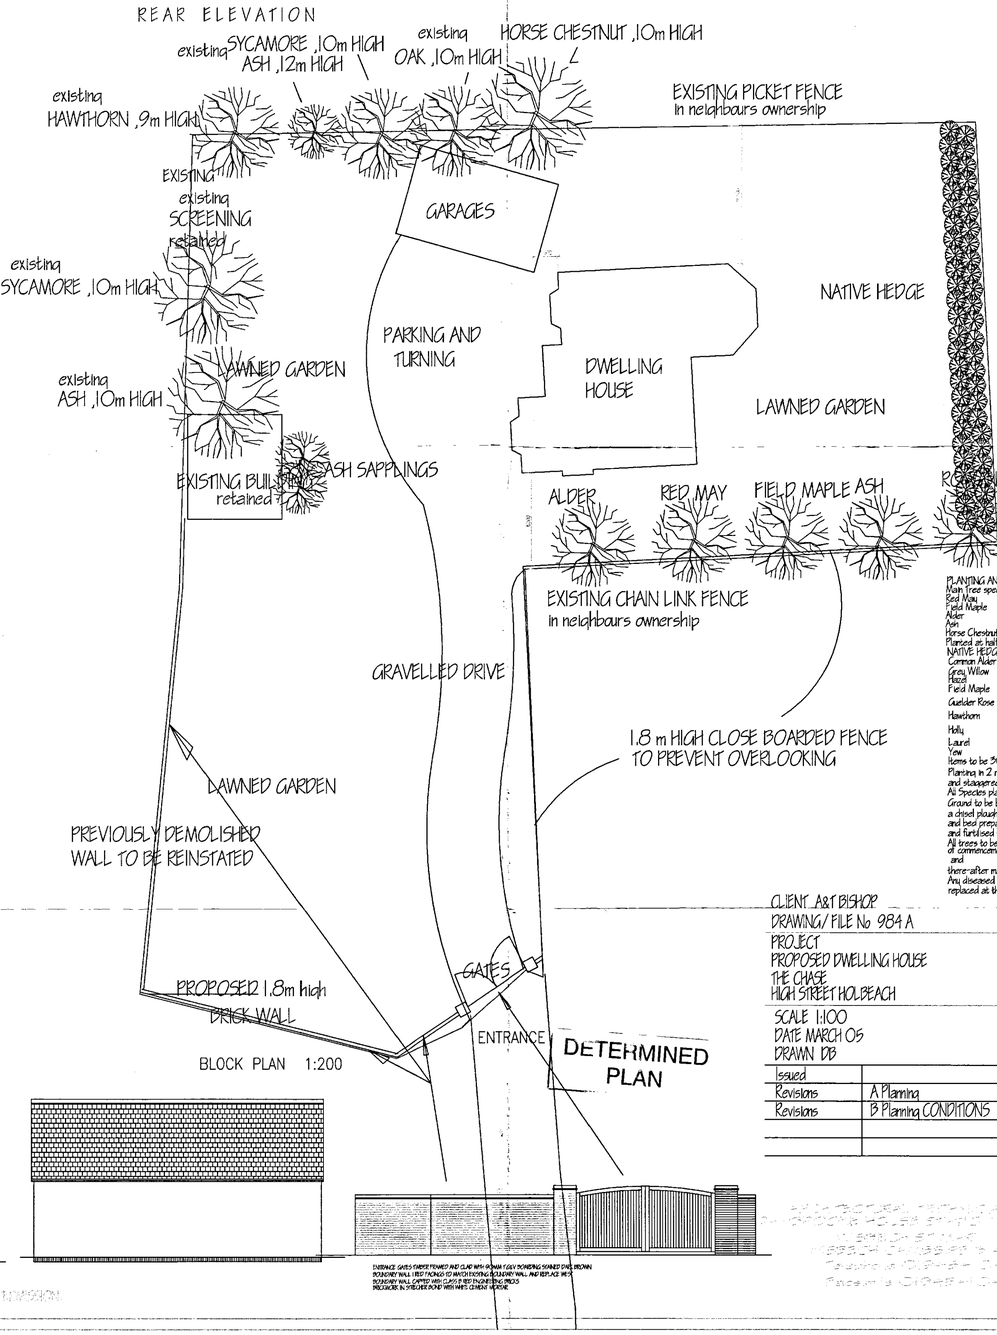


BLOCK PLAN 1:200


PLANTING AND LANDSCAPING
Main Tree species
Red May
Field Maple
Alder
Ash
Horse Chestnut
Planted as half standard
NATIVE HEDGEROW
Common Alder
Grey Willow
Hazel
Field Maple
Guelder Rose
Hawthorn
Holly
Laurel
Yew
Items to be 300/450mm high
Planting in 2 rows 600mm apart
and staggered at 300mm c/c
All Species planted in combination
Ground to be broken in depth with
a chisel plough or similar
and bed prepared
and turfed/seed before planting
All trees to be planted within 2 years of
of commencement of the development
and
there-after maintained for 10 years
Any deceased or dead items to be
replaced at the appropriate time.

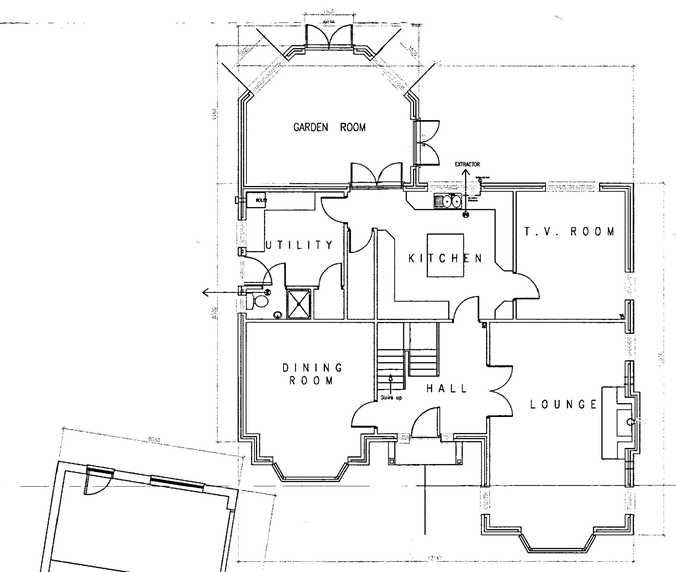


GROUND FLOOR PLAN

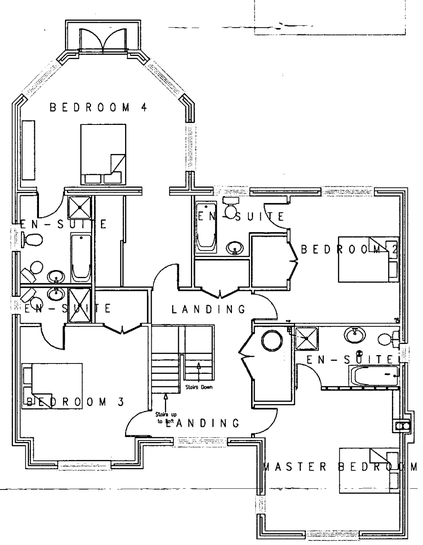

FIRST FLOOR PLAN

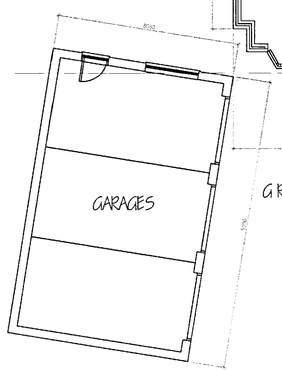



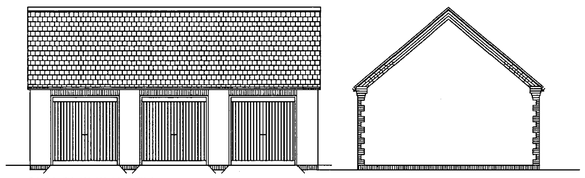

GARAGE ELEVATION

ENTRANCE GATES TIMBER FRAMED AND CLAD WITH 95MM TONGUE AND GROOVED STAINED DARK BROWN
BOUNDARY WALL 1.8M BT PACKED TO MATCH EXISTING BOUNDARY WALL, AND REPLACE WHERE
BOUNDARY WALL CAPPED WITH CLASS B ENGINEERING BRICKS

CLIENT A&T BISHOP
DRAWING/FILE No 984 A
PROJECT
PROPOSED DWELLING HOUSE
THE CHASE
HIGH STREET HOLBEACH

SCALE 1:100
DATE MARCH 08
DRAWN DB

Issued	
Revisions	A Planning
Revisions	B Planning CONDITIONS

THIS DRAWING IS COPYRIGHT AND MAY NOT BE REPRODUCED OR USED EXCEPT BY AGREEMENT WITH THE COPYRIGHT OWNER

C:\WORK\984A&T BISHOP NEW HOUS.dwg, 10/13/2008 13:21:35