




PART SOUTH WEST ELEVATION - 1:200

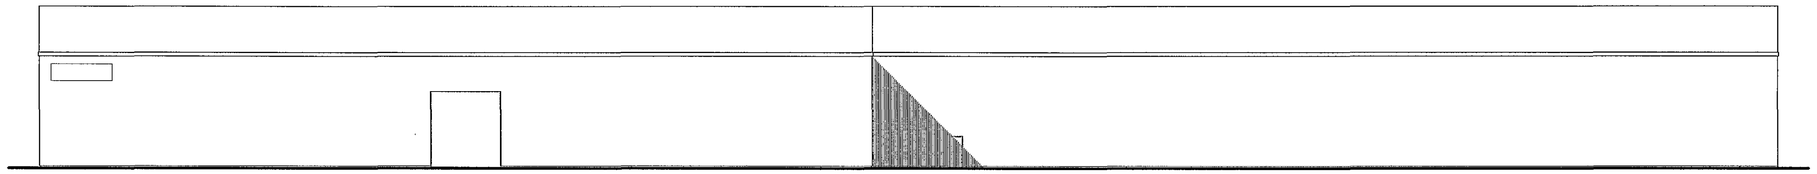

SOUTH EAST ELEVATION - 1:200

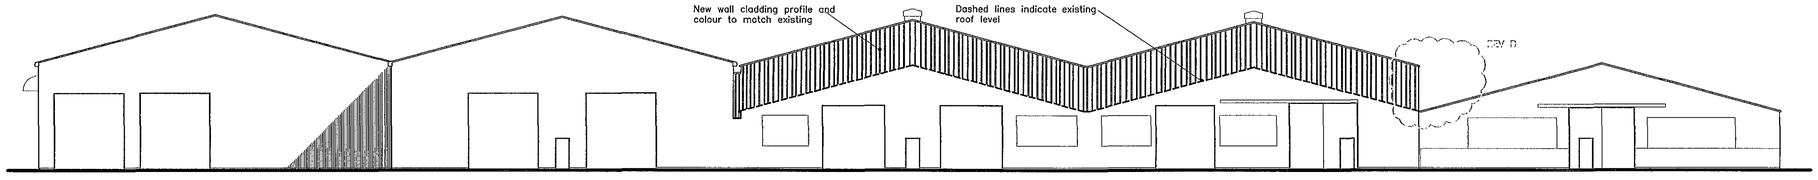

NORTH WEST ELEVATION - 1:200

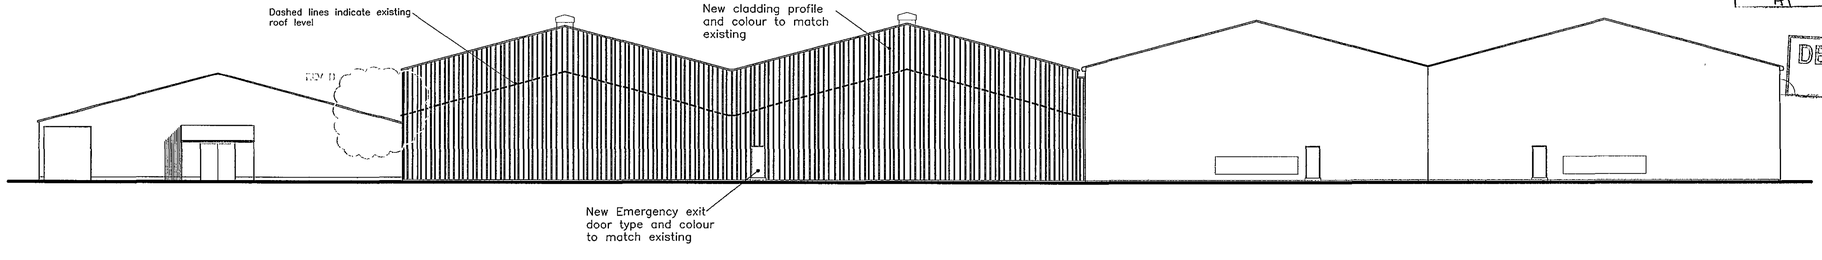

NORTH EAST ELEVATION - 1:200

NOTES

DO NOT SCALE THIS DRAWING.

ALL DIMENSIONS ARE IN mm UNLESS NOTED OTHERWISE.

ALL DIMENSIONS, DETAILS, COMPONENTS AND ASSEMBLIES SHALL BE VERIFIED BY THE CONTRACTOR PRIOR TO CONSTRUCTION, MANUFACTURE OR SUPPLY.

ALL MATERIALS, CONSTRUCTION AND DETAILS SHOWN OR IMPLIED BY THIS DRAWING MUST COMPLY WITH CURRENT BRITISH STANDARDS, CODES OF PRACTICE, PLANNING / BUILDING REGULATIONS, H & SE LEGISLATION AND CLIENTS PARTICULAR SPECIFICATIONS

CONFLICTING INFORMATION SHOWN OR IMPLIED SHALL BE REFERRED TO CALVERT BRAIN & FRAULO ARCHITECTURAL LTD.

THIS DRAWING AND THE WORKS DEPICTED ARE THE COPYRIGHT OF CALVERT BRAIN & FRAULO ARCHITECTURAL LTD. AND MAY NOT BE REPRODUCED WITHOUT WRITTEN PERMISSION.

THIS DRAWING MUST BE READ IN CONJUNCTION WITH ALL ENGINEERS, ARCHITECTS AND SPECIALISTS' DRAWINGS AND SPECIFICATIONS

REV.	DESCRIPTION	APPR.	CHKD.	DRAWN	DATE
B	LOADING CANOPY REMOVED AND RE-ISSUED FOR PLANNING PURPOSES	JLH	JLH	SAG	12/11/07
A	ISSUED FOR PLANNING PURPOSES	JLH	JLH	SAG	09/10/07

SCALES
1:200

CLIENT
O.A. TAYLOR & SONS LTD.
WASHWAY HOUSE FARM
WASHWAY ROAD
HOLBEACH

PROJECT
RAISING OF ROOF TO 'G SHED'

SHDC
Planning & Development
14 NOV 2007
Ref: 1373/07

DRAWING TITLE
ELEVATIONS - AS PROPOSED

AMENDED PLAN
Ref. A1

DETERMINED PLAN

■ PRELIMINARY ☐ TENDER ISSUE
☐ WORKING DRAWING ☐ AS BUILT

CALVERT BRAIN & FRAULO
ARCHITECTURAL LTD
3 PORTLAND STREET, KING'S LYNN, NORFOLK, PE30 1PB
TEL 01553 766220 FAX 01553 766033 WWW C-B-F-A.CO.UK

DRAWING NO.
070112 / 04

REV.
B