PLANNING AMENDMENT

For office use only

Application No. H09/ 1441/00

Date Registered

Case Officer L SMITH .

1. Please complete in block letters

NAME AND ADDRESS OF APPLICANT

~~SIR CHARLES NICHOLSON GROUP.~~

TESCO

Tel. No.

NAME AND ADDRESS OF AGENT
(if form completed by agent)

SIR CHARLES NICHOLSON GROUP.

Tel. No. (Contact)

Please complete in block letters

FULL POSTAL ADDRESS OF THE APPLICATION SITE

BOSTON ROAD HOLBEACH .

Please complete

APPLICATION No.

This amendment **cannot be considered** unless the relevant reference is stated

H09/1441/00.

Building Regulation reference relating to same development (if any)

2. Please tick **one** box only

A — Amendment is proposed where permission already granted. If yes, submit two forms and two plans. [ ]

or

B — Amendment is to a proposal currently being considered. If yes, submit four forms and four plans. [✓]

Please complete

I attach the necessary plans and request that the changes described below be accepted as an amendment. I understand that the Council may require a fresh application, together with fee if appropriate. If the amendment relates to a current application, I agree to an extension of the terminal date.

Signed ..... Date .....

3. Please complete in block letters

FULL DESCRIPTION OF DEVELOPMENT IN ORIGINAL APPLICATION

Externally illuminated wall mounted sign.

State details of amendments proposed

(Give a full detailed list of the changes, and also mark these clearly on the accompanying plans. Only the changes listed here will be considered.)

reduction in overall size.

State drawing no's of the current submission

Has this amendment been requested by the Council? (If so, state Officer dealing with the application)

YES / ~~NO~~ L SMITH .

Describe any part of the original development which is excluded by virtue of the amendment, and state any alteration to plot numbers

Has a similar amendment been submitted under Building Regulations? Yes / No

TESCO

Powder coated aluminia glazed canopy over 2 no. seats. Canopy supported on RHS stanchions and framing.

70 watt down- lighter lamp one/letter

Built-up Lettering 150mm deep
Red TESCO and Blue "BLIPS" under
overall text dimension 6590 x 1702mm


White back board fixed to brickwork

SIR CHARLES NICHOLSON

Tesco Stores Ltd

Proposed Tesco Foodstore

TESCO

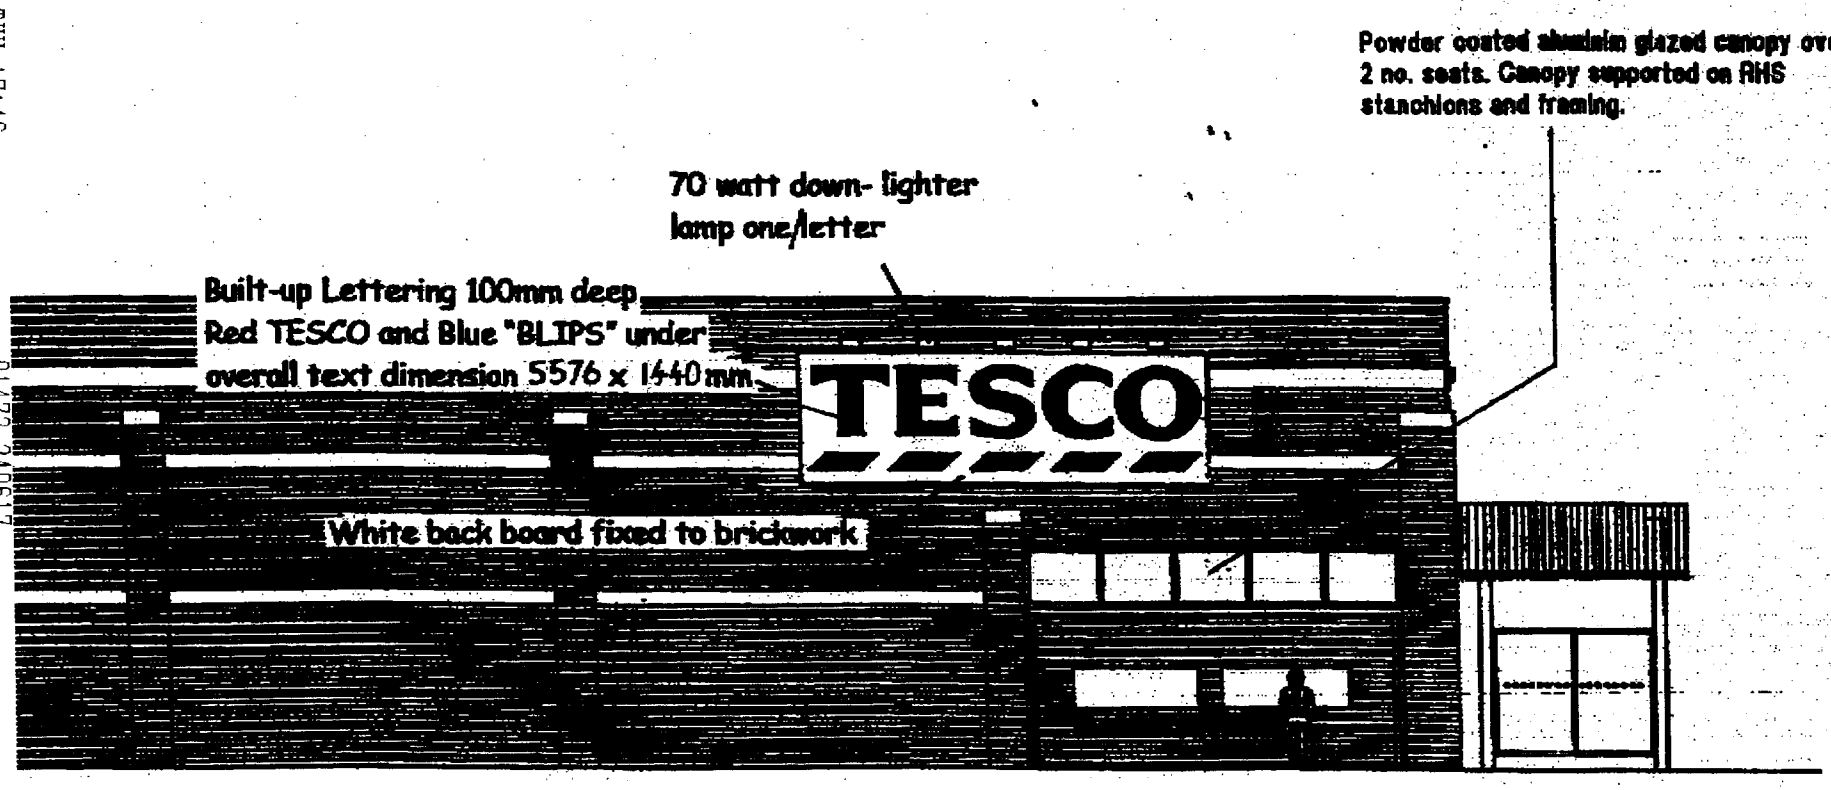

SIR CHARLES NICHOLSON

Tesco Stores Ltd

Proposed Tesco Foodstor

TESCO

Powder coated aluminium glazed canopy over 2 no. seats. Canopy supported on RHS stanchions and framing.

70 watt down- lighter lamp one/letter

Built-up Lettering 100mm deep Red TESCO and Blue "BLIPS" under overall text dimension 4562 x 1178mm



SIR CHARLES NICHOLSON

Tesco Stores Ltd

Proposed Tesco Foodstore

Hawes Signs

TESCO

Red-brown Leicester red stock facing brick, with buff soldier string courses and column caps


Powder coated aluminim glazed canopy over 2 no. seats. Canopy supported on RHS stanchions and framing.

70 watt down- lighter lamp one/letter

Built-up Lettering 100mm deep
Red TESCO and Blue "BLIPS" under
overall text dimension 5576 x 1440 mm

TESCO

White back board fixed to brickwork

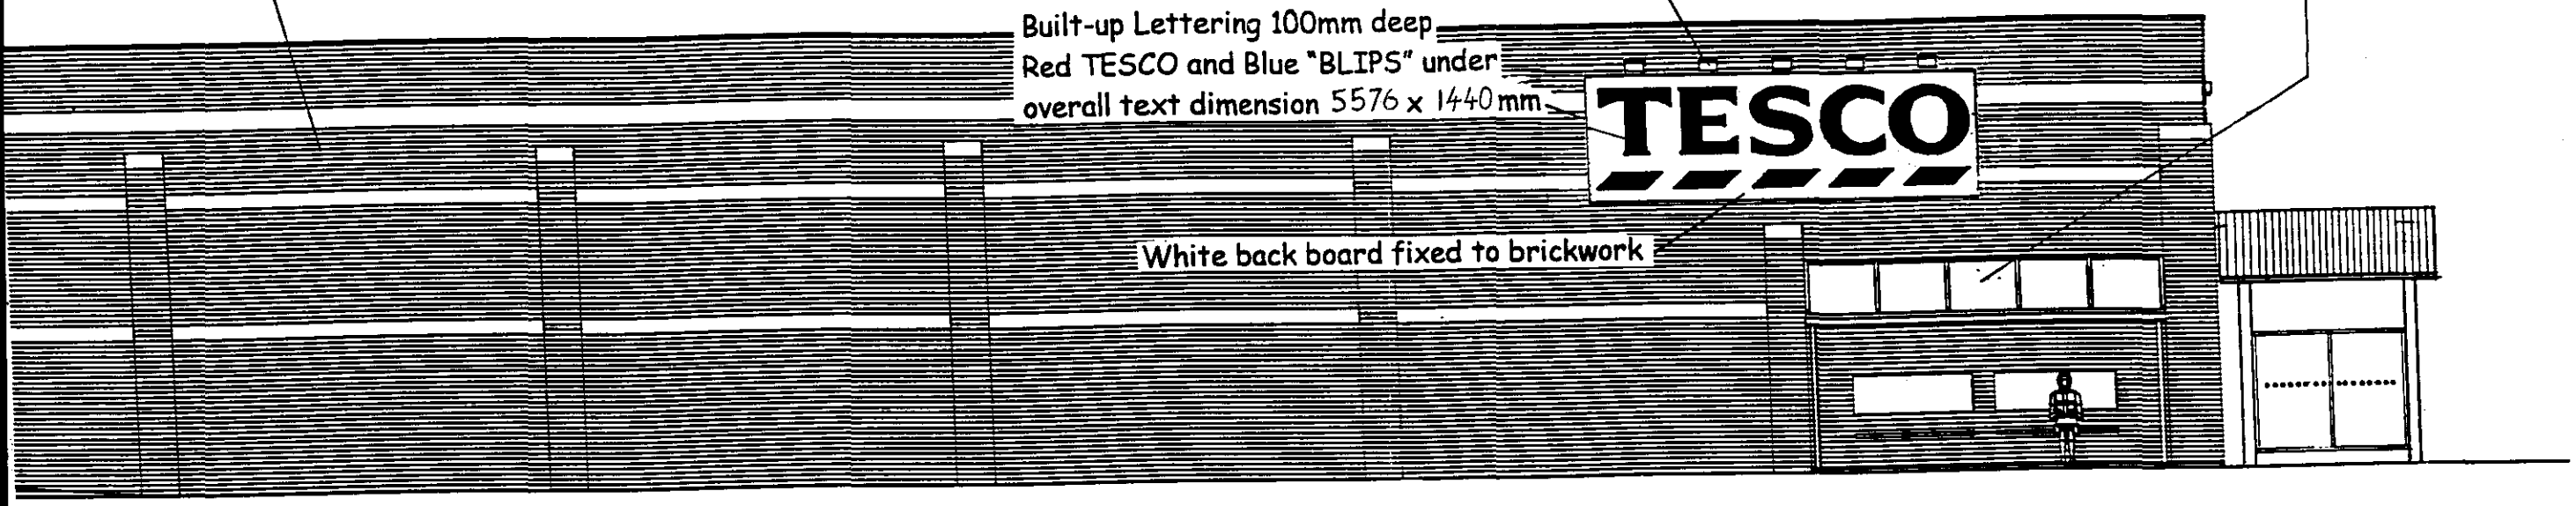

AMENDED PLAN
Ref.

SOUTH HOLLAND DC
HOUSING & PLANNING
15 JAN 2001
Ref:

SIR CHARLES NICHOLSON

Tesco Stores Ltd


Proposed Tesco Foodstor
Boston Road, Holbeach

Boston Road Sign
read in conjunction
with G.3329 .004

24/11/00

G.3329 .015 a

Hawes Signs
tel +44 (0)1604 790000 fax +44 (0)1604 790190
Moulton Park Northampton United Kingdom NN3 6E
TESCO

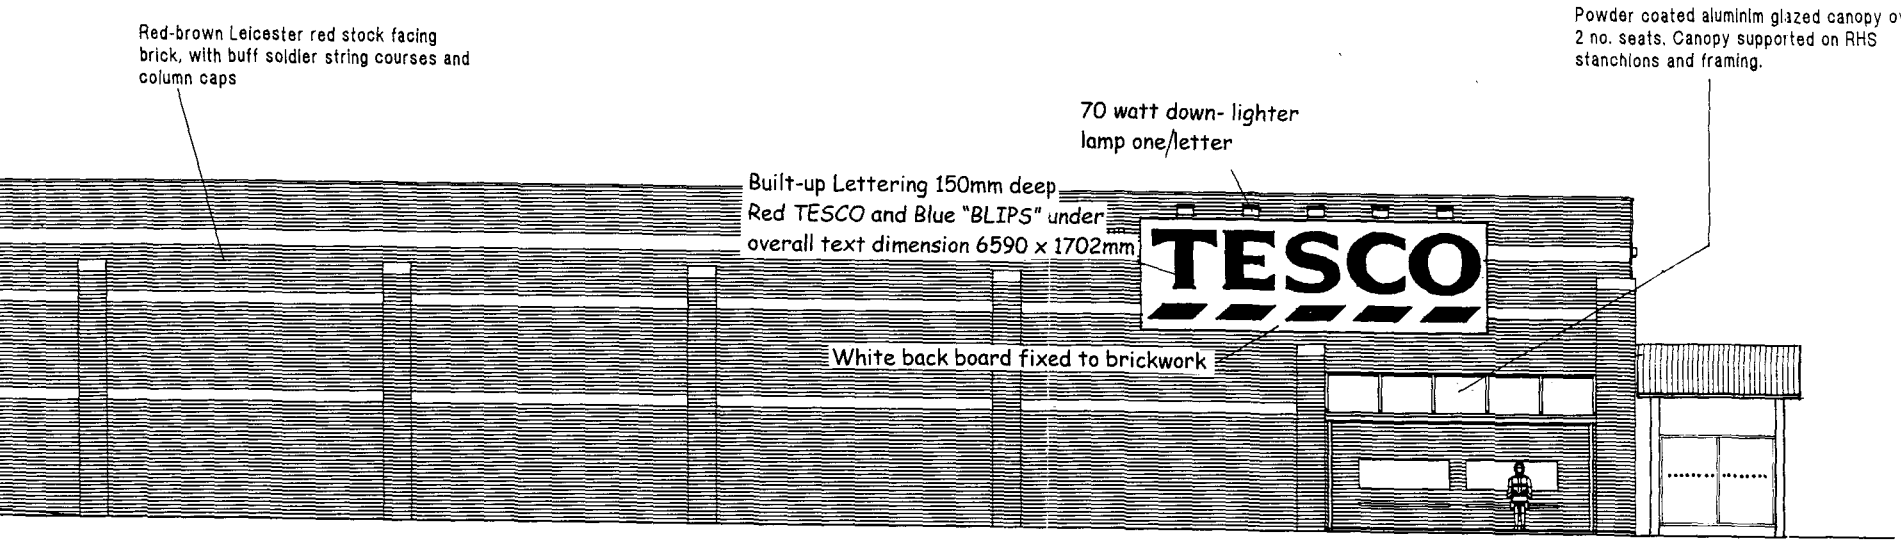

SIR CHARLES NICHOLSON GROUP

RECEIVED 24 NOV 2000
PLANNING DEPARTMENT
12 DEC 2000
Ref. 1441/00

Tesco Stores Ltd

Proposed Tesco Foodstore
Boston Road, Holbeach

Boston Road Sign
read in conjunction with G.3329 .004

1/100 24/11/00

G.3329 .015