




ENTRANCE ELEVATION (SOUTH)

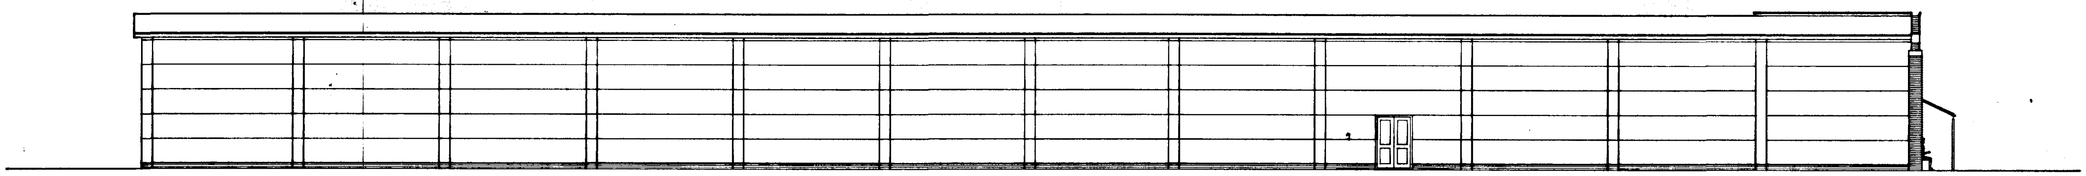

NORTH ELEVATION

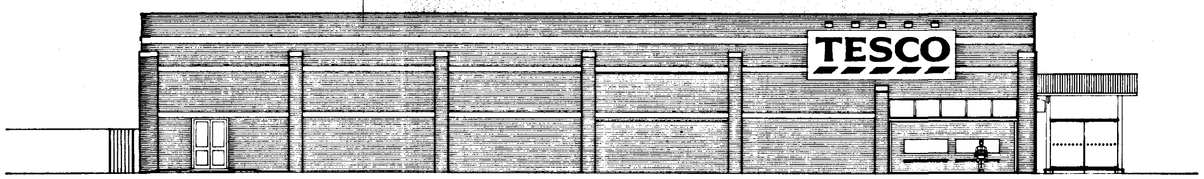

ELEVATION TO BOSTON ROAD (WEST)

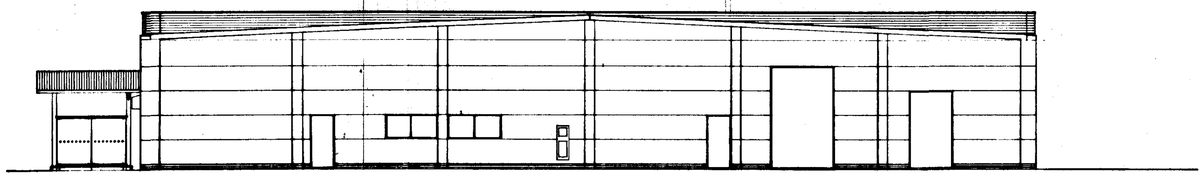

SERVICE ELEVATION (EAST)

SOUTH HOLLAND DC
HOUSING & PLANNING
-8 MAY 2001
Plot: Icaster

APPROVED
Ref. A/0

Do not scale this drawing.
Use figured dimensions only.
Contractors are responsible for taking & checking site measurements.

Design copyright is vested in the Architect from whom written consent must be obtained for copying or reproducing this drawing.

SIR CHARLES NICHOLSON GROUP
The Old Rectory
Bargate, Grimsby, N. E. Lincs. DN34 4SY
Tel: 01472 500567
Fax: 01472 500574
Architects . Designers . Planners

Client
Tesco Stores Ltd


Project
Proposed Tesco Foodstore,
Boston Road, Holbeach.

Title
Elevations
AS BUILT DRAWINGS

Scale	Date
1/125	12/04/01
Drawn SEI	Checked arch

Drawing No. G3329.23

Revision .

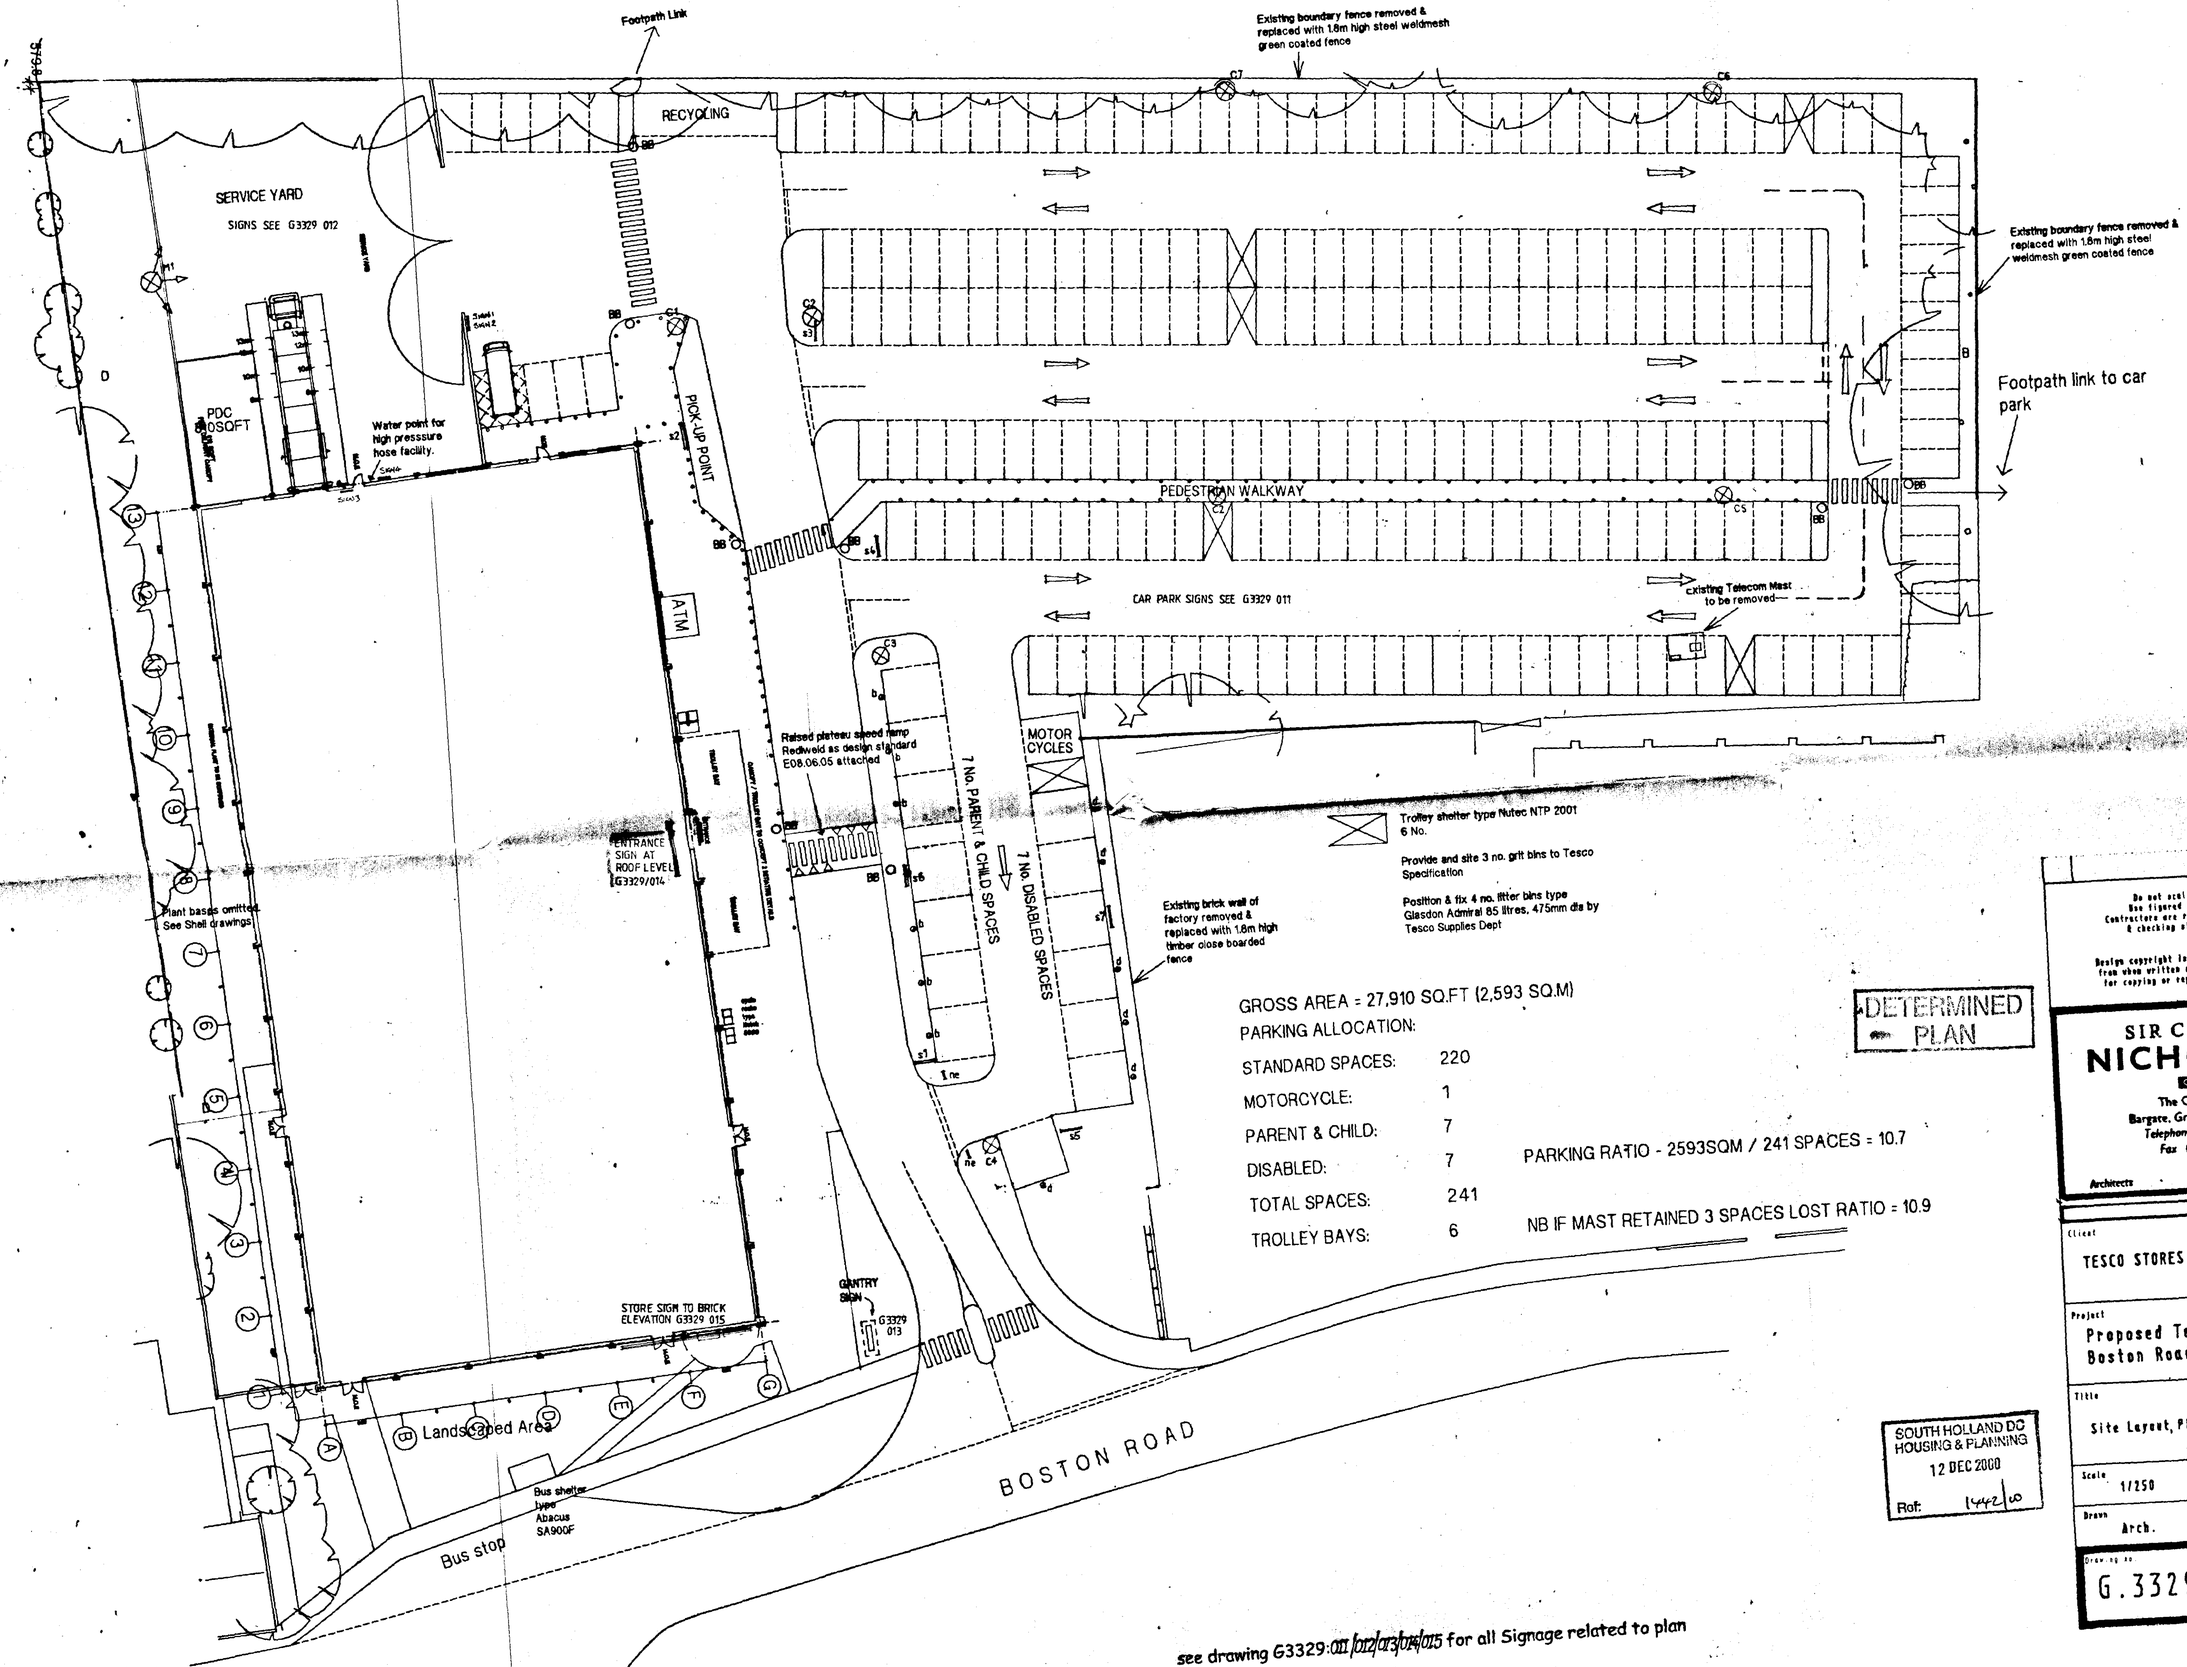

GROSS AREA = 27,910 SQ.FT (2,593 SQ.M)

PARKING ALLOCATION:

STANDARD SPACES:	220	
MOTORCYCLE:	1	
PARENT & CHILD:	7	
DISABLED:	7	PARKING RATIO - 2593SQM / 241 SPACES = 10.7
TOTAL SPACES:	241	
TROLLEY BAYS:	6	NB IF MAST RETAINED 3 SPACES LOST RATIO = 10.9


DETERMINED PLAN

SOUTH HOLLAND DC
HOUSING & PLANNING
12 DEC 2000
Ref: 1442/00

Do not scale this drawing.
Use figured dimensions only.
Contractors are responsible for taking & checking site measurements.

Design copyright is vested in the Architect from whom written consent must be obtained for copying or reproducing this drawing.

SIR CHARLES NICHOLSON GROUP
The Old Rectory
Bargate, Grimsby DN34 4SY
Telephone 01472 500567
Fax 01472 500574
Architects · Designers · Planners

Client: TESCO STORES LTD.

Project: Proposed Tesco Foodstore, Boston Road, Holbeach.

Title: Site Layout, Plan

Scale	Date
1/250	07/09/00
Drawn: Arch.	Checked: SEI
Drawing No: G.3329.04	Revision: A