PLANNING AMENDMENT

For office use only
Application No. H09/1444/00
Date Registered
Case Officer L SMITH

1. Please complete in block letters
NAME AND ADDRESS OF APPLICANT

TESCO Ltd

Tel. No.

NAME AND ADDRESS OF AGENT
(if form completed by agent)
Sir Charles Nicholson Group.

Tel. No. (Contact)

Please complete in block letters
FULL POSTAL ADDRESS OF THE APPLICATION SITE

BOSTON ROAD HORBEACH.

Please complete
APPLICATION No.
This amendment **cannot be considered** unless the relevant reference is stated

H09/1444/00

Building Regulation reference relating to same development (if any)

2. Please tick **one** box only

A Amendment is proposed where permission already granted
If yes, submit two forms and two plans.

or

B Amendment is to a proposal currently being considered
If yes, submit four forms and four plans. ✓

AMENDED PLAN Ref.

Please complete
I attach the necessary plans and request that the changes described below be accepted as an amendment. I understand that the Council may require a fresh application, together with fee if appropriate. If the amendment relates to a current application, I agree to an extension of the terminal date.

Signed ..... Date .....

3. Please complete in block letters
FULL DESCRIPTION OF DEVELOPMENT IN ORIGINAL APPLICATION

State details of amendments proposed

(Give a full detailed list of the changes, and also mark these clearly on the accompanying plans. Only the changes listed here will be considered.)

INCREASE HEIGHT OF SOME OF THE CAR PARK SIGNAGE.

State drawing no's of the current submission

Has this amendment been requested by the Council? (If so, state Officer dealing with the application)

~~YES~~/~~NO~~ L SMITH

Describe any part of the original development which is excluded by virtue of the amendment, and state any alteration to plot numbers

Has a similar amendment been submitted under Building Regulations? Yes / No

21 MARCH.

Gordon Smith and Partners
Architects Designers Planners
The Old Rectory
Bargate, Grimsby DN34 4SY
Telephone : 01472 500567
Fax : 01472 500574

SIR CHARLES NICHOLSON

Our ref SEI/TF/G3329
Your ref
Date 12 January 2001

Partners
Gordon Smith FRIBA
Brian Wood Dip Arch RIBA MIMgt

Structural Consultant
Joseph Heaton C Eng MICE MIStruct E

Administrator
Robin Parker

Consultants
Arthur Wood
Eric Toft FRIBA
Anthony Brockington MRIAT

Offices also at
Nottingham
London
York

F.A.O. Lewis Smith Esq.
South Holland & District Council
Housing & Planning Services Dept.
Council Offices
Priory Road
Spalding
Lincs. PE11 2XE

Dear Mr Smith

re: Signage application - Boston Road, Holbeach

Please find enclosed six copies of drawing G3329 011.alt and 015a together with one copy of G3329 011 showing the deleted signs for you to mark on your existing set of prints.

The heights of the signs on drawing 011 have been lifted in order for the public to be able walk under the signs without fear of collision with the signage panel.

The other signs on the site have remained at their original levels as per your instructions.

The signage concerning the brickwork elevation has been reduced to 5576 x 1440mm with a minimal white backboard as shown on drawing 15a thus satisfying the requirements raised in our telephone conversation earlier todayH.

If you have any further queries please do not hesitate to contact the writer.

Yours sincerely

Steven Ibbotson (BA Hons) Dip Arch RIBA
Sir Charles Nicholson Group

encs

In association with BRIAN HAYES


Associated offices
London
Southampton
Taunton
Bristol
Weston-super-Mare
Guernsey
Alderney
Warsaw
Gibraltar


RIBA

Corporate Member CIVIC TRUST


VAT No 128 9276 38

APPROVED PLAN
Ref.

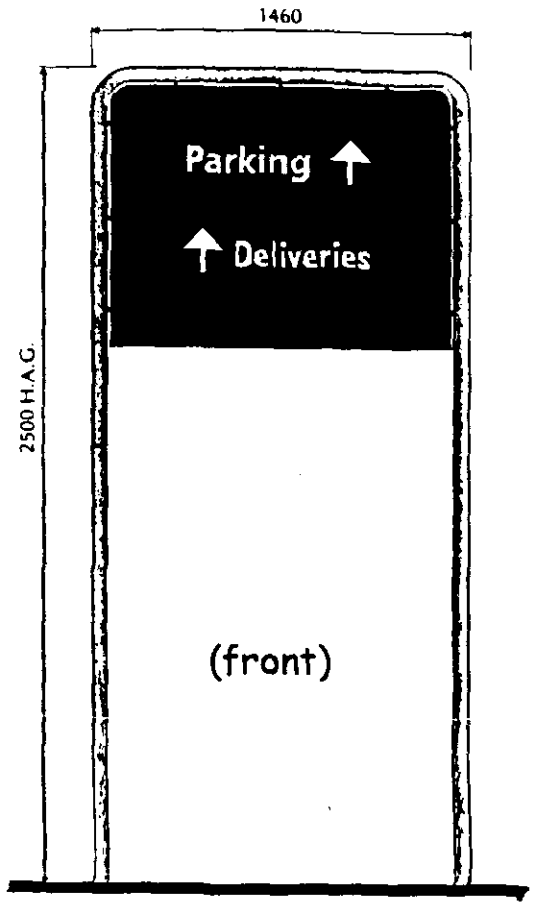


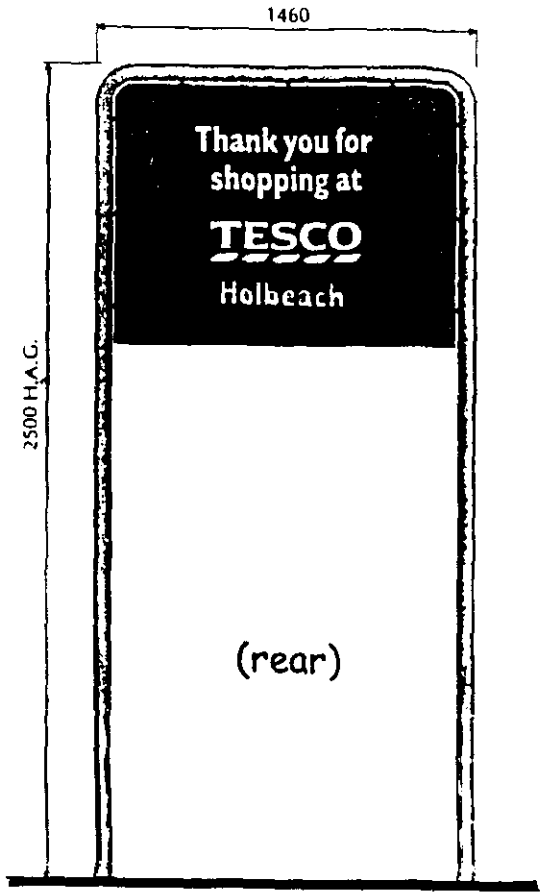

s1 Entrance Parking and Delivery sign

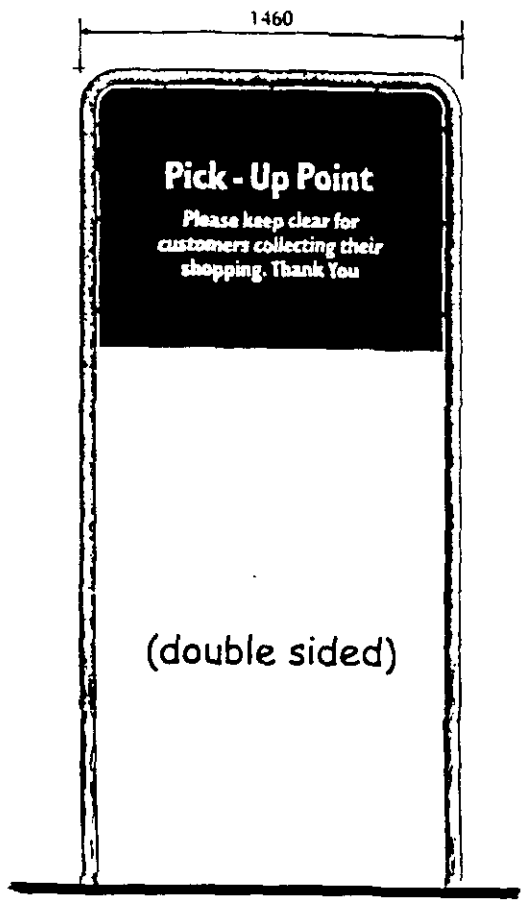

s2 Pick-Up Point

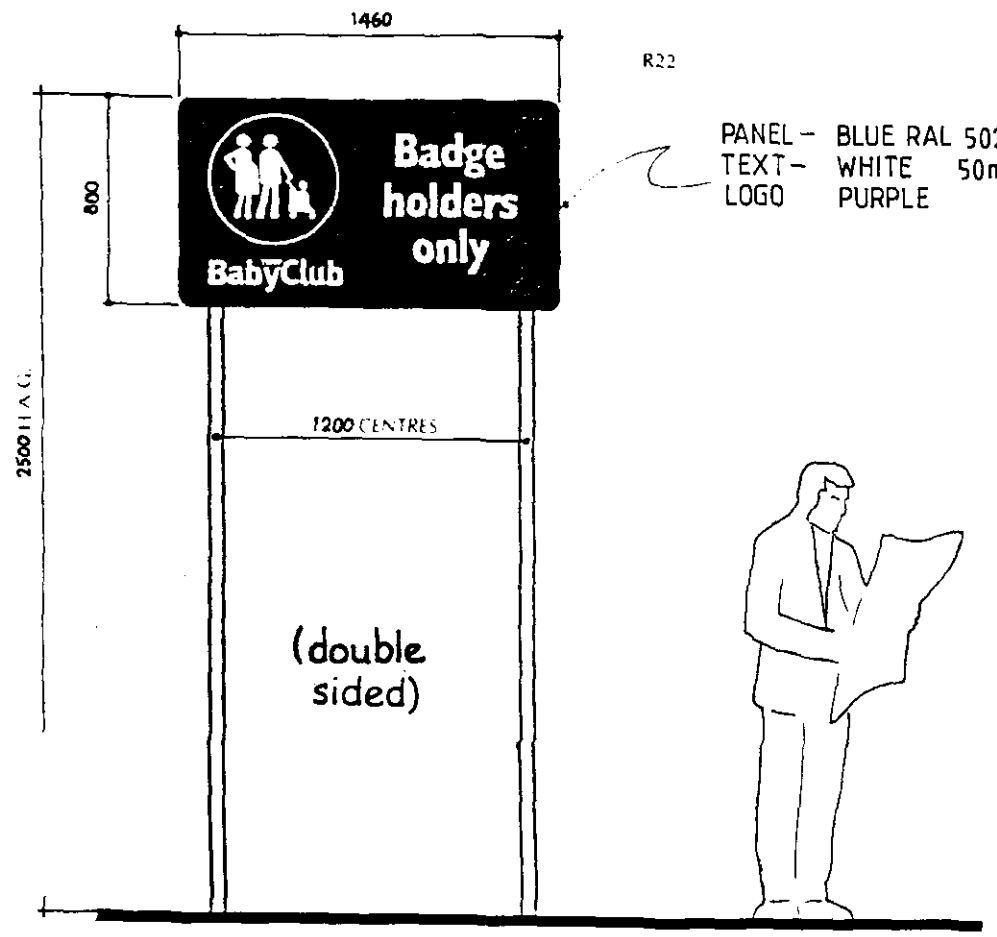

s6 Baby Club Badge holders sign

SIGNS GENERAL s1-5

PANEL - BLUE1 RAL 5022 30% GLOSS
TEXT - WHITE
LOGO - WHITE

HawesSigns
tel +44 (0)1604 760000 fax +44 (0)1604 760193
Moulton Park Northampton United Kingdom NN3 6EL

TESCO

AMENDED PLAN
Ref.
SOUTH HOLLAND D[illegible]
HOUSING & PLAN[illegible]
15 JAN 2001
Ref:

SIR CHARLES NICHOLSON

Tesco Stores Ltd

Proposed Tesco Foodstore
Boston Road, Holbeach

Car Park Signs
read in conjunction
with G.3329 .004/011

n.t.s. 24/11/00

G.3329 .011 .dt

SIGN 1
SINGLE SIDED, NON-ILLUMINATED 3mm THICK KOMACEL
1200 x 805mm, SCALE 1:12
NOTE: THIS SIGN TO BE INSTALLED ABOVE SIGN 2 AS SHOWN






SIGN 2
SINGLE SIDED, NON-ILLUMINATED 3mm THICK KOMACEL
1200 x 805mm, SCALE 1:12
NOTE: THIS PANEL TO BE INSTALLED 2000mm TO U/SIDE FROM GROUND LEVEL

SIGN 3
SINGLE SIDED, NON-ILLUMINATED 3mm THICK KOMACEL
910 x 610mm, SCALE 1:12
NOTE: THIS PANEL TO BE INSTALLED 2000mm TO U/SIDE FROM GROUND LEVEL



SIGN 4
18E53 BLUE
SINGLE SIDED, NON-ILLUMINATED 3mm THICK KOMACEL
910 x 610mm, SCALE 1:12

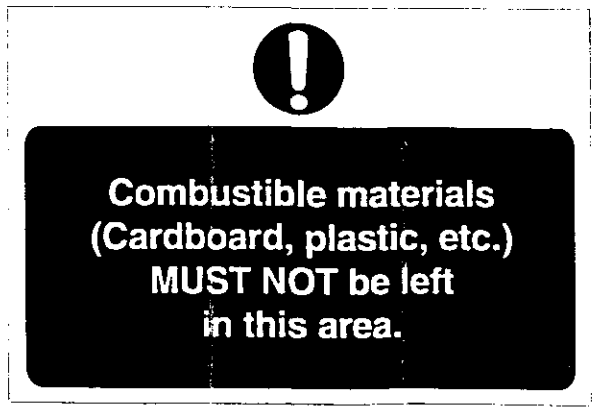

HawesSigns
tel +44 (0)1604 760000 fax +44 (0)1604 760193
Moulton Park Northampton United Kingdom NN3 6EL

TESCO

SOUTH HOLLAND DC
HOUSING & PLANNING
12 DEC 2000
Ref: 1444/cs

SIR CHARLES NICHOLSON GROUP

Tesco Stores Ltd

Proposed Tesco Foodstore
Boston Road, Holbeach

Service Yard Signs
read in conjunction with G.3329 .004

n.t.s. 24/11/00

G.3329 .012