
Do Not Scale

NOTES.

ELEVATION C

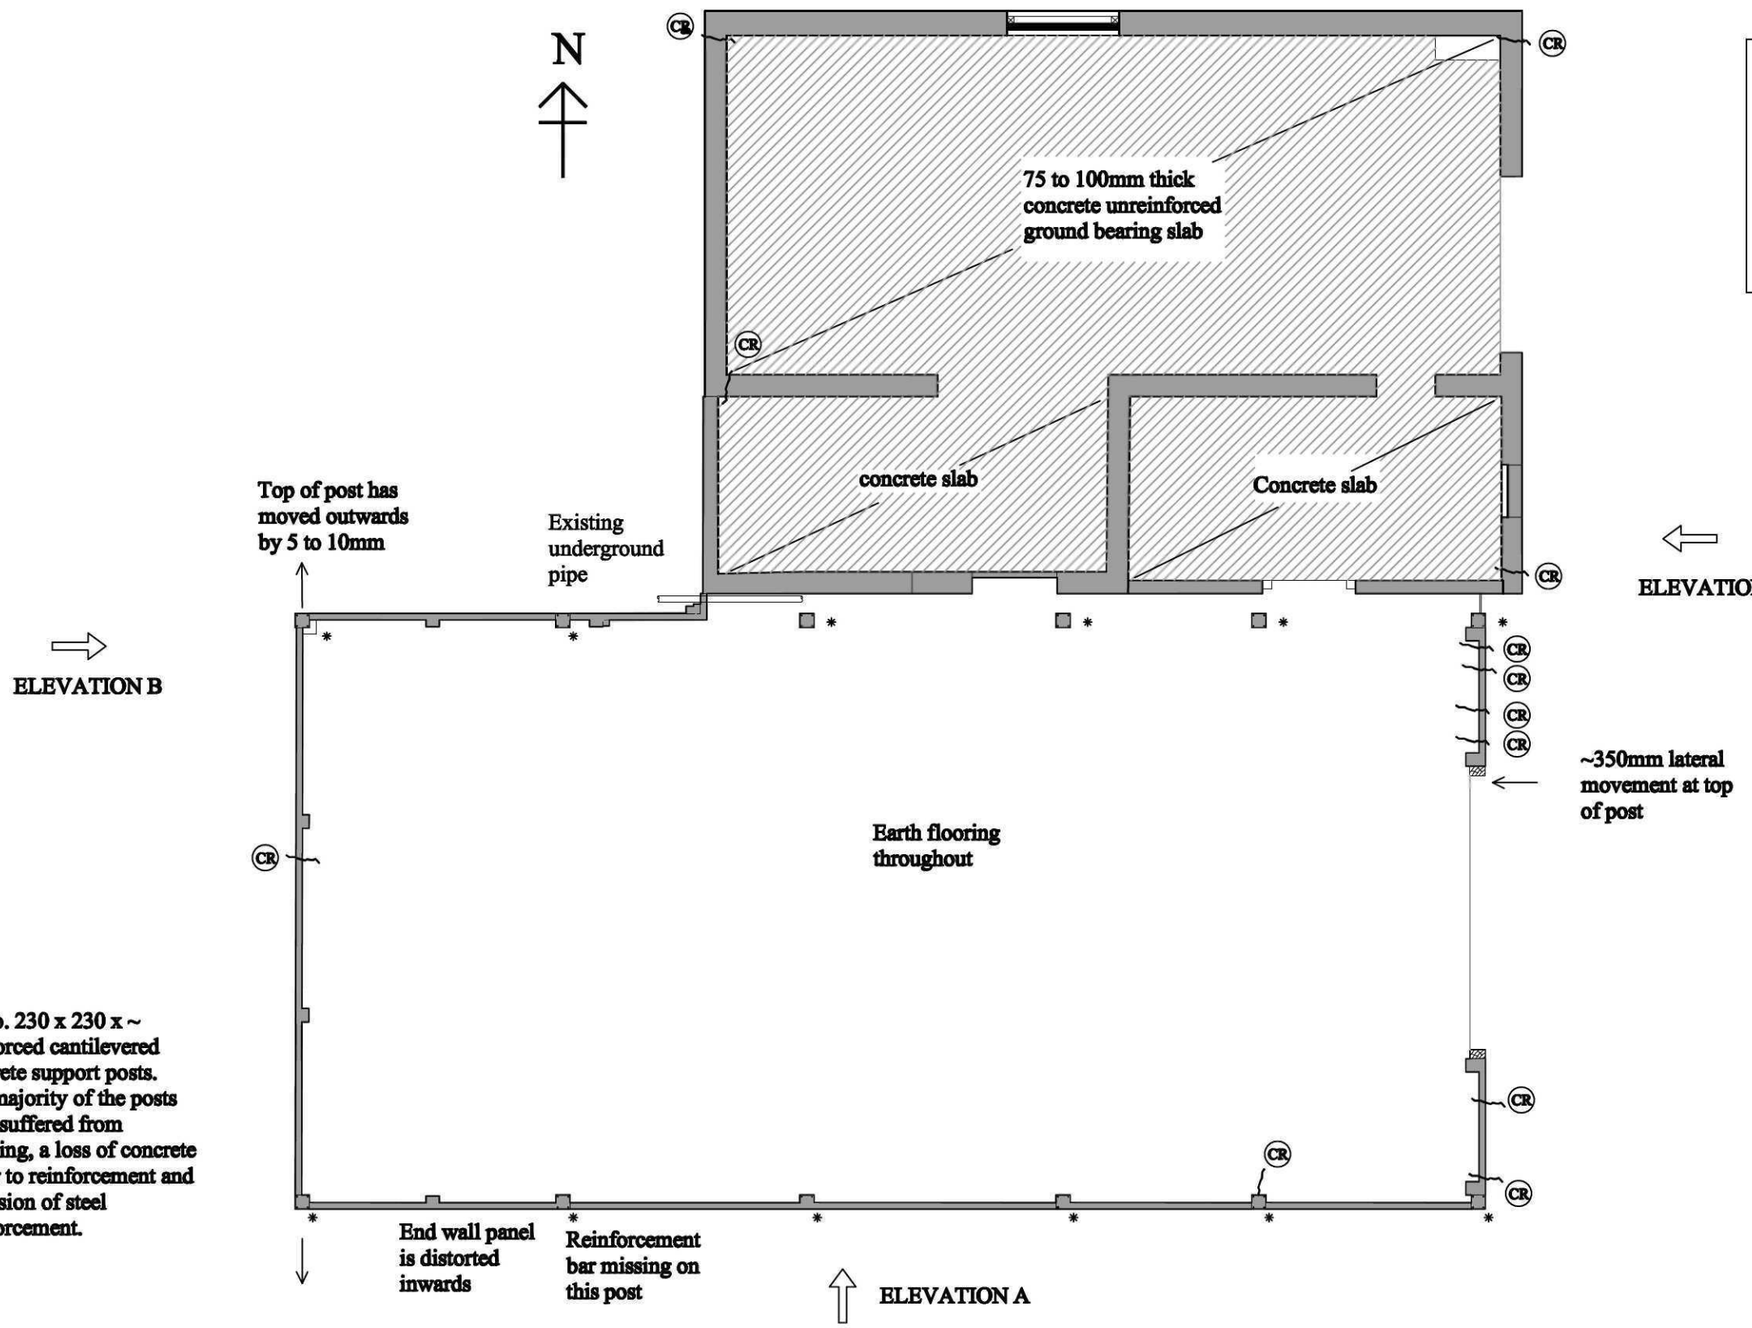

12 No. 230 x 230 x ~ reinforced cantilevered concrete support posts. The majority of the posts have suffered from cracking, a loss of concrete cover to reinforcement and corrosion of steel reinforcement.

GROUND FLOOR PLAN

STRUCTURAL NOTES MARKED UP ON ROBERT DOUGHTY CONSULTANCY LIMITED'S BASE PLANS

FOR DISCUSSION

REV.	DATE	DESCRIPTION	CHKD BY
C	-	-	-
B	-	-	-
A	-	-	-

White s.c. Ltd.

White Structural Consulting Ltd.
Consulting Engineers
1 Park View, Thurlby, Bourne,
Lincolnshire PE10 0EU
Tel: 01778 392666 Fax: 01778 392664
Email: kwhite@whitescltd.com

PROJECT:
HOME FARM
BARN CONVERSION
LITTLE SUTTON

TITLE:
STRUCTURAL OBSERVATIONS
GROUND FLOOR PLAN

SCALE: A3	DATE:	DRAWN BY:	CHECKED BY:
1:100	MAR 2015	K.P.W.	K.P.W.
JOB NO: 529/01	DRAWING NO: 529/01/S011		REVISION NO. —