
Do Not Scale


NOTES.

STRUCTURAL NOTES MARKED UP ON ROBERT DOUGHTY CONSULTANCY LIMITED'S BASE PLANS

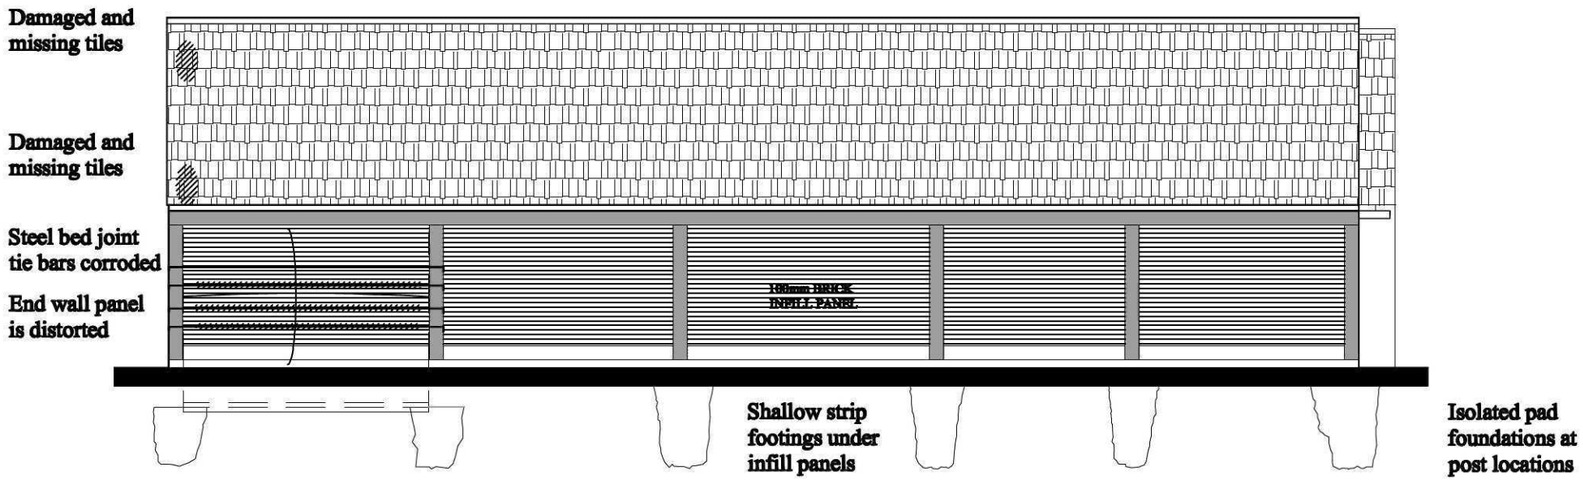

SIDE - SOUTH FACING ELEVATION A

FOR DISCUSSION

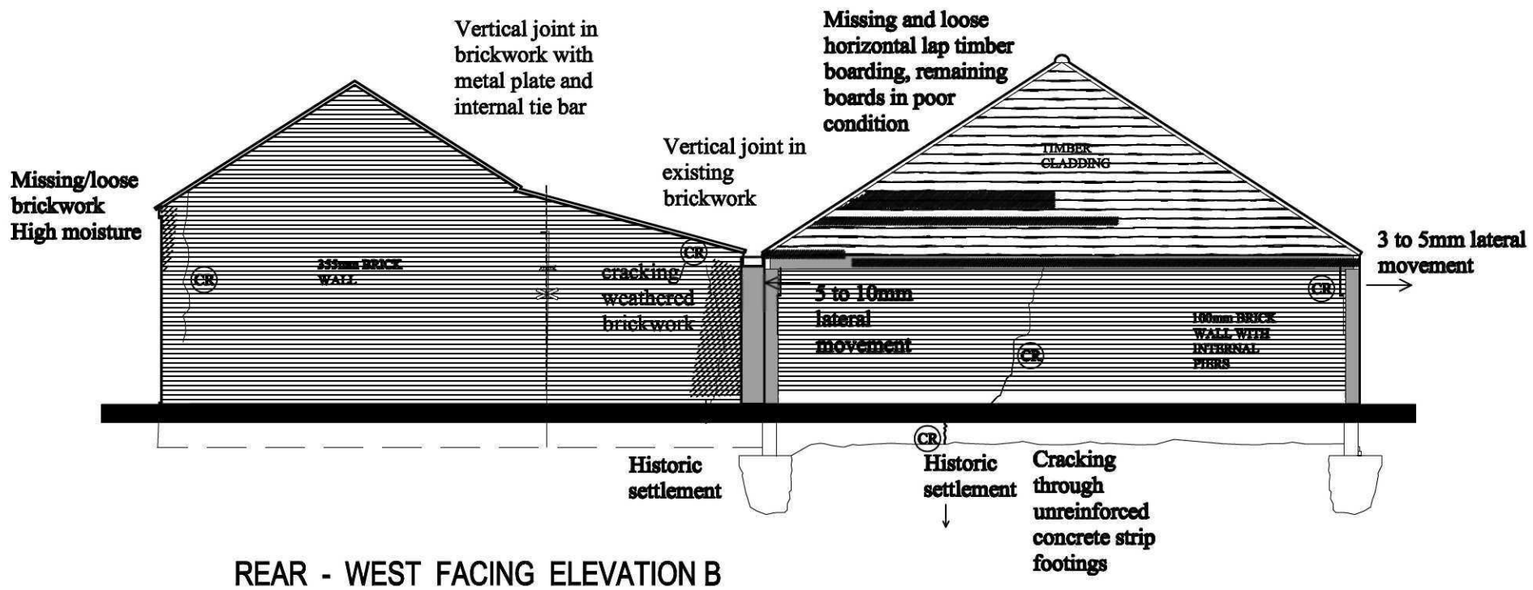

REAR - WEST FACING ELEVATION B

REV.	DATE	DESCRIPTION	CHKD BY
C	-	-	-
B	-	-	-
A	-	-	-

White S.C. Ltd.

White Structural Consulting Ltd.
Consulting Engineers

1 Park View, Thurlby, Bourne,
Lincolnshire PE10 0EU
Tel: 01778 392666 Fax: 01778 392664
Email: kwhite@whitesc ltd.com

PROJECT:

HOME FARM
BARN CONVERSION
LITTLE SUTTON

TITLE:

STRUCTURAL OBSERVATIONS
ELEVATIONS A and B

SCALE: A3	DATE:	DRAWN BY:	CHECKED BY:
1:100	MAR 2015	K.P.W.	K.P.W.

JOB NO:	DRAWING NO:	REVISION NO.
529/01	529/01/S013	—