PLANNING AMENDMENT

For office use only

Application No. H11/0175/02/A1

Date Registered 10-06-02

Case Officer LS

1. Please complete in block letters

NAME AND ADDRESS OF APPLICANT

Mr & Mrs Parker
The Walnuts
29 Wisbech Road
Long Sutton

Tel. No.

NAME AND ADDRESS OF AGENT
(if form completed by agent)

JER Associates
31 Cherryfields
Orton Waterville
Peterborough PE2 5XD

Tel. No. (Contact)

Please complete in block letters

FULL POSTAL ADDRESS OF THE APPLICATION SITE

The Walnuts, 29 Wisbech Road, Long Sutton

Please complete

APPLICATION No.

This amendment **cannot be considered** unless the relevant reference is stated

H11/0175/02

Building Regulation reference relating to same development (if any)

2. Please tick **one** box only

Amendment is proposed where permission already granted — If yes, submit two forms and two plans. — A: ✓

or

Amendment is to a proposal currently being considered — If yes, submit four forms and four plans. — B:

Please complete

I attach the necessary plans and request that the changes described below be accepted as an amendment. I understand that the Council may require a fresh application, together with fee if appropriate. If the amendment relates to a current application, I agree to an extension of the terminal date.

Signed . Gillian Smith . . . . . Date . 13/6/02 . . . . . .

3. Please complete in block letters

FULL DESCRIPTION OF DEVELOPMENT IN ORIGINAL APPLICATION

Occupation of dwelling without complying with agricultural habitation clause (Cond 3 H11/124/86)

State details of amendments proposed

(Give a full detailed list of the changes, and also mark these clearly on the accompanying plans. Only the changes listed here will be considered.)

Site Area

State drawing no's of the current submission

Has this amendment been requested by the Council? (If so, state Officer dealing with the application)

YES / NO — LS

Describe any part of the original development which is excluded by virtue of the amendment, and state any alteration to plot numbers

Has a similar amendment been submitted under Building Regulations? Yes / No

FILE COPY

SOUTH HOLLAND DISTRICT COUNCIL

Chris Simpkins
Chief Executive
Terry Huggins
Director of Customer Services
Bob Atkins
Director of Corporate Services

Application no: H11/0175/02

Original Applicant:
Mr & Mrs Parker
The Walnuts
29 Wisbech Road
Long Sutton
Spalding Lincs PE12 9HE

Original Agent:
JER Associates
31 Cherryfields
Orton Waterville
Peterborough
PE2 5XD

Description: Occupation of dwelling without complying with agricultural habitation clause (Condition 3 of H11/0124/86)

Location: The Walnuts
29 Wisbech Road
Long Sutton

Amendment: Revised site curtilage
JER Associates letter dated 7 June 2002

17-JUN-02

Dear Sir/Madam

TOWN AND COUNTRY PLANNING ACT 1990

NOTICE OF ACCEPTANCE OF AMENDMENT

The amended details submitted in respect of the above proposal have now been considered and there are no objections to the amendment being implemented to the extent described above.


Note: This Notice does not convey any approval under the Building Regulations and you may need to make a new submission.

Yours faithfully

Head of Planning & Development

Council Offices
Priory Road
Spalding
Lincolnshire
PE11 2XE

Telephone: (01775) 761161
Fax: (01775) 711253
Email: Info@sholland.gov.uk

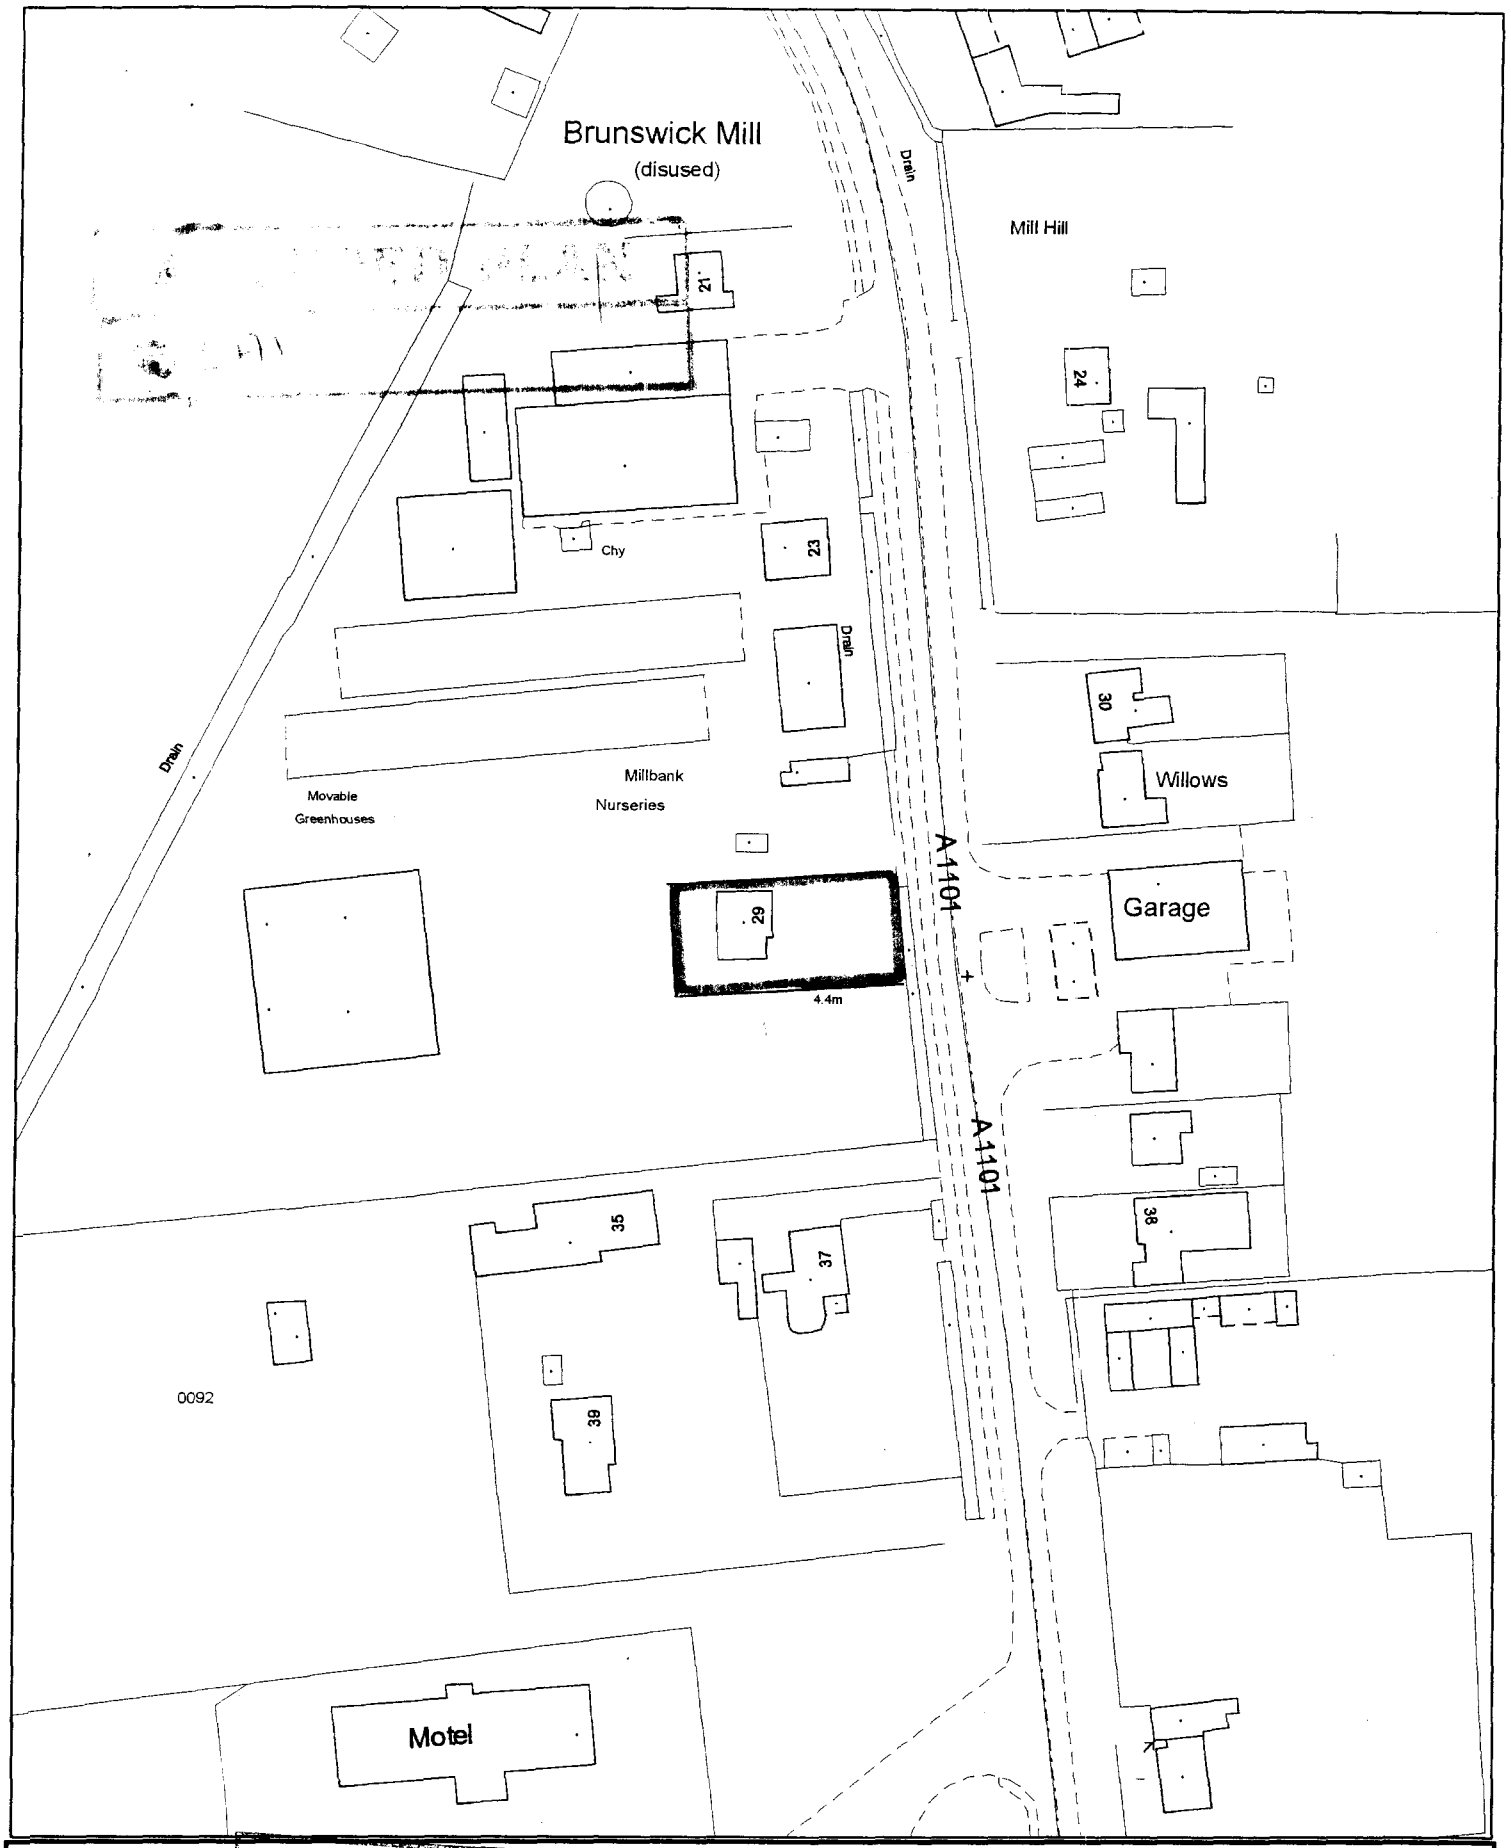

SOUTH HOLLAND DISTRICT COUNCIL

Planning and Development

Council Offices, Priory Road, Spalding, Lincolnshire
PE11 2XE

SHDC
Planning & Development
10 JUN 2002
Ref. C175/ex

Scale: 1:1250

June 2002

This map is reproduced from Ordnance Survey material with permission of Ordnance Survey on behalf of Her Majesty's Stationery Office (c) Crown copyright. Unauthorised reproduction infringes Crown copyright and may lead to prosecution or civil proceedings. South Holland District Council LA079413 2002

AMENDMENT RECORD SHEET - POST DECISION

Admin

Validation:

Inadequate/Inappropriate ☐

Clarification/Details required:

Appears valid ☑

Registered .....

DC Procedural Assessment

Is the information given correct? Yes/No (If No, state above what details are needed)

Is it an amendment in principle? Immaterial/~~Needs new app~~

Confirmed: .....

Give a revised description if the details accepted are different to the submission:

Acceptance issued:

Application Amendments Print

Application H11/0175/02 Location The Walnuts
29 Wisbech Road
Long Sutton

Amendment 1 Date 10-06-2002

Type POS Post-Decision
Sub-Type

Description Revised site ~~location plan~~ curtilage.

Decision Decision Date

JER ASSOCIATES

Planning & Development Consultants

Hamfield House, 31 Cherryfields
Orton Waterville
Peterborough PE2 5XD
Tel/Fax: 01733 231739
Mobile: 078 85 866455

Email:
jerassociates @lineone.net

LAND
10 JUN 2002

Amdt.

07 June 2002

phoned - doesn't really matter as the curtlg relates to the dwelling it self curtilage doesn't really matter. - phoned JER and told him that LMS 11-6-02.

S Williiams Esq
Head of Planning and Development
South Holland District Council
Council Offices
Priory Road
Spalding
Lincs
PE11 2XE

For the attention of Ms Gill Smith

Dear Mr Williams,

RE: CERTIFICATE OF LAWFUL USE OR DEVELOPMENT (REF H11/0175/02)
OCCUPATION OF DWELLING WITHOUT COMPLYING WITH AGRICULTURAL HABITATION CLAUSE (CONDITION NO 3 OF H11/0124/86)
'THE WALNUTS', 29 WISBECH ROAD, LONG SUTTON, SPALDING, PE12 9AG

I refer to our telephone conversation today regarding the above Certificate granted on 10 May 2002.

As discussed it has become apparent that the approved Site Location Plan does not correspond with the Site Plan held by HM Land Registry. Copies of each plan are enclosed for your information.


Accordingly I would be glad if you would revise this plan as a minor amendment to the approval.

Yours sincerely,

JOHN E RATCLIFFE

Gill, can you do this as an amendment for me please

TC1 (L).

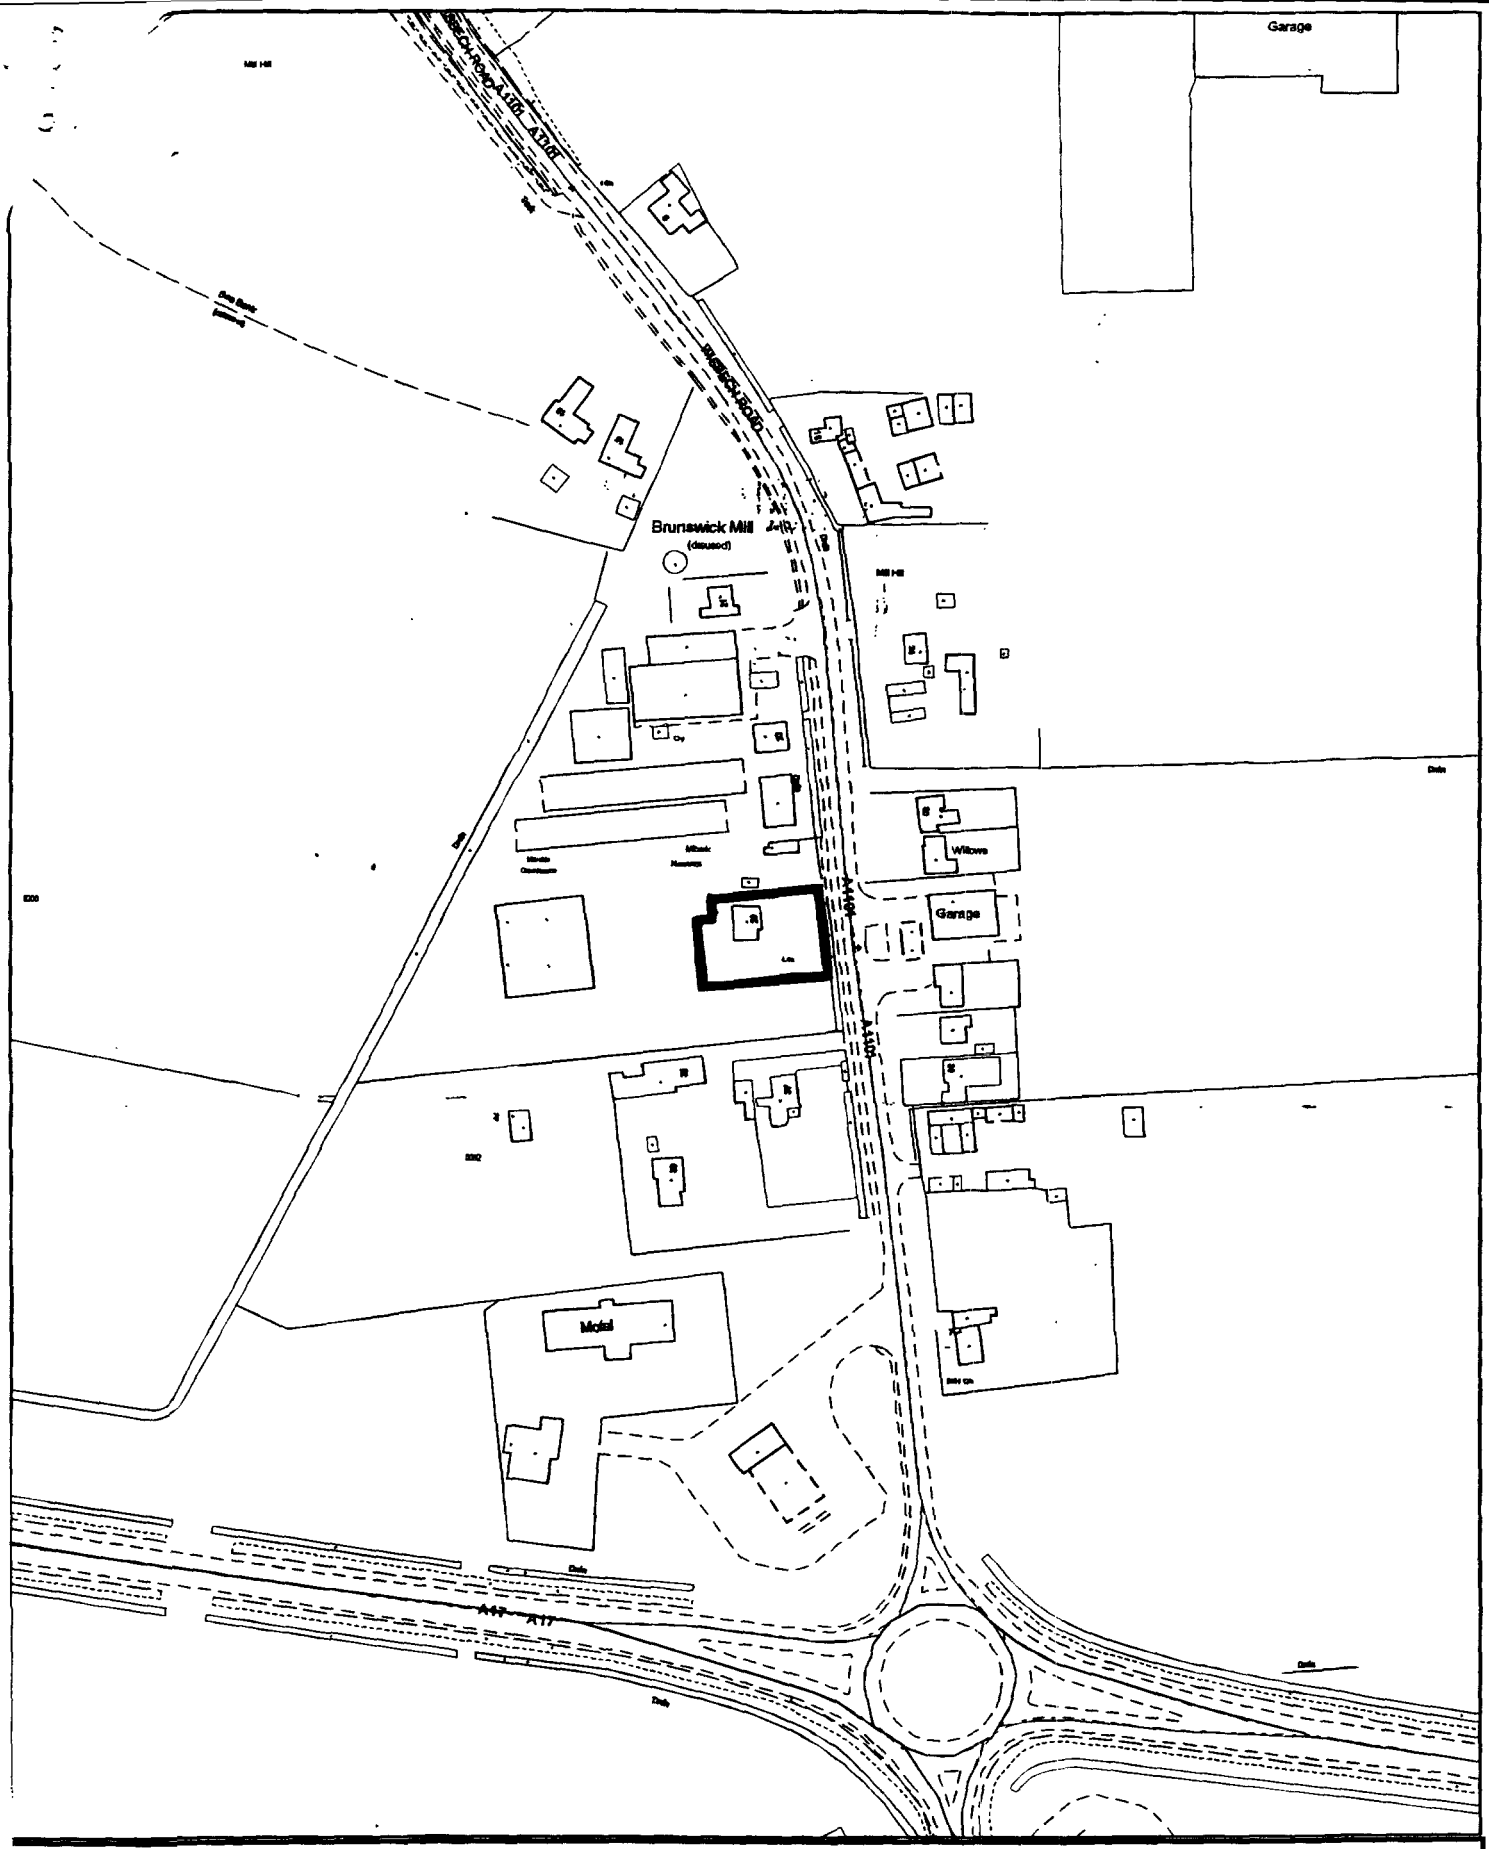

SOUTH HOLLAND DISTRICT COUNCIL

Planning and Development

Council Offices, Priory Road, Spalding, Lincolnshire
PE11 2XE

Scale: 1:2500

May 2002

This map is reproduced from Ordnance Survey material with permission of Ordnance Survey on behalf of Her Majesty's Stationery Office (c) Crown copyright. Unauthorised reproduction infringes Crown copyright and may lead to prosecution or civil proceedings. South Holland District Council LA079413 2002

:328

ircus,

Register.

TITLE NUMBER

LL182328


LINCOLNSHIRE : SOUTH HOLLAND

N

ONANCE SURVEY MAP REFERENCE: TF4422SW

SCALE 1:1250 Enlarged from 1/2500

OWN COPYRIGHT. Produced by HMLR. Further reproduction in whole or in part is prohibited without the prior written permission of Ordnance Survey. Licence Number GD 272728.

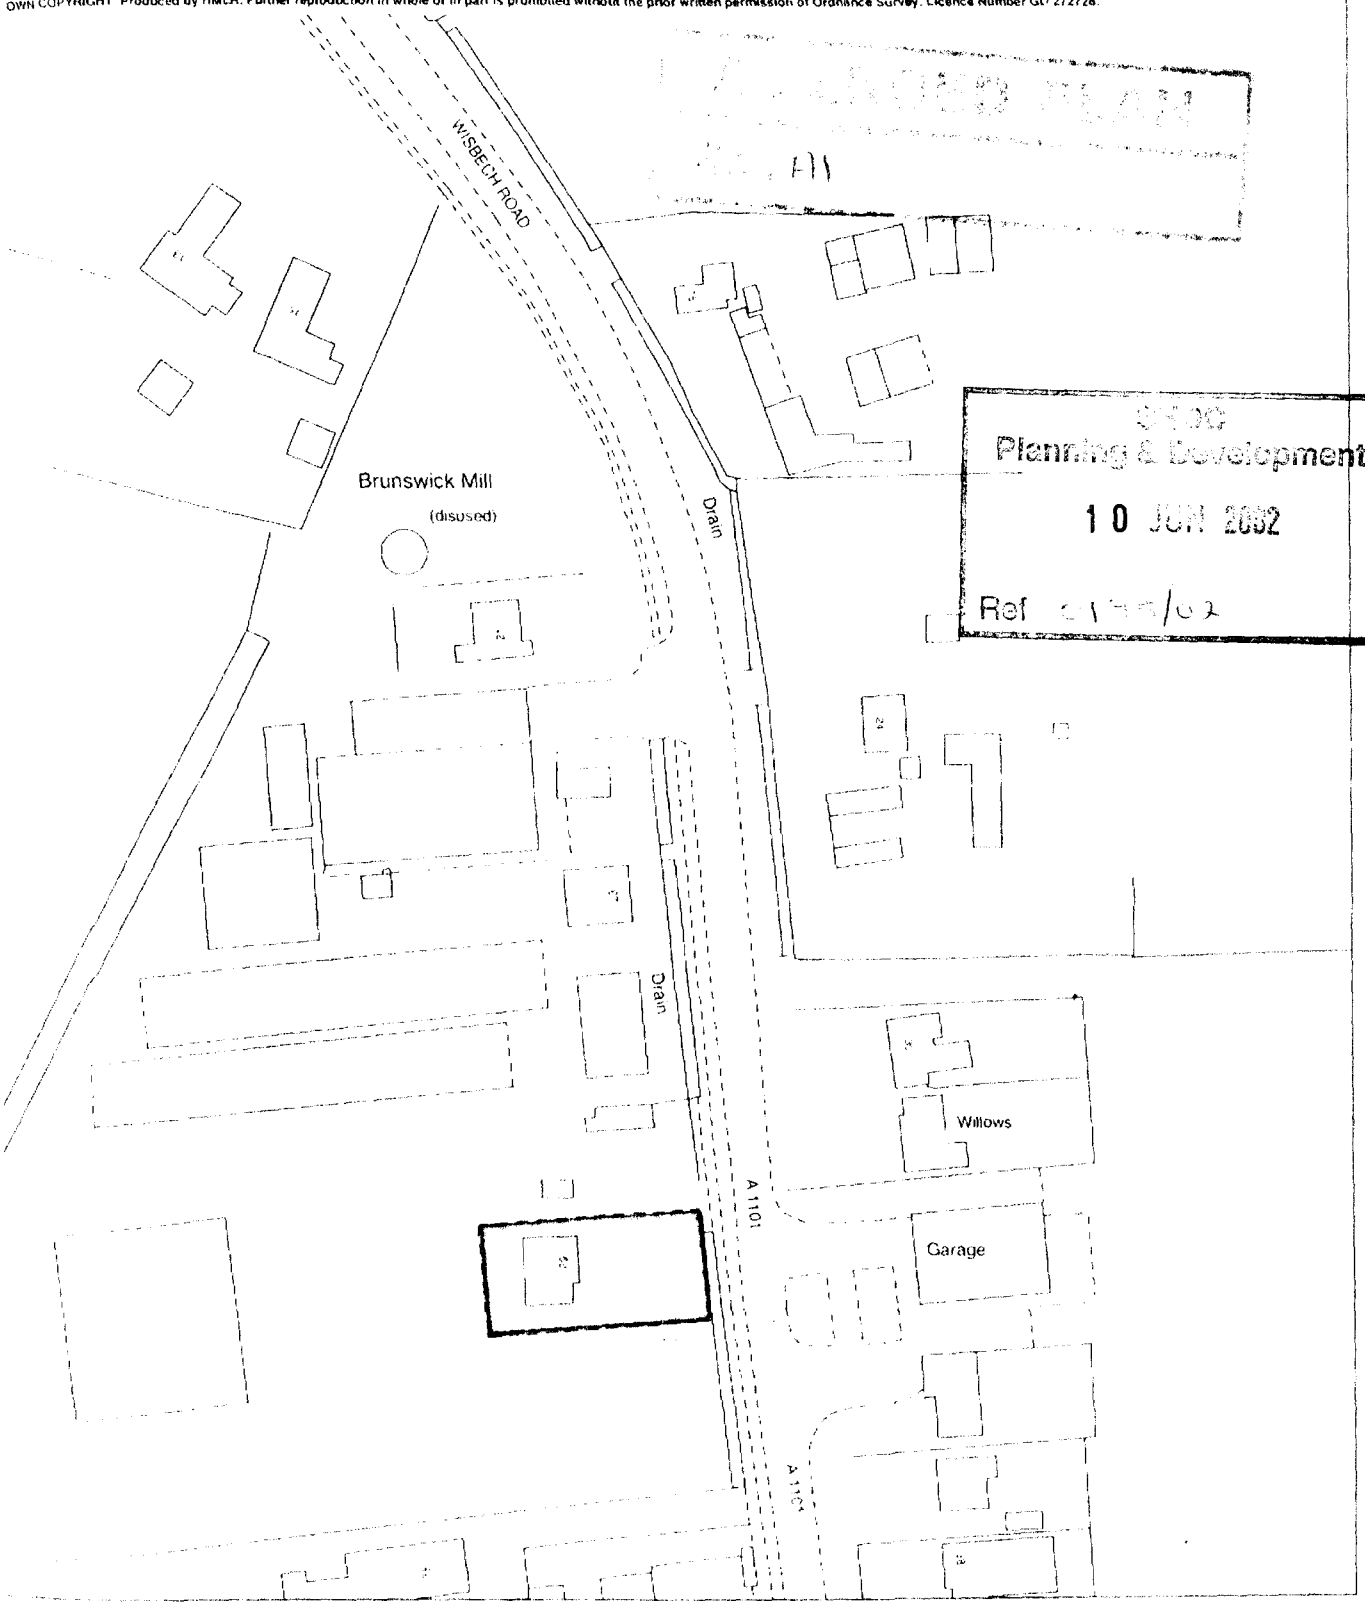

Planning & Development
10 JUN 2002
Ref

H.M. Land Registry
5/2002