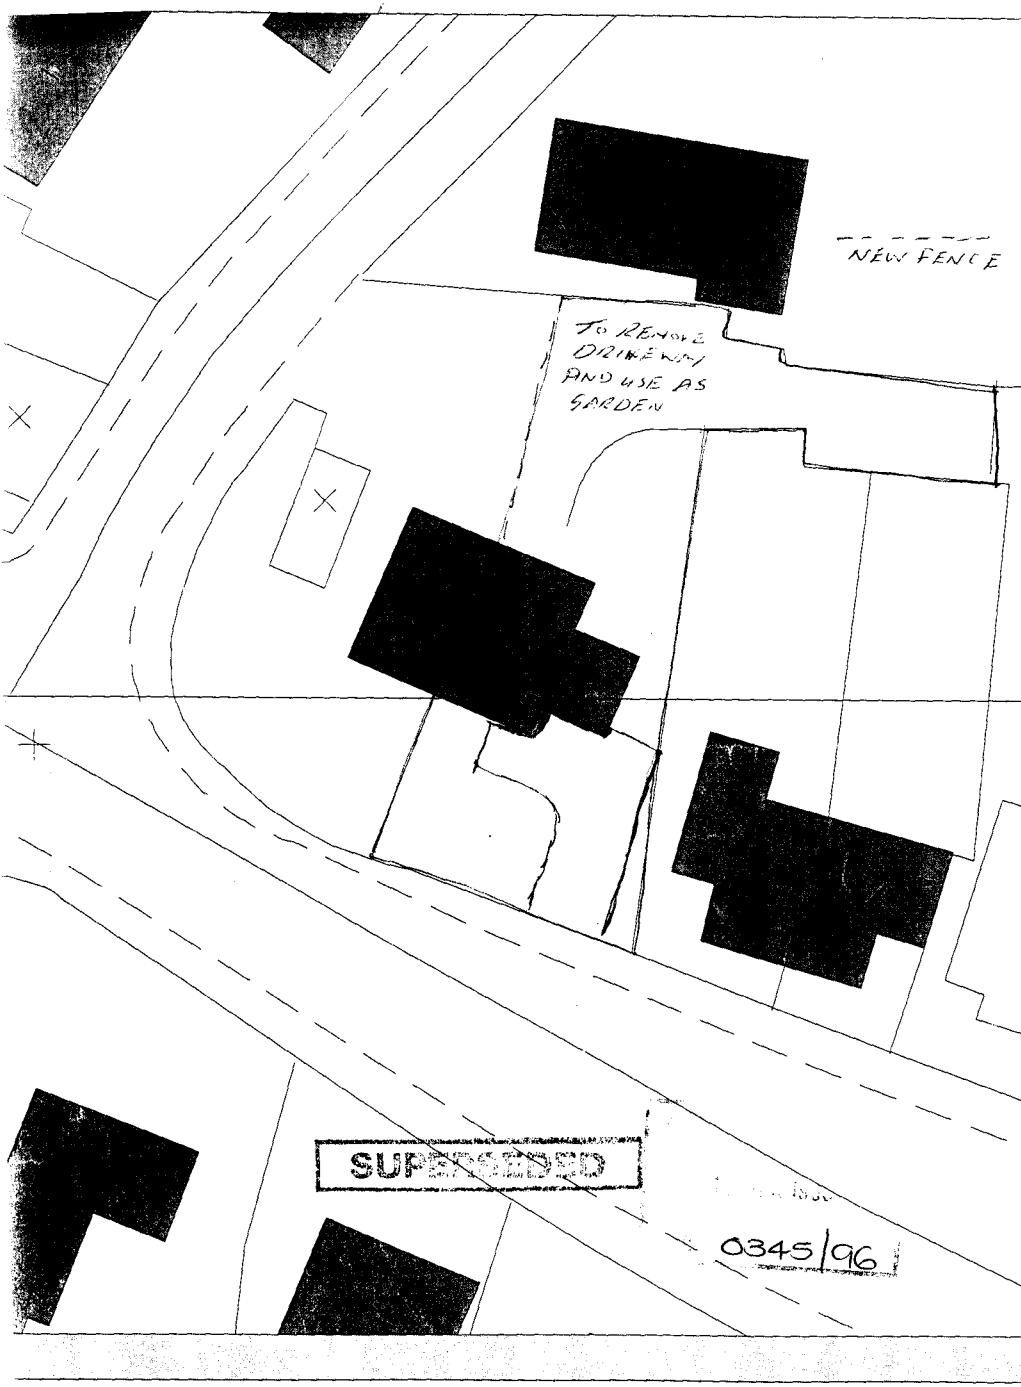
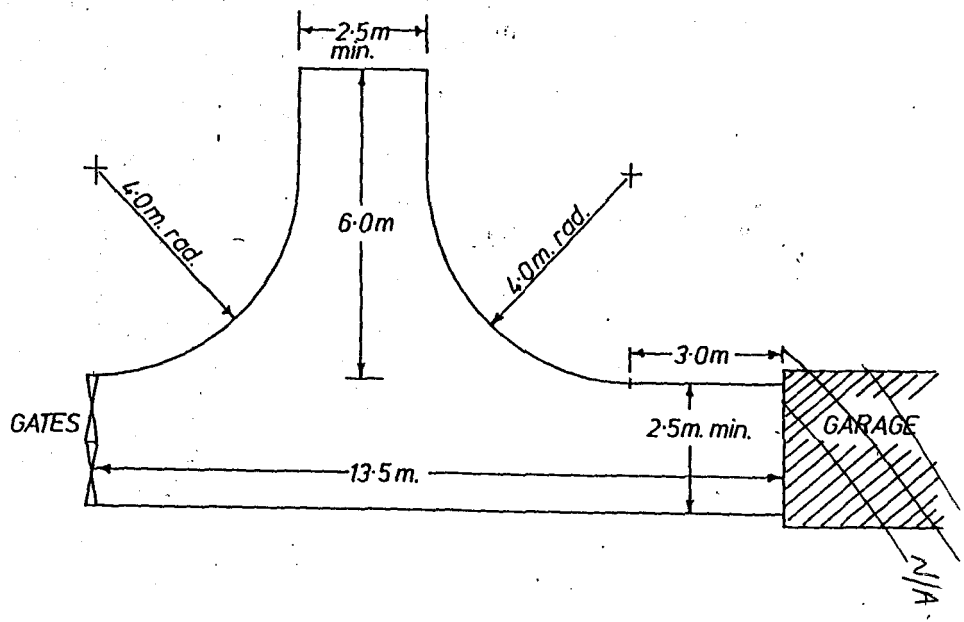

NEW FENCE
TO REMOVE DRIVEWAY AND USE AS GARDEN
SUPERSEDED
0345/96

1:250



DETAIL OF DOMESTIC TURNING SPACE.

SCALE....1:100

PLANNING AMENDMENT

For office use only
Application No. H11/0345/96.
Date Registered 23 MAY 1996
Case Officer DG.

1. Please complete in block letters
NAME AND ADDRESS OF APPLICANT
MR.D & MRS S.M.LEE
79 LONDON ROAD
LONG SUTTON
SPALDING
LINCS PE12 9EE
Tel. No. (01406) 363988

NAME AND ADDRESS OF AGENT
(if form completed by agent)
MR.D & MRS S.M.LEE
79 LONDON ROAD
LONG SUTTON
SPALDING
LINCS PE12 9EE
Tel. No. (Contact)

Please complete in block letters
FULL POSTAL ADDRESS OF THE APPLICATION SITE
79 LONDON ROAD, LONG SUTTON, SPALDING, LINCS. PE12 9EE

Please complete
APPLICATION No.
This amendment cannot be considered unless the relevant reference is stated
H11/0345/96

OFFICE COPY

Building Regulation reference relating to same development (if any)
N/A

2. Please tick one box only
Amendment is proposed where permission already granted — A [ ]
If yes, submit two forms and two plans.
or
Amendment is to a proposal currently being considered — B [✓]
If yes, submit four forms and four plans.

Please complete
I attach the necessary plans and request that the changes described below be accepted as an amendment. I understand that the Council may require a fresh application, together with fee if appropriate. If the amendment relates to a current application, I agree to an extension of the terminal date.
Signed ..... Date 22ND MAY 1996.....

3. Please complete in block letters **FULL DESCRIPTION OF DEVELOPMENT IN ORIGINAL APPLICATION**	NEW VEHICULAR ACCESS
State details of amendments proposed (Give a full detailed list of the changes, and also mark these clearly on the accompanying plans. Only the changes listed here will be considered.)	TO MOVE TURNING AREA RELOCATE FURTHER FROM DWELLING
State drawing no's of the current submission	THREE
Has this amendment been requested by the Council? (If so, state Officer dealing with the application)	YES / ~~NO~~ MR D GEDNEY
Describe any part of the original development which is excluded by virtue of the amendment, and state any alteration to plot numbers	NONE

Has a similar amendment been submitted under Building Regulations? ~~Yes~~ / No

MRS SALLY WALTHAM BA (Hons) F.C.I.H. Director of Housing & Planning Services

Housi[illegible] Planning Services Department
Council Offices,
Priory Road, Spalding,
Lincolnshire. PE11 2XE

Telephone: (01775) 761161
Fax: (01775) 710772

FILE COPY

SOUTH HOLLAND DISTRICT COUNCIL
HOUSING & PLANNING SERVICES DEPARTMENT

Application No: H11/0345/96 Date Received: 17-APR-96

Applicant: Mr D & Mrs S M Lee
79 London Road
Long Sutton
Spalding
Lincs

Agent: Mr D & Mrs S M Lee
79 London Road
Long Sutton
Spalding
Lincs

Description of Original Development: New vehicular access

Location: 79 London Road, Long Sutton

Amendment Submitted: Move turning area, relocated further from dwelling (drawing no. 'Three')

31 May 1996

Dear Sir/Madam

ACKNOWLEDGEMENT OF AMENDMENT

I acknowledge receipt of the amended details in respect of the above proposal. These have been incorporated into the application which will now only be considered in its amended form.

The terminal date for dealing with the application has now been extended to 18 July 1996, based on the date of receipt of the amendment, and your rights of appeal remain as explained on the original acknowledgement.

You are reminded that revision to any submission made under the Building Regulations may also be necessary.

Yours faithfully

Director of Housing and Planning Services

AMENDMENT RECORD SHEET – LIVE APPLICATION

Admin

Validation:

Inadequate/Inappropriate ☐

Clarification/Details required:

Appears valid ☑ HL

Registered 24/5

Terminal date/committee updated 18/7/96

DC Procedural Assessment

Is the information given correct? Yes/~~No~~ (If No, state above what details are needed)

Has this amendment been requested? Yes/~~No~~ *

If Yes, is it what was asked for? Yes/~~No~~ *

Who do you need to reconsult as a result of this amendment? PC None ☑
WM
Press
Residents
Other –

Is it an amendment in principle? Yes/~~No~~

Is it the same character/description for fee purposes? Yes/~~No~~ (Refer to Admin ?) *

If No, but Yes to (*) requested :-

Do development objectives outweigh financial objectives? Yes/No Confirmed.....

REJECTED as an amendment – new application needed

Confirmed: .....

Notes/Advice/Rejection Reason:

☐ Tick if you wish this note to be a paragraph in the Rejection Notice

AUTHORISED to treat as amendment

Confirmed: DMG 29/5

Superseded details removed ☐

Give a revised description if the details accepted are different to the submission:

Acceptance issued: ✓

Public register updated: 31/5

DC Professional Assessment

NOTES:

FILE COPY

Mr D & Mrs S M Lee,
79 London Road,
Long Sutton,
Spalding,
Lincs.
PE12 9EE.

Mr K Woods

SAW/NRM/JJ
H11/0345/96

22 May 1996

Dear Sir and Madam,

PLANNING APPLICATION H11/0345/96 - NEW VEHICULAR ACCESS, 79 LONDON ROAD, LONG SUTTON.

Thank you for the amended plan in respect of the above.

Unfortunately, the County Highways Authority still consider that the turning space as shown is inadequate to allow a vehicle to easily manoeuvre in and out of the site in forward gear. However, they have provided a copy of a 1:200 plan showing a turning facility that they consider more acceptable (copy enclosed).

If you consider the amended plan to be acceptable, please complete and return 4 copies of the enclosed amendment form and 4 copies of the 1:200 plan.

I look forward to your response in respect of the above within the next 10 days, so that I am in a position to proceed with the application.

Yours faithfully

N Midlen
Development Control Manager

Enc.