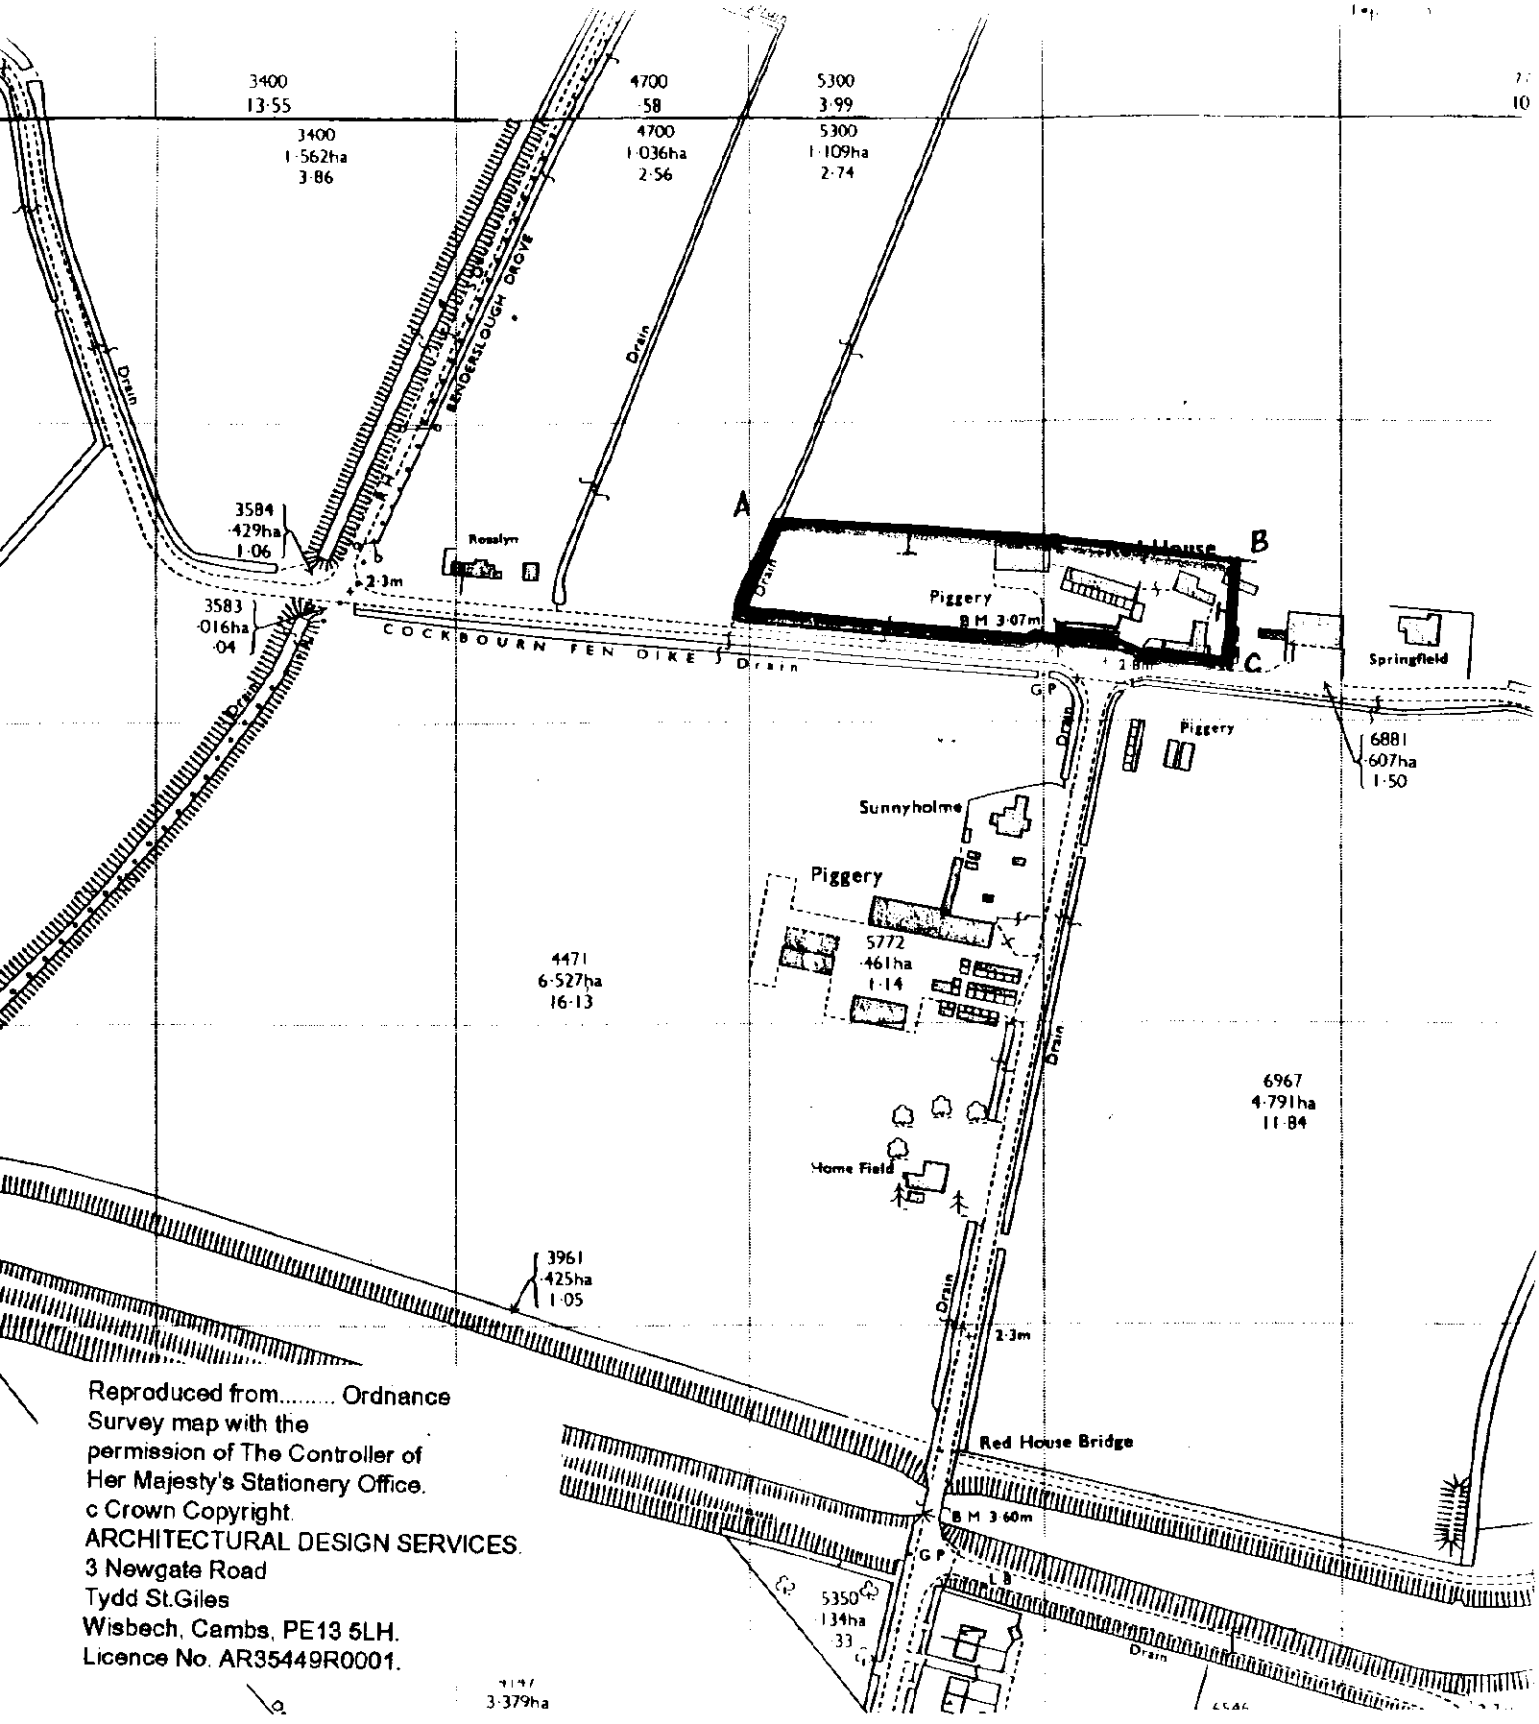



Reproduced from..... Ordnance Survey map with the permission of The Controller of Her Majesty's Stationery Office. c Crown Copyright.

ARCHITECTURAL DESIGN SERVICES.
3 Newgate Road
Tydd St.Giles
Wisbech, Cambs, PE13 5LH.
Licence No. AR35449R0001.

DETERMINED PLAN

Dec: 0948/00

Red line amended with consent

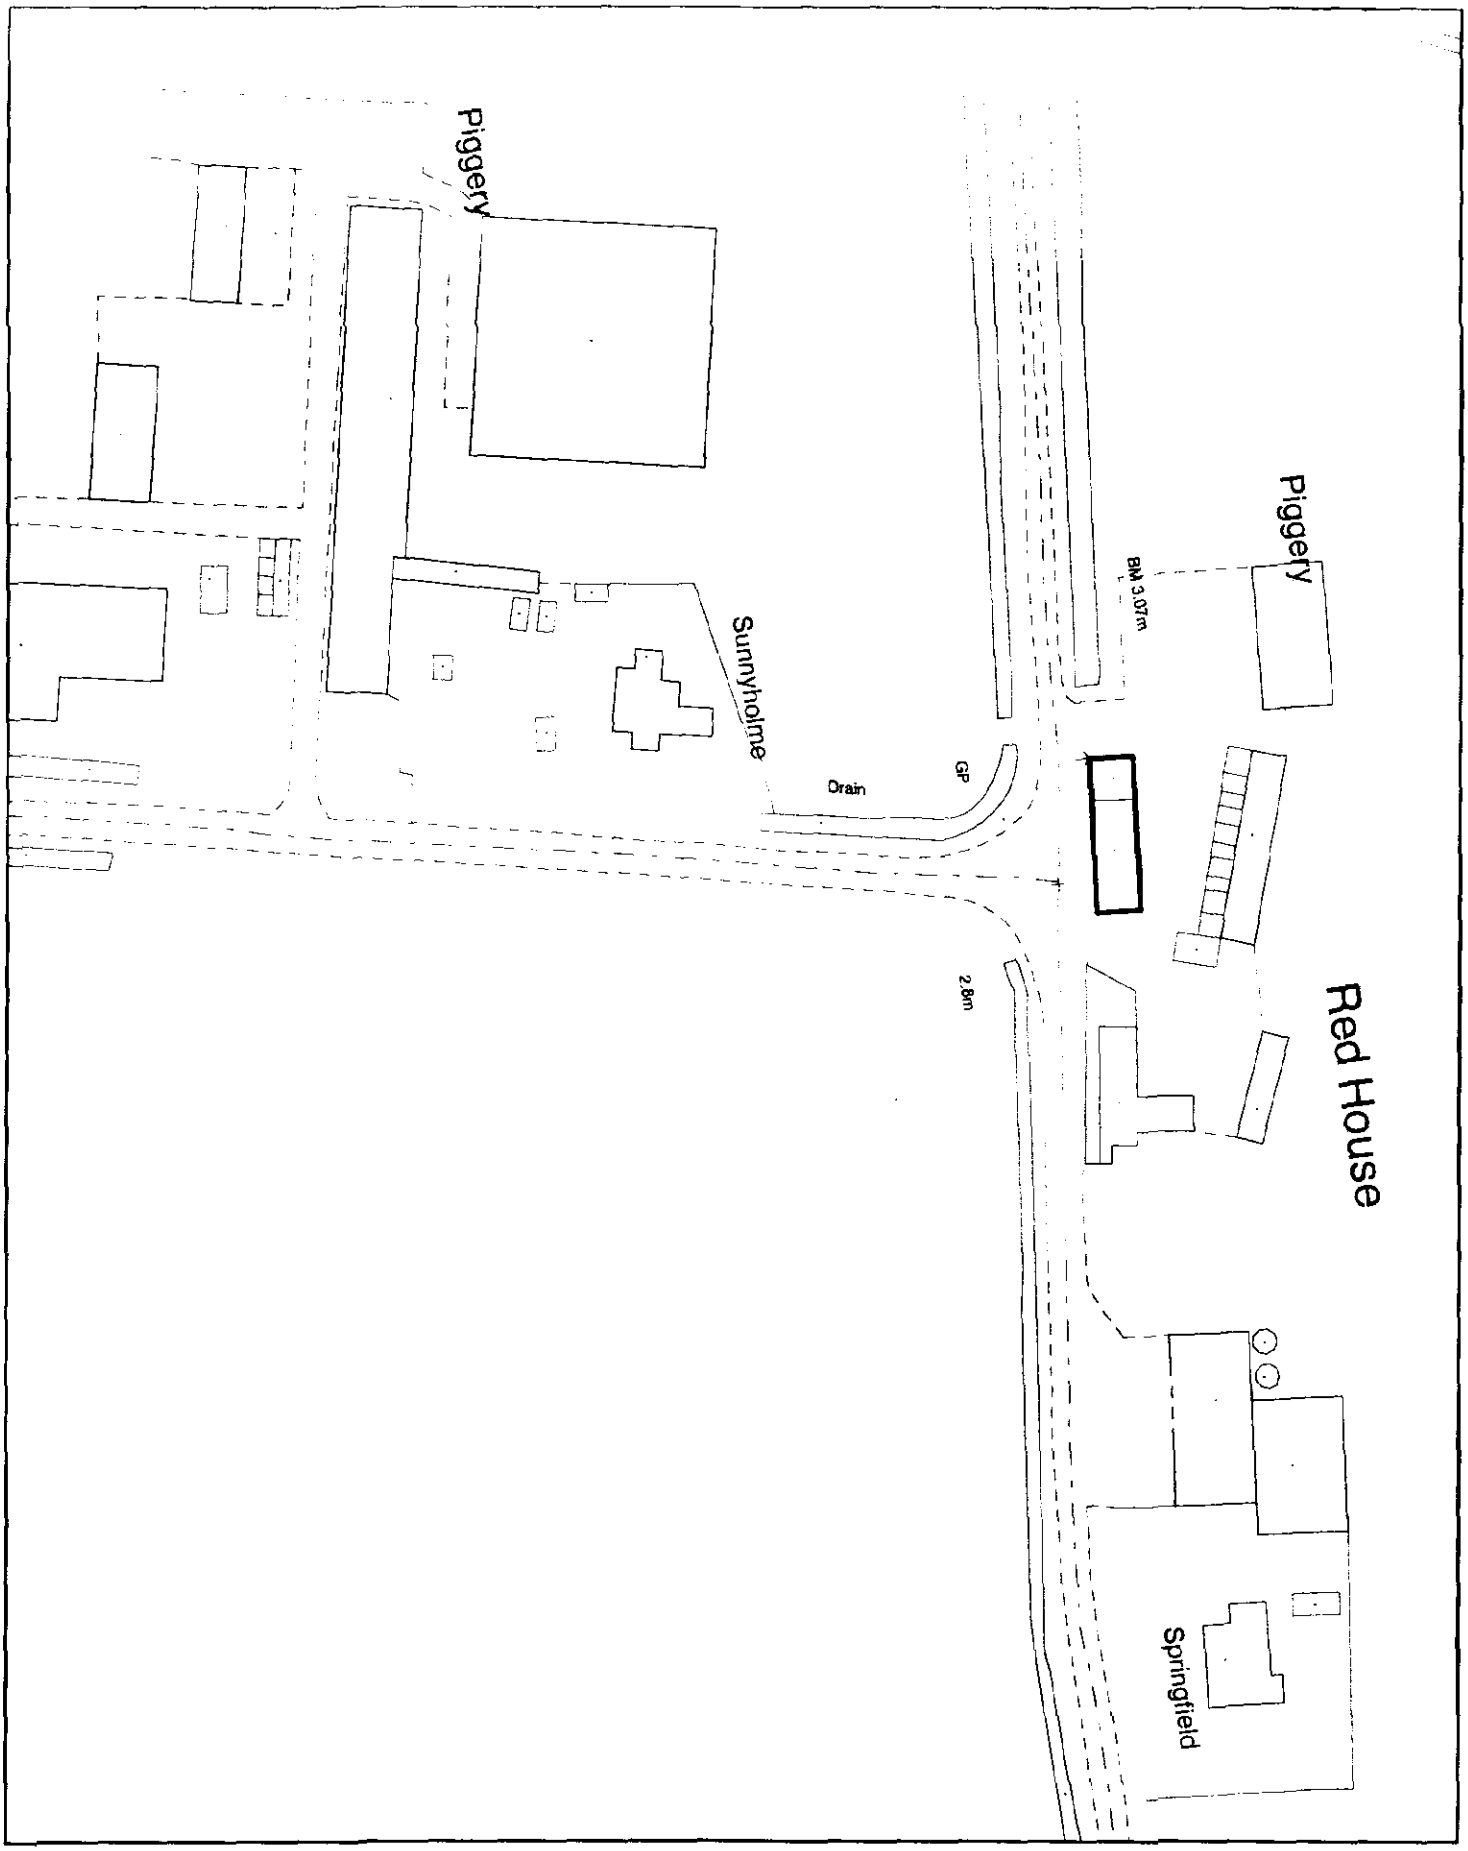

SOUTH HOLLAND DISTRICT COUNCIL

Planning Application Location Plan
Ward Member Notification

H11/0948/00

FILE COPY

Scale: 1:1000

Housing and Planning Services Department

Council Offices, Priory Road, Spalding, Lincolnshire
PE11 2XE

PLEASE DO NOT COPY THIS PLAN
This map is reproduced from Ordnance Survey material with permission of Ordnance Survey on behalf of Her Majesty's Stationery Office (c) Crown copyright. Unauthorised reproduction infringes Crown copyright and may lead to prosecution or civil proceedings. South Holland District Council LA079413 2000