PLANNING AMENDMENT

For office use only
Application No. H11/0948/00
Date Registered 21 SEP 2000
Case Officer DG

1. Please complete in block letters
NAME AND ADDRESS OF APPLICANT

mr m G Godfrey
83 Westgate
Hunstanton
Norfolk
Tel. No.

NAME AND ADDRESS OF AGENT
(if form completed by agent)
Arch. Design Serv
Tel. No. (Contact)

OFFICE COPY

Please complete in block letters
FULL POSTAL ADDRESS OF THE APPLICATION SITE

Red House, Jarvis Gate, SSJ

Please complete
APPLICATION No.
This amendment **cannot be considered** unless the relevant reference is stated

H11/0948/00

Building Regulation reference relating to same development (if any)

2. Please tick **one** box only

A ☐ Amendment is proposed where permission already granted
If yes, submit two forms and two plans.

or

B ☑ Amendment is to a proposal currently being considered
If yes, submit four forms and four plans.

Please complete
I attach the necessary plans and request that the changes described below be accepted as an amendment. I understand that the Council may require a fresh application, together with fee if appropriate. If the amendment relates to a current application, I agree to an extension of the terminal date.

Signed ..... Date .....

3. Please complete in block letters
FULL DESCRIPTION OF DEVELOPMENT IN ORIGINAL APPLICATION

Barn conversion to Residential

State details of amendments proposed

(Give a full detailed list of the changes, and also mark these clearly on the accompanying plans. Only the changes listed here will be considered.)

See Letter.

State drawing no's of the current submission

Has this amendment been requested by the Council? (If so, state Officer dealing with the application)

YES / NO

Describe any part of the original development which is excluded by virtue of the amendment, and state any alteration to plot numbers

Has a similar amendment been submitted under Building Regulations? Yes / No

SALLY WALTHAM
BA (Hons) F.C.I.H.
Director of Housing & Planning Services

Housing and Planning
Services Department,
Council Offices,
Priory Road,
Spalding,
Lincolnshire. PE11 2XE

Telephone: (01775) 761161
Fax: (01775) 710772

FILE COPY

SOUTH HOLLAND DISTRICT COUNCIL
HOUSING & PLANNING SERVICES DEPARTMENT

Application no: H11/0948/00

Applicant: Mr M G Godfrey
83 Westgate Road
Hunstanton
Norfolk
PE36 5EP

Agent:
Architectural Design Services
3 Newgate Road
Tydd St. Giles
Wisbech
PE13 5LH

Description: Proposed conversion of barn to form additional residential accommodation

Location: Red House
Jarvis Gate
Sutton St. James
Lincs

Amendment: Alterations to fenestration

28-SEP-00

Dear Sir/Madam

ACKNOWLEDGEMENT OF AMENDMENT

I acknowledge receipt of the amended details in respect of the above and confirm that the changes are able to be incorporated in the application which will now **only be considered in its amended form**.

As a result of the need for the Authority to repeat certain procedures because of the amendment, the period for determining the application has been extended to 16 NOV 2000

Your rights of appeal remain as explained on the original acknowledgement.
If you do not wish to agree to the extended time period and would rather have the application determined more quickly but on the basis of the application as originally submitted, please let me know in writing within the next 5 days.

You are reminded that revision to any submission made under the Building Regulations may also be necessary.

Yours faithfully

Director of Housing and Planning Services

AMENDMENT RECORD SHEET – LIVE APPLICATION

Admin

Validation:

Inadequate/Inappropriate ☐

Clarification/Details required:

Appears valid ☑ 26/9.

Registered .....

Terminal date/committee updated ..... 16/Nov 28/9.

DC Procedural Assessment

Is the information given correct? Yes/~~No~~ (If No, state above what details are needed)

Has this amendment been requested? Yes/~~No~~ *

If Yes, is it what was asked for? Yes/~~No~~ *

Who do you need to reconsult as a result of this amendment? None ☑

PC
WM
Press
Residents
Other –

Is it an amendment in principle? Yes/~~No~~

Is it the same character/description for fee purposes? Yes/~~No~~ (Refer to Admin ?) *

If No, but Yes to (*) requested :–

Do development objectives outweigh financial objectives? Yes/No Confirmed.....

REJECTED as an amendment – new application needed

Confirmed: .....

Notes/Advice/Rejection Reason:

☐ Tick if you wish this note to be a paragraph in the Rejection Notice

AUTHORISED to treat as amendment

Confirmed: DMC 26/9.

Superseded details removed ☐

Give a revised description if the details accepted are different to the submission:

~~Erection~~ Alteration to fenestration ✓

Acceptance issued:

Public register updated: 28/9.

DC Professional Assessment


NOTES:

ARCHITECTURAL

DESIGN SERVICES

3 Newgate Road,
Tydd St Giles,
Wisbech
Cambridgeshire
PE13 5LH

Telephone
01945 870022

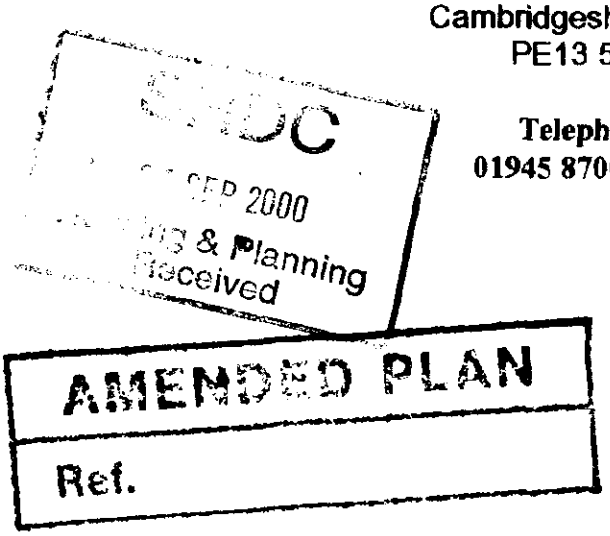

Mr.D.Gedney
Director of Planning & Building Control,
South Holland District Council,
Council Offices,
Priory Road,
Spalding,
PE11 2XE

11th September 2000

Dear Sir

REF: PROPOSED CONVERSION OF BARN TO FORM ADDITIONAL RESIDENTIAL ACCOMMODATION AT RED HOUSE, JARVIS GATE, SUTTON ST. JAMES.
FOR. M.G.GODFREY.
Ref: H11/0948/00 & H11/0949/00.

Following our recent telephone conversation regarding the above Development and your letter dated 30th August 2000 I enclose revised plans to cover the amendments.

I also make the following points on the comments:-

1. Details of eaves and doors/windows added to plans. These are basic details as no major details are envisaged.

2.The windows have been amended and my Client is in agreement to stain windows and doors.

3. This Building will be an annexe to the main dwelling and used in connection with Red House.

I trust these details are in order to allow the Application to proceed further.

Yours faithfully
ARCHITECTURAL DESIGN SERVICES

Stephen Thrower

S J Thrower

PLANNING AMENDMENT

For office use only

Application No. H11/0948/00

Date Registered 23 MAR 2001

Case Officer BMG

1. Please complete in block letters

NAME AND ADDRESS OF APPLICANT

mr m g Godfrey
83 Westgate Rd
Hunstanton

Tel. No.

NAME AND ADDRESS OF AGENT
(if form completed by agent)

Architectural
Design Services

Tel. No. (Contact)

Please complete in block letters

FULL POSTAL ADDRESS OF THE APPLICATION SITE

Red House, Jarvis Gate, SSJ

Please complete

APPLICATION No.

This amendment **cannot be considered** unless the relevant reference is stated

~~H11/0948/00~~
H11/0949/00

Building Regulation reference relating to same development (if any)

2. Please tick one box only

Amendment is proposed where permission already granted — If yes, submit two forms and two plans. — A [ ]

or

Amendment is to a proposal currently being considered — If yes, submit four forms and four plans. — B [✓]

Please complete

I attach the necessary plans and request that the changes described below be accepted as an amendment. I understand that the Council may require a fresh application, together with fee if appropriate. If the amendment relates to a current application, I agree to an extension of the terminal date.

Signed ..... Date .....

3. Please complete in block letters

FULL DESCRIPTION OF DEVELOPMENT IN ORIGINAL APPLICATION

conversion of barn to form additional accomm

State details of amendments proposed

(Give a full detailed list of the changes, and also mark these clearly on the accompanying plans. Only the changes listed here will be considered.)

See Dam

State drawing no's of the current submission

Has this amendment been requested by the Council? (If so, state Officer dealing with the application)

YES / NO

Describe any part of the original development which is excluded by virtue of the amendment, and state any alteration to plot numbers

Has a similar amendment been submitted under Building Regulations? Yes / No

AMENDMENT RECORD SHEET – LIVE APPLICATION

Admin

Validation:

Inadequate/Inappropriate ☐

Clarification/Details required:

Appears valid ☑

Registered .....

Terminal date/committee updated .....

DC Procedural Assessment

Is the information given correct? Yes/~~No~~ (If No, state above what details are needed)

Has this amendment been requested? Yes/~~No~~ *

If Yes, is it what was asked for? Yes/~~No~~ *

Who do you need to reconsult as a result of this amendment? PC None ☑
WM
Press
Residents
Other –

Is it an amendment in principle? Yes/~~No~~

Is it the same character/description for fee purposes? Yes/~~No~~ (Refer to Admin ?) *

If No, but Yes to (*) requested :-

Do development objectives outweigh financial objectives? Yes/No Confirmed.....

REJECTED as an amendment – new application needed

Confirmed: .....

Notes/Advice/Rejection Reason:

☐ Tick if you wish this note to be a paragraph in the Rejection Notice

AUTHORISED to treat as amendment

Confirmed: NK 3/4.

Superseded details removed ☐

Give a revised description if the details accepted are different to the submission:
Revised curtilage and application to freeVision.

Acceptance issued:

Public register updated:

DC Professional Assessment

NOTES:

✓ 6/4

ALEC WALLHAM
BA (Hons) F.C.I.H.
Director of Housing & Planning Services

Housing and Planning
Services Department,
Council Offices,
Priory Road,
Spalding,
Lincolnshire. PE11 2XE

Telephone: (01775) 761161
Fax: (01775) 710772

FILE COPY

SOUTH HOLLAND DISTRICT COUNCIL
HOUSING & PLANNING SERVICES DEPARTMENT

Application no: H11/0948/00

Applicant: Mr M G Godfrey
83 Westgate Road
Hunstanton
Norfolk
PE36 5EP

Agent:
Architectural Design Services
3 Newgate Road
Tydd St. Giles
Wisbech
PE13 5LH

Description: Proposed conversion of barn to form additional residential accommodation

Location: Red House
Jarvis Gate
Sutton St. James
Lincs

Amendment: Revised curtilage and alterations to fenestration (Dwg nos. SH/62400A & SH/61600B)

06-APR-01

Dear Sir/Madam

ACKNOWLEDGEMENT OF AMENDMENT

I acknowledge receipt of the amended details in respect of the above and confirm that the changes are able to be incorporated in the application which will now **only be considered in its amended form.**

As a result of the need for the Authority to repeat certain procedures because of the amendment, the period for determining the application has been extended to 18 MAY 2001

Your rights of appeal remain as explained on the original acknowledgement.
If you do not wish to agree to the extended time period and would rather have the application determined more quickly but on the basis of the application as originally submitted, please let me know in writing within the next 5 days.

You are reminded that revision to any submission made under the Building Regulations may also be necessary.

Yours faithfully

Director of Housing and Planning Services

ARCHITECTURAL

DESIGN SERVICES

3 Newgate Road,
Tydd St Giles,
Wisbech
Cambridgeshire
PE13 5LH

Telephone
01945 870022

Mr.D.Gedney
Director of Planning & Building Control,
South Holland District Council,
Council Offices,
Priory Road,
Spalding,
PE11 2XE

21st march 2001

Dear Sir

REF: PROPOSED CONVERSION OF BARN TO FORM ADDITIONAL RESIDENTIAL ACCOMMODATION AT RED HOUSE, JARVIS GATE, SUTTON ST. JAMES.
FOR. M.G.GODFREY.
Ref: H11/0948/00 & H11/0949/00.

Following our recent discussions and your letter dated 5th December 2000 regarding the above Scheme I enclose revised plans as requested.

I also confirm that my Client wishes the Application to proceed at Committee level.

I trust these details are in order.

ARCHITECTURAL DESIGN SERVICES

S J Thrower