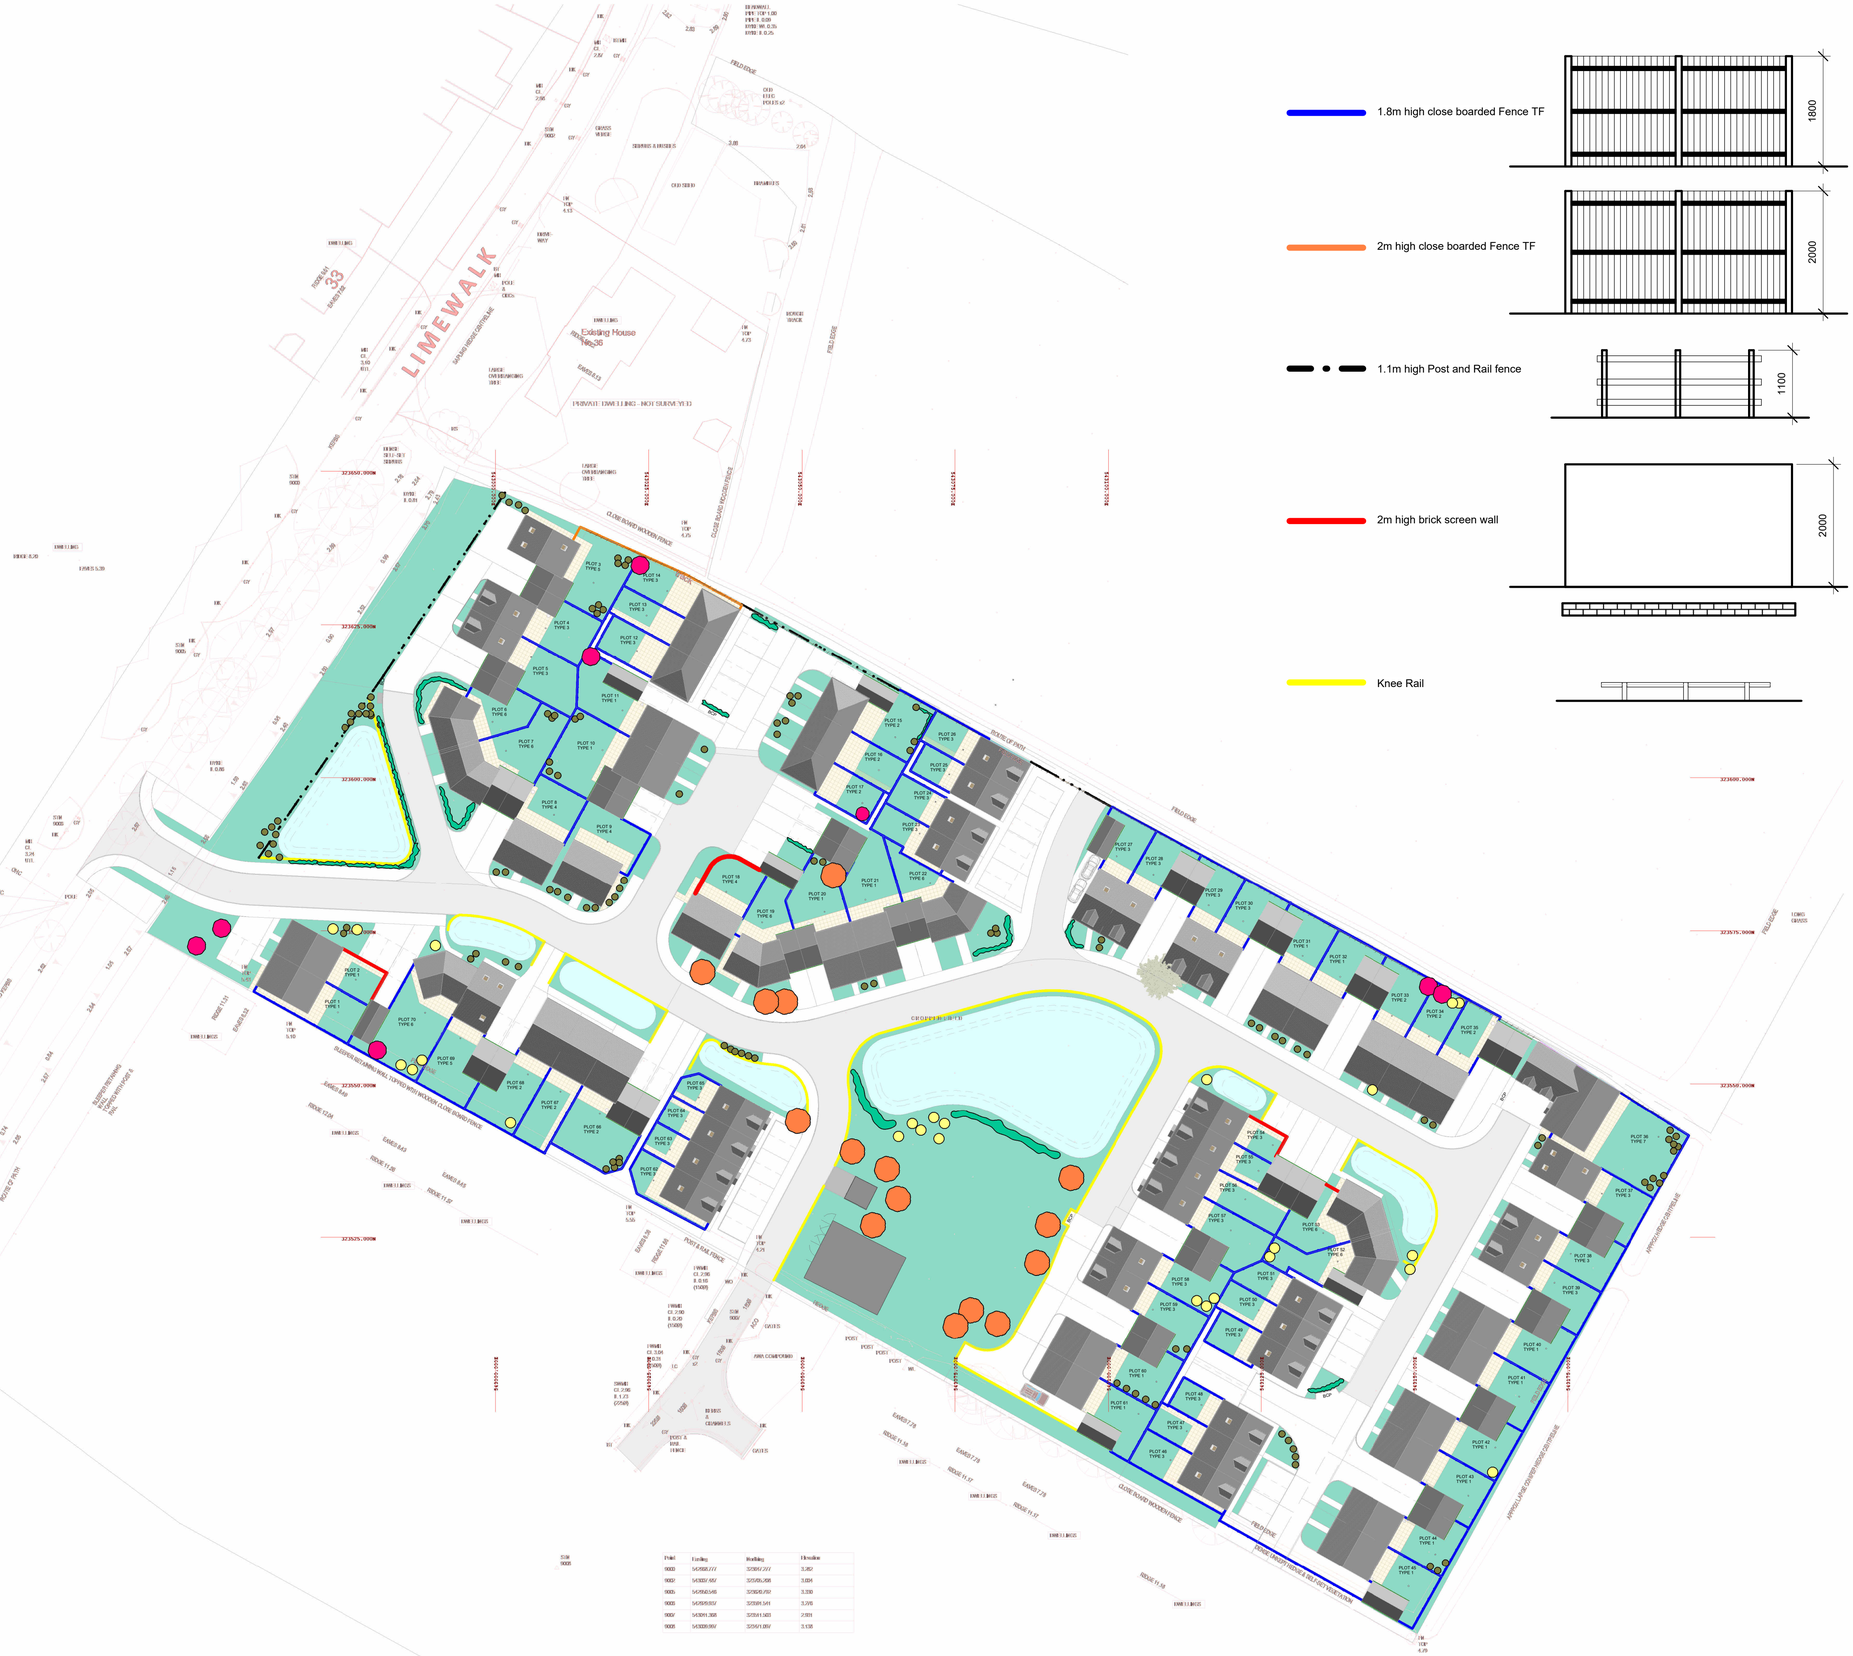


1 Site Block Plan

1 : 500

PLANTING KEY

- 1.8m high close boarded Fence TF
- 2m high close boarded Fence TF
- 1.1m high Post and Rail fence
- 2m high brick screen wall
- Knee Rail

- GRASS
- PAVING SLABS
- PAVING SLABS
- PLANTING A
- PLANTING B
- PLANTING C
- PLANTING D
- PLANTING E

rev	date	name	chk	note
C3	04/11/25	DH	SP	Fence lines updated
C2	02.11.25	DH	SP	Fencing details added
C1	14.11.22	DH	SP	Garden access updated

HA architectural Services
A The Limes, 80 High Street, Ketton, Stamford PE9 3TE
T 01780729122
E simon@h-a-architectural.co.uk

A1
Original Sheet Size

STATUS
AS BUILT

- All rights described in chapter IV of the copyright, designs and patents act 1988 have been generally asserted
- Where any drawing is to be read in conjunction with another, including specialists, the two drawings shall be cross-checked and any descrepancies reported to the architect before the work is put in hand
- All dimensions are in millimeters, all levels are in metres, unless shown otherwise
- Any discrepancies in dimensions or details on or between these drawings/specifications should be drawn to the attention of the Den Architectural and or the engineer in writing for clarification
- Drawing prepared solely for the use of client, as detailed in text box, and is not to be copied, lent or used by any third party without written permission

PROJECT
PROPOSED RESIDENTIAL DEVELOPMENT
LAND OFF LIME WALK,
LONG SUTTON
LINCONSHIRE

CLIENT
Stinders Homes SPV1 Ltd / PJKMagpie Close Ltd

DRAWING TITLE
Landscape Plan

SCALE	DATE	DRAWN	CHK
As indicated	24.06.24	DH	SP

DRAWING NUMBER
4149 / 103

REVISION
C3

© COPYRIGHT