PLANNING AMENDMENT

For office use only

Application No. H11/1187/02/AM

Date Registered 25 MAR 2003

Case Officer DHG

1. Please complete in block letters

NAME AND ADDRESS OF APPLICANT

D + J DEV.

Tel. No.

NAME AND ADDRESS OF AGENT

(if form completed by agent)

?WRIGHTS + HOLBEACH? ASPHALT LTD

Tel. No. (Contact)

Please complete in block letters

FULL POSTAL ADDRESS OF THE APPLICATION SITE

BRIDGE ROAD INDUSTRIAL ESTATE, BRIDGE ROAD, LONG SUTTON.

Please complete

APPLICATION No.

This amendment **cannot be considered** unless the relevant reference is stated

H11/1187/02

Building Regulation reference relating to same development (if any)

2. Please tick **one** box only

A — Amendment is proposed where permission already granted [✓]
If yes, submit two forms and two plans.

or

B — Amendment is to a proposal currently being considered [ ]
If yes, submit four forms and four plans.

Please complete

I attach the necessary plans and request that the changes described below be accepted as an amendment. I understand that the Council may require a fresh application, together with fee if appropriate. If the amendment relates to a current application, I agree to an extension of the terminal date.

Signed ..... Date .....

3. Please complete in block letters

FULL DESCRIPTION OF DEVELOPMENT IN ORIGINAL APPLICATION

ERECTION OF A STEEL FRAMED STORAGE BUILDING.

State details of amendments proposed

(Give a full detailed list of the changes, and also mark these clearly on the accompanying plans. Only the changes listed here will be considered.)

SEE FAXED DETAILS

State drawing no's of the current submission

Has this amendment been requested by the Council? (If so, state Officer dealing with the application)

YES / NO

Describe any part of the original development which is excluded by virtue of the amendment, and state any alteration to plot numbers

Has a similar amendment been submitted under Building Regulations? Yes / No

SOUTH HOLLAND DISTRICT COUNCIL

FILE COPY

Terry Huggins
Acting Chief Executive
Andrew Petcher
Acting Director of Customer Services
Bob Atkins
Director of Corporate Services

Application no: H11/1187/02

Original Applicant
D & J Developments
c/o G Collings
13 High Street
Long Sutton
Spalding, Lincs. PE12 9DB

Original Agent:
R W White
8 Meridian Walk
Holbeach
Spalding
Lincs

Description: Erection of a steel framed storage building

Location: Bridge Road Industrial Estate
Bridge Road
Long Sutton

Amendment: Revised windows on northern elevation

25-APR-03

Dear Sir/Madam

TOWN AND COUNTRY PLANNING ACT 1990

NOTICE OF ACCEPTANCE OF AMENDMENT

The amended details submitted in respect of the above proposal have now been considered and there are no objections to the amendment being implemented to the extent described above.

Note: This Notice does not convey any approval under the Building Regulations and you may need to make a new submission.

Yours faithfully

Head of Planning & Development

Wrights and Holbeach Asphalt Ltd
7 Wrights Mews
Park Road
Holbeach
Spalding Lincs PE12 7EE

Council Offices
Priory Road
Spalding
Lincolnshire
PE11 2XE

Telephone: (01775) 761161
Fax: (01775) 711253
Email: Info@sholland.gov.uk

AMENDMENT RECORD SHEET - POST DECISION

Admin

Validation:

Inadequate/Inappropriate ☐

Clarification/Details required:

Appears valid ☑

Registered .....

DC Procedural Assessment

Is the information given correct? Yes/~~No~~ (If No, state above what details are needed)

Is it an amendment in principle? Immaterial/~~Needs new app~~

Confirmed: .....

Give a revised description if the details accepted are different to the submission:

Acceptance issued: 25/4/03

1 OF 2

F.A.O DAVID GEONEY

ESTABLISHED 1959

Wrights & HOLBEACH ASPHALT LTD

*Polyroof Glass Fibre Roofing *
*High Performance Felt Roofing *
*Mastic Asphalt Roofing, Flooring & Tanking Work *
*UPVC Fascias, Soffits, Bargeboards & Rainwater Goods *

7 Wrights Mews,
Park Road,
Holbeach,
Spalding,
Lincolnshire
PE12 7EE

Main Office
Tel: 01406 422379
Fax: 01406 426522

Please find enclosed plan of how we would like the office windows to look.

We need 7-8 weeks to have windows made and would appreciate it if you could confirm this change is okay

Many Thanks

SHDC
Planning & Development
24 MAR 2003
Ref 11/0102


Samantha McEwan

J. McEWAN
D & J Developments

REF H11/1187/02


Please see amendments

Plastisol Box profile roof cladding on 40mm celotex insulation board in galv tee pieces.

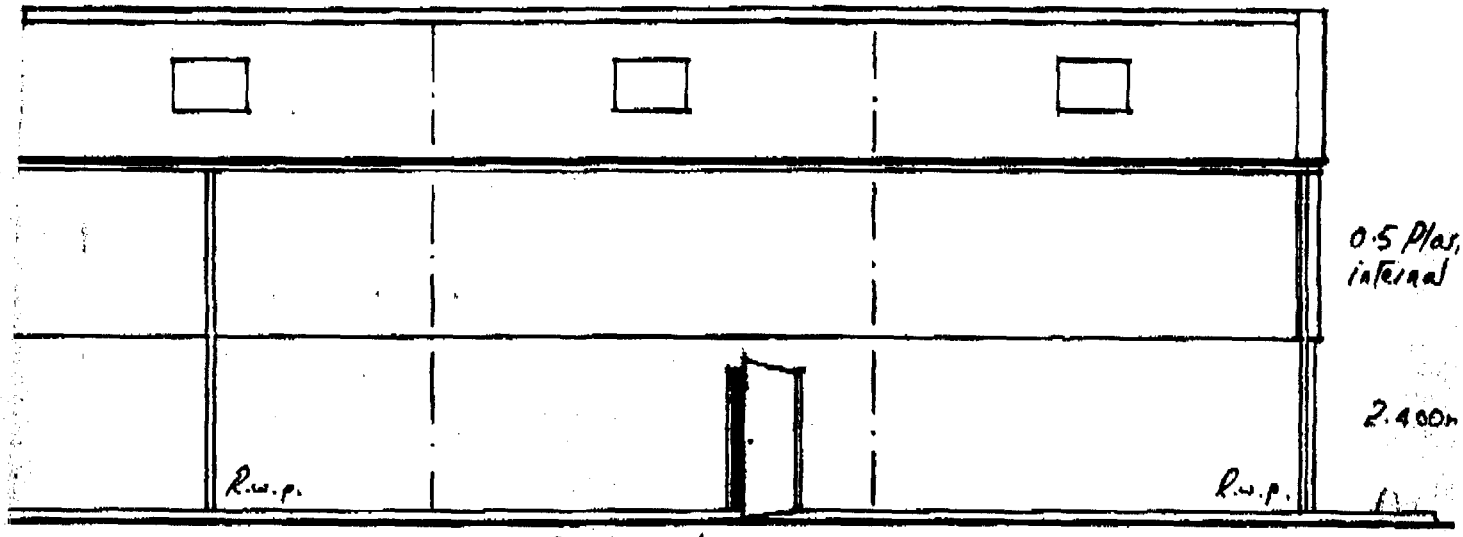

No 2 - Treated timber 'Fire Exit' doors ½hr rating.

Plastisol Box profile roof cladding on 40mm celotex insulation board in galv tee pieces.

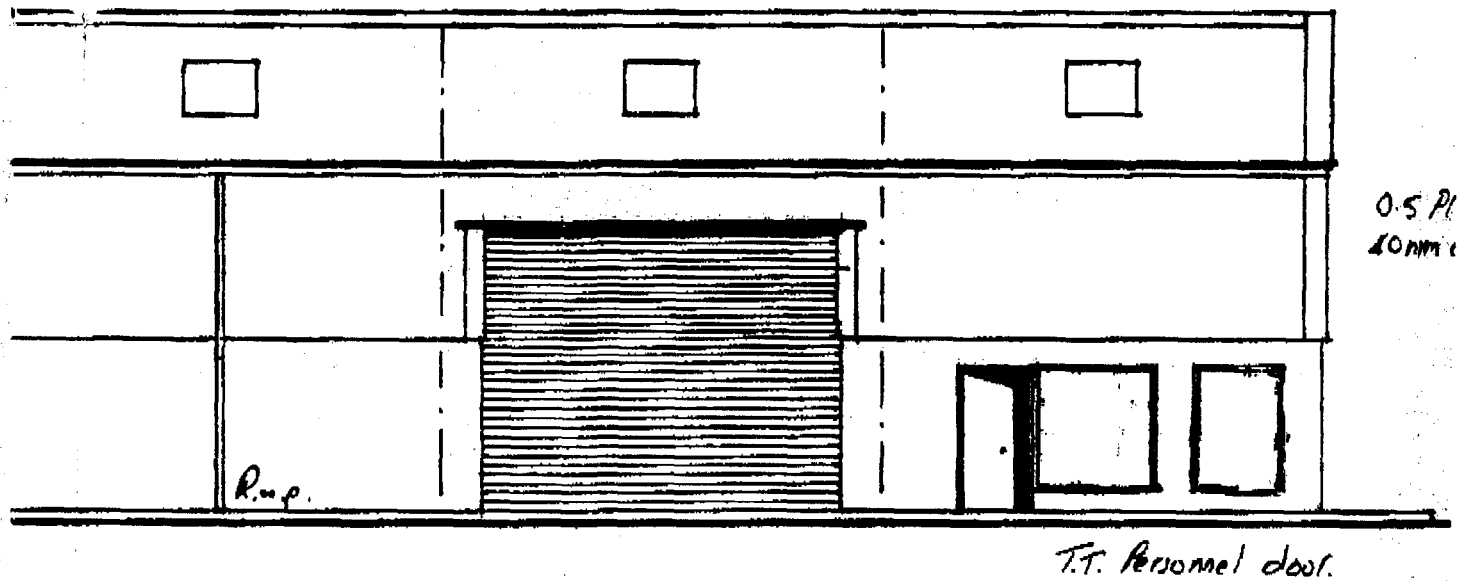

No 2 - 5.000m wide x 4.000m high, insulated, roller shutter doors.

SHDC
Planning & Development
Ref

30.500m (5 No. 6.100m Bays)

Application Amendments

Application: H11/1187/02

Location: Bridge Road Industrial Estate
Bridge Road
Long Sutton

Postcode: House Number:

Amendment: 1 Date: 25-03-2003

Type: POS Post-Decision
Sub-Type:

Description:

Long Description:

Agent: Des'n:
Name: R W White
Address: 8 Meridian Walk
Holbeach
Spalding
Lincs
Post Code: E-Mail:
Tel: 01406 422439 Fax:
Ref: