PROPOSED GARDEN CENTRE, LONG SUTTON, SPALDING,LINCS

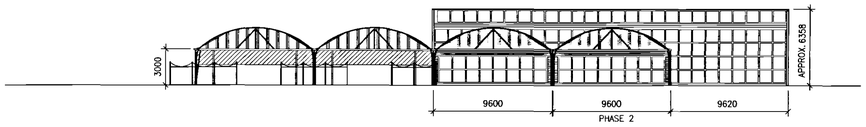

SIDE ELEVATION Scale 1:250

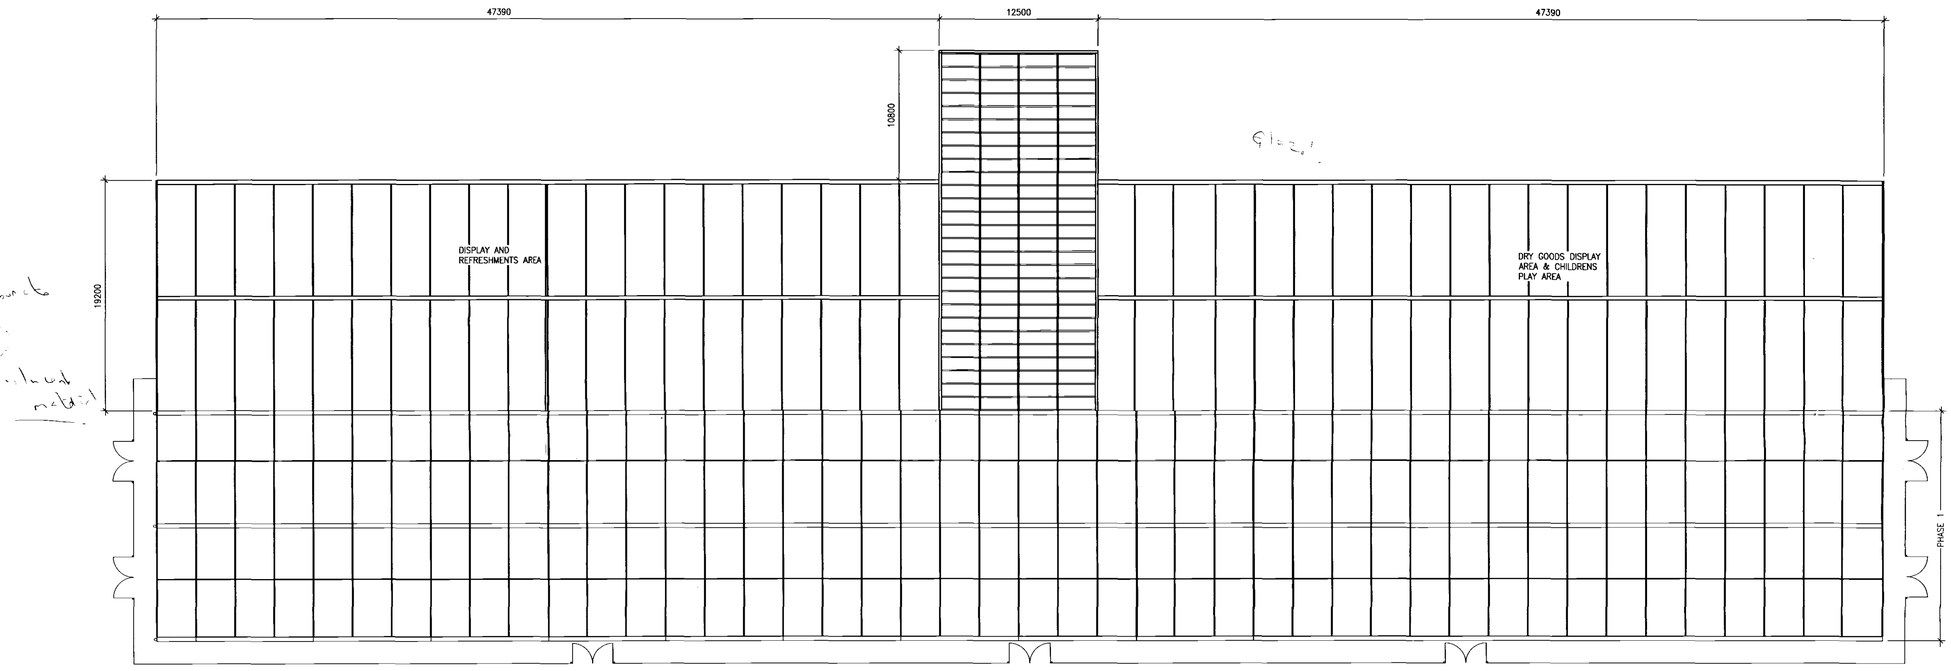

FLOOR PLAN Scale 1:250

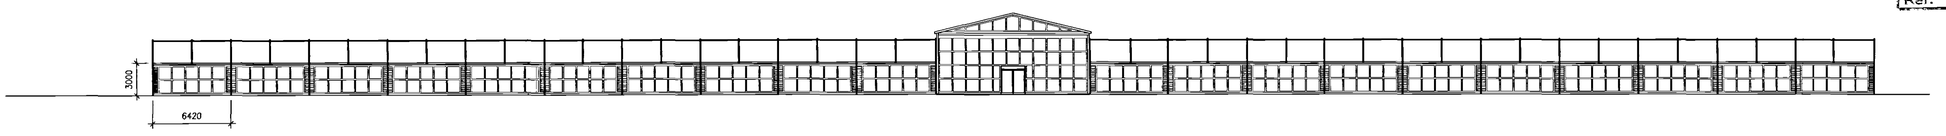

INNER BAYS FRONT ELEVATION 1:250

PROPOSED PLANS & ELEVATIONS PHASE 2 Scale 1:250

Notes
1. All dimensions must be checked on site by the Contractor.
2. Written dimensions to take precedence over scaled dimensions.

LEGEND

GREEN STRIPED FLAME RETARDANT CLADDING

PP521 FLAME RETARDANT ROOF CLADDING MATERIAL

FLAME RETARDANT DROP DOWN NETTING CLADDING MATERIAL

SPECIFICATION:

1. TWO BAYS AT 9.6m X 107.28m
2. EAVES HEIGHT 3m
3. FULL GUTTERS TO BOTH SIDES
4. 4No RAINWATER DOWNPIPES PER GUTTER RUN,
5. ALL DOWNPIPES LEADING TO A WATER STORAGE TANK.
6. OPEN ENDS AND SIDES
7. 1.2m DROP DOWN SIDES (AS SHOWN)

CONSTRUCTION:

1. HOOP FRAMES MANUFACTURED FROM 60mm ø STRUCTURAL STEEL GALVANISED INSIDE & OUTSIDE B.S.2989.

2. DIAGONAL BRACING BARS & ROOF PURILINS MANUFACTURED FROM 50mm ø STEEL SECTIONS.

3. STANCHIONS MANUFACTURED FROM 80 X 80mm BOX SECTION STEEL & HOT DIPPED GALVANISED.

4. ALL BRACKETS AND FIXINGS ARE TO BE GALVANISED

5. THE ENDS OF THE TUNNELS ARE TO BE CONSTRUCTED FROM TUBULAR 50mm ø STEEL VERTICALS USING ALUMINIUM GRIP RAILS ON BOTH ENDS.

6. ALL STEEL WORK AS Z35 STEEL.

7. ROOF AREA IS TO BE COVERING IN A TRANSLUCENT FLAME RETARDANT PP521 MATERIAL.

8. HALF MOON ENDS ARE TO BE COVERED IN WHITE STRIPED FLAME RETARDANT CLADDING MATERIAL.

9. SIDES ARE TO BE COVERED WITH GREEN 1.2m DROP DOWN FLAME RETARDANT NETTING AS SHOWN.

10. ALL RAINWATER GOODS TO RUN TO A WATER TANK WHICH WILL BE USED TO IRRIGATE PLANTS, WITH OVER FLOW TO A SOAKAWAY.

11. ALL GUTTERING WILL BE PROVIDED WITH GRIP RAIL.

Revisions	Date	Description
Amendments		

Building Surveying Architecture Project Management Planning Supervisors

Templeman Associates

THE ROYAL INSTITUTION OF CHARTERED SURVEYORS

Mechanical & Electrical Services Structural Engineering Move Management

Tel (01553) 776148 Fax (01553) 778320 www.TemplemanAssociates.co.uk

SHDC
Planning & Development
27 OCT 2004
Ref:

NATIONAL POLYTUNNELS
4 Cable Court
Pittman Way
Fulwood, Preston
Lancashire PR2 9YW
Tel: 01772 799200 Fax: 01772 799250
Email: sales@nationalpolytunnels.co.uk

TEMPLEMAN ASSOCIATES
3RD FLOOR
REGIS HOUSE
AUSTIN STREET
KING'S LYNN
NORFOLK PE30 1RB

Drawing Status: Draft; ● Consultation; Tender; Construction; As Built

Project Title: PROPOSED GARDEN CENTRE, LONG SUTTON SPALDING,LINCS

Drawing Title: PROPOSED PLANS AND ELEVATIONS PHASE 2

Works Request No.

Dwg No 1882-02

Drawn DPF Date SEP'04

Scale 1:250

Checked MJC Date SEP'04

Revision