
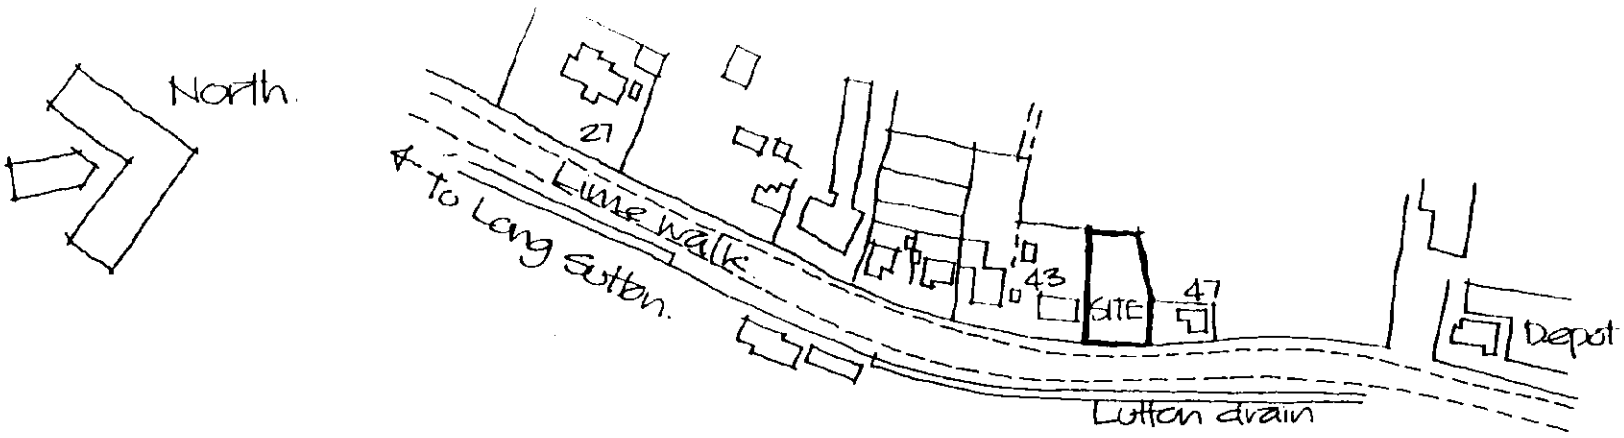


LOCATION PLAN Scale 1:2500

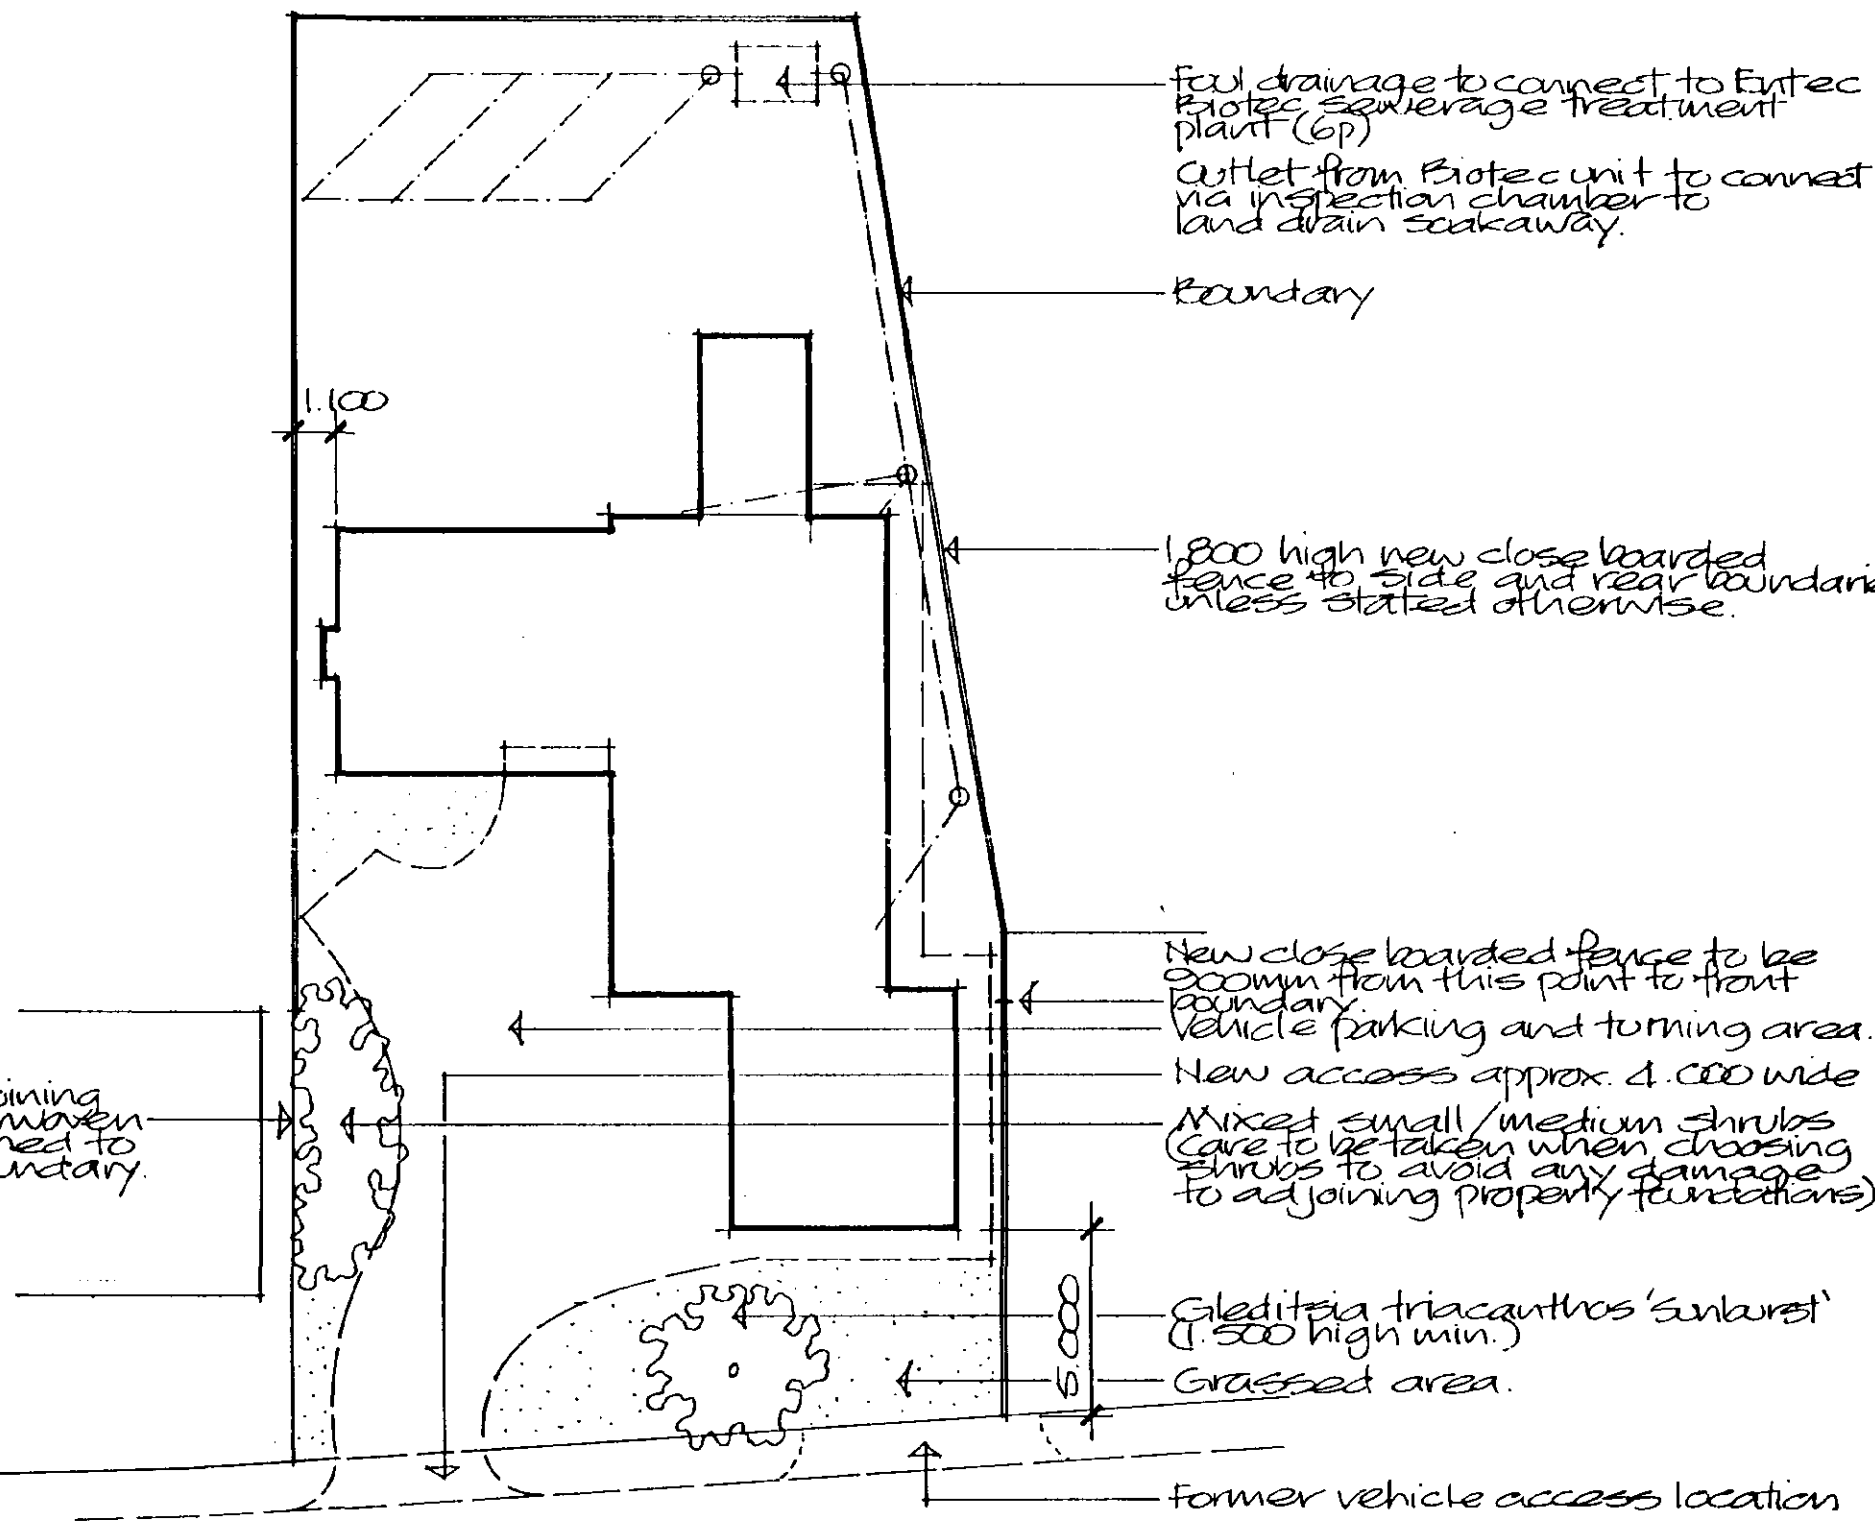

BLOCK PLAN Scale 1:200

19 MAR 2001
Ref: 0965100

A1

Project
PROPOSED BUNGALOW AND GARAGE
45 LIME WALK,
LUTTON,
LONG SUTTON.

SITE PLANS

ALAN HORNSBY
ARCHITECTURAL SERVICES
'Little Acre'
Peak Hill, Cowbit,
Spalding, Lincs. PE12 6AW
Tel. Holbeach (01406) 380591


Client
H.K.GOTT & SON

Scale


Date Aug. 2000

Dtg. no.
00/46/02

AM ADMEL 230

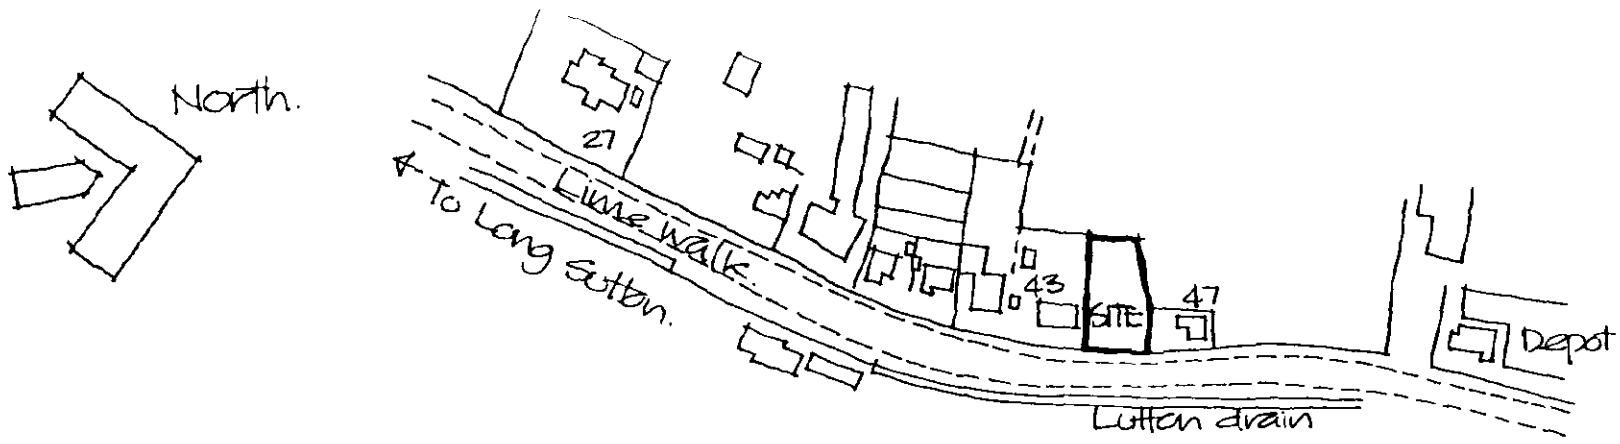

LOCATION PLAN Scale 1:2500

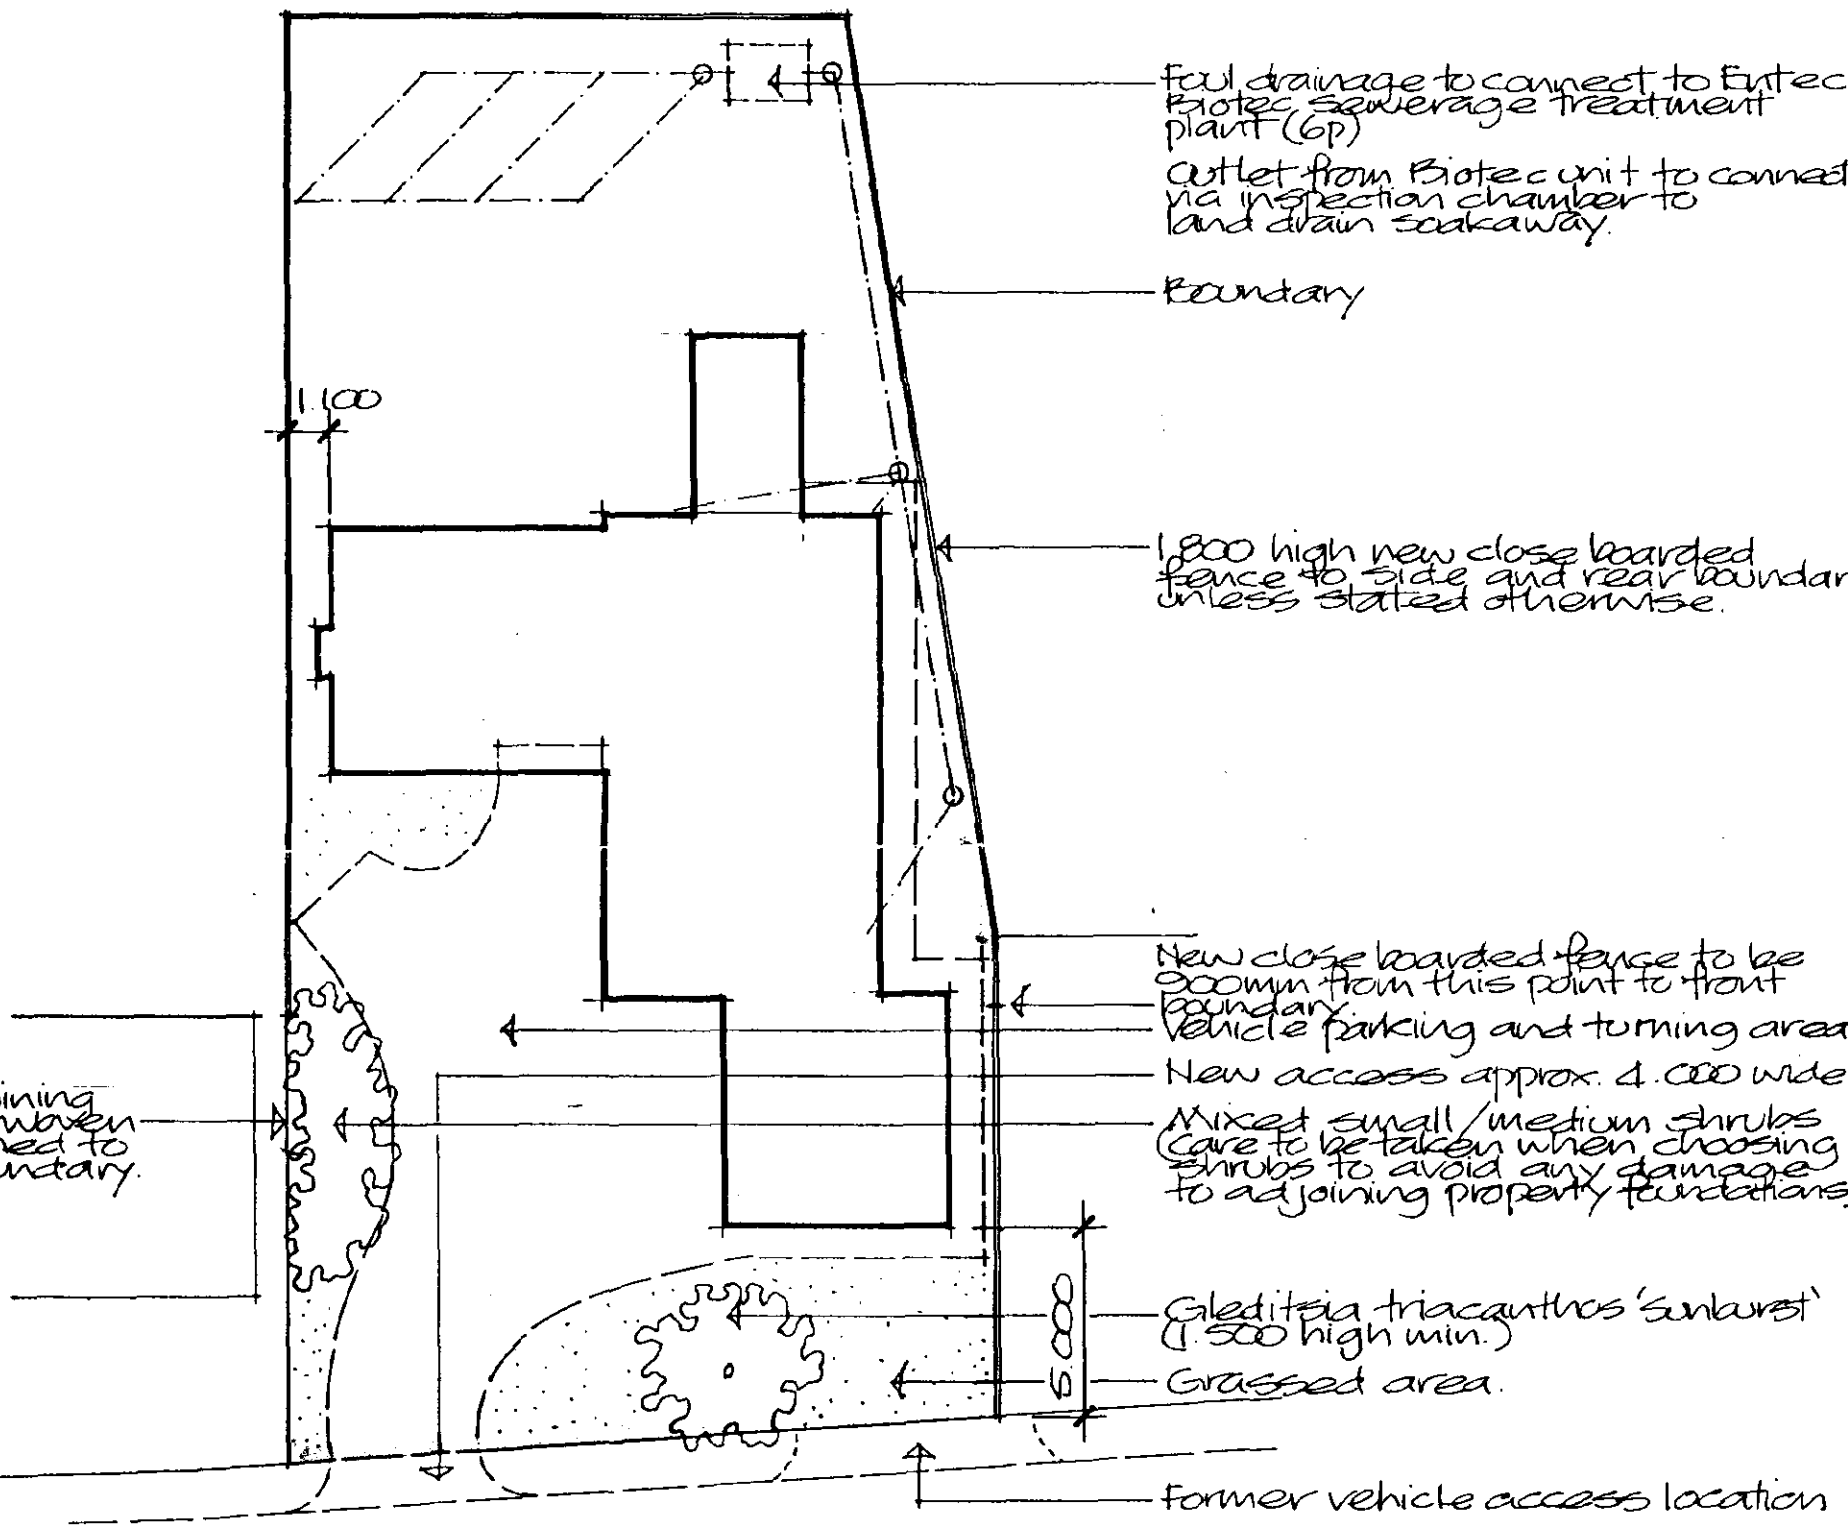

BLOCK PLAN Scale 1:200

SOUTH HOLLAND DC
HOUSING & PLANNING
03 AUG 2000
Ref. 0165/00

Project
PROPOSED BUNGALOW AND GARAGE
45 LIME WALK,
LUTTON,
LONG SUTTON.

SITE PLANS

ALAN HORNSBY
ARCHITECTURAL SERVICES
'Little Acre'
Peak Hill, Cowbit,
Spalding, Lincs. PE12 6AW
Tel. Holbeach (01406) 380591

Client
H.K.GOTT & SON

Scale


Date Aug. 2000

Drg. no.
00/46/02


AM ADMEL 230

Do not scale off this drawing.
All site dimensions to be checked before work commences.


Roof finish: MARLEY INVENDIP TERRACOTTA ~~SMOOTH RED~~
Facing bricks: IBSTOCK BRADGATE REGAL ~~FLEMISH RED~~
Windows/doors: White UPVC
Fascia/soffit: White UPVC

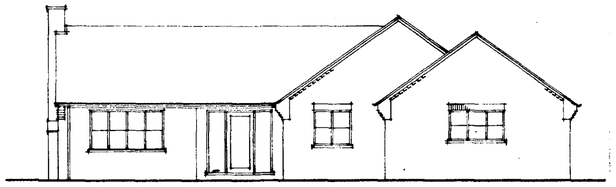


FRONT ELEVATION

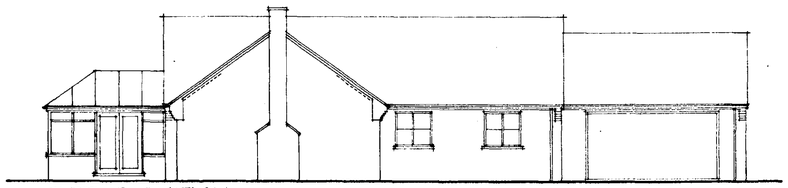


SIDE ELEVATION

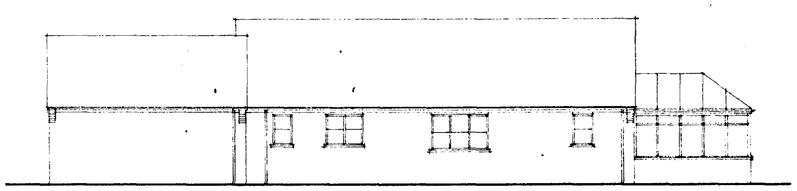


SIDE ELEVATION

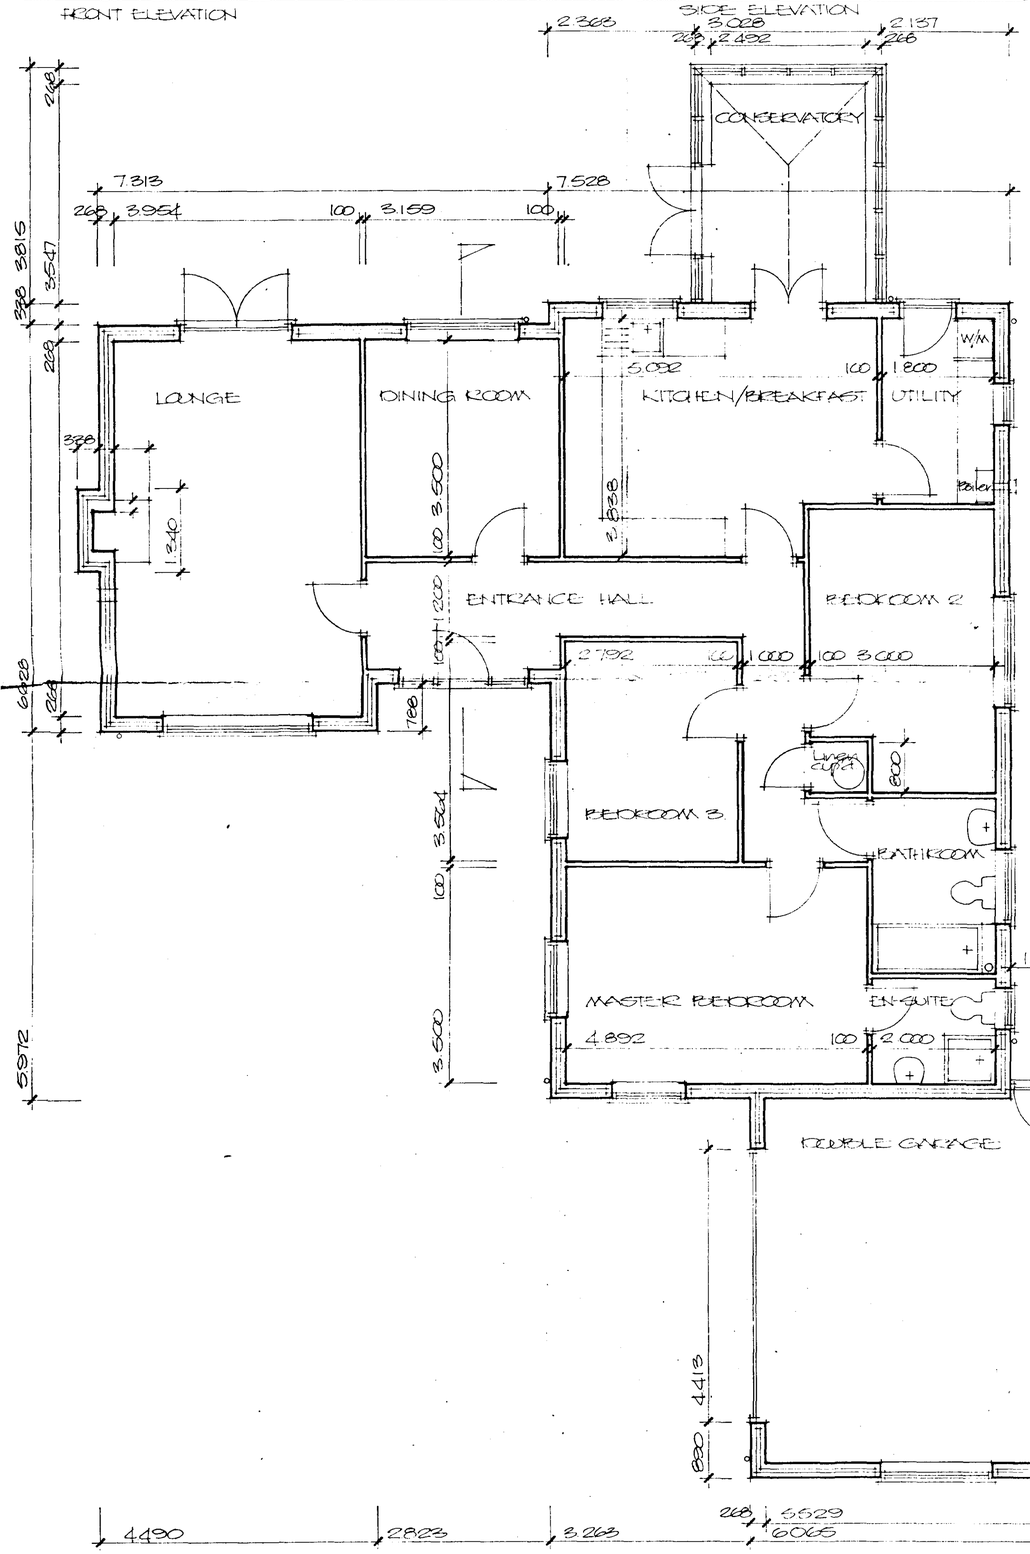

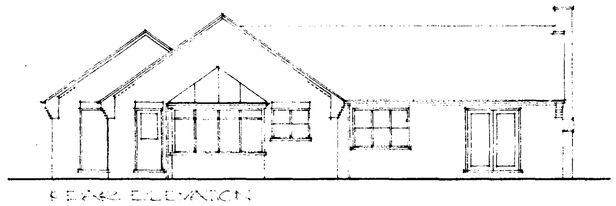

REAR ELEVATION

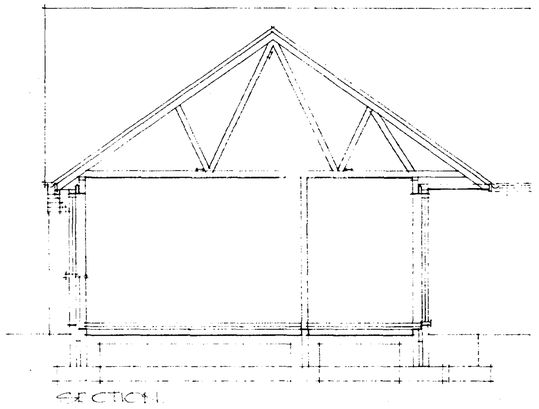

SECTION


Project	PROPOSED BUNGALOW AND GARAGE, 45 LIME WALK, LUTTON, LONG SUTTON.
Client	MR. COTTERELL
Scale	1:50 @ A1
Date	AUG 2008
Drg. no.	2008/50

ALAN HORNSBY
ARCHITECTURAL SERVICES
'Little Acre'
Peak Hill, Cowbit,
Spalding, Lincs. PE12 6AW
Tel. Holbeach (01406) 380591


AM ACMEL 430

Do not scale off this drawing.
All site dimensions to be checked before work commences.


Roof finish : Sandtoft Calderdale slate colour slate grey.
Facing bricks : Hanson Aldwell yellow multi stock.
Windows/doors : White Upvc.
Fascia/soffit : White Upvc.

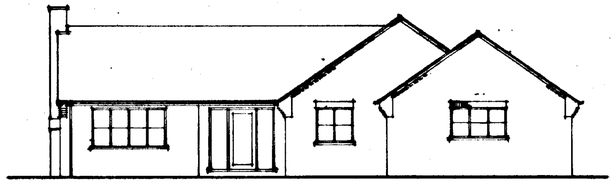


FRONT ELEVATION

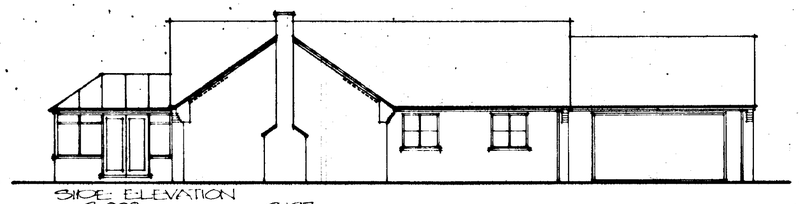


SIDE ELEVATION

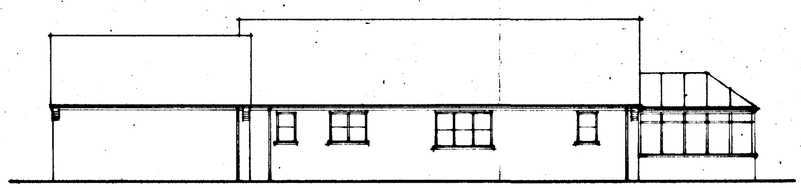


SIDE ELEVATION

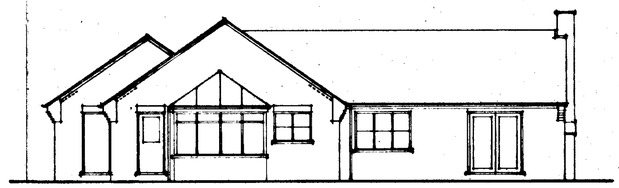

REAR ELEVATION

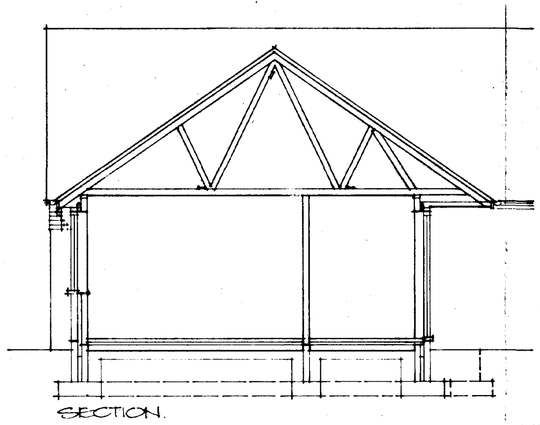

SECTION

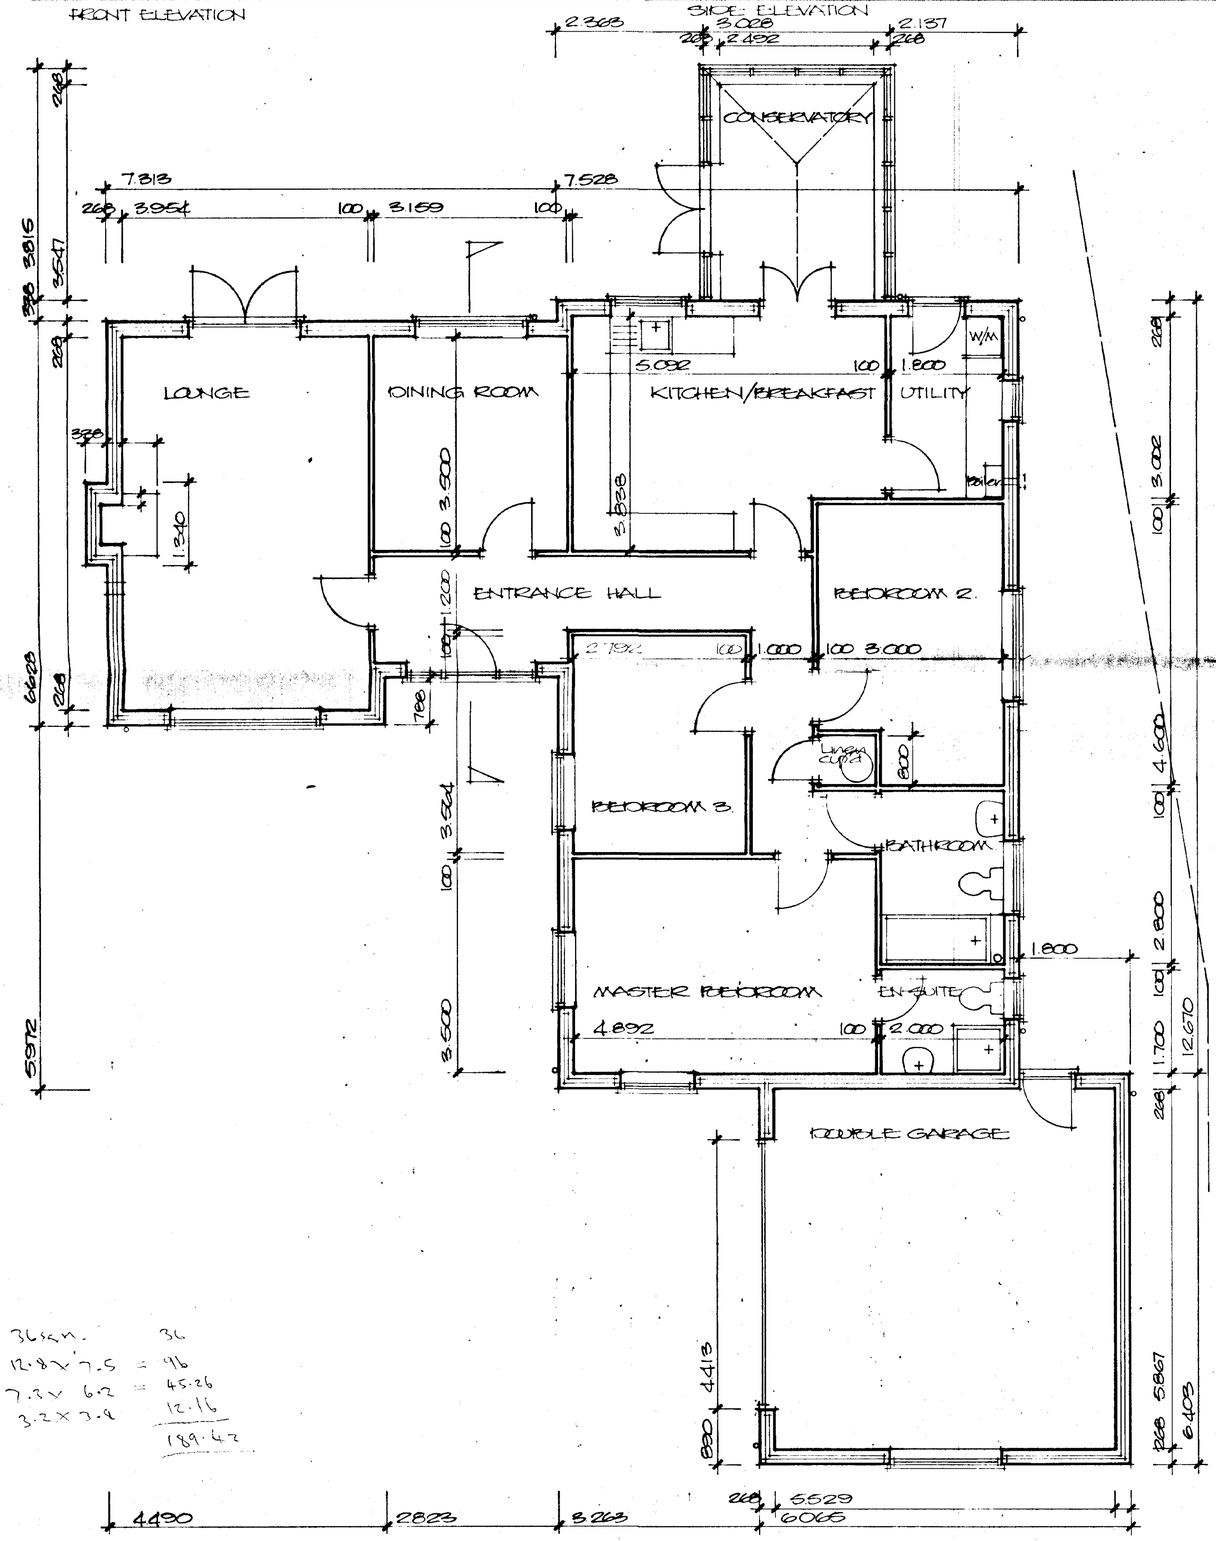

36 sq m.

12.8 × 7.5	=	96
7.3 × 6.2	=	45.26
3.2 × 3.9	=	12.16
		189.42

SOUTH HOLLAND DC
HOUSING & PLANNING
03 AUG 2000
Ref: 0965/00/F

DETERMINED PLAN

Project
PROPOSED BUNGALOW AND GARAGE
45 LIME WALK,
LUTTON,
LONG SUTTON.

ALAN HORNSBY
ARCHITECTURAL SERVICES
'Little Acre'
Peak Hill, Cowbit,
Spalding, Lincs. PE12 6AW
Tel. Holbeach (01406) 380591

Client
H.K. GOTT & SON

Scale 1:50/1:100
Date Aug. 2000

Drg. no.
00/46/01

AM ADMEL 230