
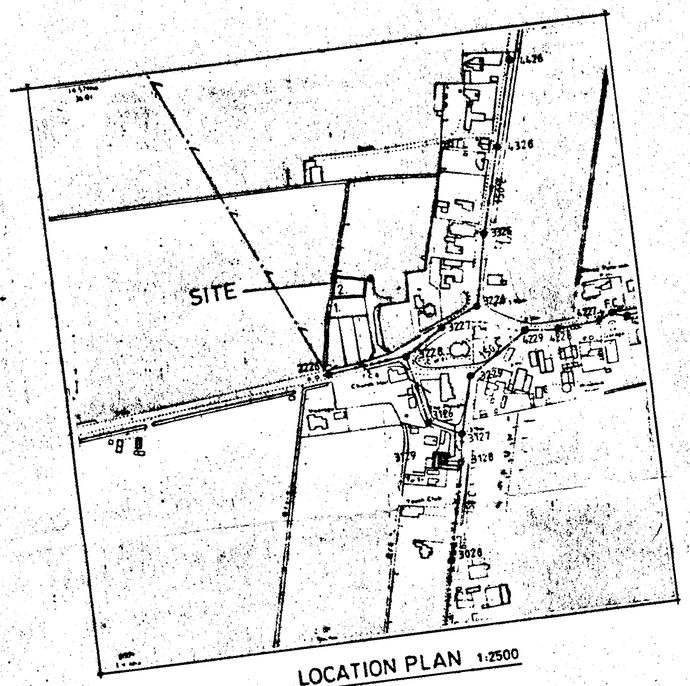


LOCATION PLAN 1:2500

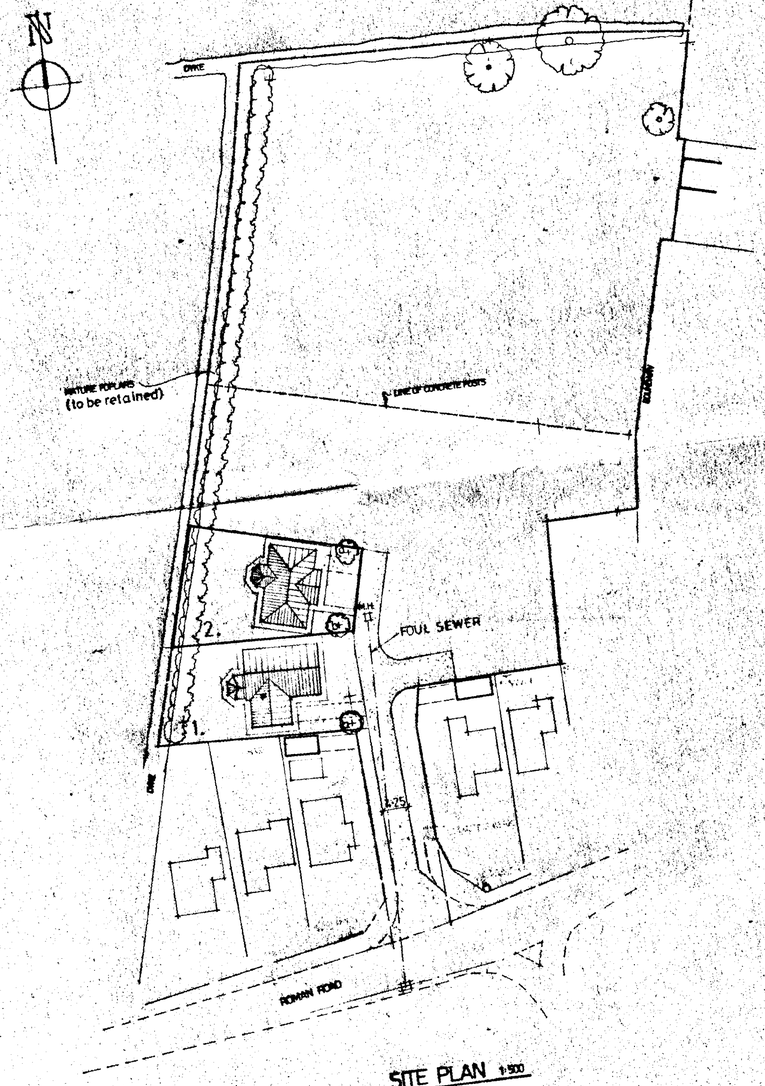

SITE PLAN 1:500

TREE PLANTING

PLOT 1. a - RED HAWTHORN (CRATAEGUS PAUL'S SCARLET) - ½ STANDARD

PLOT 2. a - RED HAWTHORN (CRATAEGUS PAUL'S SCARLET) - ½ STANDARD
b - WHITEBEAM (SORBUS ARIA LUTESCENS) - ½ STANDARD

DETERMINED PLAN

Ref. R4/113/0146/95 13/3/95

SITE LAYOUT

G. R. MERCHANT
I.ENG AMICE, FIWO,
ARCHITECTURAL, STRUCTURAL
& LAND DRAINAGE CONSULTANT
TEL: HOLBEACH (0406) 490800

PROJECT:
LAND OFF ROMAN ROAD,
MOULTON CHAPEL.


CLIENT:
D.G.M. PROPERTIES LTD.,
DOZENS BANK
POOE HOLE,
SPALDING,
LINCS.

SCALES: AS INDICATED


DATE: NOV. '94

DRAWING No.: DGM-MC.2

REVISIONS:

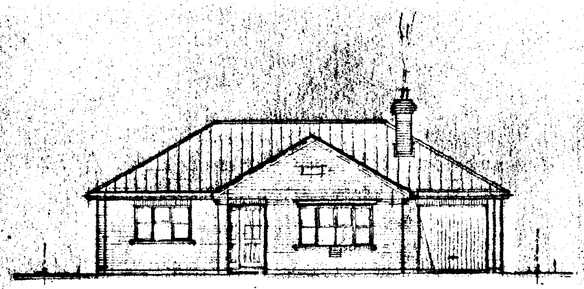


FRONT

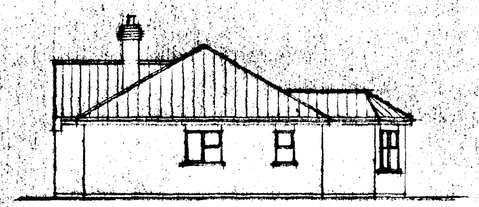


SIDE



REAR

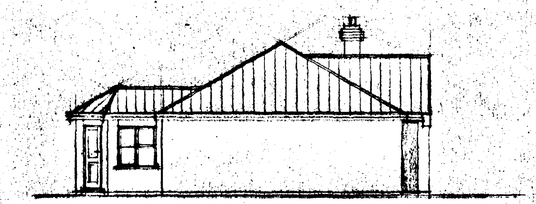

SIDE

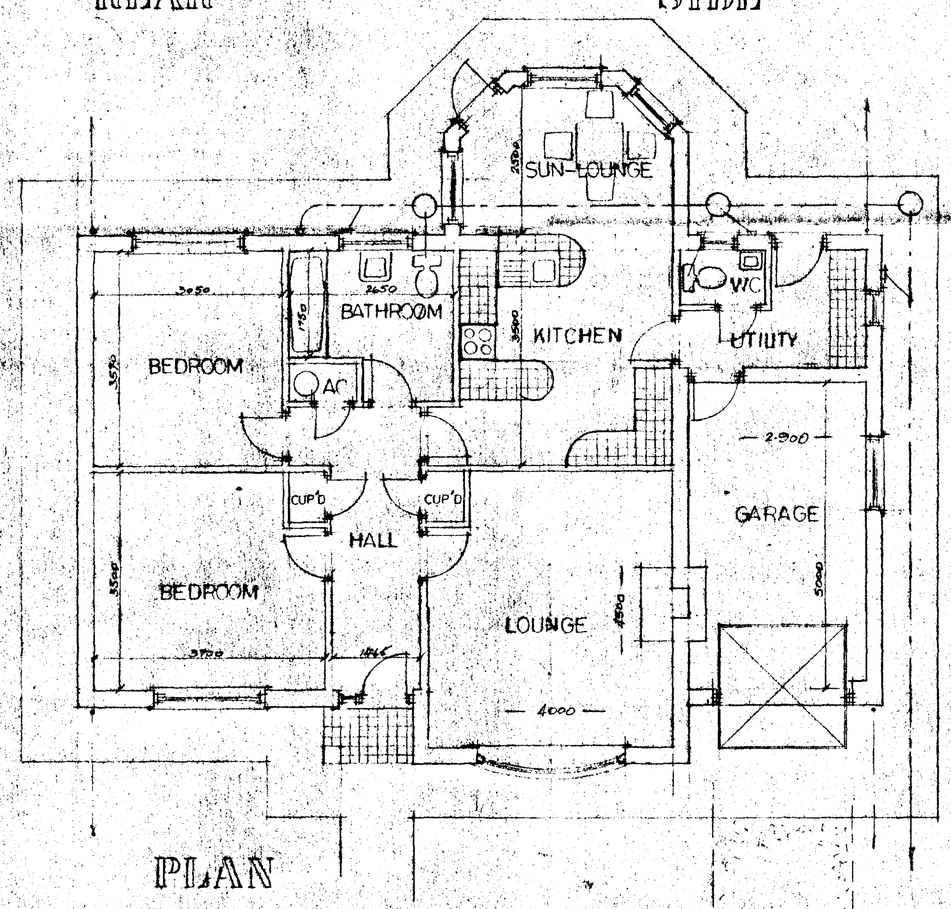

PLAN

DETERMINED PLAN

PLOT 2

PLANNING DEPARTMENT
14 FEB 1995
REF 0146/95

G. R. MERCHANT
LENG AMICE, FIWO,
ARCHITECTURAL, STRUCTURAL
& LAND DRAINAGE CONSULTANT
TEL: HOLBEACH (01406) 490800

PROJECT:
BUNGALOW & GARAGE
OFF ROMAN ROAD
MOULTON CHAPEL

CLIENT:
DGM PROPERTIES LTD.

SCALES: 1/50 1/100


DATE: JAN 1995

G.R.MERCHANT


DRAWING No.: DGM-MC. 3/2

REVISIONS:

SUMMIT
8046-1184T

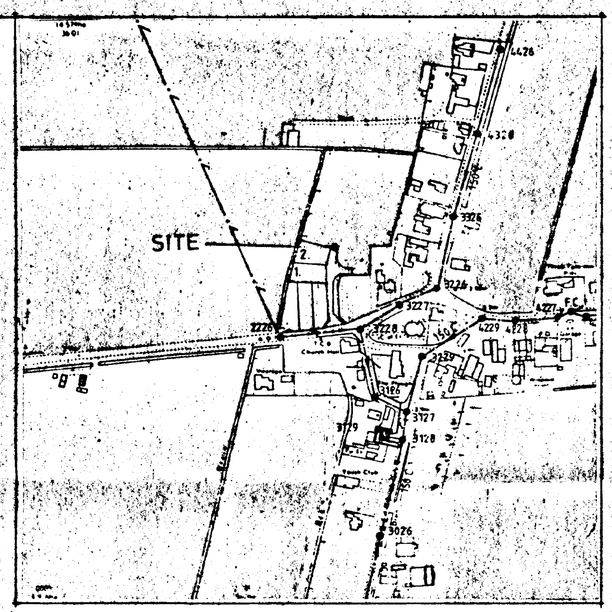

LOCATION PLAN 1:2500

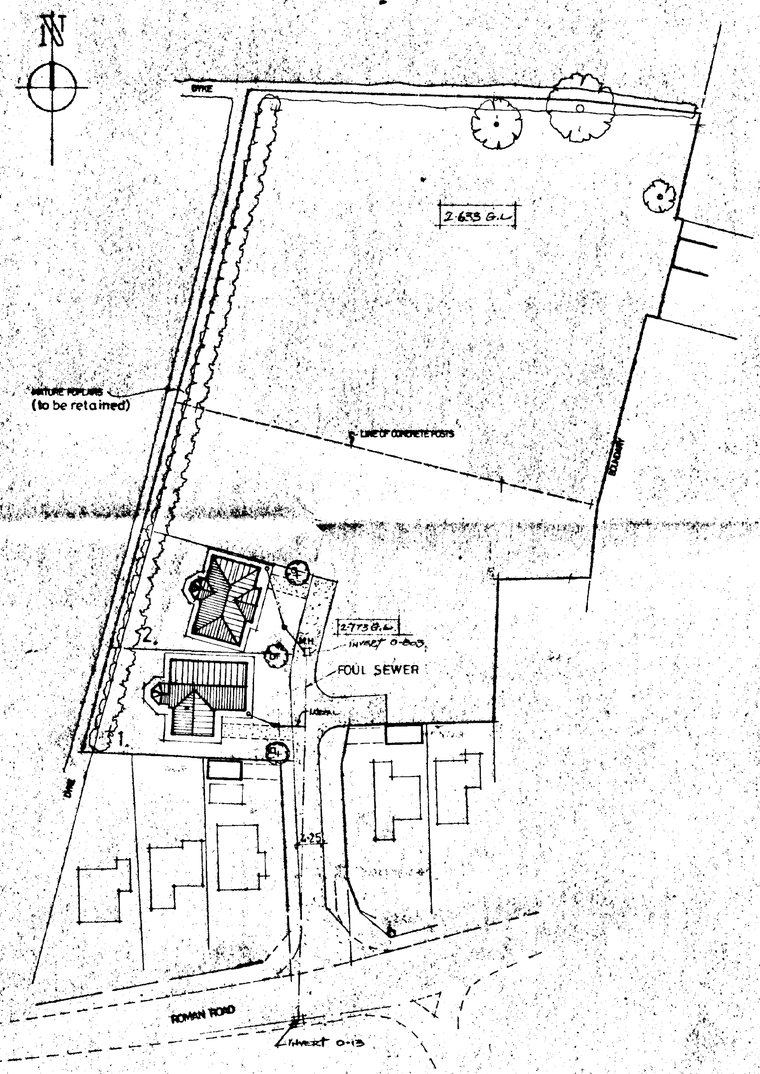

SITE PLAN 1:500

TREE PLANTING

PLOT 1. a - RED HAWTHORN (CRATAEGUS PAUL'S SCARLET) - ½ STANDARD

PLOT 2. a - RED HAWTHORN (CRATAEGUS PAUL'S SCARLET) - ½ STANDARD
b - WHITEBEAM (SORBUS ARIA LUTESCENS) - ½ STANDARD.

TEMPORARY PRIVATE DRIVE

PRIVATE DRIVE TO BE MINIMUM 4.25m WIDE CONSTRUCTED WITH 150mm WELL COMPACTED HARDCORE (SOLDOWN) & TOPPED WITH GRAVEL.

A - E 15.5
F - C 99.4
C - T 16.5
T - G 11.5
E - F 23.0
F - A 13.5

SOUTH [illegible] HOUSING [illegible]
03 JUL 1995
Ref: 0114/95

AMENDED PLAN
Ref. A1

C. 22.6.95 AS BUILT PLAN + PLOTS 1 & 2
D. 16.8.95 ROAD AMENDMENTS - PLOT 2
A. 6.9.95 LANDSCAPING PLOTS 1 & 2

G. R. MERCHANT
LENG AMICE, FIWO,
ARCHITECTURAL, STRUCTURAL
& LAND DRAINAGE CONSULTANT
TEL: HOLBEACH (0406) [illegible] 490800

PROJECT:
LAND OFF ROMAN ROAD,
MOULTON CHAPEL.

CLIENT:
D.G.M. PROPERTIES LTD.,
DOZENS BANK
PODE HOLE,
SPALDING,
LINCS.

SCALES: AS INDICATED

DATE: NOV. '94.

DRAWING No.: DGM-MC.2c.

REVISIONS: A B C

SITE LAYOUT

SUMMIT

1089 2937