




FRONT

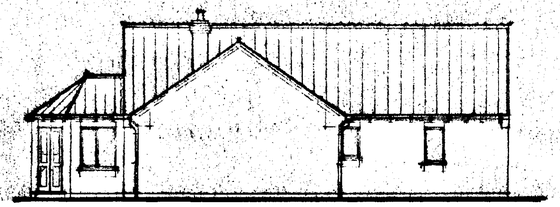


SIDE

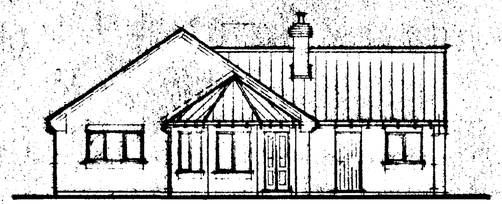

REAR

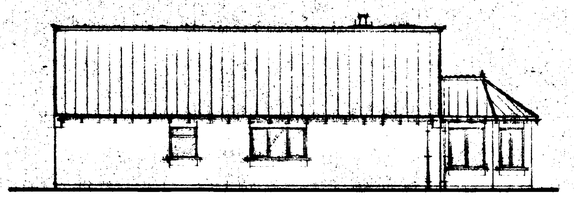

SIDE

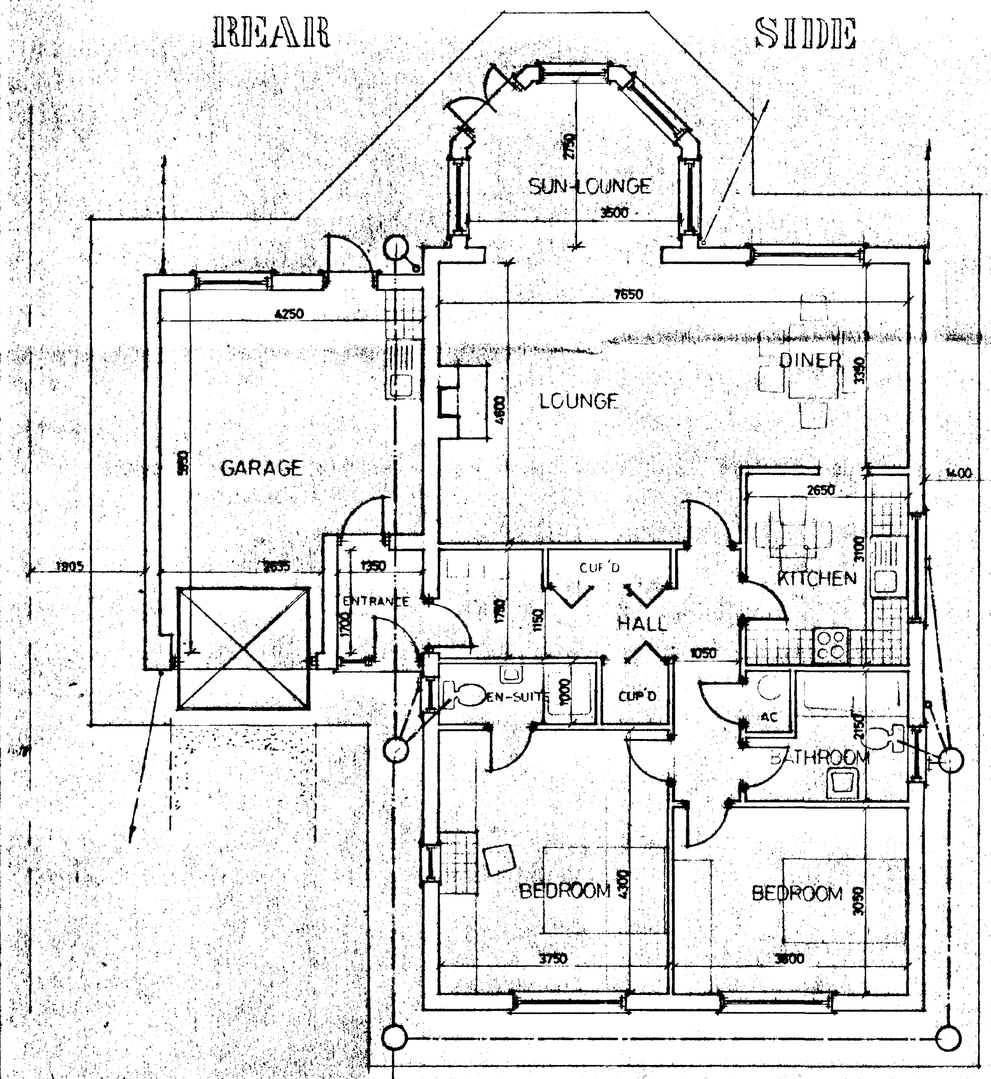

PLAN

DETERMINED PLAN

PLOT 1

SOUTH HOLLAND DISTRICT COUNCIL
PLAN DEPT.
14 FEB 1995
REF 01495

G. R. MERCHANT
I.ENG AMICE, FIWO,
ARCHITECTURAL, STRUCTURAL & LAND DRAINAGE CONSULTANT
TEL: HOLBEACH (01406) 490800

PROJECT:
BUNGALOW & GARAGE
OFF ROMAN ROAD
MOULTON CHAPEL

CLIENT:
DGM PROPERTIES LTD


SCALES: 1/100 1/50

DATE: JAN 1995


G.R.MERCHANT.

DRAWING No.: DGM-MC 3/1

REVISIONS:

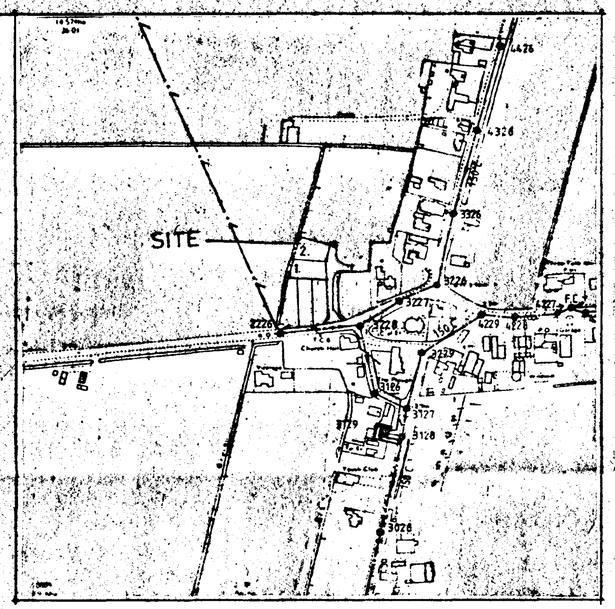

LOCATION PLAN 1:2500

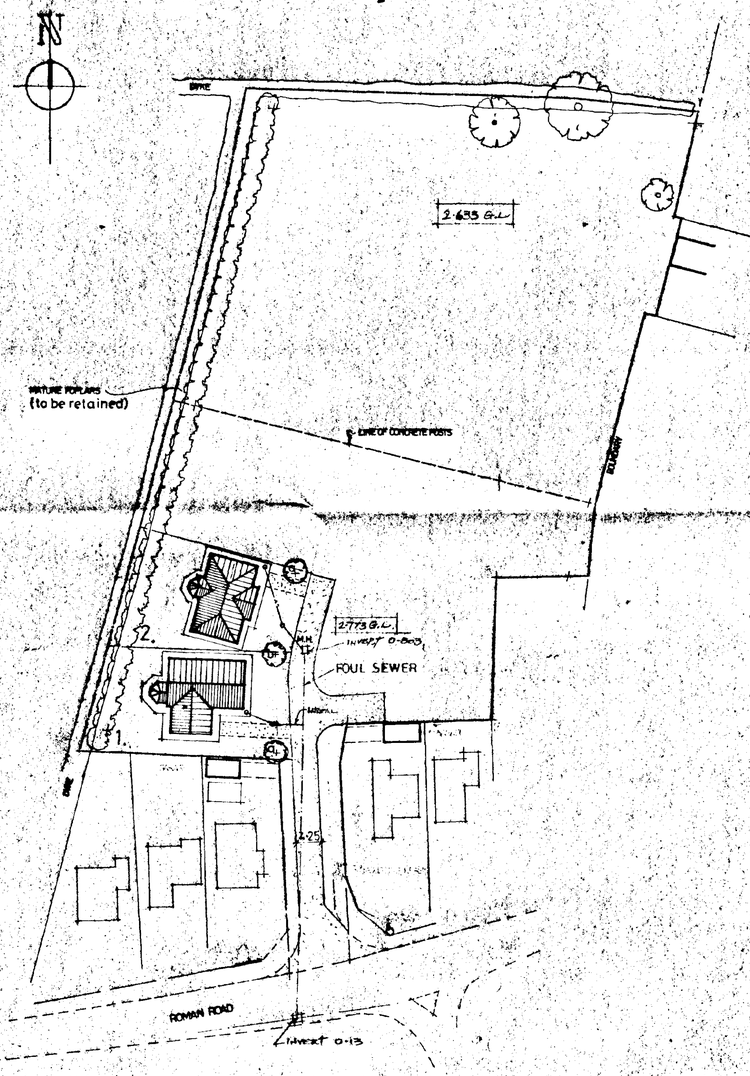

SITE PLAN 1:500

TREE PLANTING

PLOT 1. a – RED HAWTHORN (CRATAEGUS PAUL'S SCARLET) - ½ STANDARD

PLOT 2. a – RED HAWTHORN (CRATAEGUS PAUL'S SCARLET) - ½ STANDARD
b – WHITEBEAM (SORBUS ARIA LUTESCENS) - ½ STANDARD

TEMPORARY PRIVATE DRIVE

PRIVATE DRIVE TO BE MINIMUM 4.25M WIDE CONSTRUCTED WITH 150MM WELL COMPACTED HARDCORE (SUB BASE) & TOPPED WITH GRAVEL.

AMENDED PLAN
Ref. A1

SOUTH ... DC
HOUS... ...G
03 JUL 1995
Ref: 0147/95

C 27.6.95 AS BUILT PLAN - PLANS 1 & 2.
B 16.5.95 ROOF AMENDMENTS - SHT 2.
A 6.5.95 LANDSCAPING PLOTS 1 & 2.

G. R. MERCHANT
LENG AMICE, FIWO,
ARCHITECTURAL, STRUCTURAL & LAND DRAINAGE CONSULTANT
TEL: HOLBEACH (0406) 490800

PROJECT:
LAND OFF ROMAN ROAD,
MOULTON CHAPEL.


CLIENT:
D.G.M. PROPERTIES LTD.,
DOZENS BANK
POOR HOLE,
SPALDING,
LINCS.

SCALES:	DATE:
AS INDICATED	NOV. '94
	DRAWING No.: DGM-MC.2c

REVISIONS:
A B C

SITE LAYOUT

SUMMIT

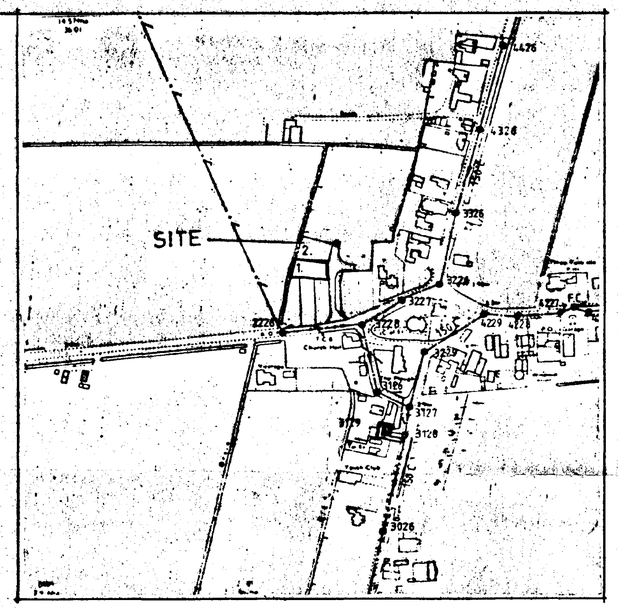


LOCATION PLAN 1:2500

TREE PLANTING

PLOT 1. a – RED HAWTHORN (CRATAEGUS PAUL'S SCARLET) - ½ STANDARD

PLOT 2. a – RED HAWTHORN (CRATAEGUS PAUL'S SCARLET) - ½ STANDARD
b – WHITEBEAM (SORBUS ARIA LUTESCENS) - ½ STANDARD

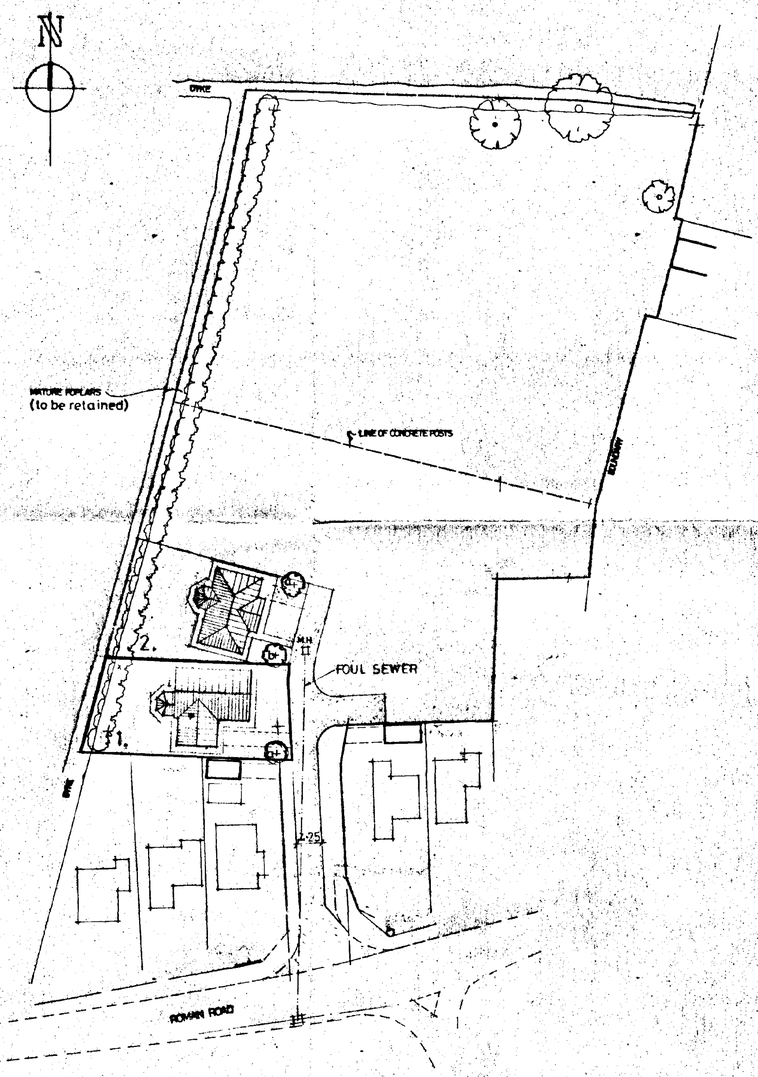

SITE PLAN 1:500

DETERMINED PLAN

AMENDED PL...
R/ H13/0147/95 13/9/95

SITE LAYOUT

G. R. MERCHANT
I.ENG AMICE, FIWO,
ARCHITECTURAL, STRUCTURAL & LAND DRAINAGE CONSULTANT
TEL: HOLBEACH (0406) 490800

PROJECT:
LAND OFF ROMAN ROAD,
MOULTON CHAPEL.

CLIENT:
D.G.M. PROPERTIES LTD.,
DOZENS BANK
PODE HOLE,
SPALDING,
LINCS.

SCALES:	DATE:
AS INDICATED	NOV '94
	DRAWING No.: DGM-MC .2

REVISIONS:
A.