SALLY WALTHAM
BA (Hons) F.C.I.H.
Director of Housing & Planning Services

Housing and Planning
Services Department,
Council Offices,
Priory Road,
Spalding,
Lincolnshire. PE11 2XE

Telephone: (01775) 761161
Fax: (01775) 710772

FILE COPY

SOUTH HOLLAND DISTRICT COUNCIL
HOUSING & PLANNING SERVICES DEPARTMENT

Application no: H13/1253/00

Original Applicant:
Mr & Mrs Snowdon
Boyfields
9 High Street
Moulton
Spalding Lincs PE12 6QB

Original Agent:
Summer Garden & Leisure
Notcutts Garden Centre
Oundle Road
Peterborough
PE2 5UU

Description: Erection of single storey double glazed conservatory, including new entrance from house

Location: Boyfields
9 High Street
Moulton
Spalding Lincs

Amendment: Roof vent added (dwg no. 10F1)

01-MAY-01

Dear Sir/Madam

TOWN AND COUNTRY PLANNING ACT 1990
NOTICE OF ACCEPTANCE OF AMENDMENT

The amended details submitted in respect of the above proposal have now been considered and there are no objections to the amendment being implemented to the extent described above.

Note: This Notice does not convey any approval under the Building Regulations and you may need to make a new submission.

Yours faithfully

Director of Housing and Planning Services

Summer Garden & Leisure Buildings
Wendover Road
Rackheath Industrial Estate
Rackheath, Norwich
Norfolk. NR13 6LH

AMENDMENT RECORD SHEET - POST DECISION

Admin

Validation:

Inadequate/Inappropriate ☐

Clarification/Details required:

Appears valid ✓

Registered .....

DC Procedural Assessment

Is the information given correct? Yes/~~No~~ (If No, state above what details are needed)

Is it an amendment in principle? Immaterial/~~Needs new app~~

Confirmed: .....MK.....6/4.

Give a revised description if the details accepted are different to the submission:

Acceptance issued: ✓ 4/5

PLANNING AMENDMENT

For office use only

Application No. H13/1253/00.

Date Registered 18 APR 2001

Case Officer DMG.

1. Please complete in block letters

NAME AND ADDRESS OF APPLICANT

MR + MRS SNOWDEN

Tel. No.

NAME AND ADDRESS OF AGENT
(if form completed by agent)

SUMMER GARDEN + LEISURE

Tel. No. (Contact)

Please complete in block letters

FULL POSTAL ADDRESS OF THE APPLICATION SITE

'BOYFIELDS', 9 HIGH STREET.

Please complete

APPLICATION No.

This amendment **cannot be considered** unless the relevant reference is stated

H13/1253/00.

Building Regulation reference relating to same development (if any)

2. Please tick **one** box only

A Amendment is proposed where permission already granted — If yes, submit two forms and two plans. ☑

or

B Amendment is to a proposal currently being considered — If yes, submit four forms and four plans. ☐

Please complete

I attach the necessary plans and request that the changes described below be accepted as an amendment. I understand that the Council may require a fresh application, together with fee if appropriate. If the amendment relates to a current application, I agree to an extension of the terminal date.

Signed ..... Date .....

3. Please complete in block letters

FULL DESCRIPTION OF DEVELOPMENT IN ORIGINAL APPLICATION

ERECT SINGLE STOREY DOUBLE GLAZED CONSERVATORY, INCL. NEW ENTRANCE FROM HOUSE.

State details of amendments proposed

(Give a full detailed list of the changes, and also mark these clearly on the accompanying plans. Only the changes listed here will be considered.)

ROOF VENT.

State drawing no's of the current submission

Has this amendment been requested by the Council? (If so, state Officer dealing with the application)

YES / NO


Describe any part of the original development which is excluded by virtue of the amendment, and state any alteration to plot numbers

Has a similar amendment been submitted under Building Regulations? Yes / No

Summer
Garden & Leisure Buildings

HEAD OFFICE & WORKS:
Wendover Road, Rackheath Industrial Estate,
Rackheath, Norwich, Norfolk, NR13 6LH.
Tel: (01603) 720079 Fax: (01603) 721668

Housing & Planning Services Department
South Holland District Council
Council Offices
Priory Road
Spalding
Lincs PE11 2XE

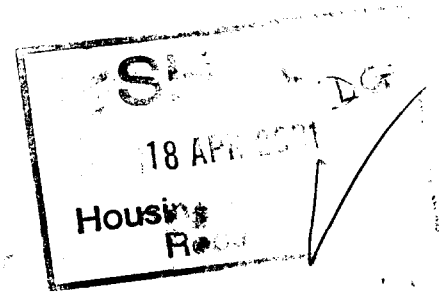

Application number H13/1253/00

12th April 2001

A1

Dear Sir or Madam


Re: Conservatory at Boyfields, 9 High Street, Moulton

We are in the process of manufacturing the above conservatory and we note that the drawings previously submitted do not include a roof vent. We therefore enclose revised drawings showing the size and location of the proposed roof vent. We do not propose any other changes to the approved plans and specifications.

The roof vent will be manufactured in white powder coated aluminium to match the glazing bars and glazed with clear polycarbonate to match the roof glazing.

We assume that this minor amendment will be considered as a non material change and that the existing consent will be amended by means of a simple letter.



We therefore look forward to receiving your reply shortly.

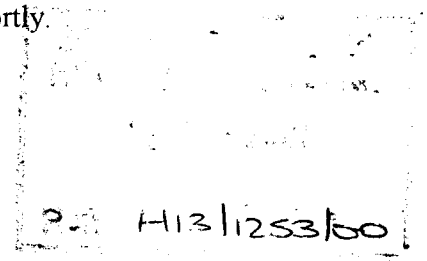


Thanking you in anticipation.

Yours sincerely,

Paul Gwilliam

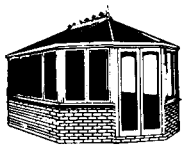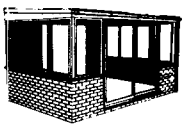


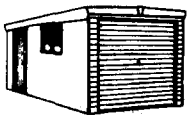


2:50

CTIONS.


PLAN.

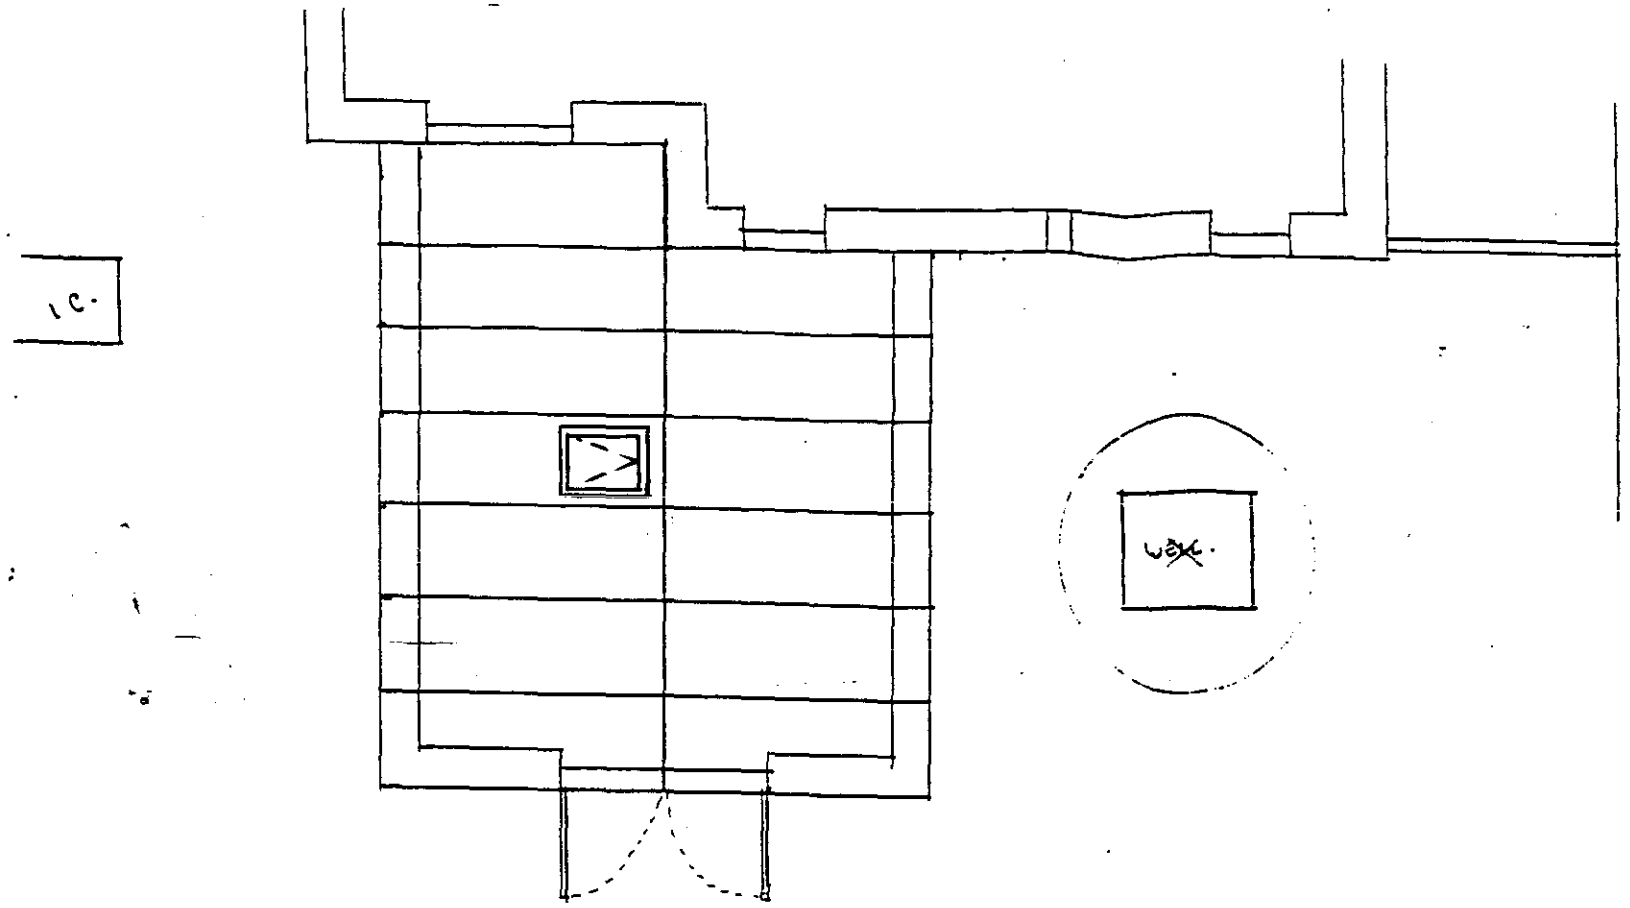


SIDE ELEVATION.

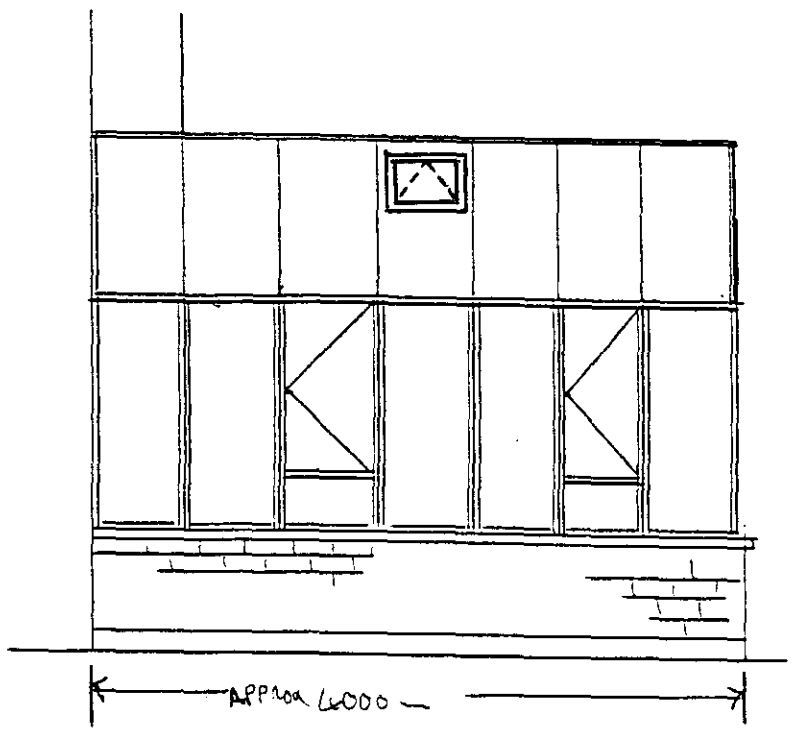

FRONT ELEVATION

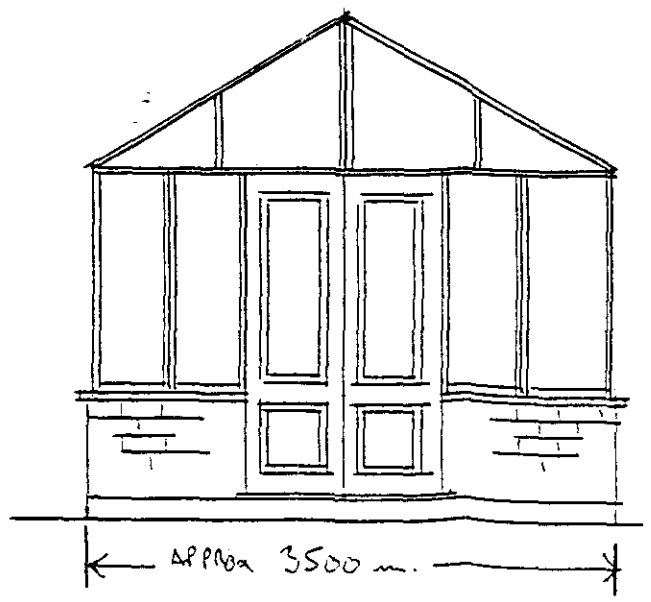

SIDE ELEVATION.

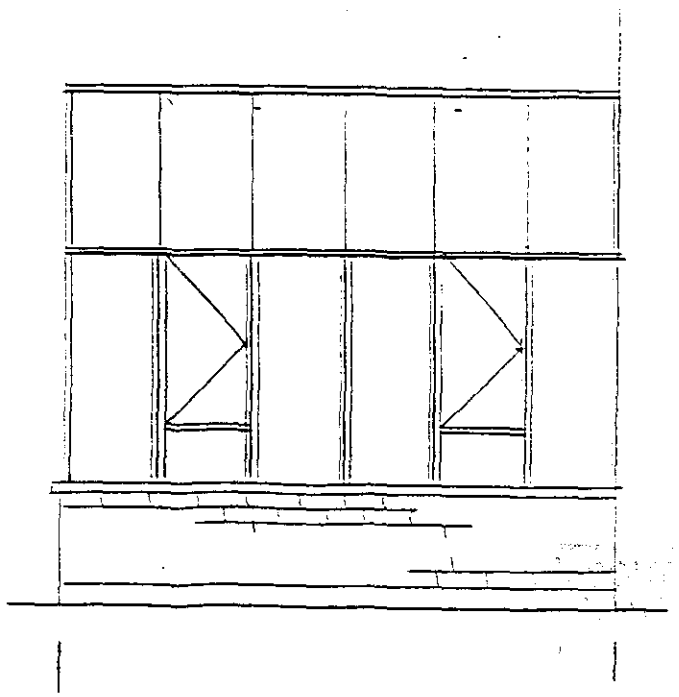

Summer
Conservatories plus...

PETERBOROUGH SHOWCENTR
Notcutts Garden Centre, Oundle Rc
Orton Waterville, Peterborough. PE2 5
Tel: (01733) 230444 Fax: (01733) 232

Proposed conservatory fo

Name: M. and Mrs. Slowson.

Address: BOYFIELDS
MOULTON.
SPALDING

Postcode:

Home tel: 01406 - 370209.

Work Tel:

Drawn by: MD.

Date: 13.09.00 | Quote ref:

Page: 1 OF 1 | Scale:

HEAD OFFICE:
Wendover Road, Rackheath Indus
Estate, Rackheath, Norwich, NR13 6
Tel: (01603) 720079 Fax: (01603) 721