




Front Elevation

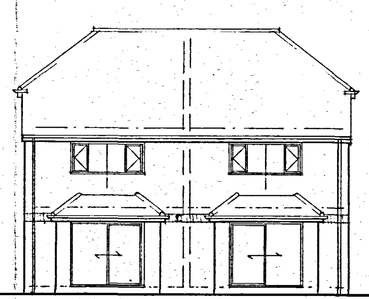


Back Elevation

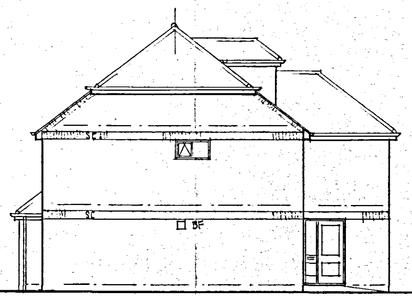


Side Elevation

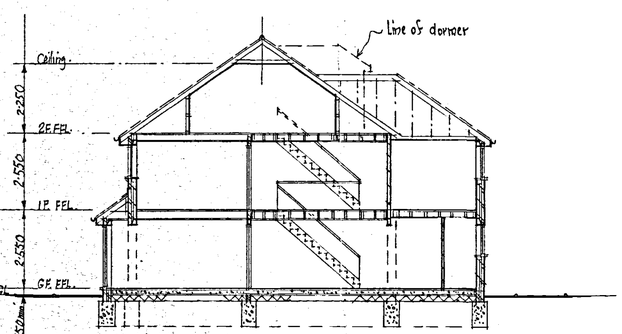


Section A-A

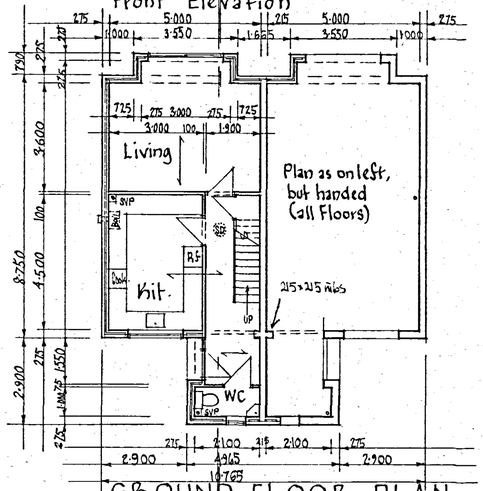

GROUND FLOOR PLAN

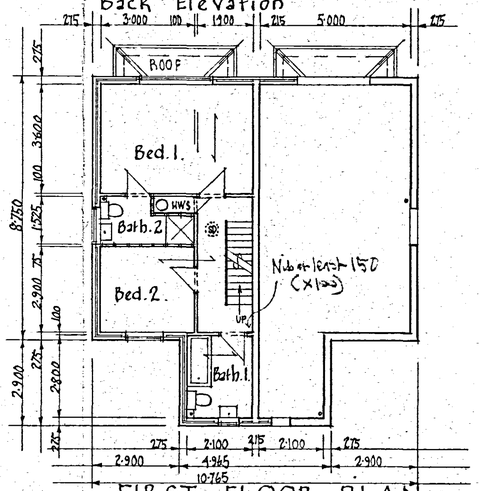

FIRST FLOOR PLAN

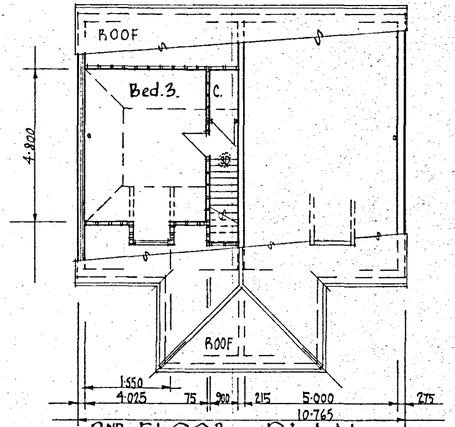

2ND FLOOR PLAN

SC added 21/10/04

SHDC
Planning & Development
14 DEC 2004
Ref: 1637/04

DETERMINED PLAN

THREE BEDROOM SEMI-DETACHED HOUSES

Type Q102·1

DIXON ARCHITECTS

Gerald Dixon, Dip.Arch., RIBA, Dip.TP — Jennifer Anne Dixon, Dip.Arch., RIBA

Chartered Architects and Planning Consultants 12 Oaklands Road London N20 8BA

Tel: 020 8445 1954 Fax: 020 8446 4015

Scale:	Date: ~~24/07/02~~ ~~24/10/03~~ 23/5/03 ~~3/7/03~~	Drg. No:
1:100		Q102.

Cali Print B 333